Transmittal
Submittal Review Response

101 Southhall Lane, Suite 200
Maitland, Fl 32751
407.660.2552 Phone
407.875.1161 Fax

Date: 9/9/2026

To: **Contractor**
Kokolakis Contracting
202 East Center Street
Tarpon Springs, FL 34689
Attention: Cameron Champaigne

Re: **Project No.:** 253117-261237
Project Name: PSTA Clearwater Multimodal Transit Center
Client: Pinellas Suncoast Transit Authority

Transmitted herewith is (are)...

☐ *Hard Copy(ies)*	**Sent via:**	☐ *Mail*	☐ *Overnight*	☐ *Courier*
☒ *Digital*		☐ Email	☐ FTP	☐ Cloud Delivery

Submittal No.: **S-051200-002-F**
Title or Description: **Structural Steel Framing Canopy & Pavilion**
Type of Submittal: **Shop Drawing** **If other**
Status
Review Code: Code 4: Approved As Noted; Resubmit
Other:
Review Comments:

1. Contractor shall provide a written response to each of the Engineer's review comments listed below.
2. Engineer notes that this is a resubmittal of S-051200-002-D (not E).
3. For additional comments see pdf entitled "S-051200-002-F - Structural Steel Framing Canopy & Pavilion_CDM Smith Comments.pdf". Effort has been made by Engineer to provide responses to all clouds. If a response has not been provided, please ensure Engineer is aware to respond to. Contractor shall refer to markups for all detailer queries that require Contractor confirmation/response. Markups and questions are also provided on individual member sheets. Many are repeat comments.
4. Contractor to confirm steel elevation on p. 6 of 231 with approved storefront (not yet submitted). Engineer confirms intent is met. This is a repeat comment and Contractor has indicated coordination to still be completed.
5. There is a mismatch between the dimensions and wave truss bend radii shown on the overall truss longitudinal drawings, E110 and E111, and those shown on the contract drawings and typical truss shop drawings, Drawing Nos. 1176 through 1200. Coordinate between the drawings and ensure that

Ben Harber

Signed

all dimensions and bend radii are consistent with and accurately reflect the requirements shown on the contract drawings.

6. As shown in Detail E, provide two stiffeners on each side of each HSS5x5-to-HSS10x6 connection not just at the column location, as indicated in Detail E/S-CP-8, at gridlines 1.1, 2.9, 4.1, 5.1, 6.5, and 7.5. An isometric view has been provided for clarity on E118. This is a repeat comment (previously only a pdf markup).
7. Some comments on the individual member sheets from the previous submittal remain unaddressed. Provide responses or revise the shop drawings as required for all individual members with comments. These have been repeated in the pdf markup.
8. Engineer notes that the typical truss erection drawing submitted is representative of all longitudinal trusses. Contractor shall ensure that all comments provided for the typical truss are incorporated into every longitudinal truss and verified prior to fabrication and construction. This is a repeat comment as engineer notes revisions to submittal (as noted above) are still required.
9. Erection drawings and erection calculations may be submitted for engineer review and final approval prior to erection. However, the contractor shall ensure that the original member sizes and connections remain adequate and are not affected by the proposed erection sequence. If any changes are required, the shop drawings shall be revised and resubmitted for review and approval. Members and connections shown on the contract drawings are designed for final in-place loading conditions. Contractor shall submit the erection sequence, lifting and temporary support details, and shoring plan for review and approval per AISC 303. Contractor shall be responsible for verifying, through signed and sealed calculations, that stresses on members and connections do not exceed their capacities during erection, including the use of proposed erection aids and temporary connections. A smooth surface finish shall be maintained after removal of erection aids at all locations, per Section 051213-3.3. This is a repeat comment as this is required for engineer's final approval and any steel being released for fabrication without this erection plan submitted for review is at Contractor's risk.
10. Contractor shall coordinate base plate thickness, bolt hole diameters, and bolt hole locations with submittal "S-051200-001-C - Anchor Bolts & Embeds Shop Drawings" (not yet fully approved). This is a repeat comment.
11. At Waiting Pavilion building, Contractor to coordinate with the selected transformer manufacturer to confirm the location of the transformer support beams, and transformer connection requirements. This is a repeat comment as Contractor has indicated to be coordinated. Contractor to confirm intent if planned to be coordinated in field, will require coordination with grouted/reinforced CMU.
12. Submit all required information as specified in Section 1.7. This is a repeat comment as only certain items have been submitted. This may be submitted under separate cover. Contractor to confirm intent and timeline on if submitted separately.
13. Submit product data for all the items listed in section 1.6.A of specification 05 12 13. This is a repeat comment. This may be submitted under separate cover. Contractor to confirm intent and timeline on if submitted separately.

Ben Harber

Signed

14. Submit the samples as requested in section 1.6.C of specification 05 12 13. This is a repeat comment. This may be submitted under separate cover. Contractor to confirm intent and timeline on if submitted separately.
15. Include all the items listed in section 1.6.B of specifications 05 12 13. This is a repeat comment. This may be submitted under separate cover. Contractor to confirm intent and timeline on if submitted separately.
16. Submit all required information as specified in Section 1.7 of specification 05 12 13. This is a repeat comment. This may be submitted under separate cover. Contractor to confirm intent and timeline on if submitted separately.
17. Submit test results and certificates of conformance for all heavy sections (flange thickness greater than 2 inches), demonstrating compliance with Section A3.1.1c of AISC 360-16, as indicated in the steel general notes on Sheet S-1. The column flanges at the side (east and west) canopies have thicknesses greater than 2 inches. Therefore, provide the requested certificates with this resubmittal or include them in the side canopy shop drawings and resubmit. Contractor to confirm. This is a repeat comment from the “A”, “C” and “D” submittals. Contractor to confirm intent and timeline on if submitted separately.
18. Cane rails shall be provided in accordance with Section 05 52 00. Contractor shall submit under a separate package if not included in the Morrow Steel scope. This is a repeat comment as detailer has also requested confirmation. Contractor to confirm intent and timeline on if submitted separately.
19. Contractor shall submit the roof framing connected stanchion at the wave canopy or confirm if will be submitted under separate cover. This is a repeat comment as coordination has not been provided and may affect submitted framing. Contractor to confirm intent and timeline on if submitted separately.
20. Contractor shall coordinate the location, size, and elevation of plates and associated connections to structural steel for the signage connection shown on Section 7/S-CP-9 with the approved signage submittal and connection requirements (not yet submitted), and with the column cover shown on architectural drawings (not yet submitted), prior to fabrication and construction. This is a repeat comment as detailer has also requested coordination. Contractor to confirm intent if planned to be coordinated in field.
21. Contractor shall coordinate the location, size, and elevation of plates and associated connections to structural steel for the lighting connection shown on Detail B/S-CP-9 with the selected lighting manufacturer for connection requirements, and with the column cover shown on architectural drawings (not yet submitted), prior to fabrication and construction. This is a repeat comment as detailer has also requested coordination. Contractor to confirm intent if planned to be coordinated in field.
22. Contractor shall coordinate all access hatch opening sizes and associated connection requirements with the approved hatch submittal (not yet submitted). This is a repeat comment as detailer is also requesting confirmation.
23. Contractor shall coordinate ladder connection locations with submittal “S-034113-001-A – (Delegated Design) Precast Concrete Hollow Core Planks” to avoid conflicts between ladder

Ben Harber

Signed

connections to hollow core planks and precast panel embed connections at openings at the retail/operations and waiting pavilion buildings. This is a repeat comment as coordination has not been provided and conflicts may exist.

24. Contractor shall submit product data for the ladder safety post (or confirm will be submitted under separate cover) for the Engineer's review and approval. This is a repeat comment as Contractor has indicated this is shown on shop drawings however it says "by others." Contractor to confirm intent and timeline on if submitted separately.
25. Submit product data for headed studs (page 44 of 52) separately. Specification 055000 indicates basis of design. This is a repeat comment as Contractor indicated they will submit separately under 055000 if required, it is required. Contractor to confirm intent and timeline on if submitted separately.
26. Contractor is responsible for confirming that project level Buy America Act requirements are met.
27. Submitted LEED information was not reviewed. Comments to be resolved by client's LEED consultant. N CDM Smith response.
28. Receipt acknowledge od drawing E121 Wave Canopy roof hatch. However, hatch location is not shown on E106 partial roof framing of wave canopy. Contractor to locate and properly adjust roof hatch on E106.
29. Comment 35 from the previous submittal remains unresolved and pertains to the roof hatch location at the Waiting Pavilion Building. As shown on Page 32 of 266, the roof hatch opening is currently located 7'-1" from the east exterior wall. At this location, the required ladder access and clear travel area overla the adjacent interior metal stud wall. Revise the roof hatch opening location by increasing the 7'-1" offset dimension as necessary to provide the required clearances and eliminate the conflict with the interior wall construction. Resubmit for review.
30. Previous submittal response to comments 31 through 33 indicate further coordination and follow up. Contractor to confirm intent and timeline on if submitted separately.

Location of the Review Comments: Attached to Submittal

Remarks:

Reviewed by: Pooja Kalaria, Esther Goldberg, Shannon Ketchum, Daniela Montoya

Ben Harber

Signed

Submittal #051200-7.1 051200 - Structural Steel Framing

Kokolakis Contracting
202 East Center Street
Tarpon Springs, Florida 34689
Phone: +17279422211

Project: 25-0264-01 - PSTA Clearwater Station
751 Franklin St.
Clearwater, Florida 33756

S-051200-002-F - Structural Steel Framing Canopy & Pavilion

SPEC SECTION:	051200 - Structural Steel Framing	**SUBMITTAL MANAGER:**	Cameron Champaigne **(Kokolakis Contracting)**
STATUS:	Open	**DATE CREATED:**	08/31/2026
ISSUE DATE:	08/31/2026	**REVISION:**	1
RESPONSIBLE CONTRACTOR:	Acclaim Service Group, Inc.	**RECEIVED FROM:**	
RECEIVED DATE:		**SUBMIT BY:**	
FINAL DUE DATE:	09/15/2026	**LOCATION:**	
SUB JOB:		**COST CODE:**	
LEAD TIME:		**TYPE:**	
APPROVERS:	Xavier Arroyo **(CDM Smith)**, David DaSilva **(CDM Smith)**, Benjamin Harber **(CDM Smith)**, Mindy Heath **(CDM Smith)**, Robin Sarvis **(CDM Smith)**		

BALL IN COURT:
Xavier Arroyo **(CDM Smith)**, David DaSilva **(CDM Smith)**, Benjamin Harber **(CDM Smith)**, Mindy Heath **(CDM Smith)**, Robin Sarvis **(CDM Smith)**

DISTRIBUTION:
Ashley Quaid **(HDR, Inc.)** , Benjamin Harber **(CDM Smith)** , Cameron Champaigne **(Kokolakis Contracting)** , Christine Herrold **(MORROW STEEL FABRICATORS, INC)** , Colton Forkush **(Kokolakis Contracting)** , David DaSilva **(CDM Smith)** , Dylan Hernandez **(HDR, Inc.)** , Elizabeth Fazio **(PSTA)** , Eric Lawson **(MORROW STEEL FABRICATORS, INC)** , John Olivio **(HDR, Inc.)** , John Steele **(HDR, Inc.)** , Joseph Barron **(HDR, Inc.)** , Josh Van Vossen **(Kokolakis Contracting)** , Leticia Sheppard **(HDR, Inc.)** , Marcus Glynn **(HDR, Inc.)** , Mike Ferry **(MORROW STEEL FABRICATORS, INC)** , Mindy Heath **(CDM Smith)** , Robin Sarvis **(CDM Smith)** , Tracie Rose **(HDR, Inc.)** , Xavier Arroyo **(CDM Smith)**

DESCRIPTION:

ATTACHMENTS:

SUBMITTAL WORKFLOW

NAME	SUBMITTER/ APPROVER	SENT DATE	DUE DATE	RETURNED DATE	RESPONSE	ATTACHMENTS	COMMENTS
Cameron Champaigne	Submitter	9/1/2026	8/31/2026	9/1/2026	Submitted	S-051200-002-F - Structural Steel Framing Canopy & Pavilion.pdf	
Xavier Arroyo	Approver	9/1/2026	9/15/2026		Pending		
David DaSilva	Approver	9/1/2026	9/15/2026		Pending		
Benjamin Harber	Approver	9/1/2026	9/15/2026		Pending		
Mindy Heath	Approver	9/1/2026	9/15/2026		Pending		
Robin Sarvis	Approver	9/1/2026	9/15/2026		Pending		

Kokolakis Contracting hereby certifies that all items submitted herewith have been checked by the Contractor, are correct, and are in accordance with the requirements of the Contract Documents, except as noted in the remarks section of the submittal.

KOKOLAKIS CONTRACTING

Submittal #051200-7.1 051200 - Structural Steel Framing

BY	DATE	COPIES TO

PSTA Clearwater Station
701 Franklin St.
Clearwater, Florida 33756

SUBMITTAL STAMPING SHEET

Shop Drawing Review

- [ ] Approved
- [x] Comments Attached
- [ ] Approved As Noted
- [x] Approved As Noted; Resubmit
- [ ] Not Approved; Resubmit

- [x] Full
- [ ] Partial

- [ ] Receipt Acknowledged (Not Subject to the Engineer's Approval)

The Contractor is responsible for the details and dimensions of fabrication and manufacture, the mean, methods, techniques, sequences or procedures of construction and performing its work in a safe manner. The Contractor is also responsible for confirmation and verification of all field measurements, and coordination with other related shop drawings and Contract requirements.

The Engineer's review of this shop drawing is limited to review for general conformance with the Contract Documents and design concept. This review does not relieve the Contractor from errors or omissions in the submittal, or from the Contractor's responsibility of addressing any deviations from the Contract Documents, or for any other Contract requirement.

Note: The review of shop drawings containing design calculations are drawings signed and sealed by a professional engineer ("Contractor Specialty Engineer") does not constitute a detail check of calculations, nor does is relieve the Contractor's Specialty Engineer from the responsibility for the design and detailing of the specialty component or system contained in such shop drawings.

CDM Smith By: Ben Harber Date: 9/9/2026

Consultant Name
Stamp Area

Project Name:
PSTA Clearwater Station

REVIEWED

Submittal #: S-051200-002-E - Structural Steel Framing Canopy & Pavilion.pdf
Reviewed By: CameronChampaigne

Date: 08/31/2026

This submittal has been reviewed, checked and approved for compliance with the Contract Documents unless otherwise noted herein. This review does not constitute nor does it assure design responsibility nor does it relieve the trade contractor/supplier from complying with the contract requirements, coordinating their work with other trade contractors and verifying field dimensions.

Review of pages 34 & 35 only

REVIEWED

- [ ] APPROVED
- [x] APPROVED AS NOTED
- [ ] RESUBMIT
- [ ] NOT APPROVED

REVIEW IS ONLY FOR CONFORMANCE WITH THE DESIGN CONCEPT OF THE PROJECT AND COMPLIANCE WITH THE INFORMATION GIVEN IN THE CONTRACT DOCUMENTS BUT SHALL NOT EXTEND TO MEANS, METHODS, TECHNIQUES, SAFE OPERATING PRACTICES, SEQUENCES OR PROCEDURES OF CONSTRUCTION OR PROGRAMS INCIDENT THERETO. THE REVIEW AND APPROVAL OF SEPARATE ITEMS AS SUCH WILL NOT INDICATE APPROVAL OF THE ASSEMBLY IN WHICH THE ITEMS FUNCTION. APPROVAL DOES NOT AUTHORIZE ANY DEVIATION FROM THE CONTRACT DOCUMENTS. CONTRACTOR IS RESPONSIBLE FOR DIMENSIONS TO BE CONFIRMED AND CORRELATED AT THE JOB SITE, FOR INFORMATION THAT PERTAINS SOLELY TO THE FABRICATION PROCESSES, OR TO TECHNIQUES OF CONSTRUCTION AND FOR COORDINATION OF THE WORK OF ALL TRADES.

DRMP, INC.

BY BArriola DATE 9/1/2026

RESUBMITTAL RESPONSE COVER SHEET

S-051200-002-E - Structural Steel Framing - Canopy & Pavilion | Response to S-051200-002-D

SUBMITTAL PURPOSE

This resubmittal is being submitted for EOR approval and release of the Canopy & Pavilion structural steel for fabrication. It includes Morrow Steel Canopy & Pavilion SEQ #1 Rev. 2 shop drawings, condensed written responses to EOR Comments 1-39, refined red revision clouds identifying Morrow revisions, supporting coating product data, Morrow welding procedures, and available welder qualification/certification records.

DOCUMENTS INCLUDED / UPDATED

- Revised Morrow Steel Canopy & Pavilion SEQ #1 shop drawings - Rev. 2, with refined red revision clouds identifying Morrow drawing changes.
- Condensed written contractor responses to EOR Comments 1-39.
- Lanning Chemical Fast Dry Universal Primer product data and ZRC Galvilite galvanizing repair compound product data.
- Morrow Steel WPS documents MSE3000, MSF1000, MSF1300, and MSF2000.
- Available Morrow Steel welder qualification/certification records.

INFORMATIONAL / FOLLOW-UP DOCUMENTATION

Remaining mill reports, certificates of conformance, qualification records, source/LEED documentation, and similar informational submittals will be provided after the steel is released for fabrication as production material becomes available. Coordination items dependent on final vendor/manufacturer information will be coordinated before fabrication or installation of the affected interface, and a follow-up submittal will be provided separately if required.

CONDENSED EOR COMMENT RESPONSES

Comments 1-20 | S-051200-002-E

1. Written response to all comments
Written responses to Comments 1-39 are included.

2. East/west canopy steel
Not included in SEQ #1; it will be submitted under a separate sequence/package with applicable prior comments incorporated.

3. Restroom CMU wall anchorage
Revised shop drawings include the restroom non-bearing CMU wall support/anchorage on E131 and related details.

4. Waiting Pavilion transformer supports
W8x24 supports and anchorage are shown. Final location/elevation will be coordinated with the selected transformer manufacturer. Morrow's revised bolt arrangement is submitted for EOR review; follow-up will be submitted if required.

5. Typical truss comments
Representative truss revisions apply to all similar longitudinal trusses. The E118 5/16 in. weld item remains identified for Morrow/EOR confirmation before affected fabrication.

6. Coating data / HDG gutter plates
Added Lanning Fast Dry Universal Primer and ZRC Galvilite data. Revised drawings identify galvanized steel; gutter bent plates are to be hot-dip galvanized.

7. 051200-1.7 informational submittals
WPSs and available welder certifications are included. Remaining qualifications, mill reports, product tests and compatibility certificates are informational submittals and will follow after release as production material becomes available.

8. 051213-1.6.A AESS product data
Available coating product data is included. Remaining applicable AESS product data will be submitted separately if required.

9. 051213-1.6.C AESS samples
Physical AESS samples will be submitted separately as required.

10. 051213-1.6.B shop-drawing content
Revised shops identify AESS categories, connections, welds, vents, coatings and fabrication information. Vendor/interface items will be coordinated; follow-up will be submitted if required.

11. 051213-1.7 informational submittals
Available welder qualifications are included. Remaining installer/fabricator/shop-painting qualifications and coating compatibility information are informational submittals and will follow after release.

12. Heavy-section AISC 360 certificates
No member with flange thickness greater than 2 in. has been identified. If one is furnished, required certificates will be submitted after release when the production material is identified.

13. Cane rails - Section 055200
Scope will be coordinated. If outside Morrow's steel scope, cane rails will be submitted separately under Section 055200.

14. Wave-canopy roof stanchion
Scope will be coordinated. A separate follow-up submittal will be provided if required.

15. Signage connection
Morrow shows the structural signage connection on E120. Final size, location and elevation will be coordinated with approved signage and column-cover information before affected fabrication; follow-up will be submitted if required.

16. Lighting connection
Morrow shows the structural lighting connection on E120. Final size, location and elevation will be coordinated with the selected lighting manufacturer and column-cover information; follow-up will be submitted if required.

17. Erection engineering
Erection sequence, lifting, temporary supports/shoring and signed/sealed calculations will be submitted separately by the erector before erection. This submittal is for release of steel for fabrication.

18. Access-hatch coordination
Revised hatch framing is shown. Final opening dimensions and connection requirements will be coordinated with the approved roof-hatch product; follow-up will be submitted if required.

19. Baseplate / anchor-bolt coordination
Baseplate thickness, bolt-hole sizes and locations will be coordinated with the anchor-bolt/embed package before affected fabrication; follow-up will be submitted if required.

20. Representative truss / BOM
The representative truss detail applies to similar trusses; final approved typical revisions will be carried through all similar trusses.

Coordination items will be completed before fabrication/installation of the affected interface; follow-up submittals will be provided separately if required.

CONDENSED EOR COMMENT RESPONSES

Comments 21-39 | S-051200-002-E

21. Ladder / hollow-core coordination
Revised ladder connection details are shown. Final connection locations will be coordinated with the approved hollow-core layout before installation; follow-up will be submitted if required.

22. Ladder safety-post data
The safety post is shown on the shop drawings. Manufacturer product data will be submitted separately under the applicable specification if required.

23. Headed-stud product data
Headed studs are shown on the shop drawings. Manufacturer product data will be submitted separately under Section 055000 if required.

24. Storefront steel elevation
EOR previously confirmed design intent. Final bottom-of-steel elevation will be coordinated with storefront and curb manufacturer information before affected fabrication.

25. Additional marked-PDF comments
Revised drawings and red revision clouds identify EOR-driven changes. Remaining detailer/vendor queries will be coordinated before affected fabrication; follow-up will be submitted if required.

26. Architectural written responses
Written responses are included.

27. Submittal completeness
This package adds coating data, WPSs and available welder certifications. Remaining certification/mill/LEED documents are informational follow-up submittals after fabrication release.

28. Galvanizing / field coatings
Revised drawings identify galvanized steel. Lanning primer and ZRC repair data are included. Field painting and anti-graffiti coating will be coordinated under the applicable coating scope.

29. Wave-canopy roof hatch
Wave-canopy roof opening/hatch framing is included on E121.

30. Prior A comments
Applicable prior comments are addressed in the revised drawings and written responses. Manufacturer-dependent interfaces will be coordinated; follow-up will be submitted if required.

31. Roof-hatch clear opening
Opening is shown. Final clear opening/location will be coordinated with the approved roof-hatch manufacturer; follow-up will be submitted if required.

32. Ladder location / safe access
Revised ladder layout is shown. Final location will be coordinated with the approved hatch and surrounding wall construction before installation.

33. Retail Ops hatch / ladder
Prior EOR acceptance is noted. Final roof-hatch product approval and interface coordination will occur under the applicable roof-hatch submittal.

34. Hatch-to-rung / side-rail dimensions
Final dimensions will be coordinated with the selected/approved roof-hatch manufacturer; follow-up will be submitted if required.

35. Ladder travel area / centering
Revised plan is included. Final clear travel area and centering will be coordinated with the approved hatch and surrounding construction.

36. Bollard finish / selection
ME112 is revised to identify bollards as galvanized and painted traffic yellow.

37. LEED EPD / recycled content
EPD/recycled-content and mill documentation are informational submittals and will follow after steel release when production material is identified/procured.

38. Mill / fabrication sourcing
Mill/source, project-distance, fabrication-location and cost-percentage documentation are informational submittals and will follow after release when production sourcing is established.

39. VOC / galvanizing certification
Lanning primer data includes VOC content and ZRC Galvilite data is included. Remaining galvanizing/coating certification for LEED review is informational and will follow after release as applicable.

Coordination items will be completed before fabrication/installation of the affected interface; follow-up submittals will be provided separately if required.

EOR REVISION / DRAWING LOCATION INDEX

S-051200-002-E - Structural Steel Framing - Canopy & Pavilion

PURPOSE OF THIS PAGE

This index identifies the primary EOR-driven revisions incorporated into Morrow Rev. 2 and where they appear in the final package. Refined red revision clouds identify revised drawing areas.

EOR	Revision / response incorporated	Drawing	Final pkg. page
3	Restroom non-bearing CMU wall support/anchorage added.	E131	29
4	Waiting Pavilion W8x24 transformer supports/anchorage added; galvanized. Final transformer interface remains coordination.	E101 / E104	8, 11
5 / 20 / 25	Representative truss/connection details revised and clouded. E118 5/16 in. weld item remains identified for confirmation.	E118	25
15	Structural signage connection detail shown; final signage/column-cover interface to be coordinated.	E114 / E120	21, 27
16	Structural lighting connection detail shown; final lighting/column-cover interface to be coordinated.	E120	27
18 / 29 / 31	Wave-canopy roof opening/hatch framing restored; final hatch dimensions remain manufacturer coordination.	E121	28
21 / 32-35	Roof-hatch ladder layout/connections revised, including hollow-core/Hollo-Bolt interface information.	ME101 / ME102	30-31
24	Storefront/curb bottom-of-steel coordination identified on Waiting Pavilion elevations.	E102 / E103	9-10
28 / 36	Galvanizing carried through revised drawings; bollard detail revised to galvanized and traffic yellow.	ME112	33
6 / 8 / 39	Lanning Fast Dry Universal Primer and ZRC Galvilite product data added.	Support Appendix	237-240
7 / 11	Morrow WPSs and available welder qualification/certification records added. Remaining production certifications follow after release.	Support Appendix	241-264

Page numbers above refer to this final resubmittal package. Morrow transmittal begins on page 6; shop drawings begin on page 7.

morrow steel Fabricators, Inc.

3620 Copeland Drive | Zephyrhills, FL 33542 | PH: (813)715-0404 | www.morrowsteel.com

---


To: Kokolakis Contracting
Attn: Tyler Knight

Date: 8/26/2026
Job #2553
Transmittal #9

We are sending via email: T#9 Canopy & Pavilion SEQ#1 for Reapproval

E Drawings ☒	**Shop Details ☒**	**Calculations ☐**
For Reapproval ☒	**Back From Approval ☒**	**File & Field ☐**
Approved as Noted ☐	**Revise & Resubmit ☐**	**For Your Use ☐**

	Drawing #	Rev	# sheets		Drawing #	Rev	# sheets	
	Erection Sheets				**Detail Sheets**			
	E100 – E121	2	22		1401 - 1520	2	120	
	E131	1	1		1522	2	1	
	ME101 & ME102	2	2		1524 - 1526	2	3	
	ME111 & ME112	2	2		1528	2	1	
					1551 - 1565	2	15	
	Detail Sheets				1651	2	1	
	1001 - 1012	2	12		1701 & 1702	2	2	
	1021 - 1032	2	12		1711 - 1719	1	9	
	1051 - 1056	2	6		1720 & 1721	0	2	
	1176	2	1		M1001 – M1003	2	3	
	1185	1	1		M1011	2	1	
	1188	1	1		M1012	1	1	
	1191 & 1194	2	2					
	1197 & 1200	2	2		**Total**		**230**	

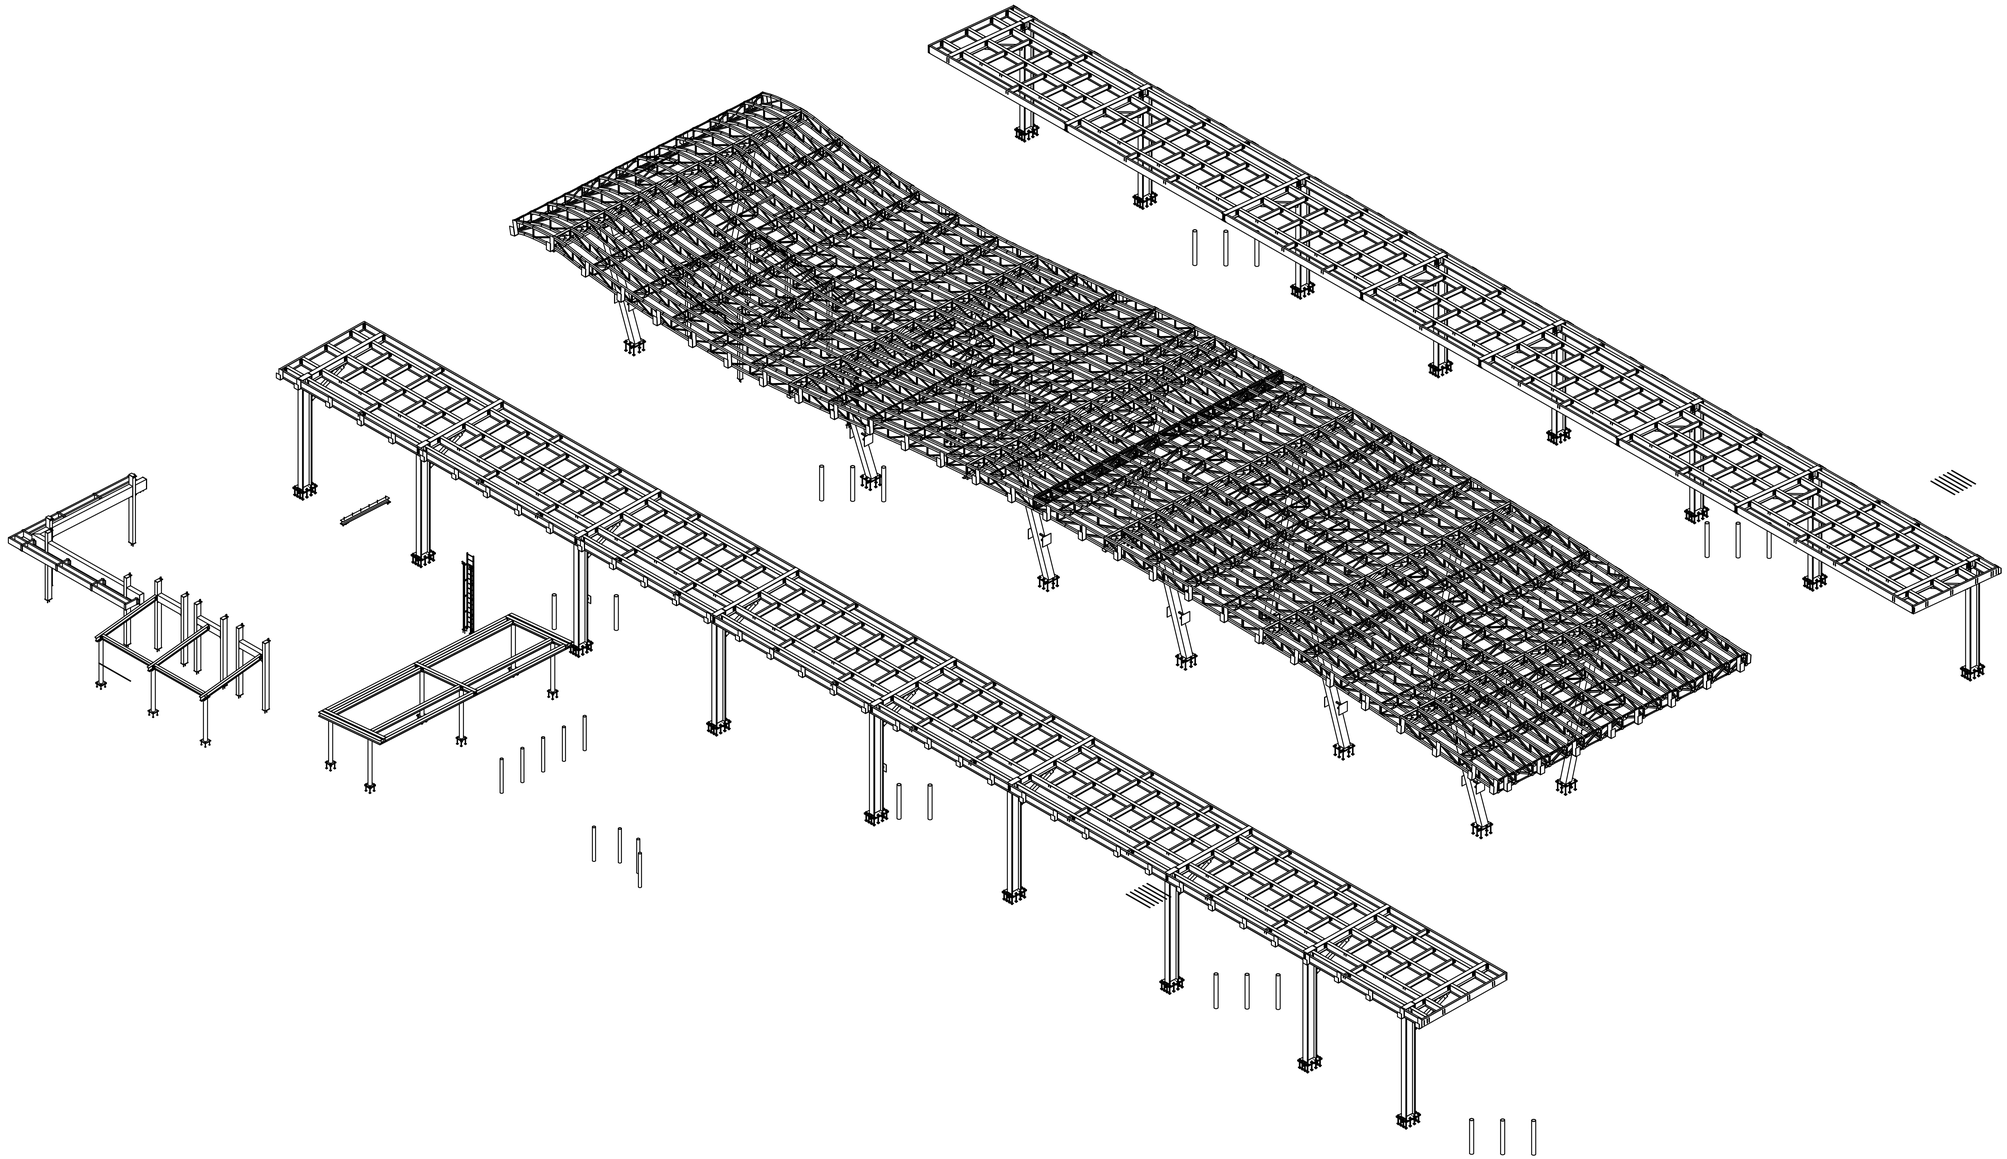

ISO VIEW

REFERENCE : S-CP-1

FIELD CONNECTIONS :
HOLES : 13/16" U.N.O
PAINT :

morrow steel Fabricators, Inc.


AISC CERTIFIED FABRICATOR AND ERECTOR

3620 COPELAND DRIVE
ZEPHYRHILLS, FL. 33542

	PRINTS FOR	DATE	MK	REVISIONS	DATE
			0	RELEASED FOR APPROVAL	Nov 18 2025
			1	RELEASED FOR RE-APPROVAL	Jul 13 2026
			2	RELEASED FOR RE-APPROVAL	Aug 26 2026

STRUCTURE:-	PINELLAS SUNCOAST TRANSIT AUTHORITY
LOCATION:-	CLEARWATER STATION,CLEARWATER,FL.
DETAILER:-	VECTORSHADES LLC
CUSTOMER:-	KOKOLAKIS
ARCH./ENG.:-	CDM SMITH
DESCRIPTION:-	ISO VIEW
DRAWN:- SHR	DATE:-10-09-2025 CHK.D:- RAG DATE:-10-10-2025

SHOP BILL	WORK ORDER NO.	DRWG. NO.
	2553	E100 ⚠

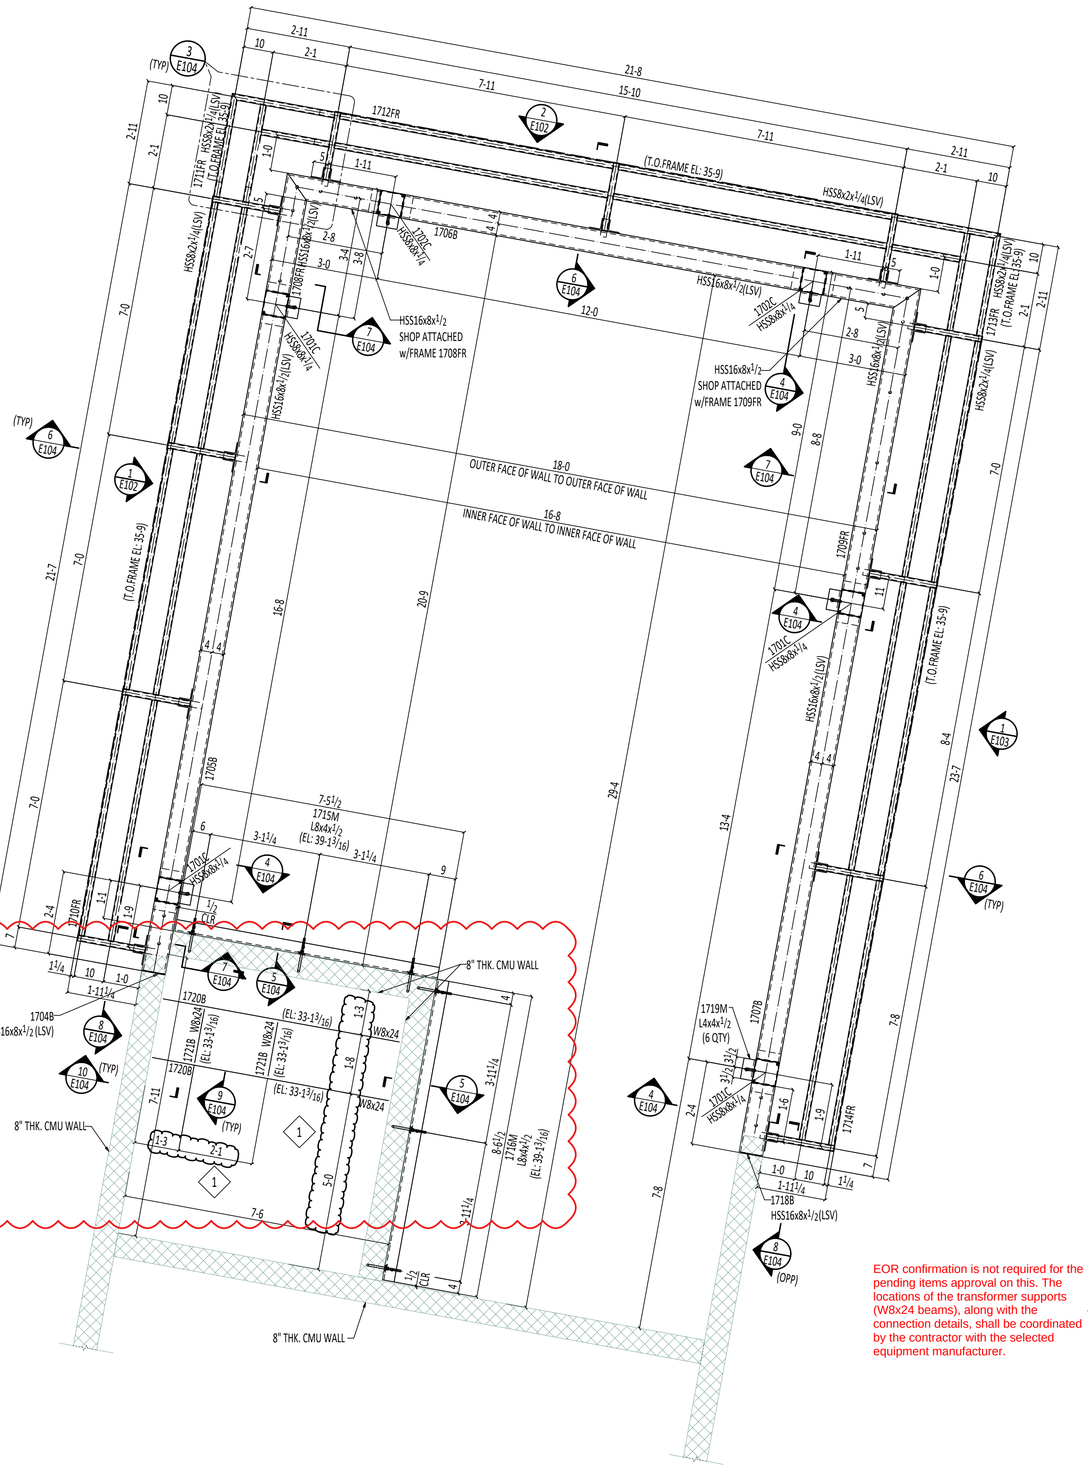

KEY PLAN

JOB NORTH

LINTEL FRAMING PLAN AT WAITING PAVILION BUILDING

(REF: S-PB-1)

JOB NORTH

NOTE:
- TOP OF STEEL EL: 36-5 (U.N.O).
- ALL MEMBERS ARE TO BE GALVANIZED.
- FOR ELEVATION VIEWS REFER SHEET E102 & E103.
- FOR SECTIONS AND DETAILS REFER SHEET E104.

APPROVER PLEASE REVIEW AND CONFIRM THE FOLLOWING ITEMS:

1 -GC TO CONFIRM THE CLOUDED TRANSFORMER SUPPORT BEAMS LOCATING DIMENSION WITH ELECTRICAL ENGINEERS.

EOR confirmation is not required for the pending items approval on this. The locations of the transformer supports (W8x24 beams), along with the connection details, shall be coordinated by the contractor with the selected equipment manufacturer.

APPROVER NOTE:
ALL CLOUDED INFORMATION NOT VERIFIED/CONFIRMED ON RETURNED APPROVAL SUBMITTAL WILL BE CONSIDERED APPROVED AS DETAILED.

LEGEND:
LSV - INDICATES LONG SIDE VERTICAL

REFERENCE : S-PB-1

FIELD CONNECTIONS :
HOLES : 13/16" U.N.O
PAINT :

morrow steel Fabricators, Inc.


AISC CERTIFIED FABRICATOR AND ERECTOR

3620 COPELAND DRIVE
ZEPHYRHILLS, FL. 33542


	PRINTS FOR	DATE	MK	REVISIONS	DATE
			0	RELEASED FOR APPROVAL	Nov 18 2025
			1	RELEASED FOR RE-APPROVAL	Jul 13 2026
			2	RELEASED FOR RE-APPROVAL	Aug 26 2026

STRUCTURE:- PINELLAS SUNCOAST TRANSIT AUTHORITY
LOCATION:- CLEARWATER STATION,CLEARWATER,FL.
DETAILER:- VECTORSHADES LLC
CUSTOMER:- KOKOLAKIS
ARCH./ENG.:- CDM SMITH
DESCRIPTION:- WAITING PAVILION BUILDING ROOF PLAN
DRAWN:- NMN DATE:-11-07-2025 CHK.D:- RAG DATE:-11-14-2025

SHOP BILL	WORK ORDER NO.	DRWG. NO.
	2553	E101 1

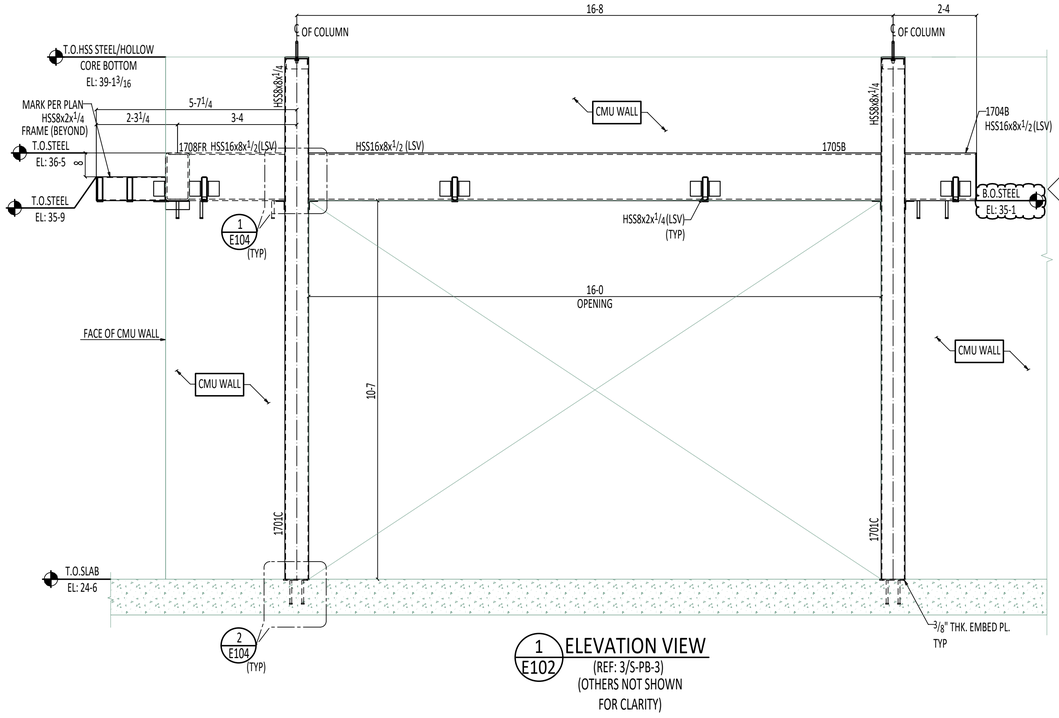

1 E102 ELEVATION VIEW
(REF: 3/S-PB-3)
(OTHERS NOT SHOWN FOR CLARITY)

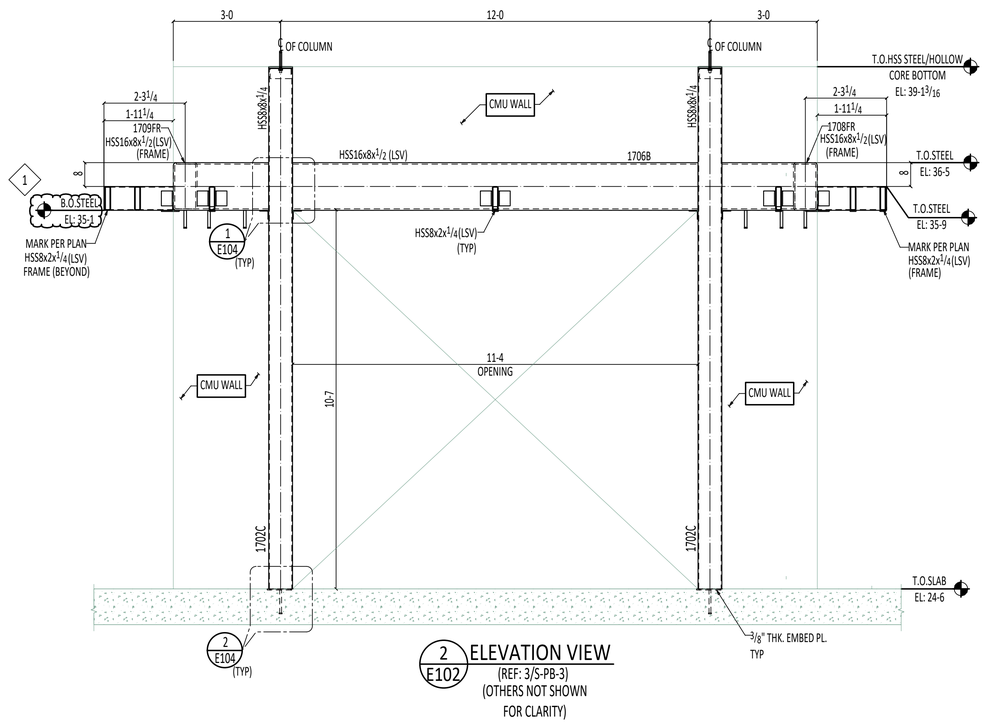

2 E102 ELEVATION VIEW
(REF: 3/S-PB-3)
(OTHERS NOT SHOWN FOR CLARITY)

1 -GC TO CONFIRM THE BOTTOM OF STEEL ELEVATION WITH STOREFRONT & CONCRETE CURB MANUFACTURER.

LEGEND:
LSV - INDICATES LONG SIDE VERTICAL

REFERENCE : S-PB-3 & A-PB-03

APPROVER NOTE:
ALL CLOUDED INFORMATION NOT VERIFIED/CONFIRMED ON RETURNED APPROVAL SUBMITTAL WILL BE CONSIDERED APPROVED AS DETAILED.

AISC CERTIFIED FABRICATOR AND ERECTOR

FIELD CONNECTIONS :
HOLES : 13/16" U.N.O
PAINT :


morrow steel Fabricators, Inc.

3620 COPELAND DRIVE
ZEPHYRHILLS, FL. 33542

	PRINTS FOR	DATE	MK	REVISIONS	DATE
			0	RELEASED FOR APPROVAL	Nov 18 2025
			1	RELEASED FOR RE-APPROVAL	Jul 13 2026
			2	RELEASED FOR RE-APPROVAL	Aug 26 2026

STRUCTURE:- PINELLAS SUNCOAST TRANSIT AUTHORITY
LOCATION:- CLEARWATER STATION,CLEARWATER,FL.
DETAILER:- VECTORSHADES LLC
CUSTOMER:- KOKOLAKIS
ARCH./ENG.:- CDM SMITH
DESCRIPTION:- WAITING PAVILION BUILDING ELEVATION VIEWS
DRAWN:- NMN DATE:-11-07-2025 CHK.D:- RAG DATE:-11-14-2025

SHOP BILL	WORK ORDER NO.	DRWG. NO.
	2553	E102

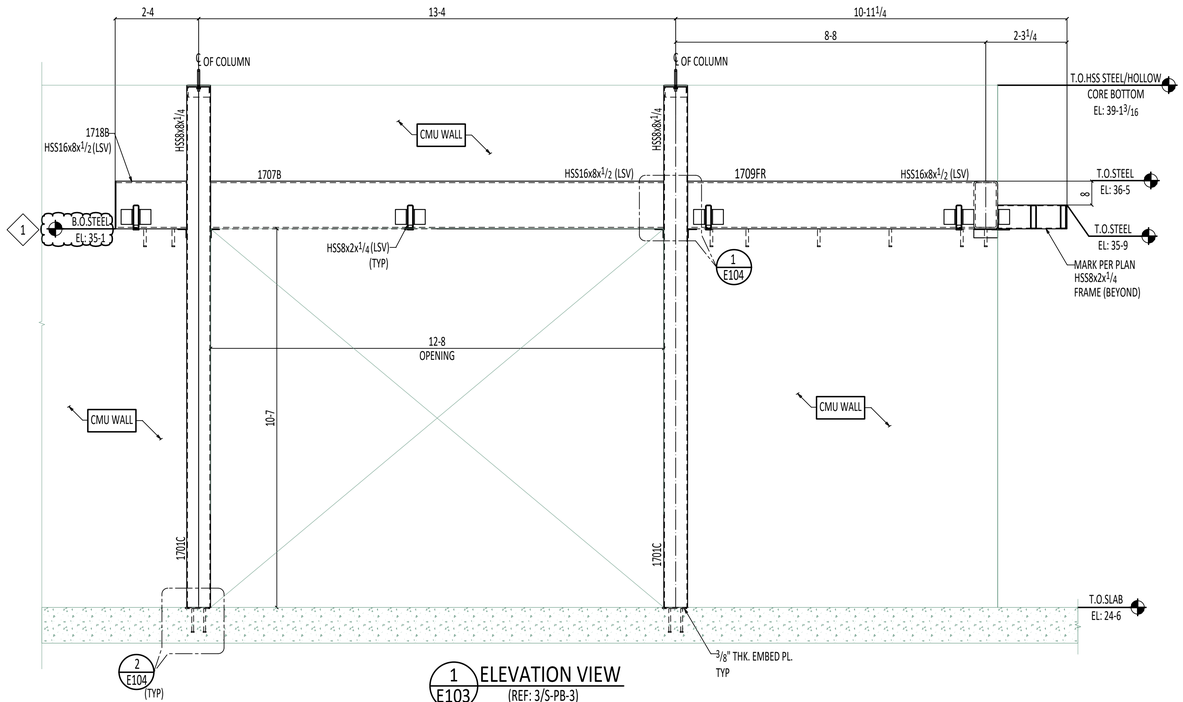

1 E103 ELEVATION VIEW
(REF: 3/S-PB-3)
(OTHERS NOT SHOWN FOR CLARITY)

1 -GC TO CONFIRM THE BOTTOM OF STEEL ELEVATION WITH STOREFRONT & CONCRETE CURB MANUFACTURER.

LEGEND:
LSV - INDICATES LONG SIDE VERTICAL

REFERENCE : S-PB-3 & A-PB-03

APPROVER NOTE:
ALL CLOUDED INFORMATION NOT VERIFIED/CONFIRMED ON RETURNED APPROVAL SUBMITTAL WILL BE CONSIDERED APPROVED AS DETAILED.

AISC CERTIFIED FABRICATOR AND ERECTOR

FIELD CONNECTIONS :
HOLES : 13/16" U.N.O
PAINT :


morrow steel Fabricators, Inc.

3620 COPELAND DRIVE
ZEPHYRHILLS, FL. 33542

	PRINTS FOR	DATE	MK	REVISIONS	DATE
			0	RELEASED FOR APPROVAL	Nov 18 2025
			1	RELEASED FOR RE-APPROVAL	Jul 13 2026
			2	RELEASED FOR RE-APPROVAL	Aug 26 2026


STRUCTURE:- PINELLAS SUNCOAST TRANSIT AUTHORITY
LOCATION:- CLEARWATER STATION,CLEARWATER,FL.
DETAILER:- VECTORSHADES LLC
CUSTOMER:- KOKOLAKIS
ARCH./ENG.:- CDM SMITH
DESCRIPTION:- WAITING PAVILION BUILDING ELEVATION VIEW
DRAWN:- NMN DATE:-11-07-2025 CHK.D:- RAG DATE:-11-14-2025

SHOP BILL	WORK ORDER NO.	DRWG. NO.
	2553	E103 1

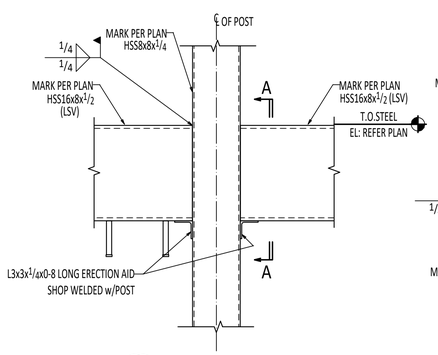


1 E104 DETAIL VIEW
(REF: B/S-SD-5)
(OTHERS NOT SHOWN FOR CLARITY)


ERECTOR NOTE:
REMOVE ERECTION AID ANGLE AFTER ERECTION OF HSS BEAM

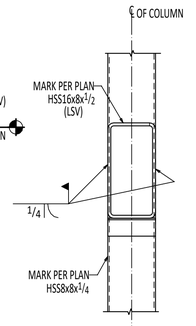


SECTION A-A

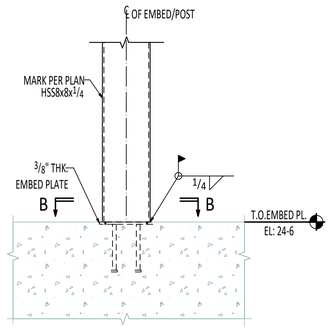


2 E104 DETAIL VIEW
(REF: A/S-SD-5)
(OTHERS NOT SHOWN FOR CLARITY)

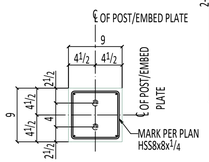


SECTION B-B

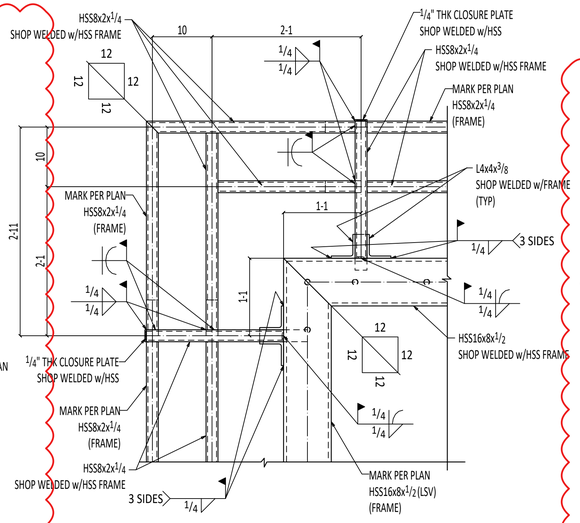


3 E104 DETAIL VIEW
(REF: A/S-PB-1)
(OTHERS NOT SHOWN FOR CLARITY)

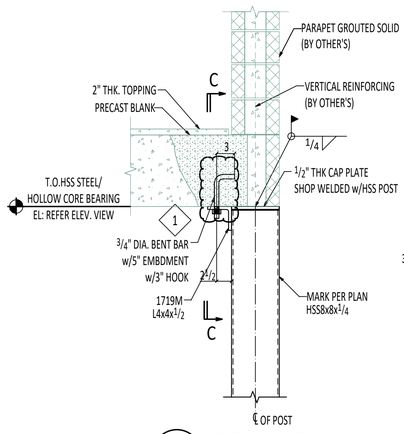


4 E104 SECTION VIEW
(REF: 4/S-PB-3)
(OTHERS NOT SHOWN FOR CLARITY)

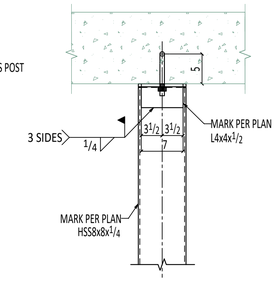


SECTION C-C

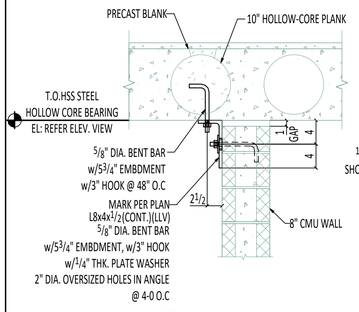


5 E104 SECTION VIEW
(REF: H/S-SD-4)
(OTHERS NOT SHOWN FOR CLARITY)

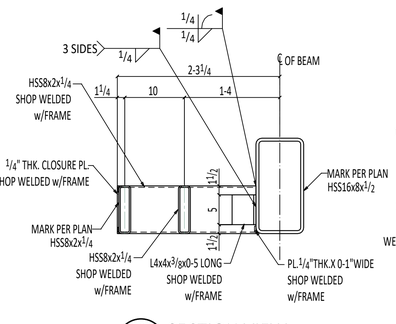


6 E104 SECTION VIEW
(REF: 5/S-PB-3)
(OTHERS NOT SHOWN FOR CLARITY)

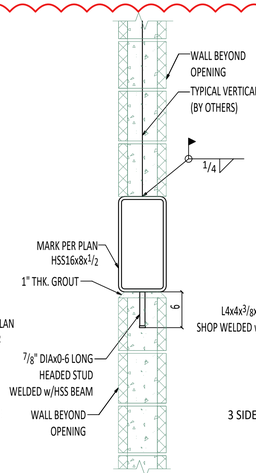

7 E104 SECTION VIEW
(REF: K/S-SD-3)
(OTHERS NOT SHOWN FOR CLARITY)

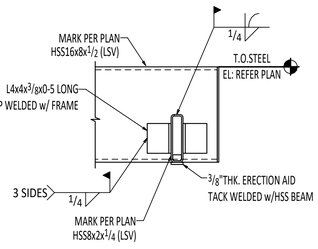


8 E104 SECTION VIEW
(REF: 5/S-PB-3)
(OTHERS NOT SHOWN FOR CLARITY)

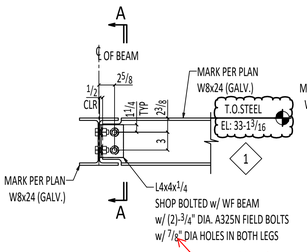


9 E104 SECTION VIEW
(REF: 7/S-PB-1)
(OTHERS NOT SHOWN FOR CLARITY)


Use the standard hole 13/16" diameter per Table J3.3 of AISC 360

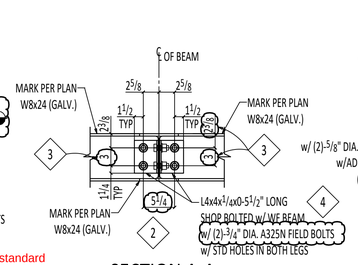

SECTION A-A

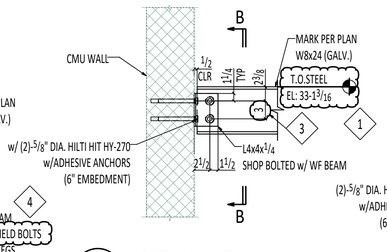

10 E104 SECTION VIEW
(REF: 6/S-PB-1)
(OTHERS NOT SHOWN FOR CLARITY)

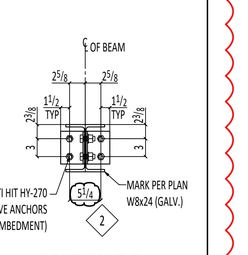

SECTION B-B

APPROVER PLEASE REVIEW AND CONFIRM THE FOLLOWING ITEMS:

1. - PLEASE VERIFY AND CONFIRM THE TOP OF BEAM ELEVATION WITH FINAL APPROVED TRANSFORMER COORDINATION DRAWINGS.
   Contractor to coordinate with the selected transformer manufacturer
2. IF WE MAINTAIN A 1 1/2" EDGE DISTANCE, THE RESULTING HOLE C/C DIMENSION WILL BE 5 1/4", AS SHOWN. PLEASE CONFIRM WHETHER THIS IS ACCEPTABLE.
   It is acceptable
3. IF WE FOLLOW 4" BOLT SPACING PER CD, THNE THE ANGLE WILL CLASH WITH BEAM K VALUE. HENCE WE FOLLOWED 3" SPACING. PLEASE CONFIRM WHETHER THIS IS ACCEPTABLE.
   If 4" spacing is maintained, there will be a slight clash with the beam root radius which should be fine. But the bolt spacing can be reduced to 3 1/2" to avoid the conflict with the root radius.
4. AS PER STANDARD PRACTICE, WE HAVE USED 3/4" DIA. BOLTS INSTEAD OF THE 5/8" DIA. BOLTS SHOWN IN THE CD. PLEASE CONFIRM WHETHER THIS IS ACCEPTABLE.
   It is acceptable

LEGEND:
LSV - INDICATES LONG SIDE VERTICAL

REFERENCE : S-SD-3, S-SD-4, S-SD-5, S-PB-1 & S-PB-3

AISC CERTIFIED FABRICATOR AND ERECTOR

FIELD CONNECTIONS :
HOLES : 13/16" U.N.O
PAINT :


morrow steel Fabricators, Inc.


3620 COPELAND DRIVE
ZEPHYRHILLS, FL. 33542

	PRINTS FOR	DATE	MK	REVISIONS	DATE
			0	RELEASED FOR APPROVAL	Nov 18 2025
			1	RELEASED FOR RE-APPROVAL	Jul 13 2026
			2	RELEASED FOR RE-APPROVAL	Aug 26 2026

STRUCTURE:-	PINELLAS SUNCOAST TRANSIT AUTHORITY
LOCATION:-	CLEARWATER STATION,CLEARWATER,FL.
DETAILER:-	VECTORSHADES LLC
CUSTOMER:-	KOKOLAKIS
ARCH./ENG.:-	CDM SMITH
DESCRIPTION:-	WAITING PAVILION BUILDING SECTION VIEWS
DRAWN:- NMN	DATE:-11-07-2025 CHK.D:- RAG DATE:-11-14-2025


SHOP BILL	WORK ORDER NO.	DRWG. NO.
	2553	E104

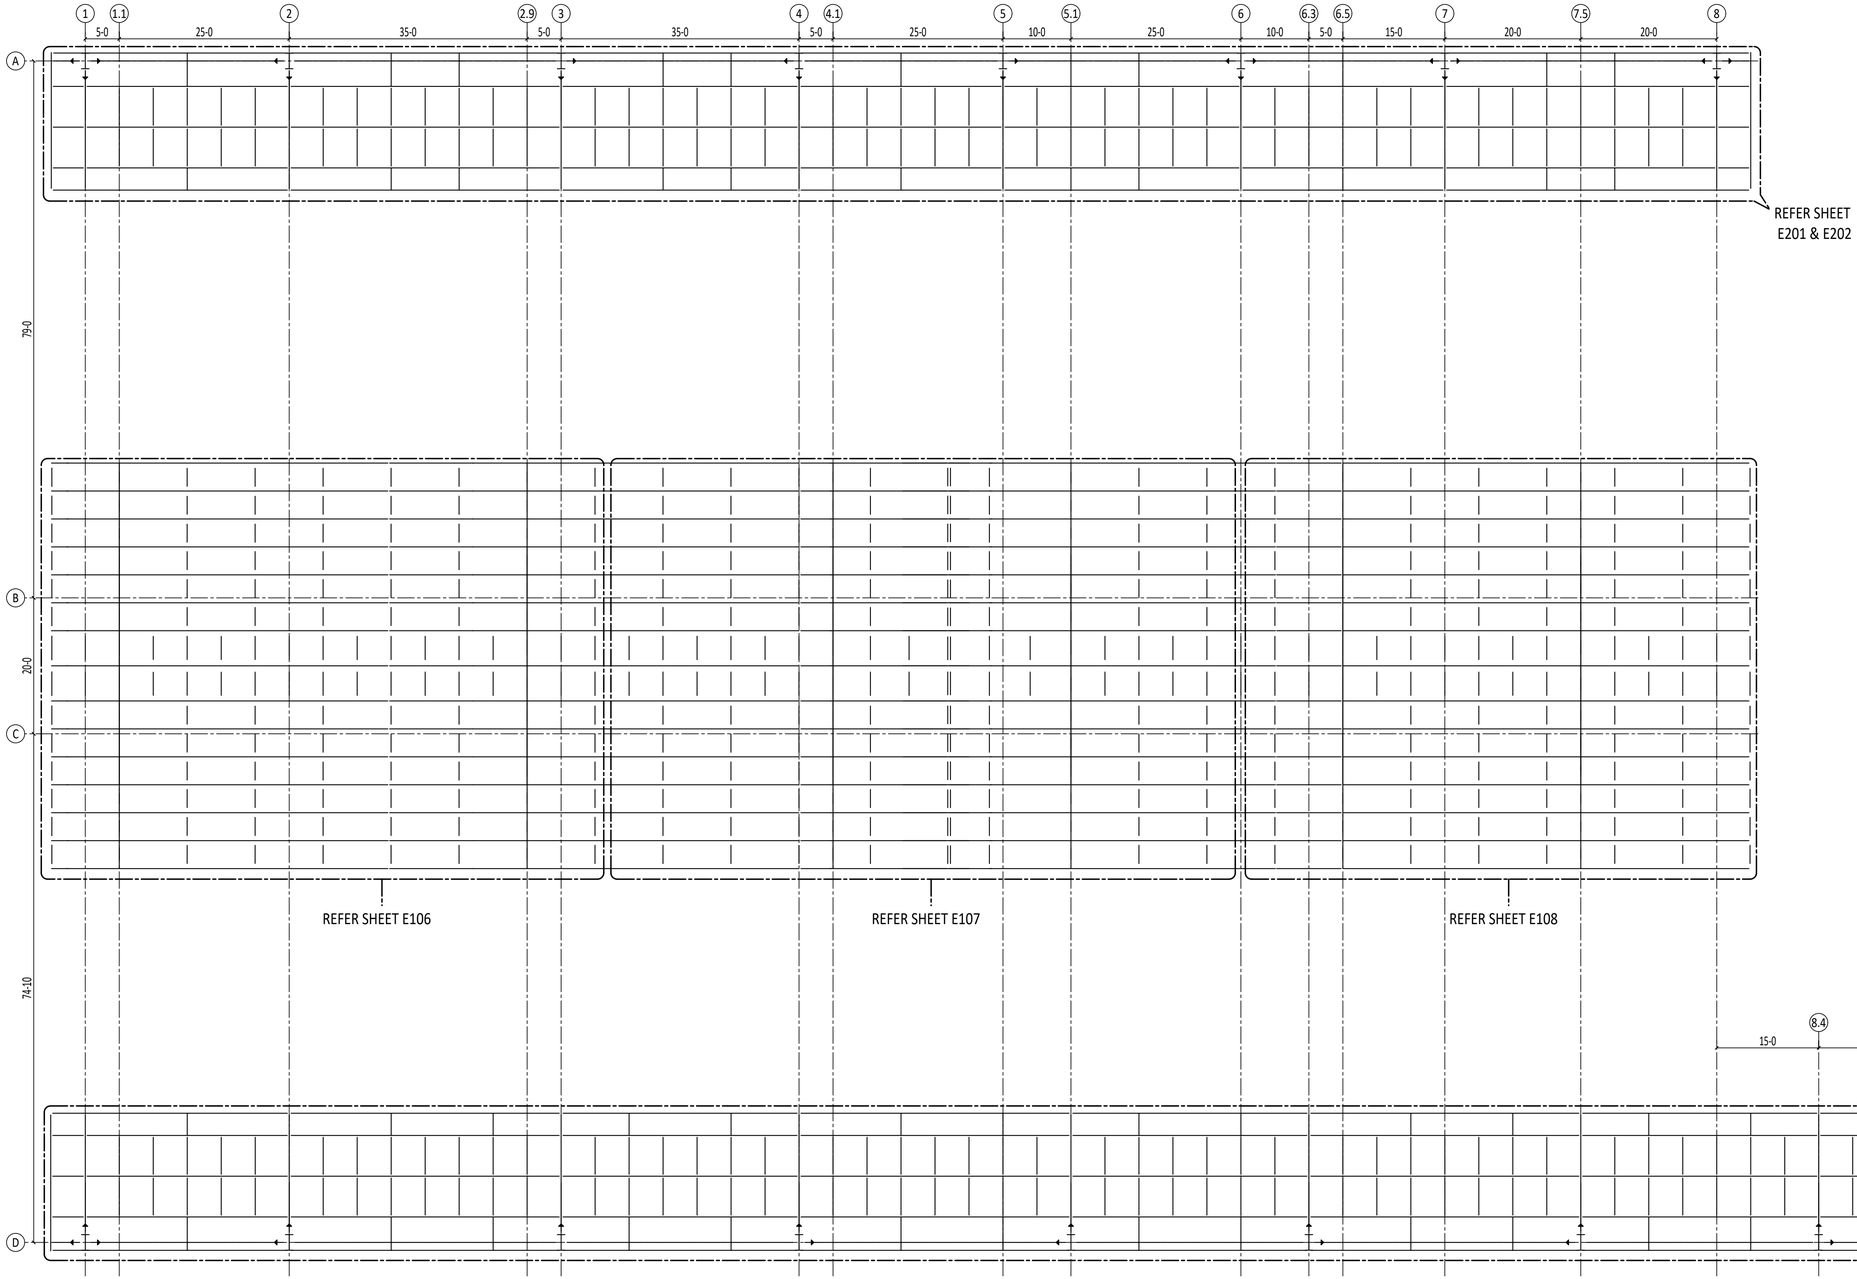

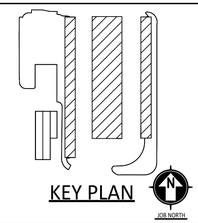

OVERALL ROOF FRAMING PLAN

(REF: S-CP-2)

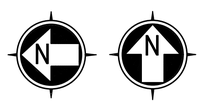

REFERENCE : S-CP-2

FIELD CONNECTIONS : _____
HOLES : 13/16" U.N.O
PAINT : _____


morrow steel Fabricators, Inc.

3620 COPELAND DRIVE
ZEPHYRHILLS, FL. 33542

	PRINTS FOR	DATE	MK	REVISIONS	DATE
			0	RELEASED FOR APPROVAL	Nov 18 2025
			1	RELEASED FOR RE-APPROVAL	Jul 13 2026
			2	RELEASED FOR RE-APPROVAL	Aug 26 2026

STRUCTURE:- PINELLAS SUNCOAST TRANSIT AUTHORITY
LOCATION:- CLEARWATER STATION,CLEARWATER,FL.
DETAILER:- VECTORSHADES LLC
CUSTOMER:- KOKOLAKIS
ARCH./ENG.:- CDM SMITH
DESCRIPTION:- OVERALL ROOF FRAMING PLAN
DRAWN:- SHR DATE:-10-09-2025 CHK.D:- RAG DATE:-10-10-2025

SHOP BILL	WORK ORDER NO.	DRWG. NO.
	2553	E105 1

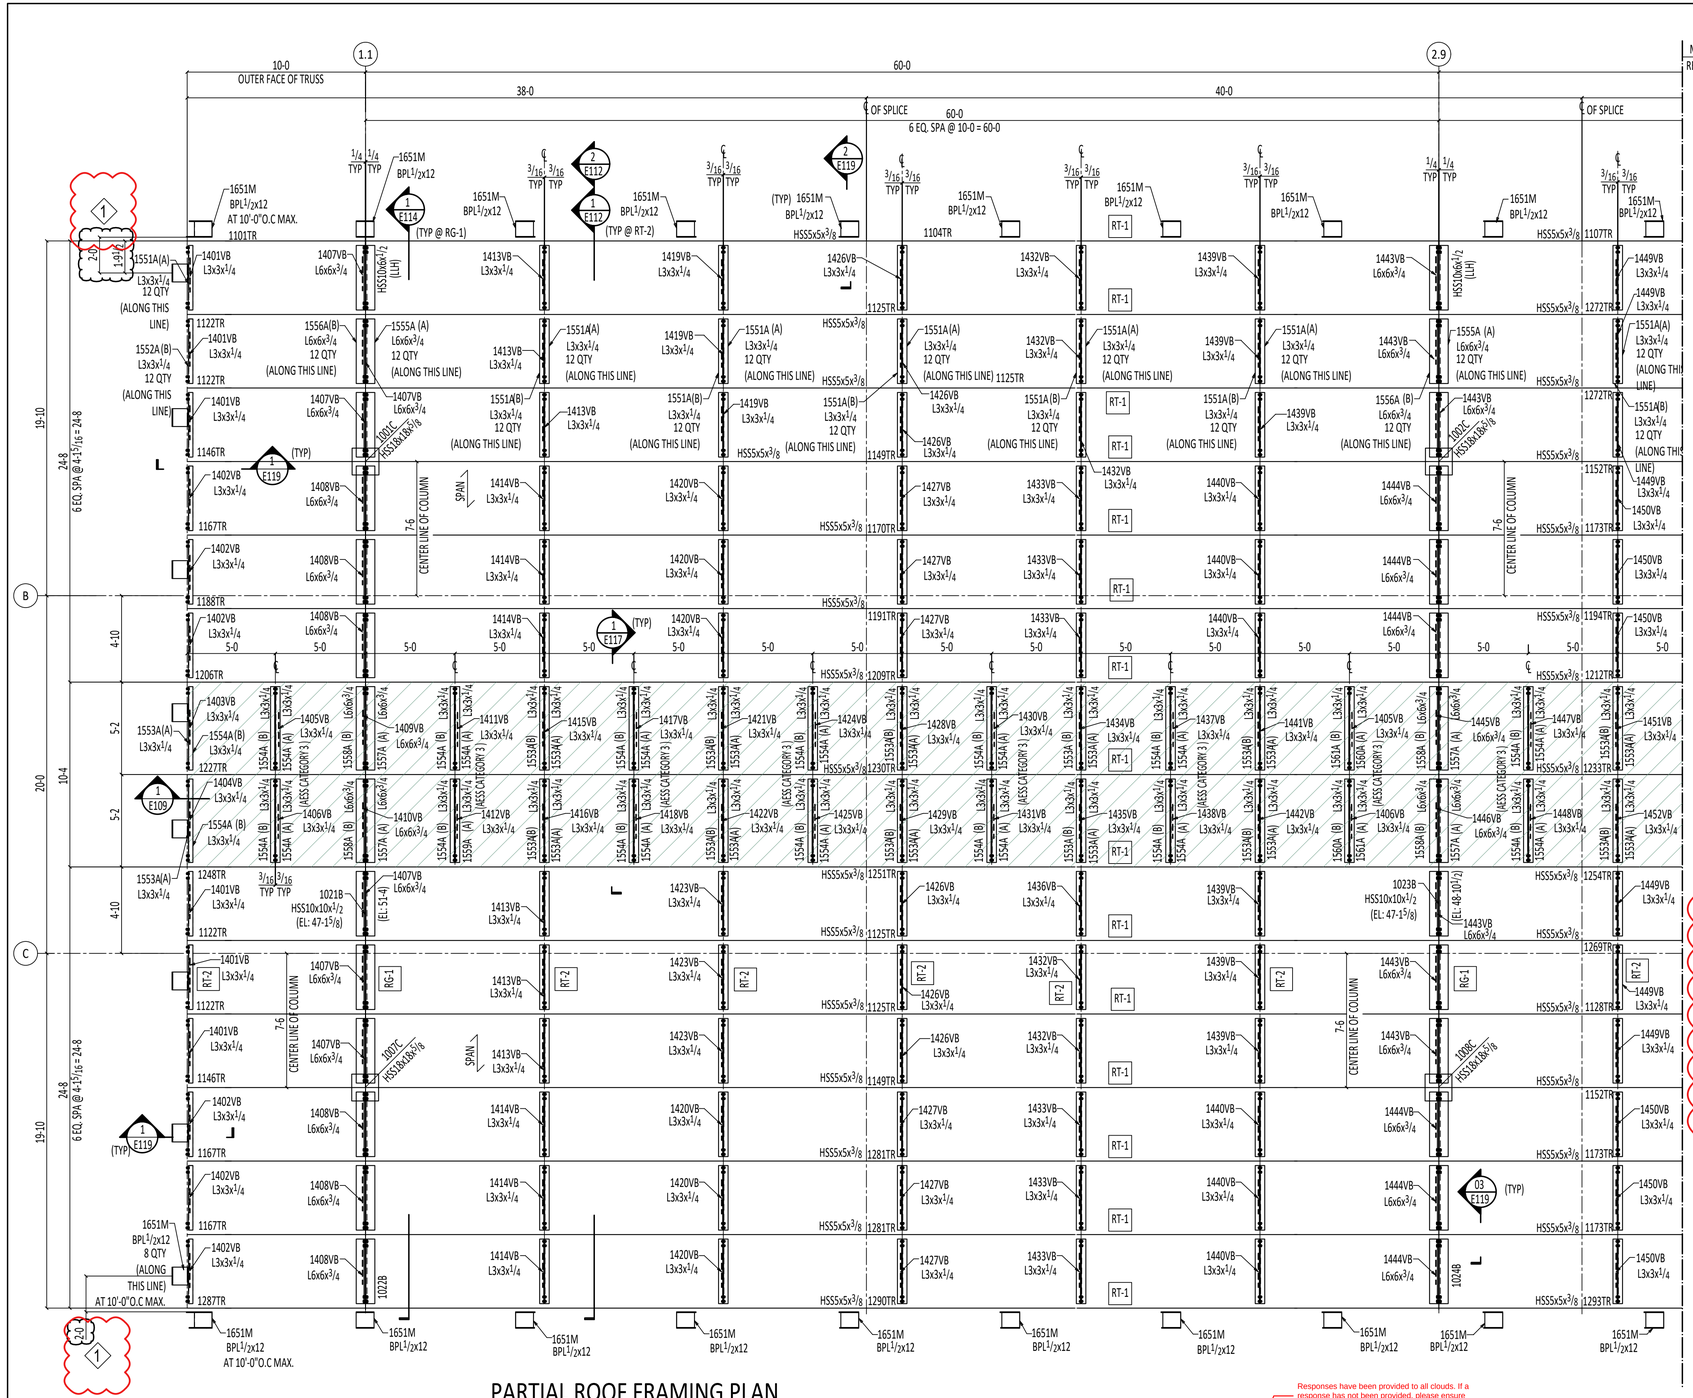

PARTIAL ROOF FRAMING PLAN

NOTE: (REF: S-CP-2 & S-CP-3)

- TOP OF STEEL EL: REFER E109 TO E111.
- SPAN INDICATES 1.5 B18 GALVANIZED METAL DECK.
- – – – INDICATES VERTICAL BRACE.
- FOR ELEVATION VIEWS REFER SHEET E109 TO E111.
- FOR TYPICAL SECTIONS REFER SHEET E118.
- FOR SECTIONS AND DETAILS REFER SHEET E119 & E120.

TRUE NORTH JOB NORTH

Responses have been provided to all clouds. If a response has not been provided, please ensure Engineer is aware to respond to.

APPROVER NOTE:
ALL CLOUDED INFORMATION NOT VERIFIED/CONFIRMED ON RETURNED APPROVAL SUBMITTAL WILL BE CONSIDERED APPROVED AS DETAILED.

READ THIS DRAWING IN CONJUNCTION WITH E107 & E108

LEGEND:
(A) - INDICATES ABOVE
(B) - INDICATES BELOW
LLH- LONG LEG HORIZONTAL
E.J- EXPANSION JOINT

REFERENCE : S-CP-2 & S-CP-3

AISC CERTIFIED FABRICATOR AND ERECTOR

FIELD CONNECTIONS :
HOLES : 13/16" U.N.O
PAINT :


morrow steel Fabricators, Inc.

3620 COPELAND DRIVE
ZEPHYRHILLS, FL. 33542

	PRINTS FOR	DATE	MK	REVISIONS	DATE
			0	RELEASED FOR APPROVAL	Nov 18 2025
			1	RELEASED FOR RE-APPROVAL	Jul 13 2026
			2	RELEASED FOR RE-APPROVAL	Aug 26 2026

STRUCTURE:-	PINELLAS SUNCOAST TRANSIT AUTHORITY
LOCATION:-	CLEARWATER STATION,CLEARWATER,FL.
DETAILER:-	VECTORSHADES LLC
CUSTOMER:-	KOKOLAKIS
ARCH./ENG.:-	COM SMITH
DESCRIPTION:-	PARTIAL ROOF FRAMING PLAN AT WAVE CANOPY
DRAWN:- SPK	DATE:-11-07-2025 CHK.D:- RAG DATE:-11-14-2025

SHOP BILL	WORK ORDER NO.	DRWG. NO.
	2553	E106

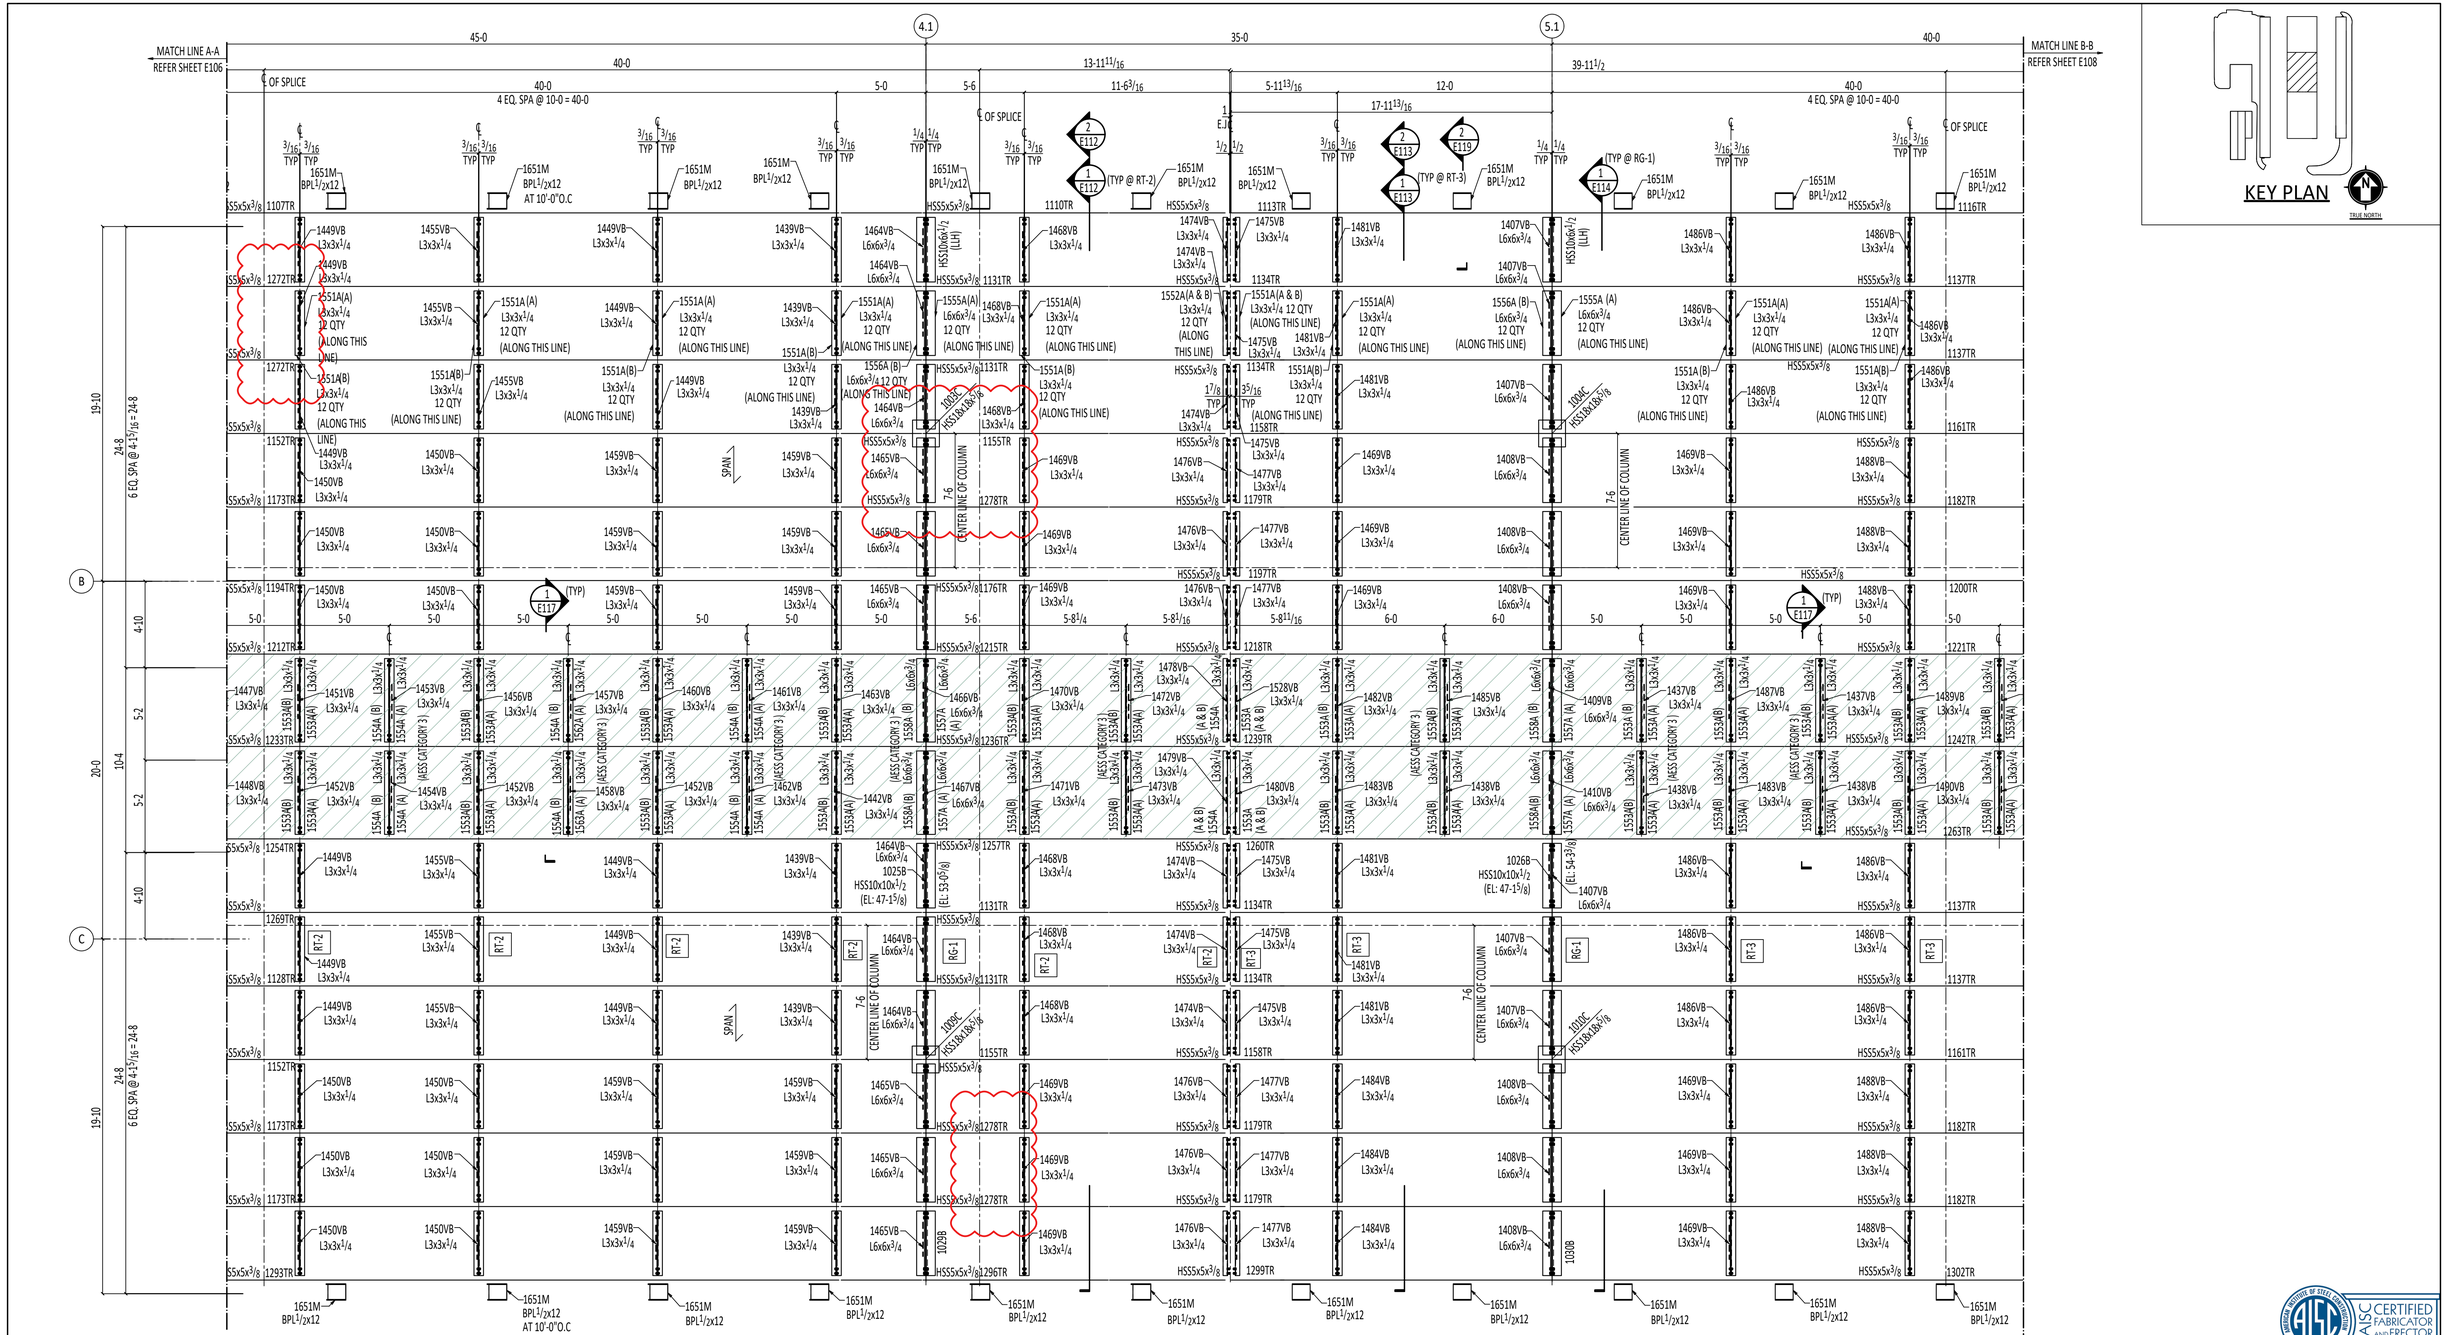

PARTIAL ROOF FRAMING PLAN

(REF: S-CP-2 & S-CP-3)

NOTE:

- TOP OF STEEL EL: REFER E109 TO E111.
- SPAN → INDICATES 1.5 B18 GALVANIZED METAL DECK.
- – – – INDICATES VERTICAL BRACE.
- FOR ELEVATION VIEWS REFER SHEET E109 TO E111.
- FOR TYPICAL SECTIONS REFER SHEET E118.
- FOR SECTIONS AND DETAILS REFER SHEET E119 & E120.

TRUE NORTH

JOB NORTH

READ THIS DRAWING IN CONJUNCTION WITH E106 & E108

REFERENCE : S-CP-2 & S-CP-3

LEGEND:
(A) - INDICATES ABOVE
(B) - INDICATES BELOW
LLH- LONG LEG HORIZONTAL
E.J- EXPANSION JOINT

FIELD CONNECTIONS :
HOLES : 13/16" U.N.O
PAINT :

morrow steel Fabricators, Inc.

AISC CERTIFIED FABRICATOR AND ERECTOR

3620 COPELAND DRIVE
ZEPHYRHILLS, FL. 33542


	PRINTS FOR	DATE	MK	REVISIONS	DATE
			0	RELEASED FOR APPROVAL	Nov 18 2025
			1	RELEASED FOR RE-APPROVAL	Jul 13 2026
			2	RELEASED FOR RE-APPROVAL	Aug 26 2026

STRUCTURE:- PINELLAS SUNCOAST TRANSIT AUTHORITY
LOCATION:- CLEARWATER STATION,CLEARWATER,FL.
DETAILER:- VECTORSHADES LLC
CUSTOMER:- KOKOLAKIS
ARCH./ENG.:- CDM SMITH
DESCRIPTION:- PARTIAL ROOF FRAMING PLAN AT WAVE CANOPY
DRAWN:- SPK DATE:-11-07-2025 CHK.D:- RAG DATE:-11-14-2025

SHOP BILL	WORK ORDER NO.	DRWG. NO.
	2553	E107

MATCH LINE B-B
REFER SHEET E107


6.5
7.5
8
B
C
40-0
35-0
20-0
5-0
25-0
38-0
30-0
3 EQ. SPA @ 10-0 = 30-0
5-0
10-0
OF SPLICE
1651M BPL1/2x12
1116TR
1137TR
1140TR
1119TR
1161TR
1182TR
1200TR
1221TR
1242TR
1263TR
1284TR
1164TR
1185TR
1224TR
1245TR
1266TR
1143TR
1275TR
1203TR
1302TR
1493VB L3x3x1/4
1497VB L6x6x3/4
HSS10x6x1/2 (LLH)
1501VB L3x3x1/4
1506VB L3x3x1/4
1511VB L6x6x3/4
1515VB L3x3x1/4
1551A(B) L3x3x1/4 12 QTY (ALONG THIS LINE)
1551A(A) L3x3x1/4 12 QTY (ALONG THIS LINE)
1555A (A) L6x6x3/4 12 QTY (ALONG THIS LINE)
1564A(B) L6x6x3/4 12 QTY (ALONG THIS LINE)
1556A (B) L6x6x3/4 12 QTY (ALONG THIS LINE)
1486VB L3x3x1/4
1493VB L3x3x1/4
1494VB L3x3x1/4
1498VB L6x6x3/4
1507VB L3x3x1/4
1512VB L6x6x3/4
1516VB L3x3x1/4
1526VB L3x3x1/4
HSS5x5x3/8
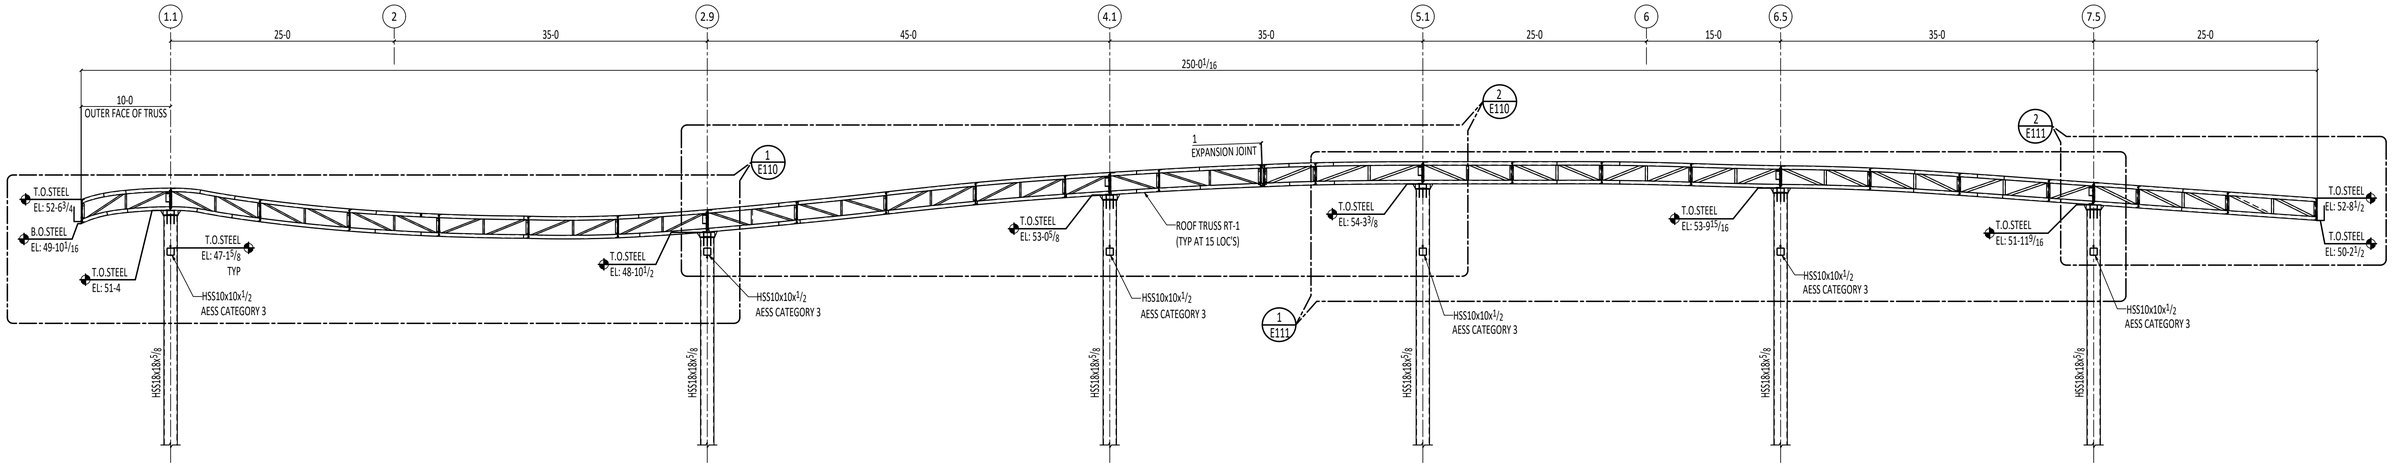

1 / E109 OVERALL ROOF TRUSS ELEVATION VIEW

(REF: 1/S-CP-4)

(OTHERS NOT SHOWN FOR CLARITY)

REFERENCE : S-CP-4

FIELD CONNECTIONS : _____

HOLES : 13/16" U.N.O

PAINT : _____

morrow steel Fabricators, Inc.


3620 COPELAND DRIVE
ZEPHYRHILLS, FL. 33542

AISC CERTIFIED FABRICATOR AND ERECTOR

	PRINTS FOR	DATE	MK	REVISIONS	DATE
			0	RELEASED FOR APPROVAL	Nov 18 2025
			1	RELEASED FOR RE-APPROVAL	Jul 13 2026
			2	RELEASED FOR RE-APPROVAL	Aug 26 2026

STRUCTURE:- PINELLAS SUNCOAST TRANSIT AUTHORITY
LOCATION:- CLEARWATER STATION,CLEARWATER,FL.
DETAILER:- VECTORSHADES LLC
CUSTOMER:- KOKOLAKIS
ARCH./ENG.:- CDM SMITH
DESCRIPTION:- OVERALL ROOF TRUSS ELEVATION VIEWS
DRAWN:- SHR DATE:- 11-10-2025 CHK.D:- RAG DATE:- 11-11-2025


SHOP BILL	WORK ORDER NO.	DRWG. NO.
	2553	E109 △

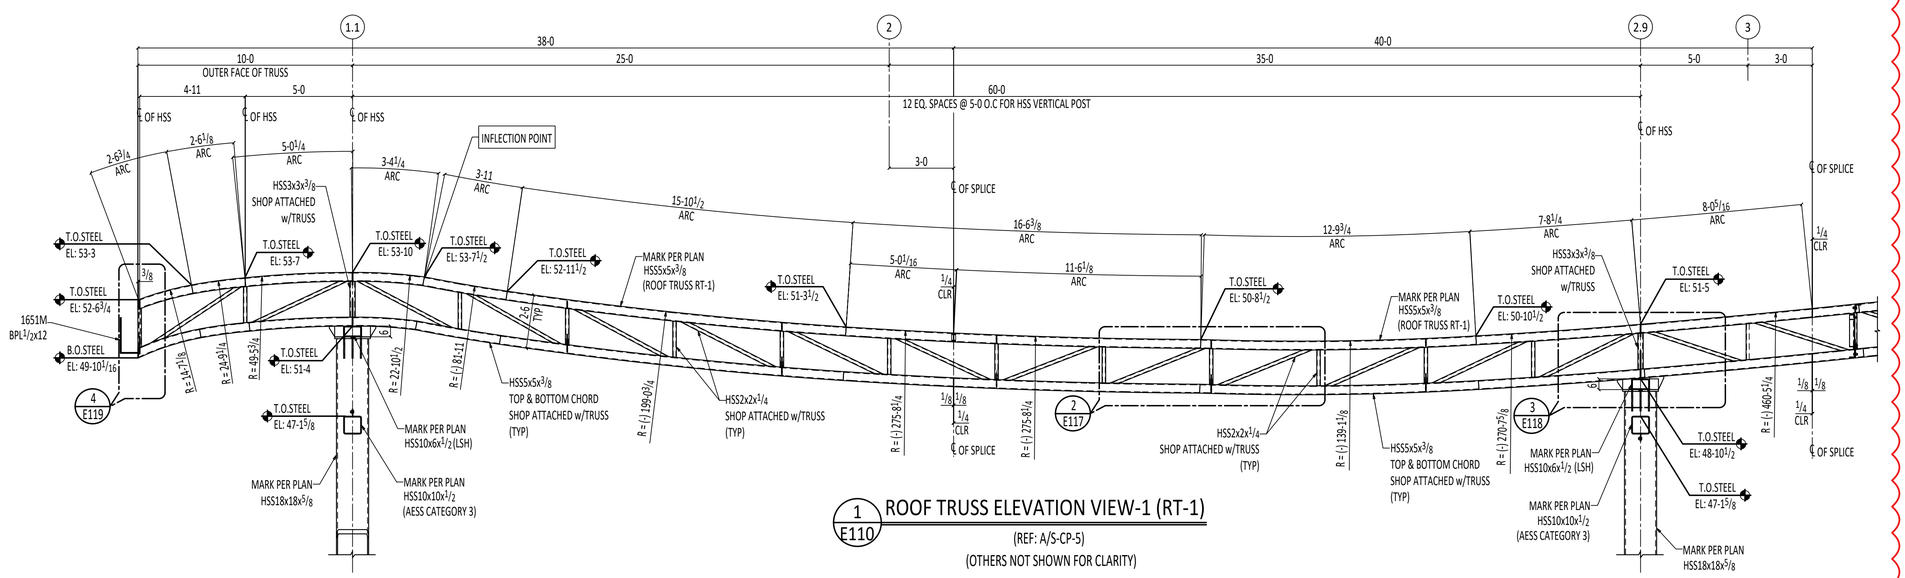

1 E110 ROOF TRUSS ELEVATION VIEW-1 (RT-1)

(REF: A/S-CP-5)

(OTHERS NOT SHOWN FOR CLARITY)

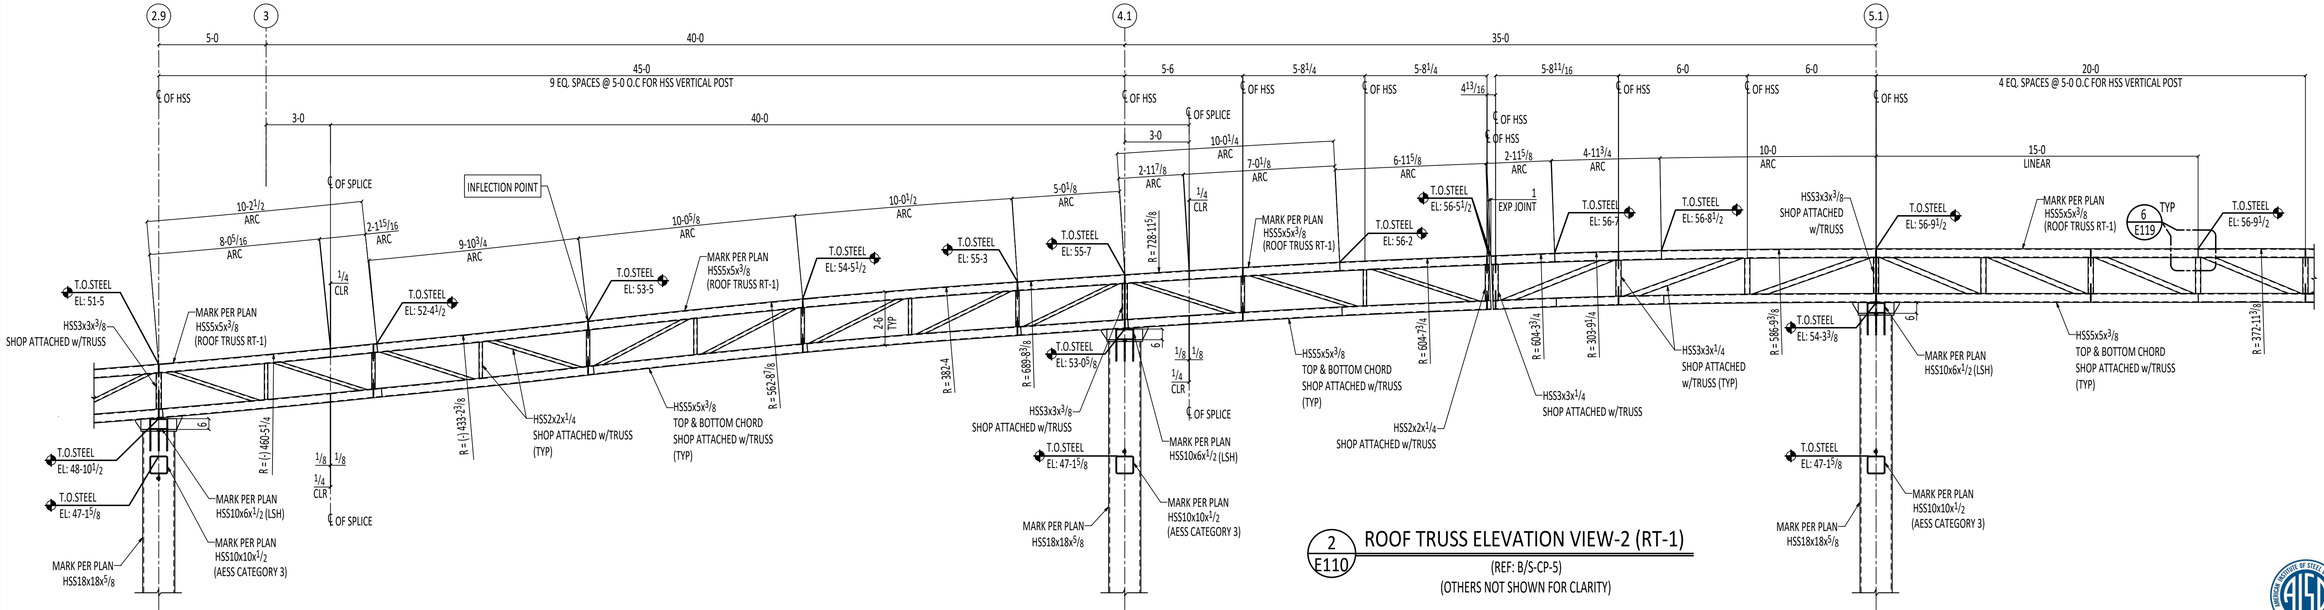

2 E110 ROOF TRUSS ELEVATION VIEW-2 (RT-1)

(REF: B/S-CP-5)

(OTHERS NOT SHOWN FOR CLARITY)

REFERENCE : S-CP-4, 5 & 6

FIELD CONNECTIONS : ———

HOLES : 13/16" U.N.O

PAINT : ———


morrow steel Fabricators, Inc.

3620 COPELAND DRIVE
ZEPHYRHILLS, FL. 33542

	PRINTS FOR	DATE	MK	REVISIONS	DATE
			0	RELEASED FOR APPROVAL	Nov 18 2025
			1	RELEASED FOR RE-APPROVAL	Jul 13 2026
			2	RELEASED FOR RE-APPROVAL	Aug 26 2026


STRUCTURE:- PINELLAS SUNCOAST TRANSIT AUTHORITY
LOCATION:- CLEARWATER STATION,CLEARWATER,FL.
DETAILER:- VECTORSHADES LLC
CUSTOMER:- KOKOLAKIS
ARCH./ENG.:- CDM SMITH
DESCRIPTION:- ROOF TRUSS ELEVATION VIEWS
DRAWN:- SHR DATE:- 11-10-2025 CHK.D:- RAG DATE:- 11-11-2025

SHOP BILL	WORK ORDER NO.	DRWG. NO.
	2553	E110 ⚠2

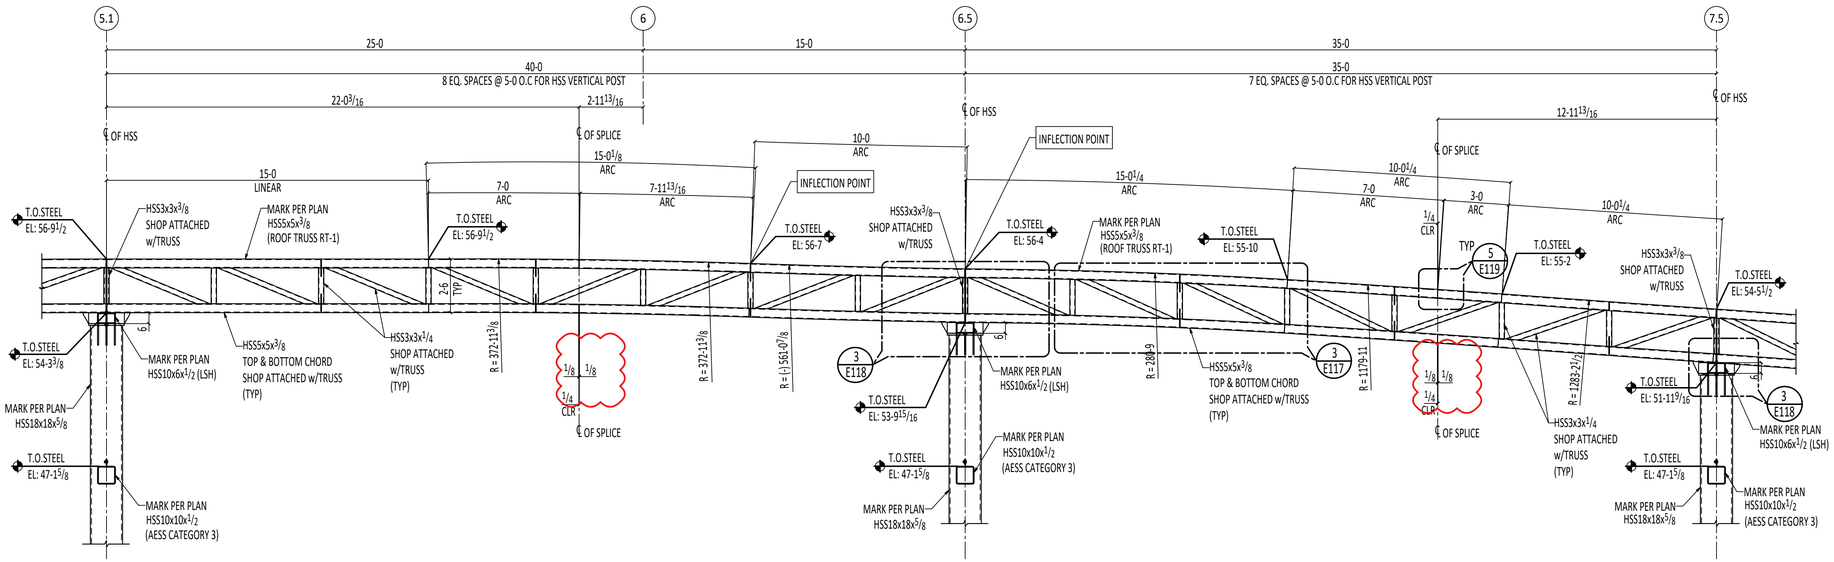

1 E111 ROOF TRUSS ELEVATION VIEW-3 (RT-1)

(REF: C/S-CP-5)
(OTHERS NOT SHOWN FOR CLARITY)

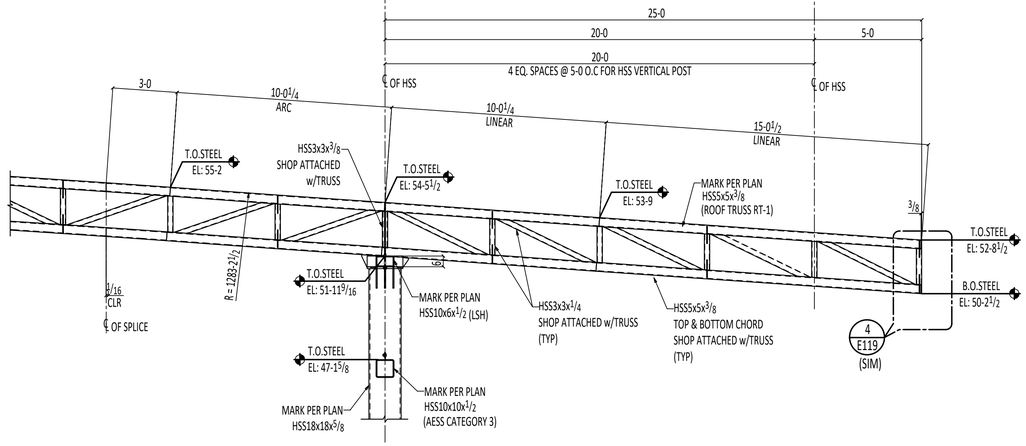

2 E111 ROOF TRUSS ELEVATION VIEW-4 (RT-1)

(REF: D/S-CP-6)
(OTHERS NOT SHOWN FOR CLARITY)

REFERENCE : S-CP-4, 5 & 6

FIELD CONNECTIONS :
HOLES : 13/16" U.N.O
PAINT :

morrow steel Fabricators, Inc.


AISC CERTIFIED FABRICATOR AND ERECTOR

3620 COPELAND DRIVE
ZEPHYRHILLS, FL. 33542

	PRINTS FOR	DATE	MK	REVISIONS	DATE
			0	RELEASED FOR APPROVAL	Nov 18 2025
			1	RELEASED FOR RE-APPROVAL	Jul 13 2026
			2	RELEASED FOR RE-APPROVAL	Aug 26 2026

STRUCTURE:- PINELLAS SUNCOAST TRANSIT AUTHORITY
LOCATION:- CLEARWATER STATION,CLEARWATER,FL.
DETAILER:- VECTORSHADES LLC
CUSTOMER:- KOKOLAKIS
ARCH./ENG.:- CDM SMITH
DESCRIPTION:- ROOF TRUSS ELEVATION VIEWS
DRAWN:- SHR DATE:- 11-10-2025 CHK.D:- RAG DATE:- 11-11-2025


SHOP BILL	WORK ORDER NO.	DRWG. NO.
	2553	E111

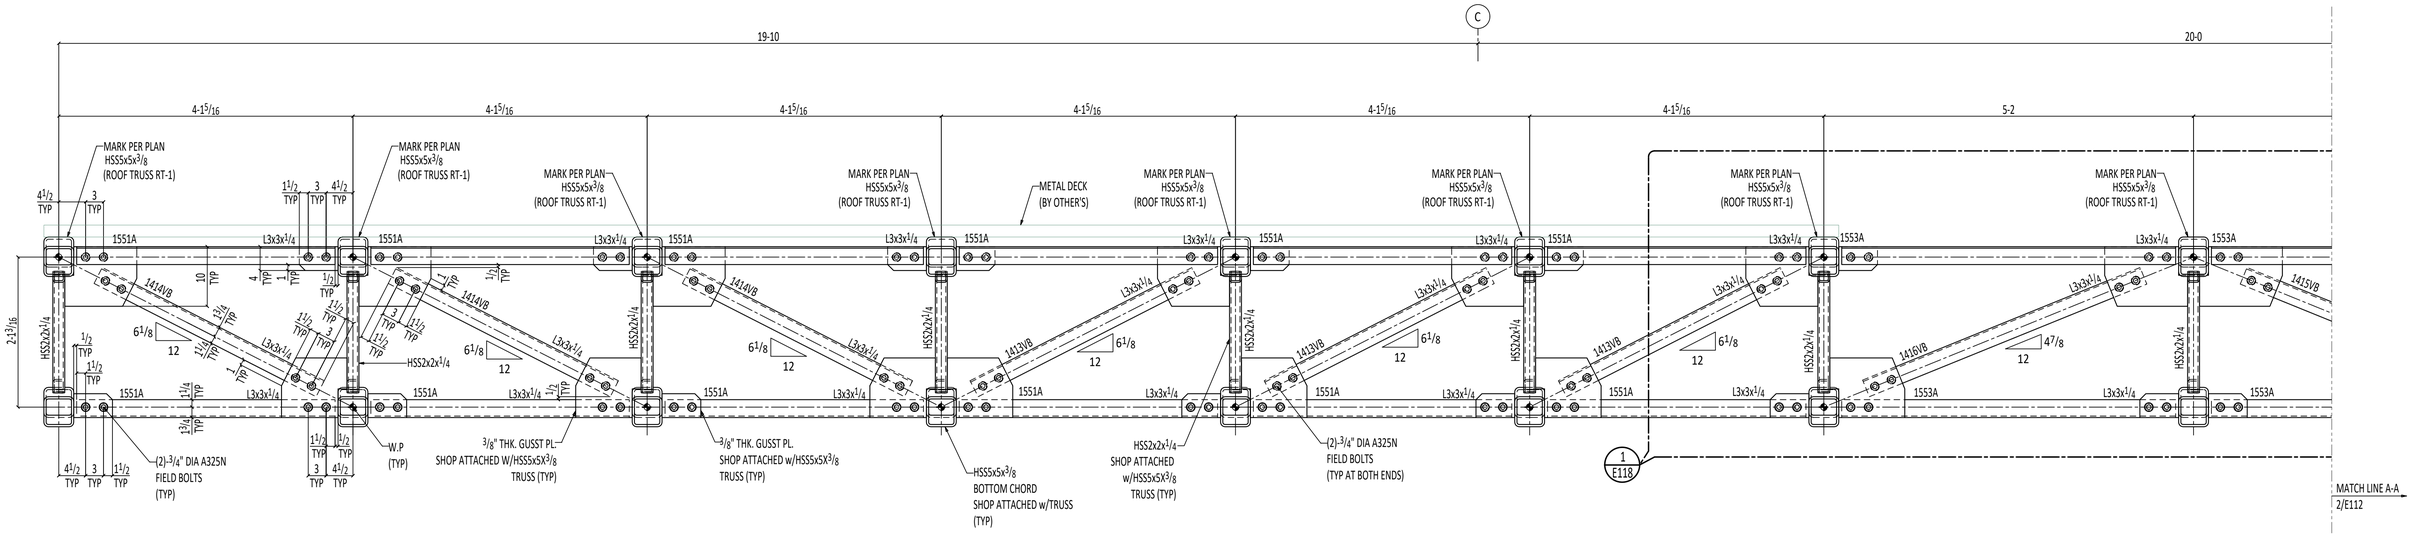

ROOF TRUSS ELEVATION VIEW-RT-2
TYPICAL AT NORTH OF EXPANSION JOINT

1 / E112

(REF: 1/S-CP-6)
(OTHERS NOT SHOWN FOR CLARITY)

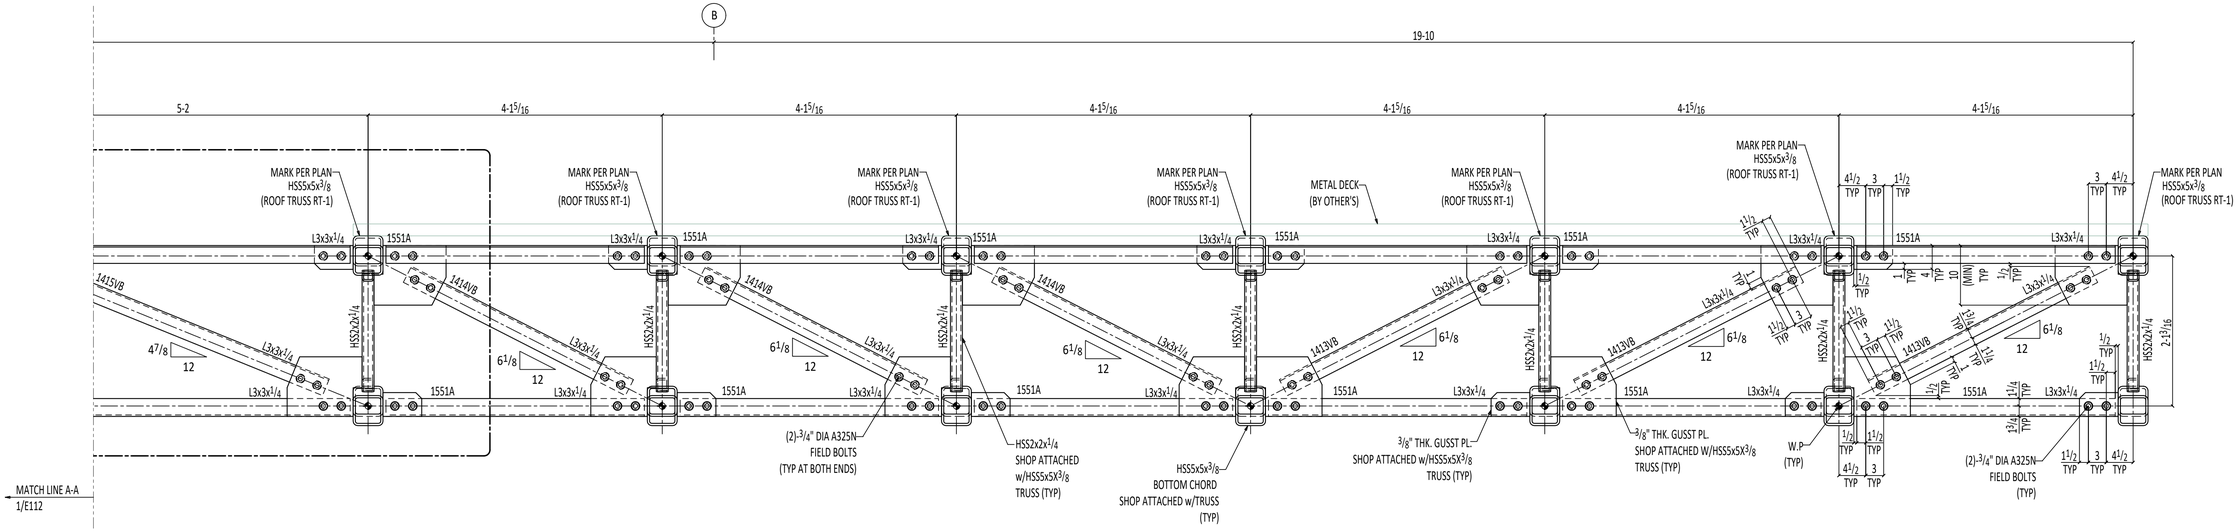

ROOF TRUSS ELEVATION VIEW-RT-2
TYPICAL AT NORTH OF EXPANSION JOINT

2 / E112

(REF: 1/S-CP-6)
(OTHERS NOT SHOWN FOR CLARITY)

REFERENCE : 1/S-CP-6

FIELD CONNECTIONS :
HOLES : 13/16" U.N.O
PAINT :

morrow steel Fabricators, Inc.

AISC CERTIFIED FABRICATOR AND ERECTOR

3620 COPELAND DRIVE
ZEPHYRHILLS, FL. 33542

	PRINTS FOR	DATE	MK	REVISIONS	DATE
			0	RELEASED FOR APPROVAL	Nov 18 2025
			1	RELEASED FOR RE-APPROVAL	Jul 13 2026
			2	RELEASED FOR RE-APPROVAL	Aug 26 2026

STRUCTURE:- PINELLAS SUNCOAST TRANSIT AUTHORITY
LOCATION:- CLEARWATER STATION,CLEARWATER,FL.
DETAILER:- VECTORSHADES LLC
CUSTOMER:- KOKOLAKIS
ARCH./ENG.:- CDM SMITH
DESCRIPTION:- ROOF TRUSS ELEVATION VIEWS
DRAWN:- SHR DATE:- 11-10-2025 CHK.D:- RAG DATE:- 11-11-2025

SHOP BILL	WORK ORDER NO.	DRWG. NO.
	2553	E112 1