Transmittal
Submittal Review Response

101 Southhall Lane, Suite 200
Maitland, Fl 32751
407.660.2552 Phone
407.875.1161 Fax

Date: 9/9/2026

To: **Contractor**
Kokolakis Contracting
202 East Center Street
Tarpon Springs, FL 34689
Attention: Cameron Champaigne

Re: **Project No.:** 253117-261237
Project Name: PSTA Clearwater Multimodal Transit Center
Client: Pinellas Suncoast Transit Authority

Transmitted herewith is (are)...

☐ *Hard Copy(ies)*	**Sent via:**	☐ *Mail*	☐ *Overnight*	☐ *Courier*
☒ *Digital*		☐ Email	☐ FTP	☐ Cloud Delivery

Submittal No.: **S-051200-002-F**
Title or Description: **Structural Steel Framing Canopy & Pavilion**
Type of Submittal: **Shop Drawing** **If other**
Status
Review Code: Code 4: Approved As Noted; Resubmit
Other:
Review Comments:

1. Contractor shall provide a written response to each of the Engineer's review comments listed below.
2. Engineer notes that this is a resubmittal of S-051200-002-D (not E).
3. For additional comments see pdf entitled "S-051200-002-F - Structural Steel Framing Canopy & Pavilion_CDM Smith Comments.pdf". Effort has been made by Engineer to provide responses to all clouds. If a response has not been provided, please ensure Engineer is aware to respond to. Contractor shall refer to markups for all detailer queries that require Contractor confirmation/response. Markups and questions are also provided on individual member sheets. Many are repeat comments.
4. Contractor to confirm steel elevation on p. 6 of 231 with approved storefront (not yet submitted). Engineer confirms intent is met. This is a repeat comment and Contractor has indicated coordination to still be completed.
5. There is a mismatch between the dimensions and wave truss bend radii shown on the overall truss longitudinal drawings, E110 and E111, and those shown on the contract drawings and typical truss shop drawings, Drawing Nos. 1176 through 1200. Coordinate between the drawings and ensure that

Ben Harber

Signed

all dimensions and bend radii are consistent with and accurately reflect the requirements shown on the contract drawings.

6. As shown in Detail E, provide two stiffeners on each side of each HSS5x5-to-HSS10x6 connection not just at the column location, as indicated in Detail E/S-CP-8, at gridlines 1.1, 2.9, 4.1, 5.1, 6.5, and 7.5. An isometric view has been provided for clarity on E118. This is a repeat comment (previously only a pdf markup).
7. Some comments on the individual member sheets from the previous submittal remain unaddressed. Provide responses or revise the shop drawings as required for all individual members with comments. These have been repeated in the pdf markup.
8. Engineer notes that the typical truss erection drawing submitted is representative of all longitudinal trusses. Contractor shall ensure that all comments provided for the typical truss are incorporated into every longitudinal truss and verified prior to fabrication and construction. This is a repeat comment as engineer notes revisions to submittal (as noted above) are still required.
9. Erection drawings and erection calculations may be submitted for engineer review and final approval prior to erection. However, the contractor shall ensure that the original member sizes and connections remain adequate and are not affected by the proposed erection sequence. If any changes are required, the shop drawings shall be revised and resubmitted for review and approval. Members and connections shown on the contract drawings are designed for final in-place loading conditions. Contractor shall submit the erection sequence, lifting and temporary support details, and shoring plan for review and approval per AISC 303. Contractor shall be responsible for verifying, through signed and sealed calculations, that stresses on members and connections do not exceed their capacities during erection, including the use of proposed erection aids and temporary connections. A smooth surface finish shall be maintained after removal of erection aids at all locations, per Section 051213-3.3. This is a repeat comment as this is required for engineer's final approval and any steel being released for fabrication without this erection plan submitted for review is at Contractor's risk.
10. Contractor shall coordinate base plate thickness, bolt hole diameters, and bolt hole locations with submittal "S-051200-001-C - Anchor Bolts & Embeds Shop Drawings" (not yet fully approved). This is a repeat comment.
11. At Waiting Pavilion building, Contractor to coordinate with the selected transformer manufacturer to confirm the location of the transformer support beams, and transformer connection requirements. This is a repeat comment as Contractor has indicated to be coordinated. Contractor to confirm intent if planned to be coordinated in field, will require coordination with grouted/reinforced CMU.
12. Submit all required information as specified in Section 1.7. This is a repeat comment as only certain items have been submitted. This may be submitted under separate cover. Contractor to confirm intent and timeline on if submitted separately.
13. Submit product data for all the items listed in section 1.6.A of specification 05 12 13. This is a repeat comment. This may be submitted under separate cover. Contractor to confirm intent and timeline on if submitted separately.

Ben Harber

Signed

14. Submit the samples as requested in section 1.6.C of specification 05 12 13. This is a repeat comment. This may be submitted under separate cover. Contractor to confirm intent and timeline on if submitted separately.
15. Include all the items listed in section 1.6.B of specifications 05 12 13. This is a repeat comment. This may be submitted under separate cover. Contractor to confirm intent and timeline on if submitted separately.
16. Submit all required information as specified in Section 1.7 of specification 05 12 13. This is a repeat comment. This may be submitted under separate cover. Contractor to confirm intent and timeline on if submitted separately.
17. Submit test results and certificates of conformance for all heavy sections (flange thickness greater than 2 inches), demonstrating compliance with Section A3.1.1c of AISC 360-16, as indicated in the steel general notes on Sheet S-1. The column flanges at the side (east and west) canopies have thicknesses greater than 2 inches. Therefore, provide the requested certificates with this resubmittal or include them in the side canopy shop drawings and resubmit. Contractor to confirm. This is a repeat comment from the “A”, “C” and “D” submittals. Contractor to confirm intent and timeline on if submitted separately.
18. Cane rails shall be provided in accordance with Section 05 52 00. Contractor shall submit under a separate package if not included in the Morrow Steel scope. This is a repeat comment as detailer has also requested confirmation. Contractor to confirm intent and timeline on if submitted separately.
19. Contractor shall submit the roof framing connected stanchion at the wave canopy or confirm if will be submitted under separate cover. This is a repeat comment as coordination has not been provided and may affect submitted framing. Contractor to confirm intent and timeline on if submitted separately.
20. Contractor shall coordinate the location, size, and elevation of plates and associated connections to structural steel for the signage connection shown on Section 7/S-CP-9 with the approved signage submittal and connection requirements (not yet submitted), and with the column cover shown on architectural drawings (not yet submitted), prior to fabrication and construction. This is a repeat comment as detailer has also requested coordination. Contractor to confirm intent if planned to be coordinated in field.
21. Contractor shall coordinate the location, size, and elevation of plates and associated connections to structural steel for the lighting connection shown on Detail B/S-CP-9 with the selected lighting manufacturer for connection requirements, and with the column cover shown on architectural drawings (not yet submitted), prior to fabrication and construction. This is a repeat comment as detailer has also requested coordination. Contractor to confirm intent if planned to be coordinated in field.
22. Contractor shall coordinate all access hatch opening sizes and associated connection requirements with the approved hatch submittal (not yet submitted). This is a repeat comment as detailer is also requesting confirmation.
23. Contractor shall coordinate ladder connection locations with submittal “S-034113-001-A – (Delegated Design) Precast Concrete Hollow Core Planks” to avoid conflicts between ladder

Ben Harber

Signed

connections to hollow core planks and precast panel embed connections at openings at the retail/operations and waiting pavilion buildings. This is a repeat comment as coordination has not been provided and conflicts may exist.

24. Contractor shall submit product data for the ladder safety post (or confirm will be submitted under separate cover) for the Engineer's review and approval. This is a repeat comment as Contractor has indicated this is shown on shop drawings however it says "by others." Contractor to confirm intent and timeline on if submitted separately.
25. Submit product data for headed studs (page 44 of 52) separately. Specification 055000 indicates basis of design. This is a repeat comment as Contractor indicated they will submit separately under 055000 if required, it is required. Contractor to confirm intent and timeline on if submitted separately.
26. Contractor is responsible for confirming that project level Buy America Act requirements are met.
27. Submitted LEED information was not reviewed. Comments to be resolved by client's LEED consultant. N CDM Smith response.
28. Receipt acknowledge od drawing E121 Wave Canopy roof hatch. However, hatch location is not shown on E106 partial roof framing of wave canopy. Contractor to locate and properly adjust roof hatch on E106.
29. Comment 35 from the previous submittal remains unresolved and pertains to the roof hatch location at the Waiting Pavilion Building. As shown on Page 32 of 266, the roof hatch opening is currently located 7'-1" from the east exterior wall. At this location, the required ladder access and clear travel area overla the adjacent interior metal stud wall. Revise the roof hatch opening location by increasing the 7'-1" offset dimension as necessary to provide the required clearances and eliminate the conflict with the interior wall construction. Resubmit for review.
30. Previous submittal response to comments 31 through 33 indicate further coordination and follow up. Contractor to confirm intent and timeline on if submitted separately.

Location of the Review Comments: Attached to Submittal

Remarks:

Reviewed by: Pooja Kalaria, Esther Goldberg, Shannon Ketchum, Daniela Montoya

Ben Harber

Signed

Submittal #051200-7.1 051200 - Structural Steel Framing

Kokolakis Contracting
202 East Center Street
Tarpon Springs, Florida 34689
Phone: +17279422211

Project: 25-0264-01 - PSTA Clearwater Station
751 Franklin St.
Clearwater, Florida 33756

S-051200-002-F - Structural Steel Framing Canopy & Pavilion

SPEC SECTION:	051200 - Structural Steel Framing	**SUBMITTAL MANAGER:**	Cameron Champaigne **(Kokolakis Contracting)**
STATUS:	Open	**DATE CREATED:**	08/31/2026
ISSUE DATE:	08/31/2026	**REVISION:**	1
RESPONSIBLE CONTRACTOR:	Acclaim Service Group, Inc.	**RECEIVED FROM:**	
RECEIVED DATE:		**SUBMIT BY:**	
FINAL DUE DATE:	09/15/2026	**LOCATION:**	
SUB JOB:		**COST CODE:**	
LEAD TIME:		**TYPE:**	
APPROVERS:	Xavier Arroyo **(CDM Smith)**, David DaSilva **(CDM Smith)**, Benjamin Harber **(CDM Smith)**, Mindy Heath **(CDM Smith)**, Robin Sarvis **(CDM Smith)**		

BALL IN COURT:
Xavier Arroyo **(CDM Smith)**, David DaSilva **(CDM Smith)**, Benjamin Harber **(CDM Smith)**, Mindy Heath **(CDM Smith)**, Robin Sarvis **(CDM Smith)**

DISTRIBUTION:
Ashley Quaid **(HDR, Inc.)** , Benjamin Harber **(CDM Smith)** , Cameron Champaigne **(Kokolakis Contracting)** , Christine Herrold **(MORROW STEEL FABRICATORS, INC)** , Colton Forkush **(Kokolakis Contracting)** , David DaSilva **(CDM Smith)** , Dylan Hernandez **(HDR, Inc.)** , Elizabeth Fazio **(PSTA)** , Eric Lawson **(MORROW STEEL FABRICATORS, INC)** , John Olivio **(HDR, Inc.)** , John Steele **(HDR, Inc.)** , Joseph Barron **(HDR, Inc.)** , Josh Van Vossen **(Kokolakis Contracting)** , Leticia Sheppard **(HDR, Inc.)** , Marcus Glynn **(HDR, Inc.)** , Mike Ferry **(MORROW STEEL FABRICATORS, INC)** , Mindy Heath **(CDM Smith)** , Robin Sarvis **(CDM Smith)** , Tracie Rose **(HDR, Inc.)** , Xavier Arroyo **(CDM Smith)**

DESCRIPTION:

ATTACHMENTS:

SUBMITTAL WORKFLOW

NAME	SUBMITTER/ APPROVER	SENT DATE	DUE DATE	RETURNED DATE	RESPONSE	ATTACHMENTS	COMMENTS
Cameron Champaigne	Submitter	9/1/2026	8/31/2026	9/1/2026	Submitted	S-051200-002-F - Structural Steel Framing Canopy & Pavilion.pdf	
Xavier Arroyo	Approver	9/1/2026	9/15/2026		Pending		
David DaSilva	Approver	9/1/2026	9/15/2026		Pending		
Benjamin Harber	Approver	9/1/2026	9/15/2026		Pending		
Mindy Heath	Approver	9/1/2026	9/15/2026		Pending		
Robin Sarvis	Approver	9/1/2026	9/15/2026		Pending		

Kokolakis Contracting hereby certifies that all items submitted herewith have been checked by the Contractor, are correct, and are in accordance with the requirements of the Contract Documents, except as noted in the remarks section of the submittal.

KOKOLAKIS CONTRACTING

Submittal #051200-7.1 051200 - Structural Steel Framing

BY	DATE	COPIES TO

PSTA Clearwater Station
701 Franklin St.
Clearwater, Florida 33756

SUBMITTAL STAMPING SHEET

Shop Drawing Review

- [ ] Approved
- [x] Comments Attached
- [ ] Approved As Noted
- [x] Approved As Noted; Resubmit
- [ ] Not Approved; Resubmit

- [x] Full
- [ ] Partial

- [ ] Receipt Acknowledged (Not Subject to the Engineer's Approval)

The Contractor is responsible for the details and dimensions of fabrication and manufacture, the mean, methods, techniques, sequences or procedures of construction and performing its work in a safe manner. The Contractor is also responsible for confirmation and verification of all field measurements, and coordination with other related shop drawings and Contract requirements.

The Engineer's review of this shop drawing is limited to review for general conformance with the Contract Documents and design concept. This review does not relieve the Contractor from errors or omissions in the submittal, or from the Contractor's responsibility of addressing any deviations from the Contract Documents, or for any other Contract requirement.

Note: The review of shop drawings containing design calculations are drawings signed and sealed by a professional engineer ("Contractor Specialty Engineer") does not constitute a detail check of calculations, nor does is relieve the Contractor's Specialty Engineer from the responsibility for the design and detailing of the specialty component or system contained in such shop drawings.

CDM Smith By: Ben Harber Date: 9/9/2026

Consultant Name
Stamp Area

Project Name:
PSTA Clearwater Station

REVIEWED

Submittal #: S-051200-002-E - Structural Steel Framing Canopy & Pavilion.pdf
Reviewed By: CameronChampaigne

Date: 08/31/2026

This submittal has been reviewed, checked and approved for compliance with the Contract Documents unless otherwise noted herein. This review does not constitute nor does it assure design responsibility nor does it relieve the trade contractor/supplier from complying with the contract requirements, coordinating their work with other trade contractors and verifying field dimensions.

Review of pages 34 & 35 only

REVIEWED

- [ ] APPROVED
- [x] APPROVED AS NOTED
- [ ] RESUBMIT
- [ ] NOT APPROVED

REVIEW IS ONLY FOR CONFORMANCE WITH THE DESIGN CONCEPT OF THE PROJECT AND COMPLIANCE WITH THE INFORMATION GIVEN IN THE CONTRACT DOCUMENTS BUT SHALL NOT EXTEND TO MEANS, METHODS, TECHNIQUES, SAFE OPERATING PRACTICES, SEQUENCES OR PROCEDURES OF CONSTRUCTION OR PROGRAMS INCIDENT THERETO. THE REVIEW AND APPROVAL OF SEPARATE ITEMS AS SUCH WILL NOT INDICATE APPROVAL OF THE ASSEMBLY IN WHICH THE ITEMS FUNCTION. APPROVAL DOES NOT AUTHORIZE ANY DEVIATION FROM THE CONTRACT DOCUMENTS. CONTRACTOR IS RESPONSIBLE FOR DIMENSIONS TO BE CONFIRMED AND CORRELATED AT THE JOB SITE, FOR INFORMATION THAT PERTAINS SOLELY TO THE FABRICATION PROCESSES, OR TO TECHNIQUES OF CONSTRUCTION AND FOR COORDINATION OF THE WORK OF ALL TRADES.

DRMP, INC.

BY BArriola DATE 9/1/2026

RESUBMITTAL RESPONSE COVER SHEET

S-051200-002-E - Structural Steel Framing - Canopy & Pavilion | Response to S-051200-002-D

SUBMITTAL PURPOSE

This resubmittal is being submitted for EOR approval and release of the Canopy & Pavilion structural steel for fabrication. It includes Morrow Steel Canopy & Pavilion SEQ #1 Rev. 2 shop drawings, condensed written responses to EOR Comments 1-39, refined red revision clouds identifying Morrow revisions, supporting coating product data, Morrow welding procedures, and available welder qualification/certification records.

DOCUMENTS INCLUDED / UPDATED

- Revised Morrow Steel Canopy & Pavilion SEQ #1 shop drawings - Rev. 2, with refined red revision clouds identifying Morrow drawing changes.
- Condensed written contractor responses to EOR Comments 1-39.
- Lanning Chemical Fast Dry Universal Primer product data and ZRC Galvilite galvanizing repair compound product data.
- Morrow Steel WPS documents MSE3000, MSF1000, MSF1300, and MSF2000.
- Available Morrow Steel welder qualification/certification records.

INFORMATIONAL / FOLLOW-UP DOCUMENTATION

Remaining mill reports, certificates of conformance, qualification records, source/LEED documentation, and similar informational submittals will be provided after the steel is released for fabrication as production material becomes available. Coordination items dependent on final vendor/manufacturer information will be coordinated before fabrication or installation of the affected interface, and a follow-up submittal will be provided separately if required.

CONDENSED EOR COMMENT RESPONSES

Comments 1-20 | S-051200-002-E

1. Written response to all comments
Written responses to Comments 1-39 are included.

2. East/west canopy steel
Not included in SEQ #1; it will be submitted under a separate sequence/package with applicable prior comments incorporated.

3. Restroom CMU wall anchorage
Revised shop drawings include the restroom non-bearing CMU wall support/anchorage on E131 and related details.

4. Waiting Pavilion transformer supports
W8x24 supports and anchorage are shown. Final location/elevation will be coordinated with the selected transformer manufacturer. Morrow's revised bolt arrangement is submitted for EOR review; follow-up will be submitted if required.

5. Typical truss comments
Representative truss revisions apply to all similar longitudinal trusses. The E118 5/16 in. weld item remains identified for Morrow/EOR confirmation before affected fabrication.

6. Coating data / HDG gutter plates
Added Lanning Fast Dry Universal Primer and ZRC Galvilite data. Revised drawings identify galvanized steel; gutter bent plates are to be hot-dip galvanized.

7. 051200-1.7 informational submittals
WPSs and available welder certifications are included. Remaining qualifications, mill reports, product tests and compatibility certificates are informational submittals and will follow after release as production material becomes available.

8. 051213-1.6.A AESS product data
Available coating product data is included. Remaining applicable AESS product data will be submitted separately if required.

9. 051213-1.6.C AESS samples
Physical AESS samples will be submitted separately as required.

10. 051213-1.6.B shop-drawing content
Revised shops identify AESS categories, connections, welds, vents, coatings and fabrication information. Vendor/interface items will be coordinated; follow-up will be submitted if required.

11. 051213-1.7 informational submittals
Available welder qualifications are included. Remaining installer/fabricator/shop-painting qualifications and coating compatibility information are informational submittals and will follow after release.

12. Heavy-section AISC 360 certificates
No member with flange thickness greater than 2 in. has been identified. If one is furnished, required certificates will be submitted after release when the production material is identified.

13. Cane rails - Section 055200
Scope will be coordinated. If outside Morrow's steel scope, cane rails will be submitted separately under Section 055200.

14. Wave-canopy roof stanchion
Scope will be coordinated. A separate follow-up submittal will be provided if required.

15. Signage connection
Morrow shows the structural signage connection on E120. Final size, location and elevation will be coordinated with approved signage and column-cover information before affected fabrication; follow-up will be submitted if required.

16. Lighting connection
Morrow shows the structural lighting connection on E120. Final size, location and elevation will be coordinated with the selected lighting manufacturer and column-cover information; follow-up will be submitted if required.

17. Erection engineering
Erection sequence, lifting, temporary supports/shoring and signed/sealed calculations will be submitted separately by the erector before erection. This submittal is for release of steel for fabrication.

18. Access-hatch coordination
Revised hatch framing is shown. Final opening dimensions and connection requirements will be coordinated with the approved roof-hatch product; follow-up will be submitted if required.

19. Baseplate / anchor-bolt coordination
Baseplate thickness, bolt-hole sizes and locations will be coordinated with the anchor-bolt/embed package before affected fabrication; follow-up will be submitted if required.

20. Representative truss / BOM
The representative truss detail applies to similar trusses; final approved typical revisions will be carried through all similar trusses.

Coordination items will be completed before fabrication/installation of the affected interface; follow-up submittals will be provided separately if required.

CONDENSED EOR COMMENT RESPONSES

Comments 21-39 | S-051200-002-E

21. Ladder / hollow-core coordination
Revised ladder connection details are shown. Final connection locations will be coordinated with the approved hollow-core layout before installation; follow-up will be submitted if required.

22. Ladder safety-post data
The safety post is shown on the shop drawings. Manufacturer product data will be submitted separately under the applicable specification if required.

23. Headed-stud product data
Headed studs are shown on the shop drawings. Manufacturer product data will be submitted separately under Section 055000 if required.

24. Storefront steel elevation
EOR previously confirmed design intent. Final bottom-of-steel elevation will be coordinated with storefront and curb manufacturer information before affected fabrication.

25. Additional marked-PDF comments
Revised drawings and red revision clouds identify EOR-driven changes. Remaining detailer/vendor queries will be coordinated before affected fabrication; follow-up will be submitted if required.

26. Architectural written responses
Written responses are included.

27. Submittal completeness
This package adds coating data, WPSs and available welder certifications. Remaining certification/mill/LEED documents are informational follow-up submittals after fabrication release.

28. Galvanizing / field coatings
Revised drawings identify galvanized steel. Lanning primer and ZRC repair data are included. Field painting and anti-graffiti coating will be coordinated under the applicable coating scope.

29. Wave-canopy roof hatch
Wave-canopy roof opening/hatch framing is included on E121.

30. Prior A comments
Applicable prior comments are addressed in the revised drawings and written responses. Manufacturer-dependent interfaces will be coordinated; follow-up will be submitted if required.

31. Roof-hatch clear opening
Opening is shown. Final clear opening/location will be coordinated with the approved roof-hatch manufacturer; follow-up will be submitted if required.

32. Ladder location / safe access
Revised ladder layout is shown. Final location will be coordinated with the approved hatch and surrounding wall construction before installation.

33. Retail Ops hatch / ladder
Prior EOR acceptance is noted. Final roof-hatch product approval and interface coordination will occur under the applicable roof-hatch submittal.

34. Hatch-to-rung / side-rail dimensions
Final dimensions will be coordinated with the selected/approved roof-hatch manufacturer; follow-up will be submitted if required.

35. Ladder travel area / centering
Revised plan is included. Final clear travel area and centering will be coordinated with the approved hatch and surrounding construction.

36. Bollard finish / selection
ME112 is revised to identify bollards as galvanized and painted traffic yellow.

37. LEED EPD / recycled content
EPD/recycled-content and mill documentation are informational submittals and will follow after steel release when production material is identified/procured.

38. Mill / fabrication sourcing
Mill/source, project-distance, fabrication-location and cost-percentage documentation are informational submittals and will follow after release when production sourcing is established.

39. VOC / galvanizing certification
Lanning primer data includes VOC content and ZRC Galvilite data is included. Remaining galvanizing/coating certification for LEED review is informational and will follow after release as applicable.

Coordination items will be completed before fabrication/installation of the affected interface; follow-up submittals will be provided separately if required.

EOR REVISION / DRAWING LOCATION INDEX

S-051200-002-E - Structural Steel Framing - Canopy & Pavilion

PURPOSE OF THIS PAGE

This index identifies the primary EOR-driven revisions incorporated into Morrow Rev. 2 and where they appear in the final package. Refined red revision clouds identify revised drawing areas.

EOR	Revision / response incorporated	Drawing	Final pkg. page
3	Restroom non-bearing CMU wall support/anchorage added.	E131	29
4	Waiting Pavilion W8x24 transformer supports/anchorage added; galvanized. Final transformer interface remains coordination.	E101 / E104	8, 11
5 / 20 / 25	Representative truss/connection details revised and clouded. E118 5/16 in. weld item remains identified for confirmation.	E118	25
15	Structural signage connection detail shown; final signage/column-cover interface to be coordinated.	E114 / E120	21, 27
16	Structural lighting connection detail shown; final lighting/column-cover interface to be coordinated.	E120	27
18 / 29 / 31	Wave-canopy roof opening/hatch framing restored; final hatch dimensions remain manufacturer coordination.	E121	28
21 / 32-35	Roof-hatch ladder layout/connections revised, including hollow-core/Hollo-Bolt interface information.	ME101 / ME102	30-31
24	Storefront/curb bottom-of-steel coordination identified on Waiting Pavilion elevations.	E102 / E103	9-10
28 / 36	Galvanizing carried through revised drawings; bollard detail revised to galvanized and traffic yellow.	ME112	33
6 / 8 / 39	Lanning Fast Dry Universal Primer and ZRC Galvilite product data added.	Support Appendix	237-240
7 / 11	Morrow WPSs and available welder qualification/certification records added. Remaining production certifications follow after release.	Support Appendix	241-264

Page numbers above refer to this final resubmittal package. Morrow transmittal begins on page 6; shop drawings begin on page 7.

morrow steel
Fabricators, Inc.

3620 Copeland Drive | Zephyrhills, FL 33542 | PH: (813)715-0404 | www.morrowsteel.com

---

To: Kokolakis Contracting
Attn: Tyler Knight

Date: 8/26/2026
Job #2553
Transmittal #9

We are sending via email: T#9 Canopy & Pavilion SEQ#1 for Reapproval

E Drawings ☒	**Shop Details ☒**	**Calculations ☐**
For Reapproval ☒	**Back From Approval ☒**	**File & Field ☐**
Approved as Noted ☐	**Revise & Resubmit ☐**	**For Your Use ☐**

	Drawing #	Rev	# sheets		Drawing #	Rev	# sheets	
	Erection Sheets				**Detail Sheets**			
	E100 – E121	2	22		1401 - 1520	2	120	
	E131	1	1		1522	2	1	
	ME101 & ME102	2	2		1524 - 1526	2	3	
	ME111 & ME112	2	2		1528	2	1	
					1551 - 1565	2	15	
	Detail Sheets				1651	2	1	
	1001 - 1012	2	12		1701 & 1702	2	2	
	1021 - 1032	2	12		1711 - 1719	1	9	
	1051 - 1056	2	6		1720 & 1721	0	2	
	1176	2	1		M1001 – M1003	2	3	
	1185	1	1		M1011	2	1	
	1188	1	1		M1012	1	1	
	1191 & 1194	2	2					
	1197 & 1200	2	2		**Total**		**230**	

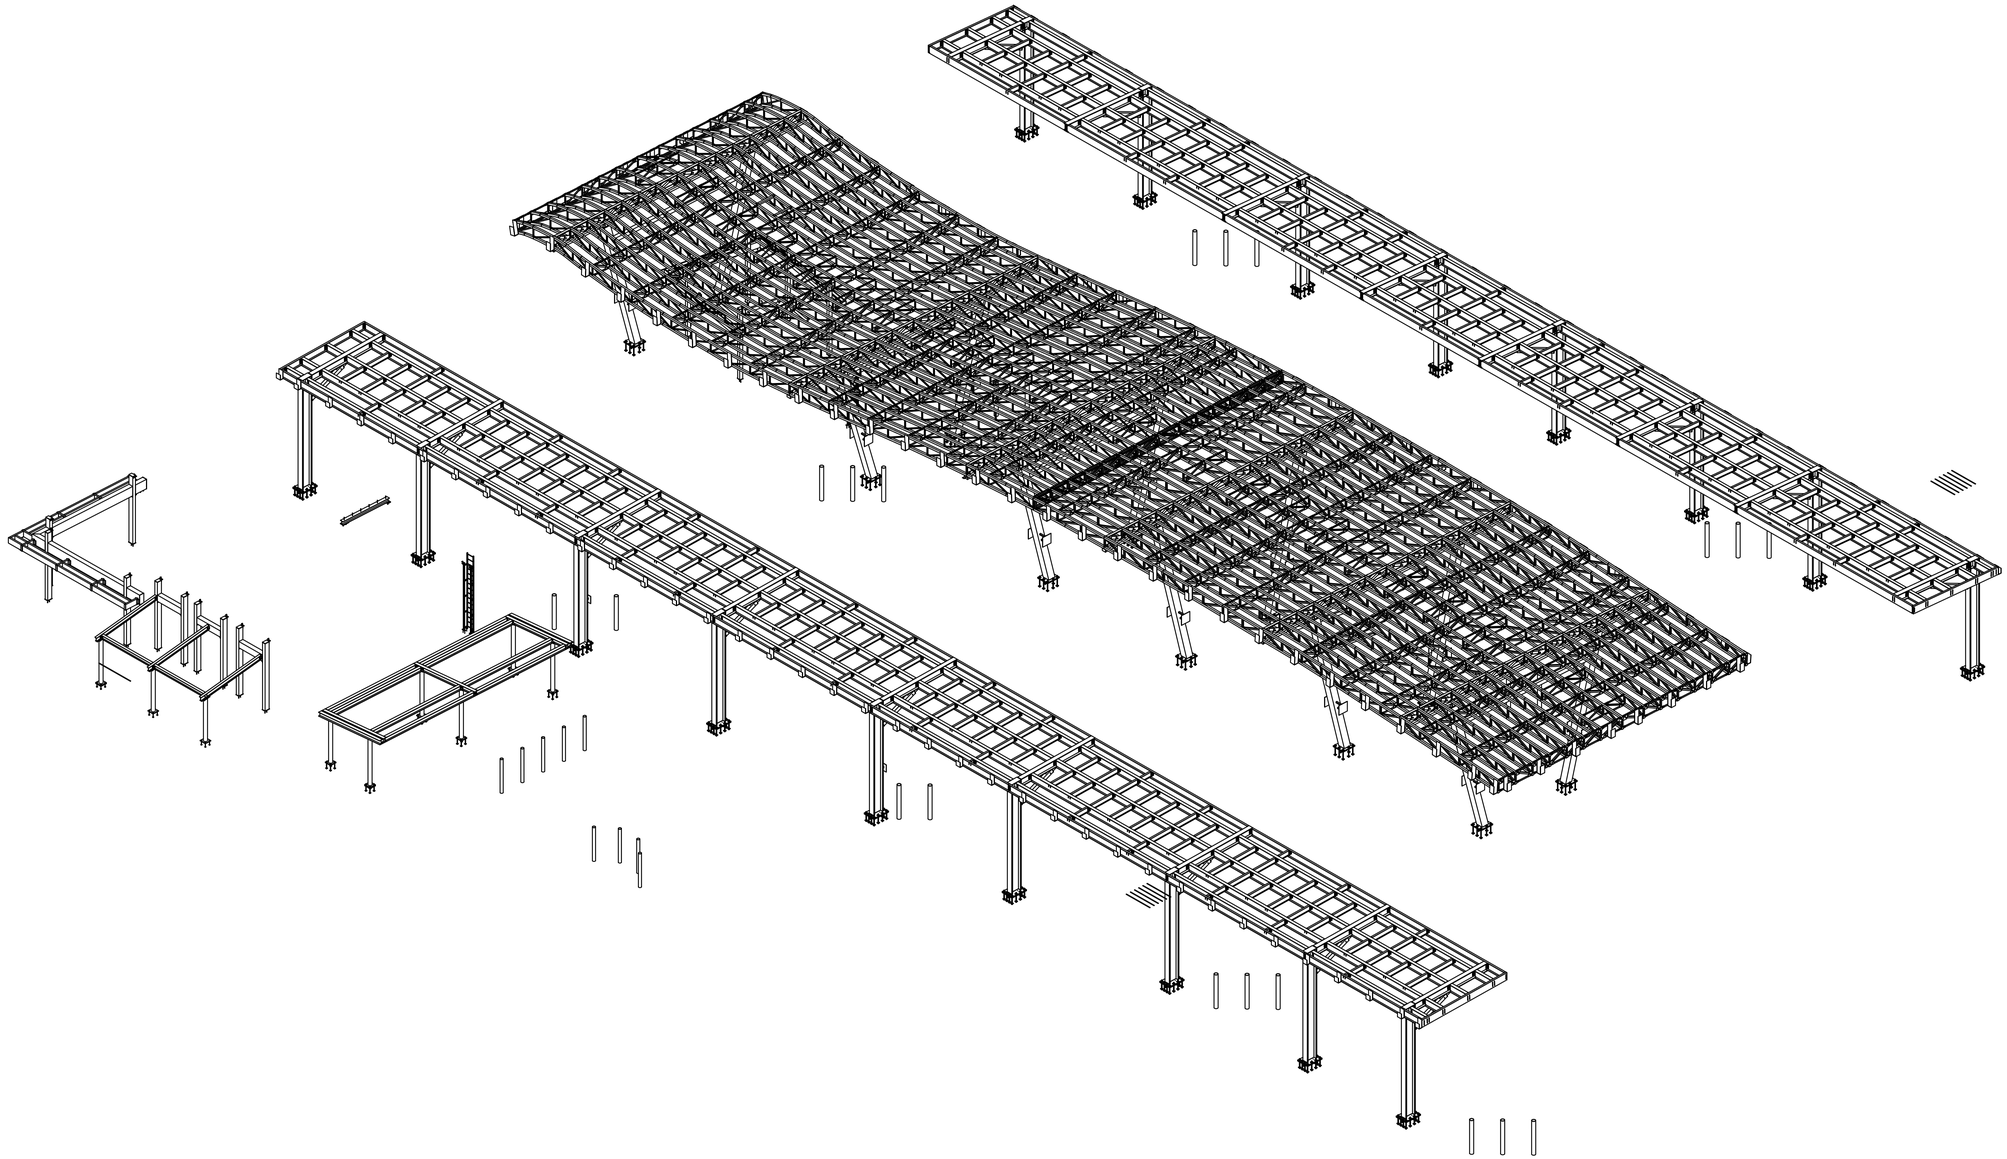

ISO VIEW

REFERENCE : S-CP-1

FIELD CONNECTIONS :
HOLES : 13/16" U.N.O
PAINT :

morrow steel Fabricators, Inc.

3620 COPELAND DRIVE
ZEPHYRHILLS, FL. 33542

AISC CERTIFIED FABRICATOR AND ERECTOR

	PRINTS FOR	DATE	MK	REVISIONS	DATE
			0	RELEASED FOR APPROVAL	Nov 18 2025
			1	RELEASED FOR RE-APPROVAL	Jul 13 2026
			2	RELEASED FOR RE-APPROVAL	Aug 26 2026

STRUCTURE:- PINELLAS SUNCOAST TRANSIT AUTHORITY
LOCATION:- CLEARWATER STATION,CLEARWATER,FL.
DETAILER:- VECTORSHADES LLC
CUSTOMER:- KOKOLAKIS
ARCH./ENG.:- CDM SMITH
DESCRIPTION:- ISO VIEW
DRAWN:- SHR DATE:-10-09-2025 CHK.D:- RAG DATE:-10-10-2025

SHOP BILL	WORK ORDER NO.	DRWG. NO.
	2553	E100 ⚠1

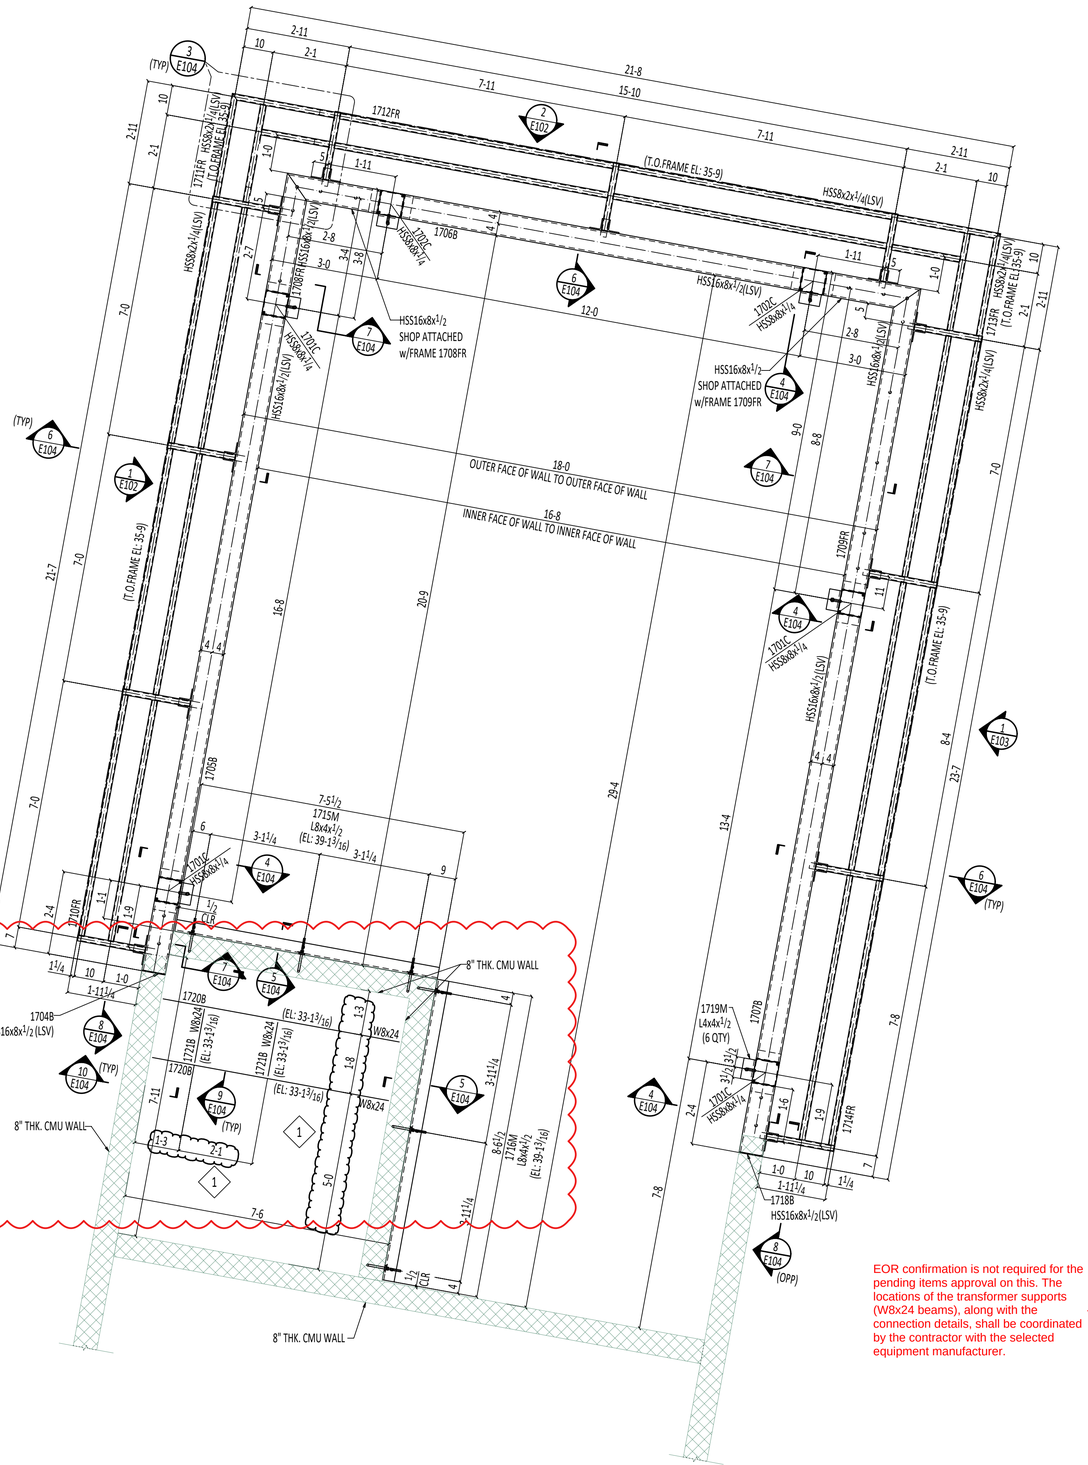

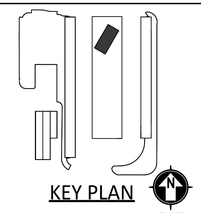

LINTEL FRAMING PLAN AT WAITING PAVILION BUILDING

(REF: S-PB-1)

JOB NORTH

NOTE:
- TOP OF STEEL EL: 36-5 (U.N.O).
- ALL MEMBERS ARE TO BE GALVANIZED.
- FOR ELEVATION VIEWS REFER SHEET E102 & E103.
- FOR SECTIONS AND DETAILS REFER SHEET E104.

APPROVER PLEASE REVIEW AND CONFIRM THE FOLLOWING ITEMS:

1 -GC TO CONFIRM THE CLOUDED TRANSFORMER SUPPORT BEAMS LOCATING DIMENSION WITH ELECTRICAL ENGINEERS.

EOR confirmation is not required for the pending items approval on this. The locations of the transformer supports (W8x24 beams), along with the connection details, shall be coordinated by the contractor with the selected equipment manufacturer.

APPROVER NOTE:
ALL CLOUDED INFORMATION NOT VERIFIED/CONFIRMED ON RETURNED APPROVAL SUBMITTAL WILL BE CONSIDERED APPROVED AS DETAILED.

LEGEND:
LSV - INDICATES LONG SIDE VERTICAL

REFERENCE : S-PB-1

FIELD CONNECTIONS :
HOLES : 13/16" U.N.O
PAINT :

morrow steel Fabricators, Inc.

3620 COPELAND DRIVE
ZEPHYRHILLS, FL. 33542

	PRINTS FOR	DATE	MK	REVISIONS	DATE
			0	RELEASED FOR APPROVAL	Nov 18 2025
			1	RELEASED FOR RE-APPROVAL	Jul 13 2026
			2	RELEASED FOR RE-APPROVAL	Aug 26 2026

STRUCTURE:- PINELLAS SUNCOAST TRANSIT AUTHORITY
LOCATION:- CLEARWATER STATION,CLEARWATER,FL.
DETAILER:- VECTORSHADES LLC
CUSTOMER:- KOKOLAKIS
ARCH./ENG.:- CDM SMITH
DESCRIPTION:- WAITING PAVILION BUILDING ROOF PLAN
DRAWN:- NMN DATE:-11-07-2025 CHK.D:- RAG DATE:-11-14-2025

SHOP BILL	WORK ORDER NO.	DRWG. NO.
	2553	E101 1

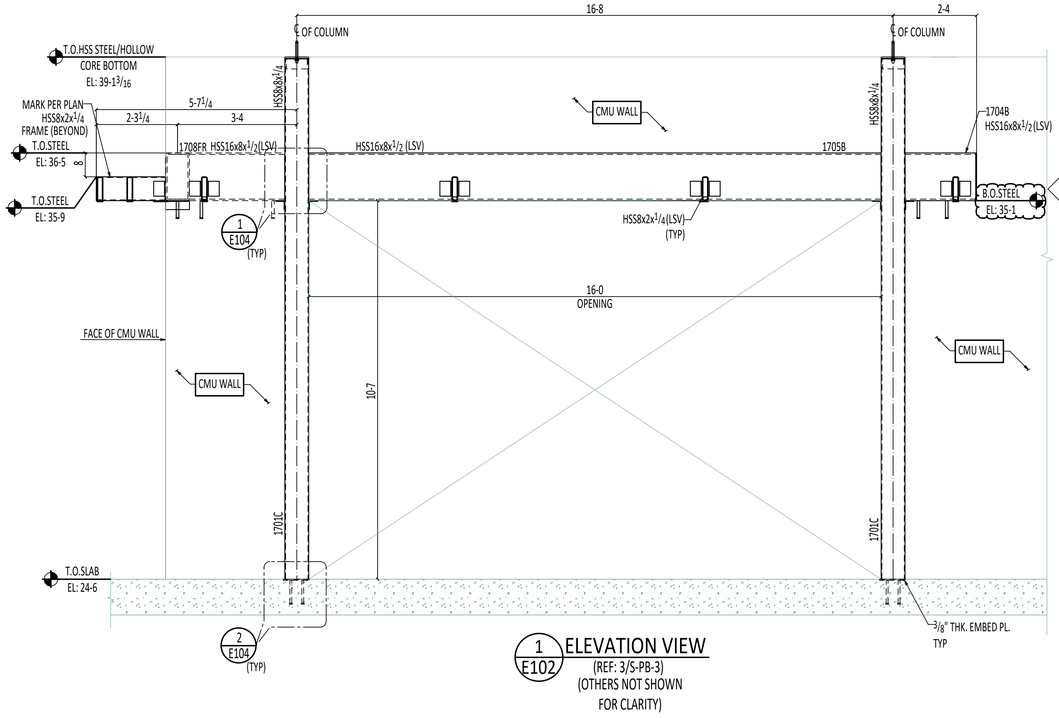

1 E102 ELEVATION VIEW
(REF: 3/S-PB-3)
(OTHERS NOT SHOWN FOR CLARITY)

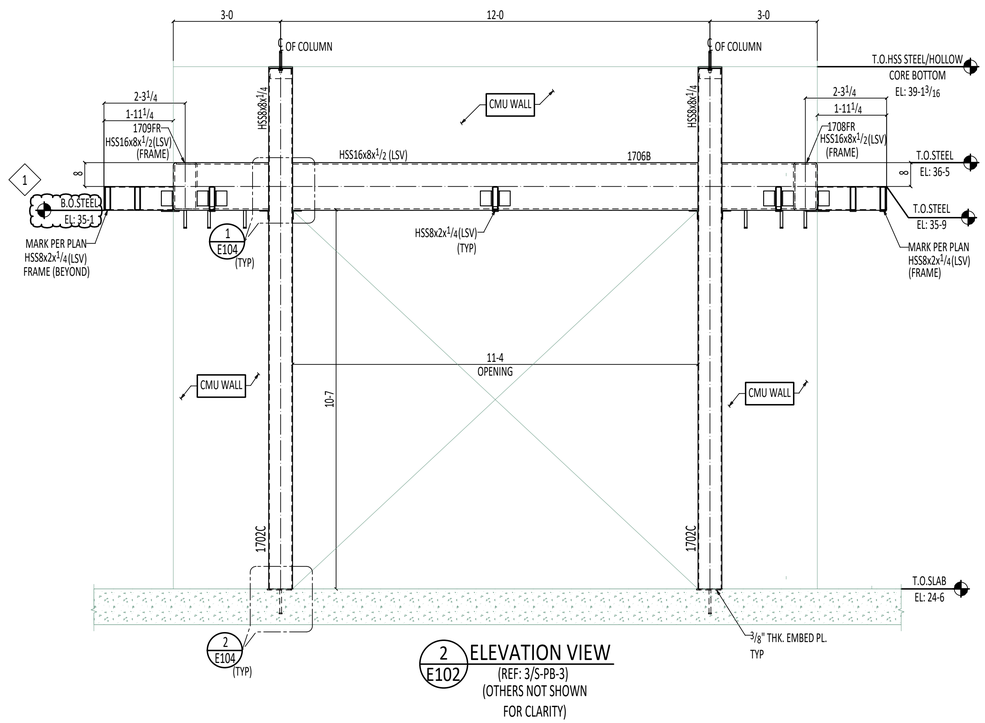

2 E102 ELEVATION VIEW
(REF: 3/S-PB-3)
(OTHERS NOT SHOWN FOR CLARITY)

APPROVER NOTE:
ALL CLOUDED INFORMATION NOT VERIFIED/CONFIRMED ON RETURNED APPROVAL SUBMITTAL WILL BE CONSIDERED APPROVED AS DETAILED.

LEGEND:
LSV - INDICATES LONG SIDE VERTICAL

REFERENCE : S-PB-3 & A-PB-03

FIELD CONNECTIONS :
HOLES : 13/16" U.N.O
PAINT :

morrow steel Fabricators, Inc.

3620 COPELAND DRIVE
ZEPHYRHILLS, FL. 33542

AISC CERTIFIED FABRICATOR AND ERECTOR

	PRINTS FOR	DATE	MK	REVISIONS	DATE
			0	RELEASED FOR APPROVAL	Nov 18 2025
			1	RELEASED FOR RE-APPROVAL	Jul 13 2026
			2	RELEASED FOR RE-APPROVAL	Aug 26 2026

STRUCTURE:- PINELLAS SUNCOAST TRANSIT AUTHORITY
LOCATION:- CLEARWATER STATION,CLEARWATER,FL.
DETAILER:- VECTORSHADES LLC
CUSTOMER:- KOKOLAKIS
ARCH./ENG.:- CDM SMITH
DESCRIPTION:- WAITING PAVILION BUILDING ELEVATION VIEWS
DRAWN:- NMN DATE:-11-07-2025 CHK.D:- RAG DATE:-11-14-2025

SHOP BILL	WORK ORDER NO.	DRWG. NO.
	2553	E102

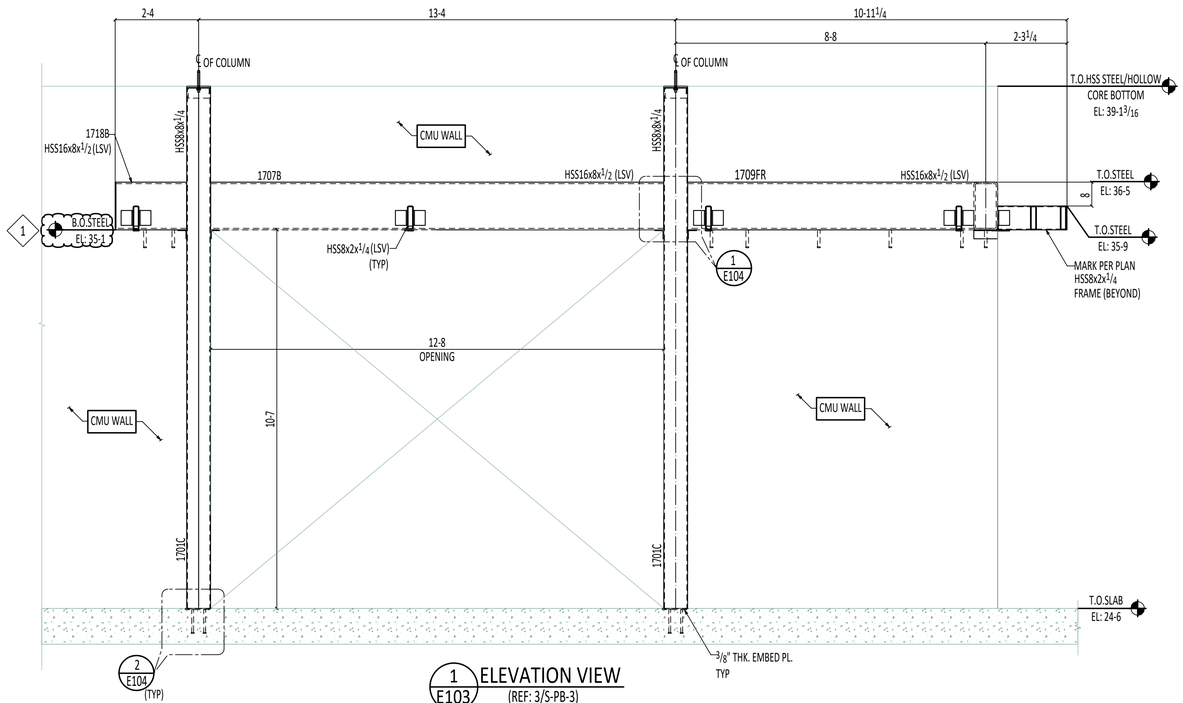

1 E103 ELEVATION VIEW
(REF: 3/S-PB-3)
(OTHERS NOT SHOWN FOR CLARITY)

1 -GC TO CONFIRM THE BOTTOM OF STEEL ELEVATION WITH STOREFRONT & CONCRETE CURB MANUFACTURER.

LEGEND:
LSV - INDICATES LONG SIDE VERTICAL

REFERENCE : S-PB-3 & A-PB-03

APPROVER NOTE:
ALL CLOUDED INFORMATION NOT VERIFIED/CONFIRMED ON RETURNED APPROVAL SUBMITTAL WILL BE CONSIDERED APPROVED AS DETAILED.

AISC CERTIFIED FABRICATOR AND ERECTOR

FIELD CONNECTIONS :
HOLES : 13/16" U.N.O
PAINT :

morrow steel Fabricators, Inc.

3620 COPELAND DRIVE
ZEPHYRHILLS, FL. 33542

	PRINTS FOR	DATE	MK	REVISIONS	DATE
			0	RELEASED FOR APPROVAL	Nov 18 2025
			1	RELEASED FOR RE-APPROVAL	Jul 13 2026
			2	RELEASED FOR RE-APPROVAL	Aug 26 2026

STRUCTURE:- PINELLAS SUNCOAST TRANSIT AUTHORITY
LOCATION:- CLEARWATER STATION,CLEARWATER,FL.
DETAILER:- VECTORSHADES LLC
CUSTOMER:- KOKOLAKIS
ARCH./ENG.:- CDM SMITH
DESCRIPTION:- WAITING PAVILION BUILDING ELEVATION VIEW
DRAWN:- NMN DATE:-11-07-2025 CHK.D:- RAG DATE:-11-14-2025

SHOP BILL	WORK ORDER NO.	DRWG. NO.
	2553	E103 1

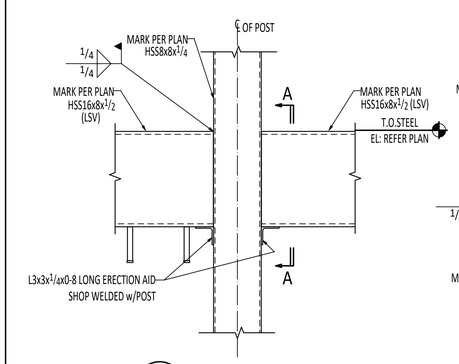

1 E104 DETAIL VIEW
(REF: B/S-SD-5)
(OTHERS NOT SHOWN FOR CLARITY)

ERECTOR NOTE:
REMOVE ERECTION AID ANGLE AFTER ERECTION OF HSS BEAM

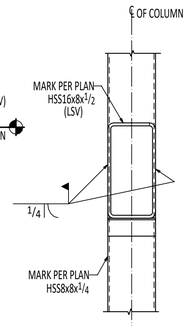

SECTION A-A

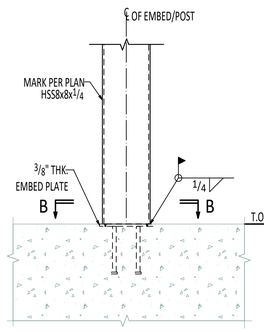

2 E104 DETAIL VIEW
(REF: A/S-SD-5)
(OTHERS NOT SHOWN FOR CLARITY)

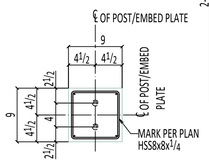

SECTION B-B

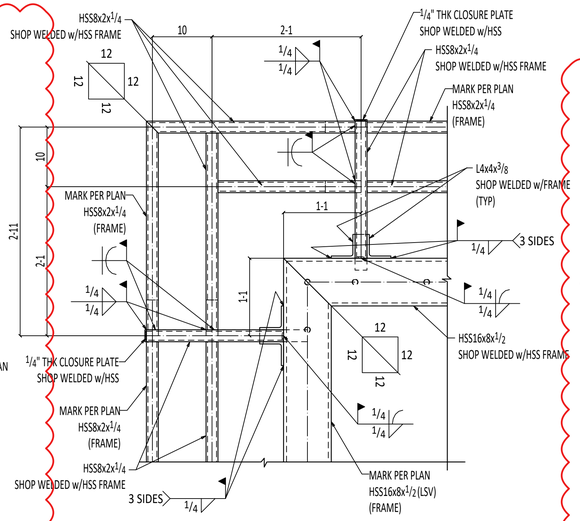

3 E104 DETAIL VIEW
(REF: A/S-PB-1)
(OTHERS NOT SHOWN FOR CLARITY)

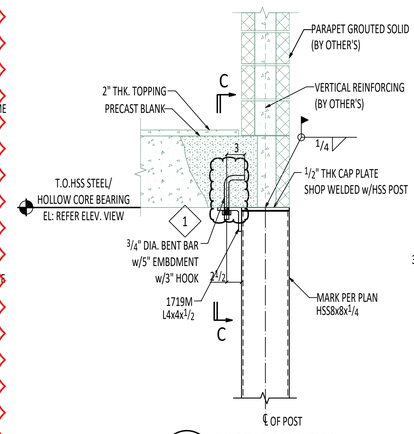

4 E104 SECTION VIEW
(REF: 4/S-PB-3)
(OTHERS NOT SHOWN FOR CLARITY)

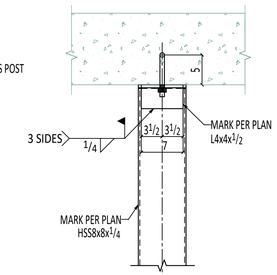

SECTION C-C

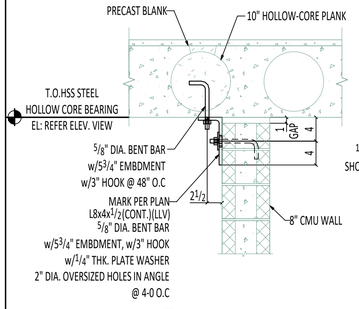

5 E104 SECTION VIEW
(REF: H/S-SD-4)
(OTHERS NOT SHOWN FOR CLARITY)

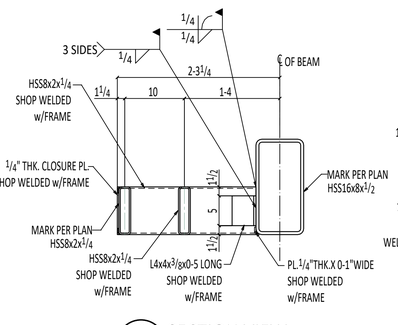

6 E104 SECTION VIEW
(REF: 5/S-PB-3)
(OTHERS NOT SHOWN FOR CLARITY)

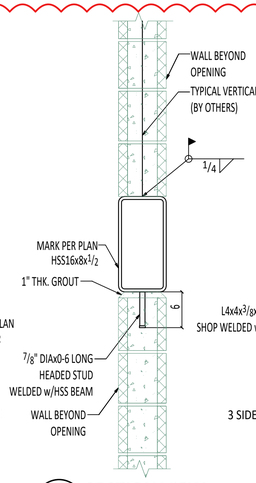

7 E104 SECTION VIEW
(REF: K/S-SD-3)
(OTHERS NOT SHOWN FOR CLARITY)

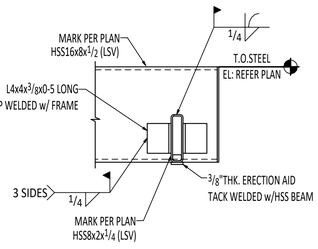

8 E104 SECTION VIEW
(REF: 5/S-PB-3)
(OTHERS NOT SHOWN FOR CLARITY)

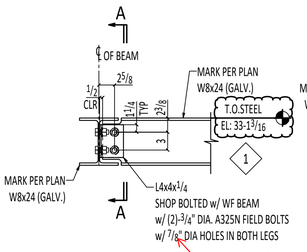

9 E104 SECTION VIEW
(REF: 7/S-PB-1)
(OTHERS NOT SHOWN FOR CLARITY)

Use the standard hole 13/16" diameter per Table J3.3 of AISC 360

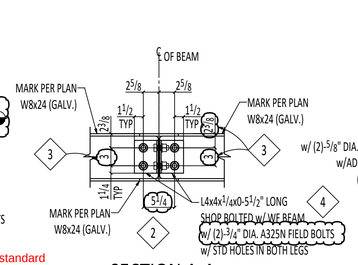

SECTION A-A

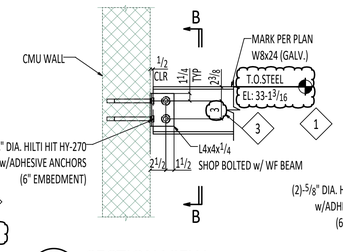

10 E104 SECTION VIEW
(REF: 6/S-PB-1)
(OTHERS NOT SHOWN FOR CLARITY)

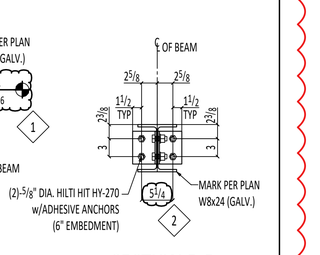

SECTION B-B

APPROVER PLEASE REVIEW AND CONFIRM THE FOLLOWING ITEMS:

1. - PLEASE VERIFY AND CONFIRM THE TOP OF BEAM ELEVATION WITH FINAL APPROVED TRANSFORMER COORDINATION DRAWINGS.
   Contractor to coordinate with the selected transformer manufacturer
2. IF WE MAINTAIN A 1 1/2" EDGE DISTANCE, THE RESULTING HOLE C/C DIMENSION WILL BE 5 1/4", AS SHOWN. PLEASE CONFIRM WHETHER THIS IS ACCEPTABLE.
   It is acceptable
3. IF WE FOLLOW 4" BOLT SPACING PER CD, THNE THE ANGLE WILL CLASH WITH BEAM K VALUE. HENCE WE FOLLOWED 3" SPACING. PLEASE CONFIRM WHETHER THIS IS ACCEPTABLE.
   If 4" spacing is maintained, there will be a slight clash with the beam root radius which should be fine. But the bolt spacing can be reduced to 3 1/2" to avoid the conflict with the root radius.
4. AS PER STANDARD PRACTICE, WE HAVE USED 3/4" DIA. BOLTS INSTEAD OF THE 5/8" DIA. BOLTS SHOWN IN THE CD. PLEASE CONFIRM WHETHER THIS IS ACCEPTABLE.
   It is acceptable

LEGEND:
LSV - INDICATES LONG SIDE VERTICAL

REFERENCE : S-SD-3, S-SD-4, S-SD-5, S-PB-1 & S-PB-3

AISC CERTIFIED FABRICATOR AND ERECTOR

FIELD CONNECTIONS :
HOLES : 13/16" U.N.O
PAINT :

morrow steel Fabricators, Inc.

3620 COPELAND DRIVE
ZEPHYRHILLS, FL. 33542

	PRINTS FOR	DATE	MK	REVISIONS	DATE
			0	RELEASED FOR APPROVAL	Nov 18 2025
			1	RELEASED FOR RE-APPROVAL	Jul 13 2026
			2	RELEASED FOR RE-APPROVAL	Aug 26 2026

STRUCTURE:-	PINELLAS SUNCOAST TRANSIT AUTHORITY
LOCATION:-	CLEARWATER STATION,CLEARWATER,FL.
DETAILER:-	VECTORSHADES LLC
CUSTOMER:-	KOKOLAKIS
ARCH./ENG.:-	CDM SMITH
DESCRIPTION:-	WAITING PAVILION BUILDING SECTION VIEWS
DRAWN:- NMN	DATE:-11-07-2025 CHK.D:-RAG DATE:-11-14-2025

SHOP BILL	WORK ORDER NO.	DRWG. NO.
	2553	E104

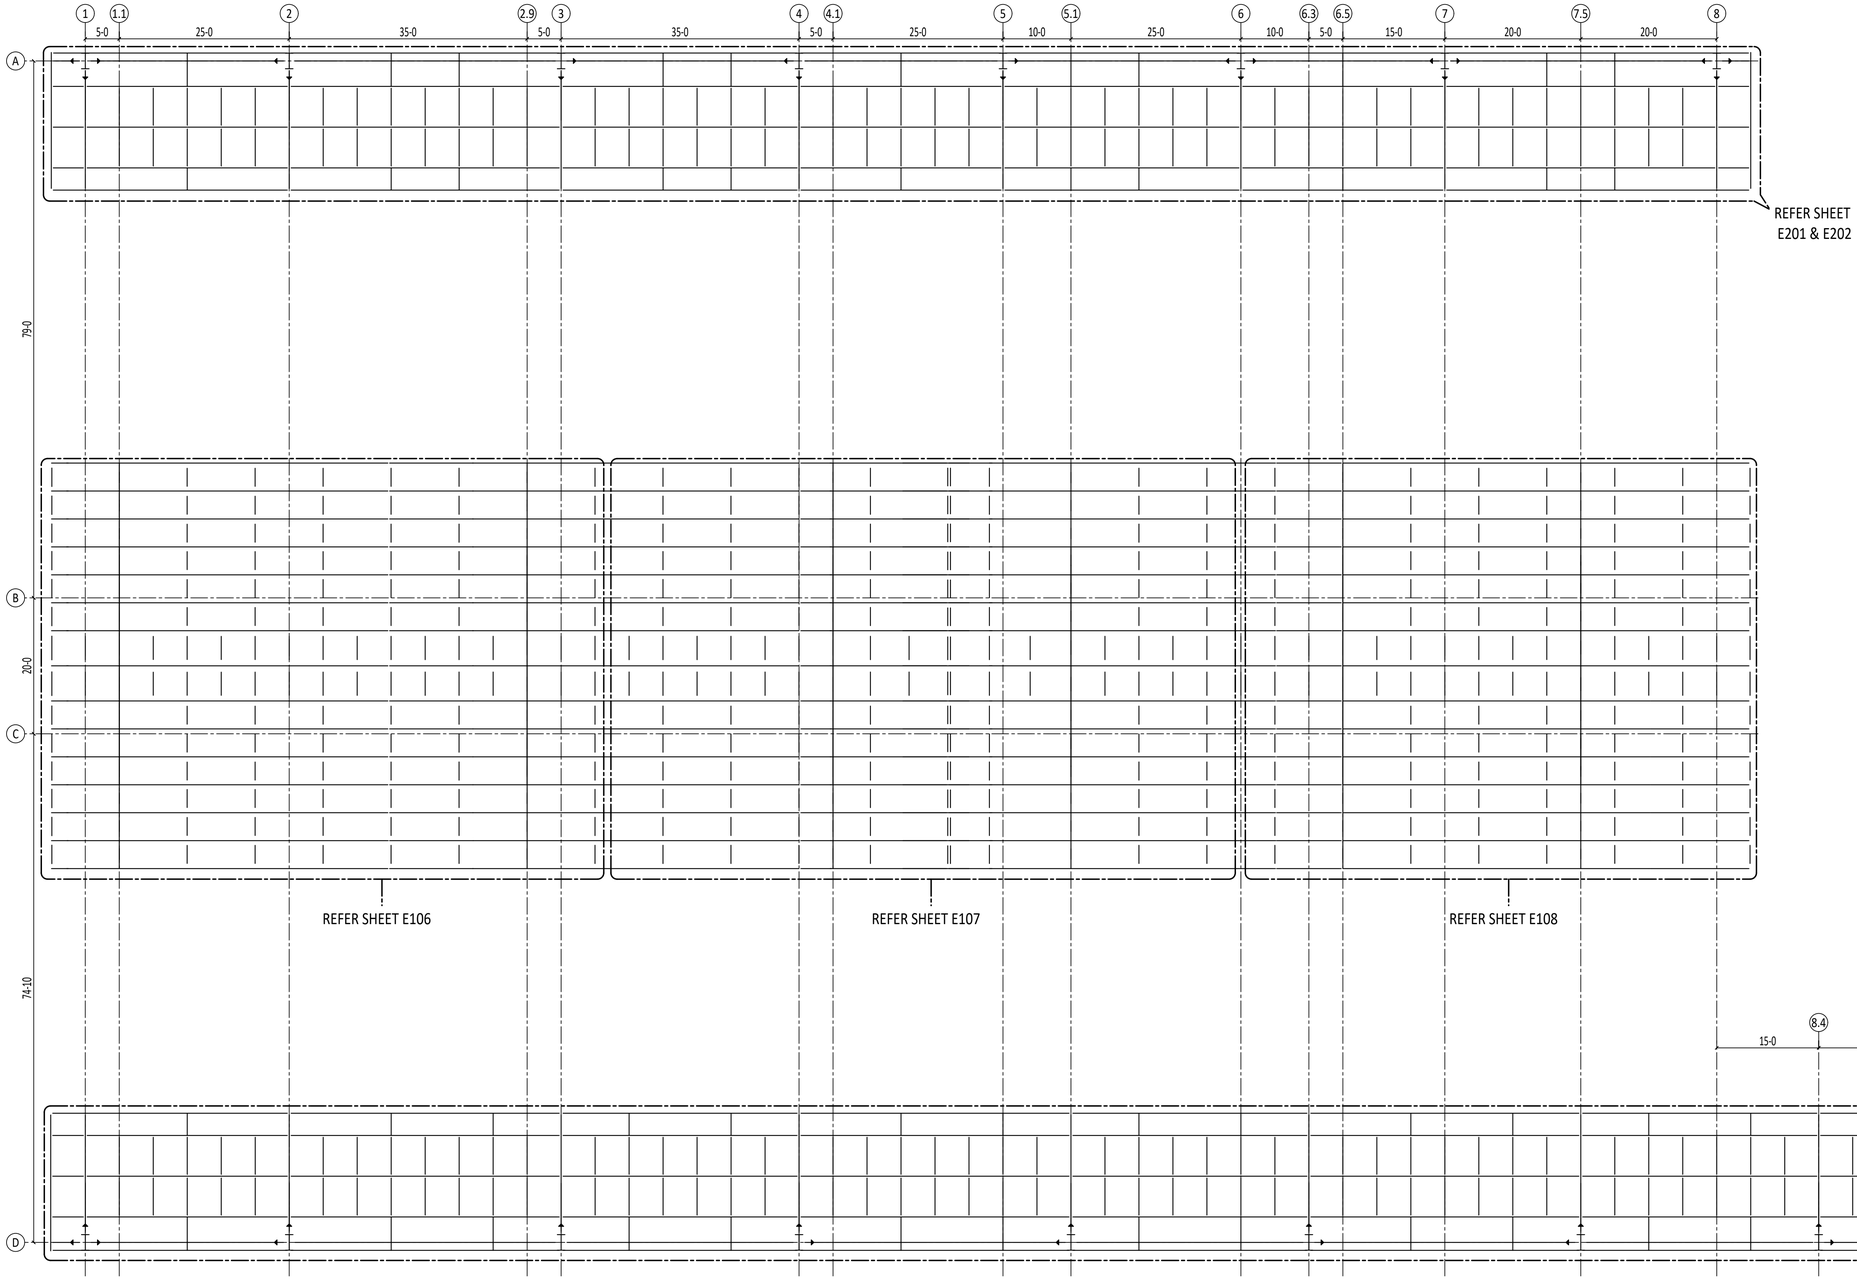

KEY PLAN

JOB NORTH

OVERALL ROOF FRAMING PLAN

(REF: S-CP-2)

TRUE NORTH

JOB NORTH

REFERENCE : S-CP-2

FIELD CONNECTIONS : _____

HOLES : $^{13}/_{16}$" U.N.O

PAINT : _____

morrow steel Fabricators, Inc.

3620 COPELAND DRIVE
ZEPHYRHILLS, FL. 33542

	PRINTS FOR	DATE	MK	REVISIONS	DATE
			0	RELEASED FOR APPROVAL	Nov 18 2025
			1	RELEASED FOR RE-APPROVAL	Jul 13 2026
			2	RELEASED FOR RE-APPROVAL	Aug 26 2026

STRUCTURE:- PINELLAS SUNCOAST TRANSIT AUTHORITY
LOCATION:- CLEARWATER STATION,CLEARWATER,FL.
DETAILER:- VECTORSHADES LLC
CUSTOMER:- KOKOLAKIS
ARCH./ENG.:- CDM SMITH
DESCRIPTION:- OVERALL ROOF FRAMING PLAN
DRAWN:- SHR DATE:-10-09-2025 CHK.D:- RAG DATE:-10-10-2025

SHOP BILL	WORK ORDER NO.	DRWG. NO.
	2553	E105 ⚠1

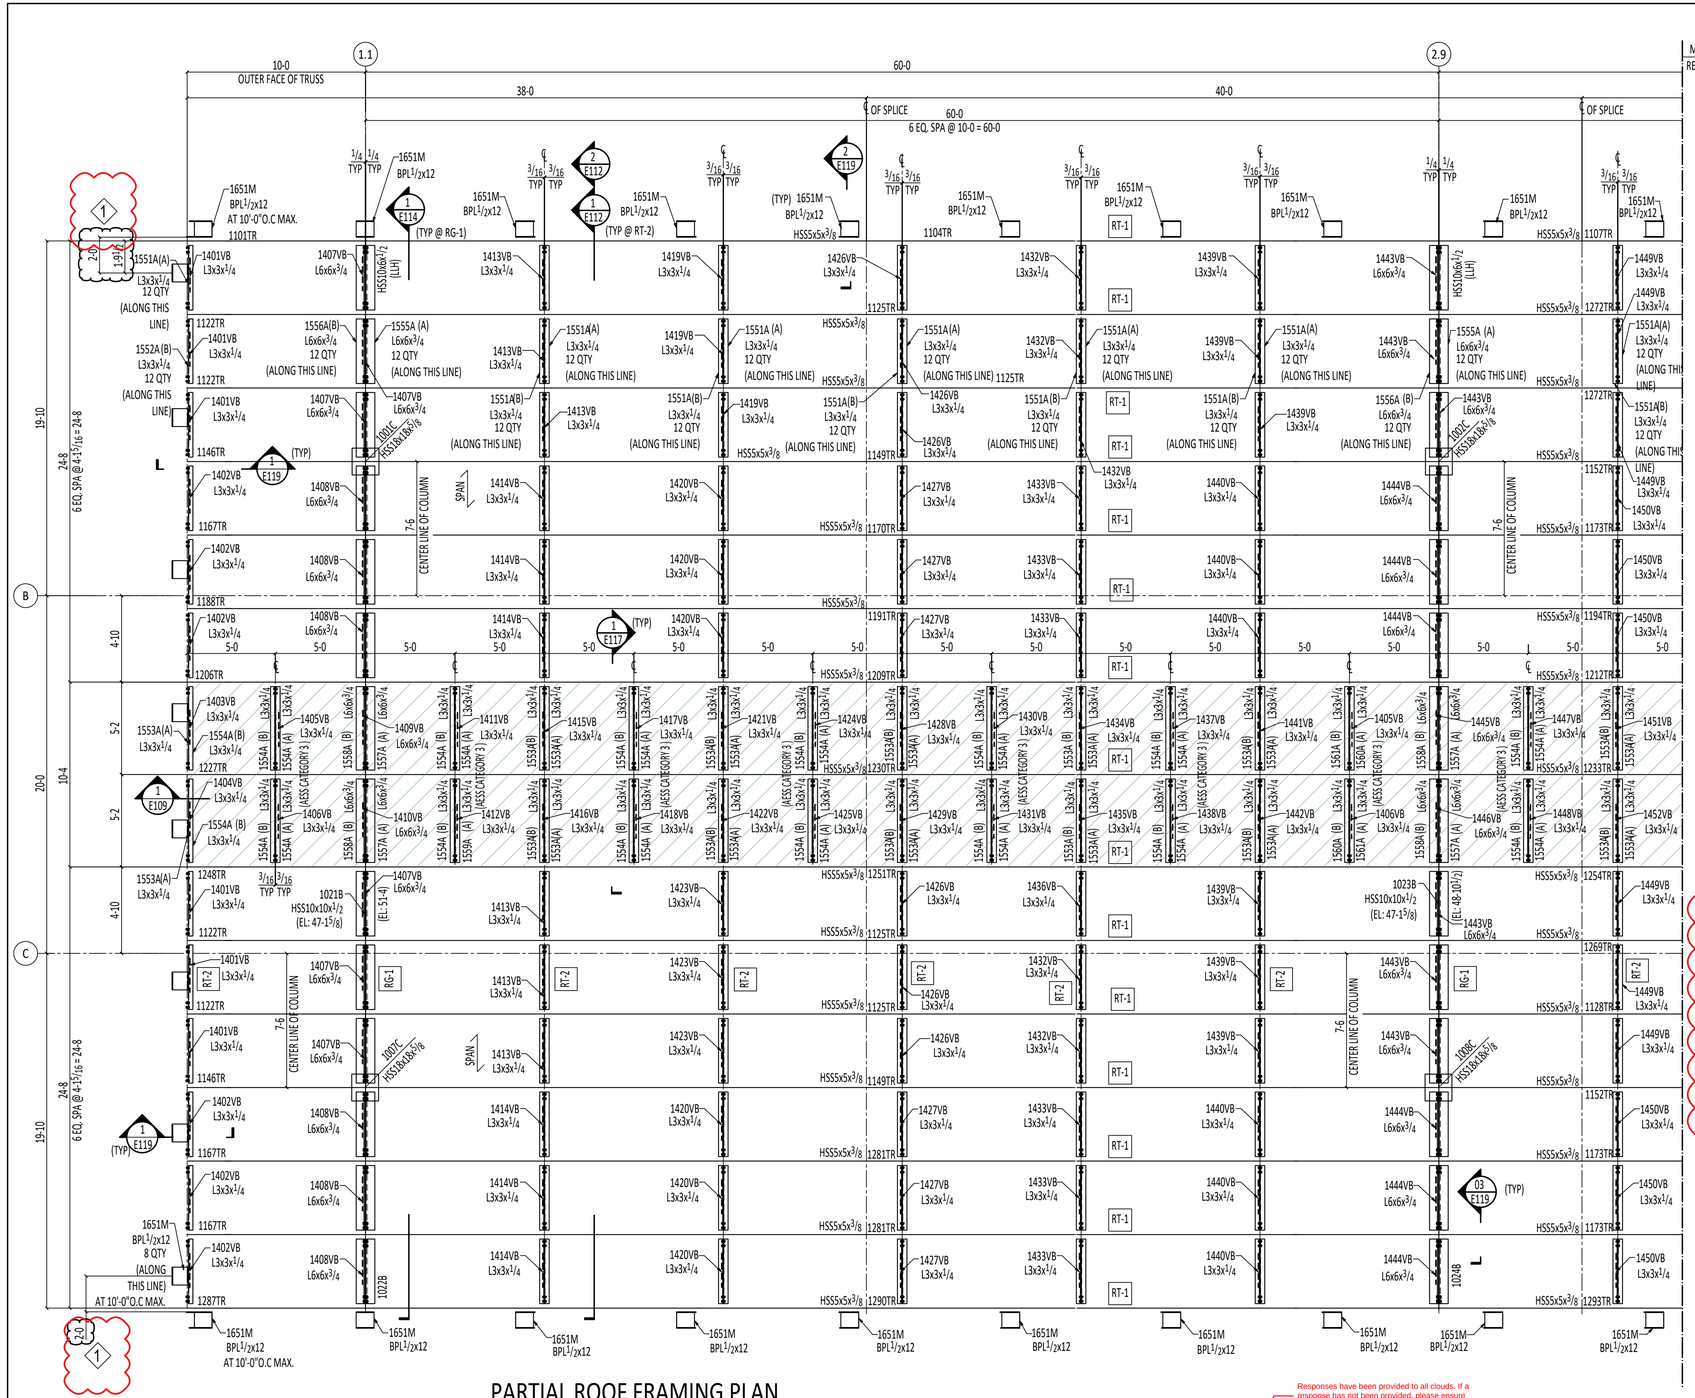

PARTIAL ROOF FRAMING PLAN

NOTE: (REF: S-CP-2 & S-CP-3)

- TOP OF STEEL EL: REFER E109 TO E111.
- SPAN INDICATES 1.5 B18 GALVANIZED METAL DECK.
- – – – INDICATES VERTICAL BRACE.
- FOR ELEVATION VIEWS REFER SHEET E109 TO E111.
- FOR TYPICAL SECTIONS REFER SHEET E118.
- FOR SECTIONS AND DETAILS REFER SHEET E119 & E120.

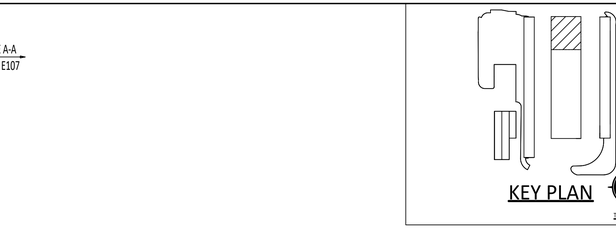

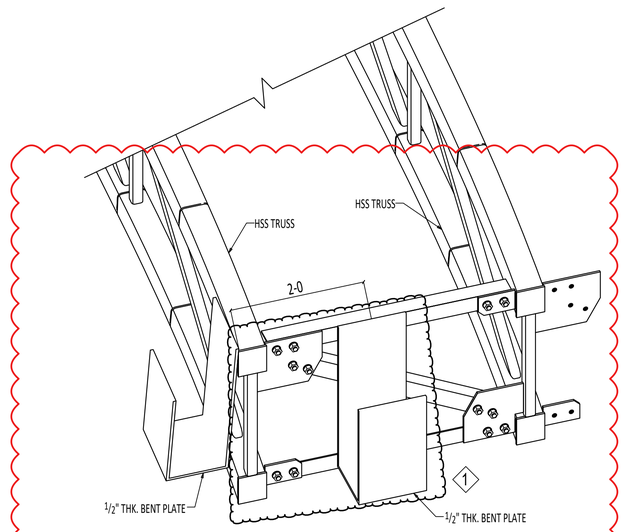

ISO VIEW-1

APPROVER PLEASE REVIEW AND CONFIRM THE FOLLOWING ITEMS:

1. AT THIS LOCATION, WE CAN FOLLOW A MAXIMUM SPACING FROM CORNER 2-0. DUE TO THE GUSSET PLATE CONNECTION AND BOLT ARRANGEMENT. PLEASE REFER TO THE ISO VIEW FOR MORE CLARIFICATION. PLEASE REVIEW AND CONFIRM IF THIS ARRANGEMENT IS ACCEPTABLE, OR ADVISE AN ALTERNATIVE SOLUTION TO PROCEED FURTHER.

The current arrangement shown is acceptable

LEGEND:
(A) - INDICATES ABOVE
(B) - INDICATES BELOW
LLH- LONG LEG HORIZONTAL
E.J- EXPANSION JOINT

REFERENCE : S-CP-2 & S-CP-3

Responses have been provided to all clouds. If a response has not been provided, please ensure Engineer is aware to respond to.

APPROVER NOTE:
ALL CLOUDED INFORMATION NOT VERIFIED/CONFIRMED ON RETURNED APPROVAL SUBMITTAL WILL BE CONSIDERED APPROVED AS DETAILED.

READ THIS DRAWING IN CONJUNCTION WITH E107 & E108

FIELD CONNECTIONS :
HOLES : 13/16" U.N.O
PAINT :

morrow steel Fabricators, Inc.

3620 COPELAND DRIVE
ZEPHYRHILLS, FL. 33542

PRINTS FOR	DATE	MK	REVISIONS	DATE
		0	RELEASED FOR APPROVAL	Nov 18 2025
		1	RELEASED FOR RE-APPROVAL	Jul 13 2026
		2	RELEASED FOR RE-APPROVAL	Aug 26 2026

STRUCTURE:-	PINELLAS SUNCOAST TRANSIT AUTHORITY
LOCATION:-	CLEARWATER STATION,CLEARWATER,FL.
DETAILER:-	VECTORSHADES LLC
CUSTOMER:-	KOKOLAKIS
ARCH./ENG.:-	COM SMITH
DESCRIPTION:-	PARTIAL ROOF FRAMING PLAN AT WAVE CANOPY
DRAWN:- SPK	DATE:-11-07-2025 CHK.D:- RAG DATE:-11-14-2025

SHOP BILL	WORK ORDER NO.	DRWG. NO.
	2553	E106

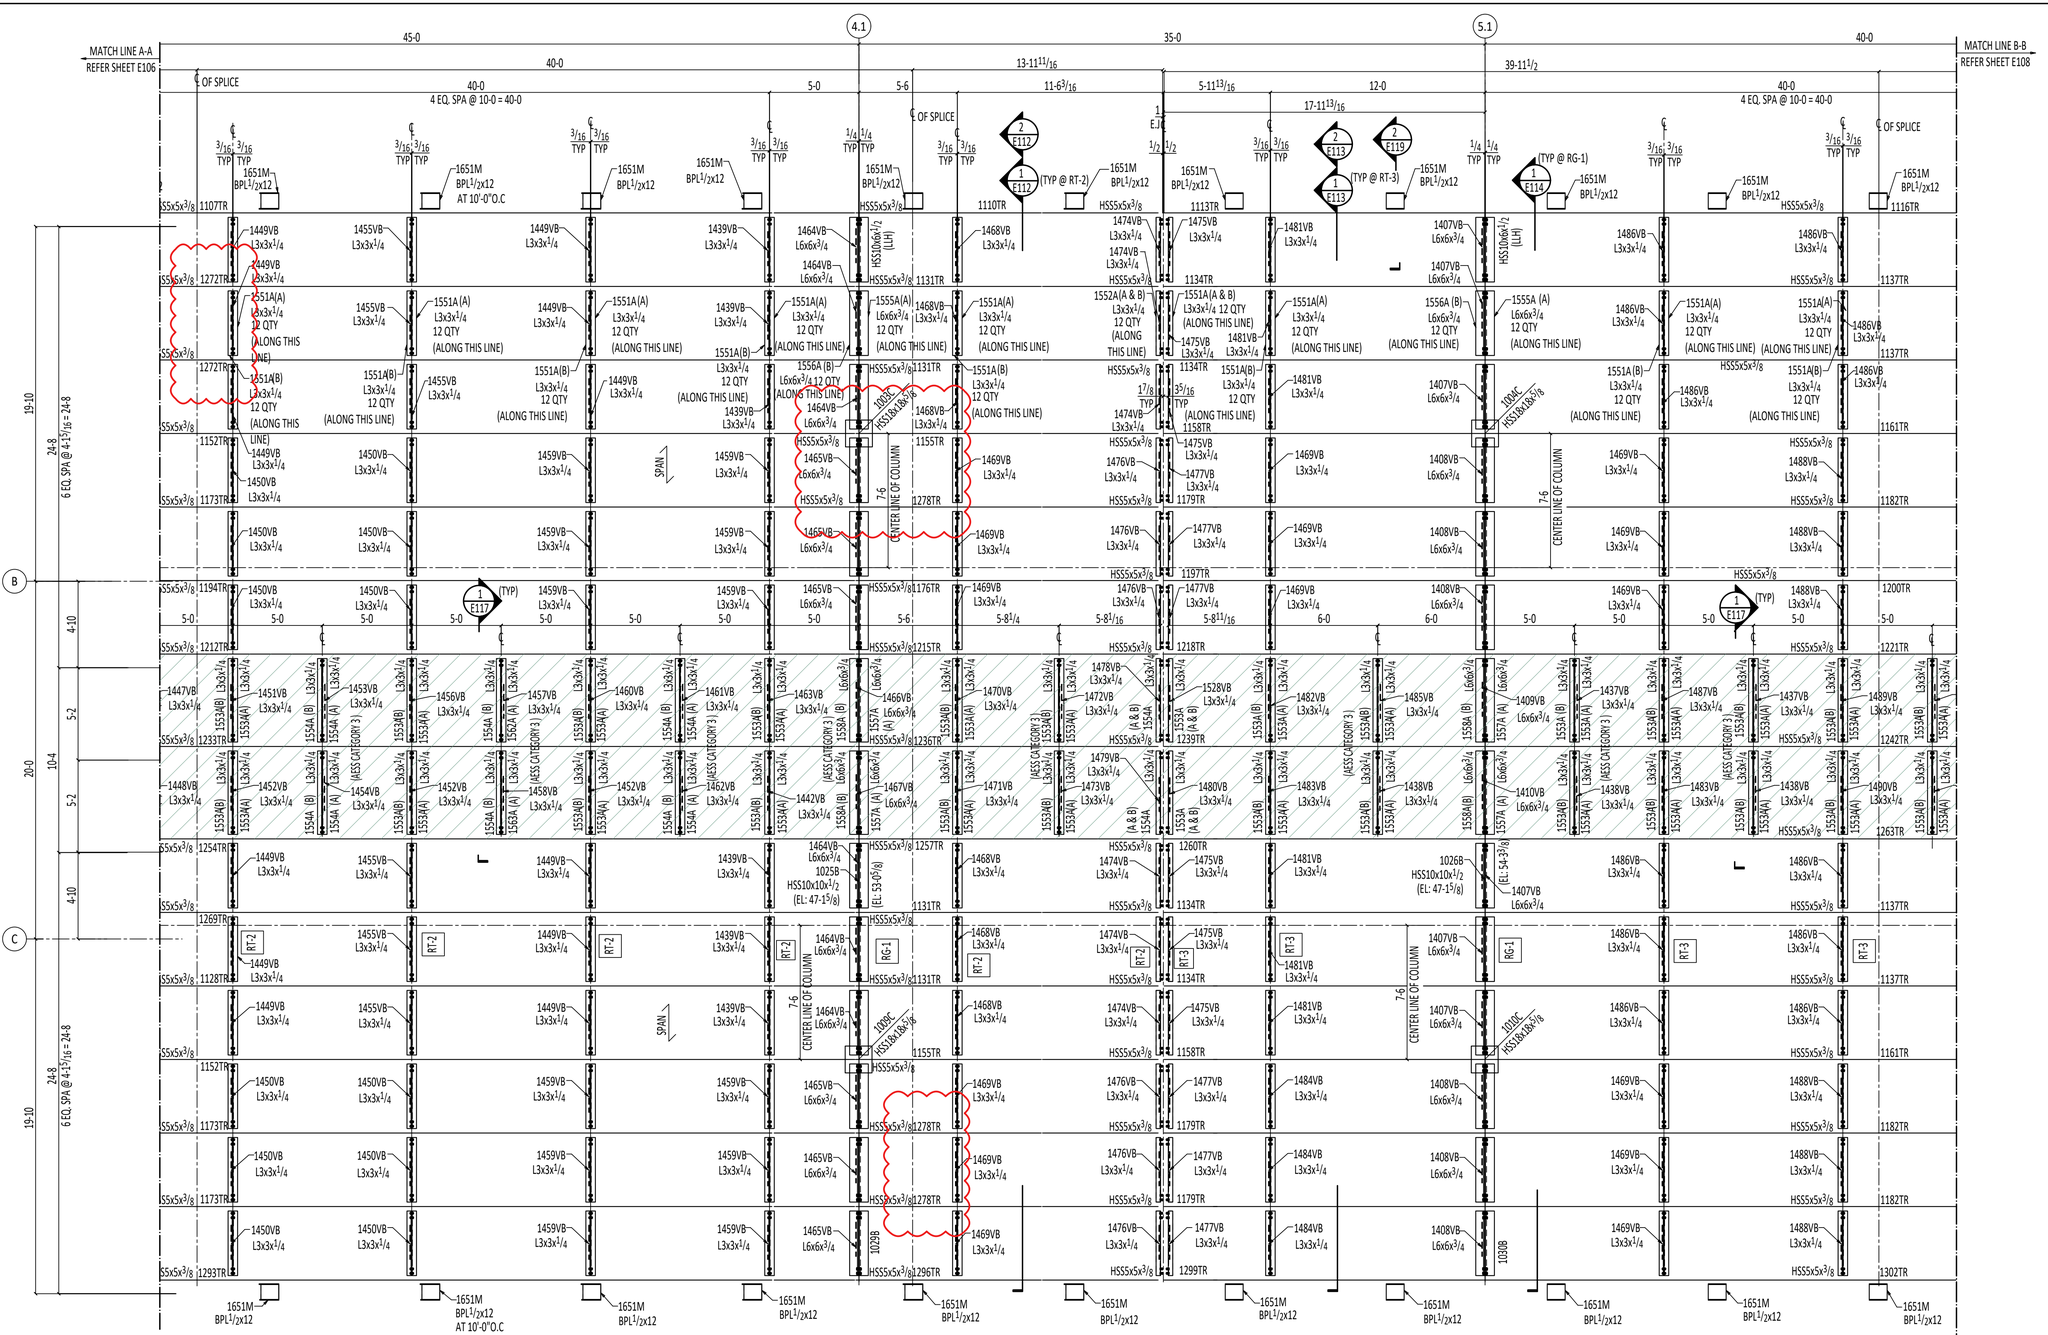

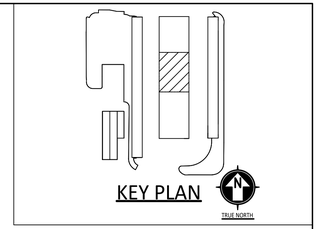

PARTIAL ROOF FRAMING PLAN

(REF: S-CP-2 & S-CP-3)

NOTE:

- TOP OF STEEL EL: REFER E109 TO E111.
- SPAN → INDICATES 1.5 B18 GALVANIZED METAL DECK.
- – – – INDICATES VERTICAL BRACE.
- FOR ELEVATION VIEWS REFER SHEET E109 TO E111.
- FOR TYPICAL SECTIONS REFER SHEET E118.
- FOR SECTIONS AND DETAILS REFER SHEET E119 & E120.

TRUE NORTH

JOB NORTH

READ THIS DRAWING IN CONJUNCTION WITH E106 & E108

REFERENCE : S-CP-2 & S-CP-3

LEGEND:
(A) - INDICATES ABOVE
(B) - INDICATES BELOW
LLH- LONG LEG HORIZONTAL
E.J- EXPANSION JOINT

AISC CERTIFIED FABRICATOR AND ERECTOR

FIELD CONNECTIONS :
HOLES : 13/16" U.N.O
PAINT :

morrow steel Fabricators, Inc.

3620 COPELAND DRIVE
ZEPHYRHILLS, FL. 33542

	PRINTS FOR	DATE	MK	REVISIONS	DATE
			0	RELEASED FOR APPROVAL	Nov 18 2025
			1	RELEASED FOR RE-APPROVAL	Jul 13 2026
			2	RELEASED FOR RE-APPROVAL	Aug 26 2026

STRUCTURE:-	PINELLAS SUNCOAST TRANSIT AUTHORITY
LOCATION:-	CLEARWATER STATION,CLEARWATER,FL.
DETAILER:-	VECTORSHADES LLC
CUSTOMER:-	KOKOLAKIS
ARCH./ENG.:-	CDM SMITH
DESCRIPTION:-	PARTIAL ROOF FRAMING PLAN AT WAVE CANOPY
DRAWN:- SPK	DATE:-11-07-2025 CHK.D:- RAG DATE:-11-14-2025

SHOP BILL	WORK ORDER NO.	DRWG. NO.
	2553	E107 1

MATCH LINE B-B
REFER SHEET E107

PARTIAL ROOF FRAMING PLAN

(REF: S-CP-2 & S-CP-3)

NOTE:

- TOP OF STEEL EL: REFER E109 TO E111.
- SPAN INDICATES 1.5 B18 GALVANIZED METAL DECK.
- ----INDICATES VERTICAL BRACE.
- FOR ELEVATION VIEWS REFER SHEET E109 TO E111.
- FOR TYPICAL SECTIONS REFER SHEET E118.
- FOR SECTIONS AND DETAILS REFER SHEET E119 & E120.

PLAN NORTH

JOB NORTH

READ THIS DRAWING IN CONJUNCTION WITH E106 & E107

APPROVER PLEASE REVIEW AND CONFIRM THE FOLLOWING ITEMS:

1. AT THIS LOCATION, WE CAN FOLLOW A MAXIMUM SPACING FROM CORNER 2-0. DUE TO THE GUSSET PLATE CONNECTION AND BOLT ARRANGEMENT. PLEASE REFER TO THE ISO VIEW FOR MORE CLARIFICATION. PLEASE REVIEW AND CONFIRM IF THIS ARRANGEMENT IS ACCEPTABLE, OR ADVISE AN ALTERNATIVE SOLUTION TO PROCEED FURTHER.

The current arrangement shown is acceptable

LEGEND:
(A) - INDICATES ABOVE
(B) - INDICATES BELOW
LLH- LONG LEG HORIZONTAL
E.J- EXPANSION JOINT

REFERENCE : S-CP-2 & S-CP-3

FIELD CONNECTIONS :
HOLES : 13/16" U.N.O
PAINT :

morrow steel Fabricators, Inc.

AISC CERTIFIED FABRICATOR AND ERECTOR

3620 COPELAND DRIVE
ZEPHYRHILLS, FL. 33542

	PRINTS FOR	DATE	MK	REVISIONS	DATE
			0	RELEASED FOR APPROVAL	Nov 18 2025
			1	RELEASED FOR RE-APPROVAL	Jul 13 2026
			2	RELEASED FOR RE-APPROVAL	Aug 26 2026

STRUCTURE:- PINELLAS SUNCOAST TRANSIT AUTHORITY
LOCATION:- CLEARWATER STATION,CLEARWATER,FL.
DETAILER:- VECTORSHADES LLC
CUSTOMER:- KOKOLAKIS
ARCH./ENG.:- CDM SMITH
DESCRIPTION:- PARTIAL ROOF FRAMING PLAN AT WAVE CANOPY
DRAWN:- SPK DATE:-11-07-2025 CHK.D:- RAG DATE:-11-14-2025

SHOP BILL	WORK ORDER NO.	DRWG. NO.
	2553	E108 1

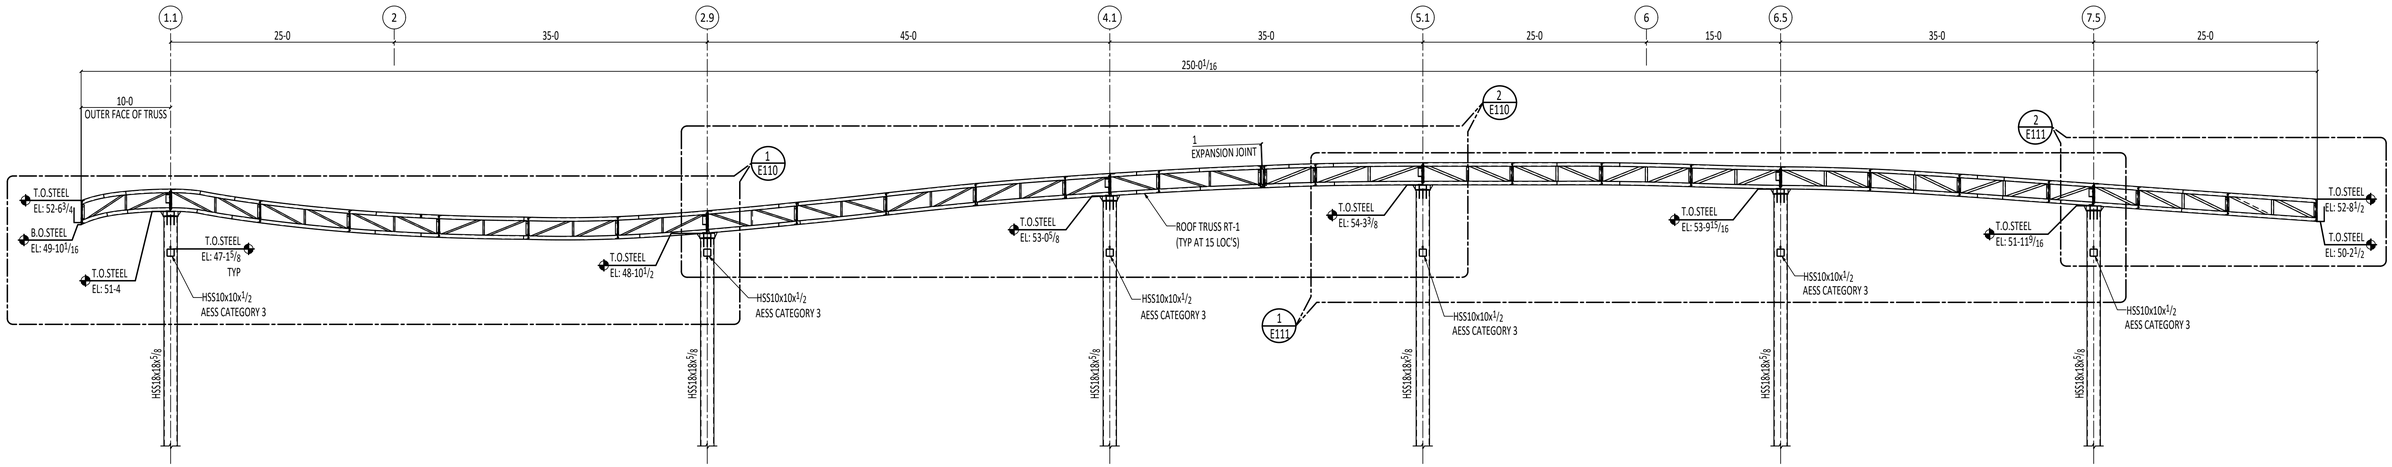

1
E109

OVERALL ROOF TRUSS ELEVATION VIEW

(REF: 1/S-CP-4)

(OTHERS NOT SHOWN FOR CLARITY)

REFERENCE : S-CP-4

FIELD CONNECTIONS : _____

HOLES : 13/16" U.N.O

PAINT : _____

morrow steel Fabricators, Inc.

3620 COPELAND DRIVE
ZEPHYRHILLS, FL. 33542

	PRINTS FOR	DATE	MK	REVISIONS	DATE
			0	RELEASED FOR APPROVAL	Nov 18 2025
			1	RELEASED FOR RE-APPROVAL	Jul 13 2026
			2	RELEASED FOR RE-APPROVAL	Aug 26 2026

STRUCTURE:- PINELLAS SUNCOAST TRANSIT AUTHORITY
LOCATION:- CLEARWATER STATION,CLEARWATER,FL.
DETAILER:- VECTORSHADES LLC
CUSTOMER:- KOKOLAKIS
ARCH./ENG.:- CDM SMITH
DESCRIPTION:- OVERALL ROOF TRUSS ELEVATION VIEWS
DRAWN:- SHR DATE:- 11-10-2025 CHK.D:- RAG DATE:- 11-11-2025

SHOP BILL	WORK ORDER NO.	DRWG. NO.
	2553	E109

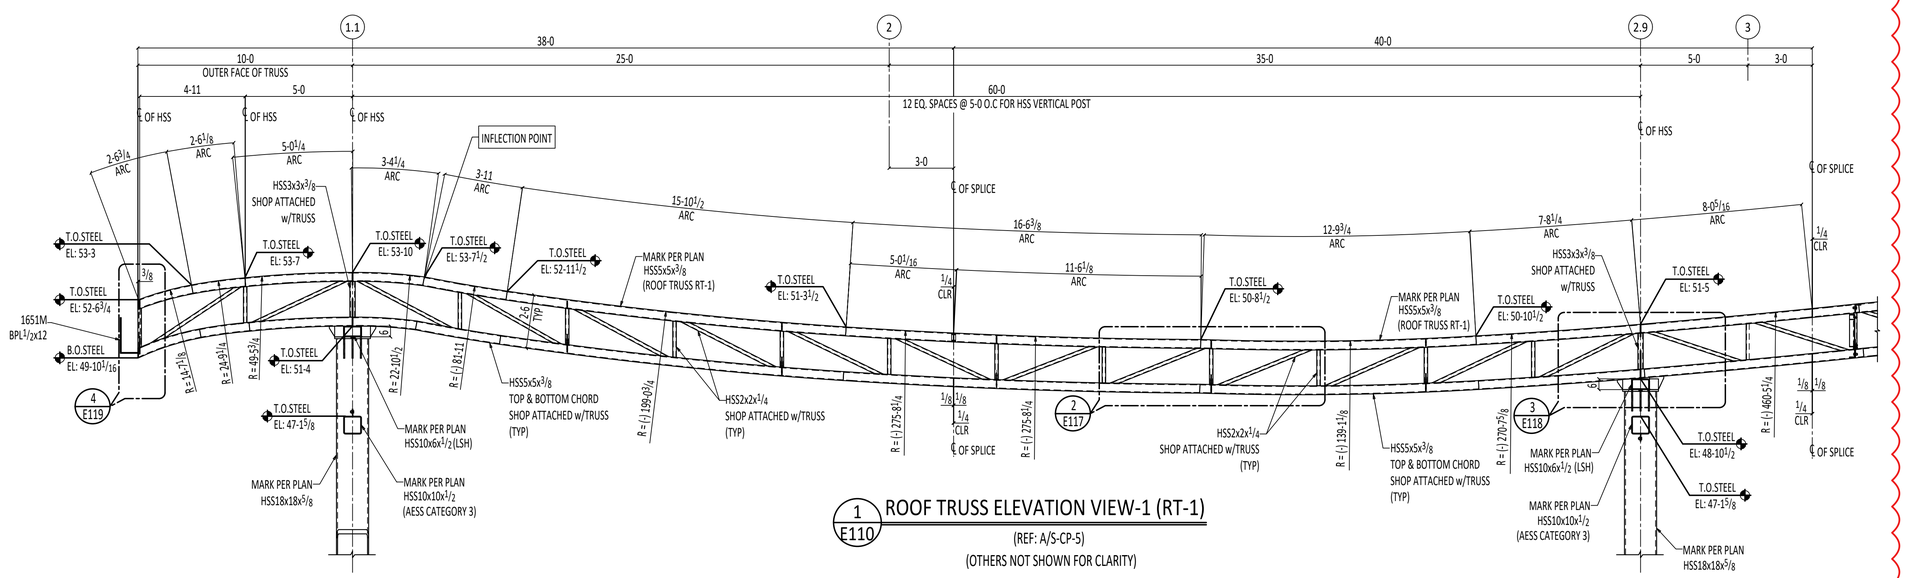

1 E110 ROOF TRUSS ELEVATION VIEW-1 (RT-1)

(REF: A/S-CP-5)

(OTHERS NOT SHOWN FOR CLARITY)

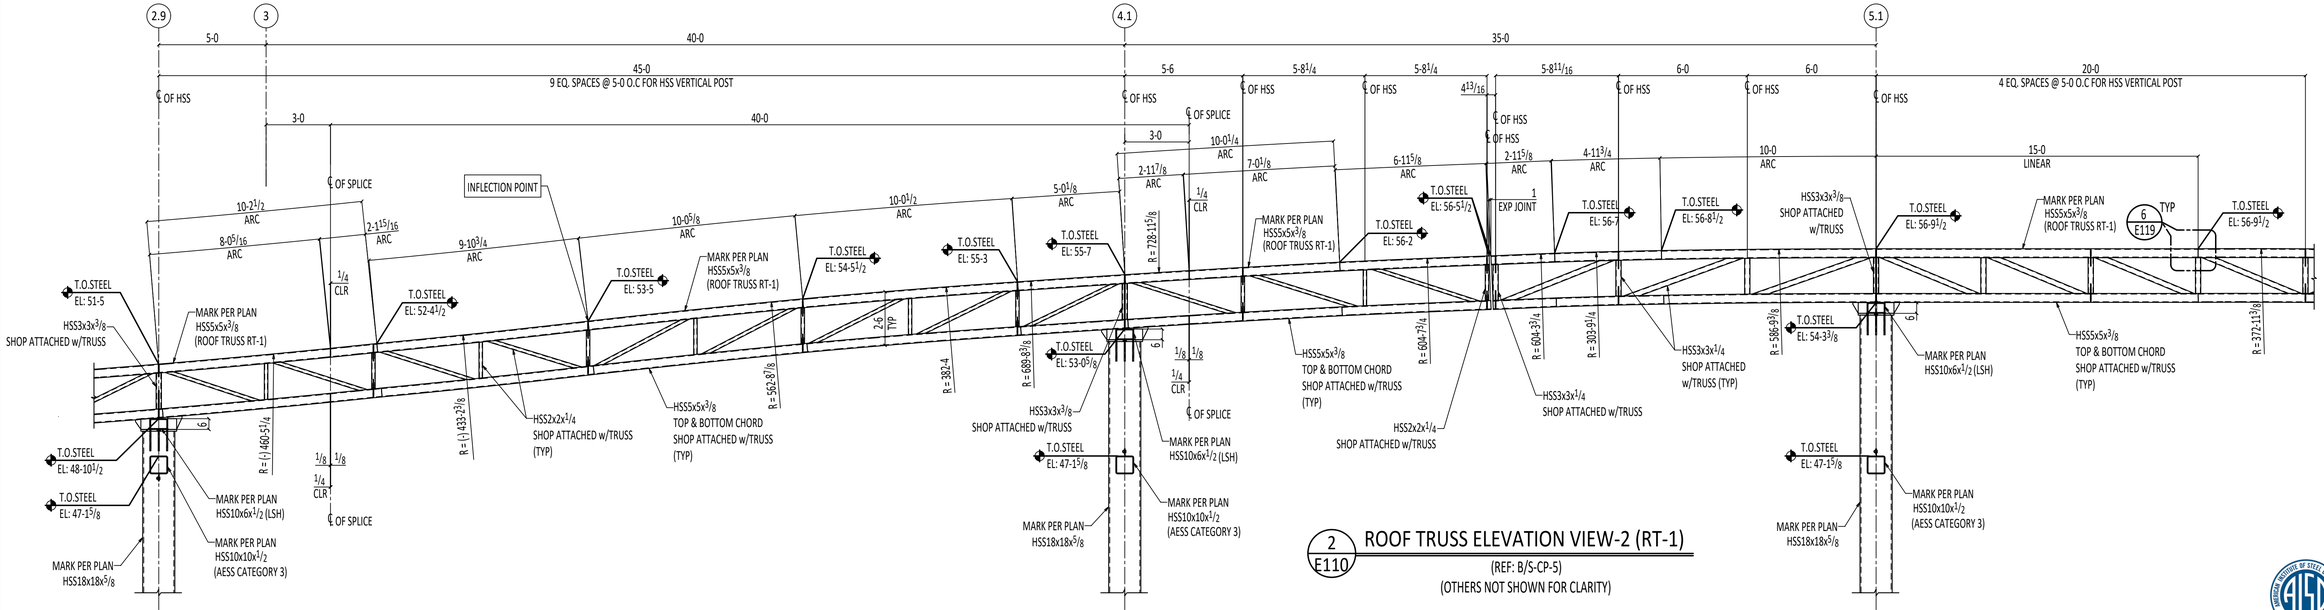

2 E110 ROOF TRUSS ELEVATION VIEW-2 (RT-1)

(REF: B/S-CP-5)

(OTHERS NOT SHOWN FOR CLARITY)

REFERENCE : S-CP-4, 5 & 6

FIELD CONNECTIONS : ———
HOLES : 13/16" U.N.O
PAINT : ———

morrow steel Fabricators, Inc.

3620 COPELAND DRIVE
ZEPHYRHILLS, FL. 33542

	PRINTS FOR	DATE	MK	REVISIONS	DATE
			0	RELEASED FOR APPROVAL	Nov 18 2025
			1	RELEASED FOR RE-APPROVAL	Jul 13 2026
			2	RELEASED FOR RE-APPROVAL	Aug 26 2026

STRUCTURE:- PINELLAS SUNCOAST TRANSIT AUTHORITY
LOCATION:- CLEARWATER STATION,CLEARWATER,FL.
DETAILER:- VECTORSHADES LLC
CUSTOMER:- KOKOLAKIS
ARCH./ENG.:- CDM SMITH
DESCRIPTION:- ROOF TRUSS ELEVATION VIEWS
DRAWN:- SHR DATE:- 11-10-2025 CHK.D:- RAG DATE:- 11-11-2025

SHOP BILL	WORK ORDER NO.	DRWG. NO.
	2553	E110 ⚠2

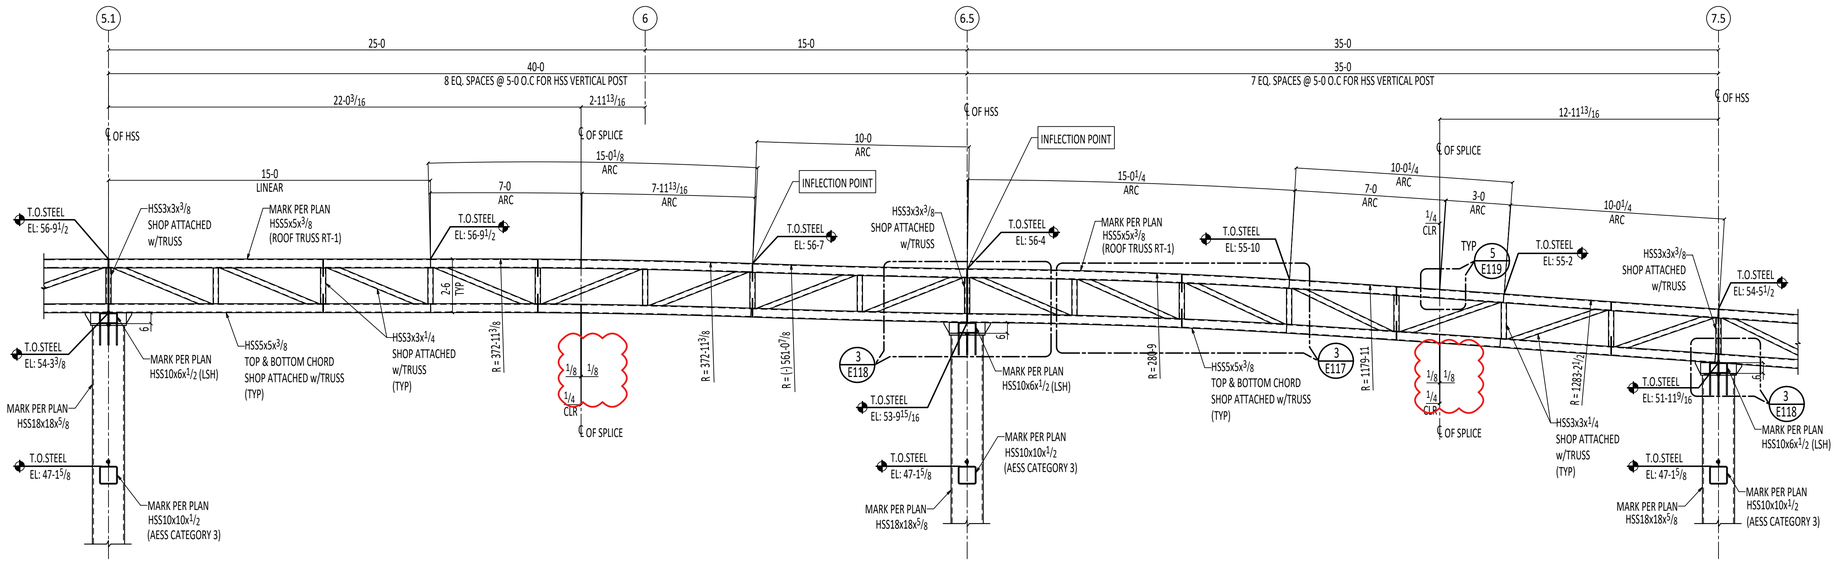

1 E111 ROOF TRUSS ELEVATION VIEW-3 (RT-1)

(REF: C/S-CP-5)
(OTHERS NOT SHOWN FOR CLARITY)

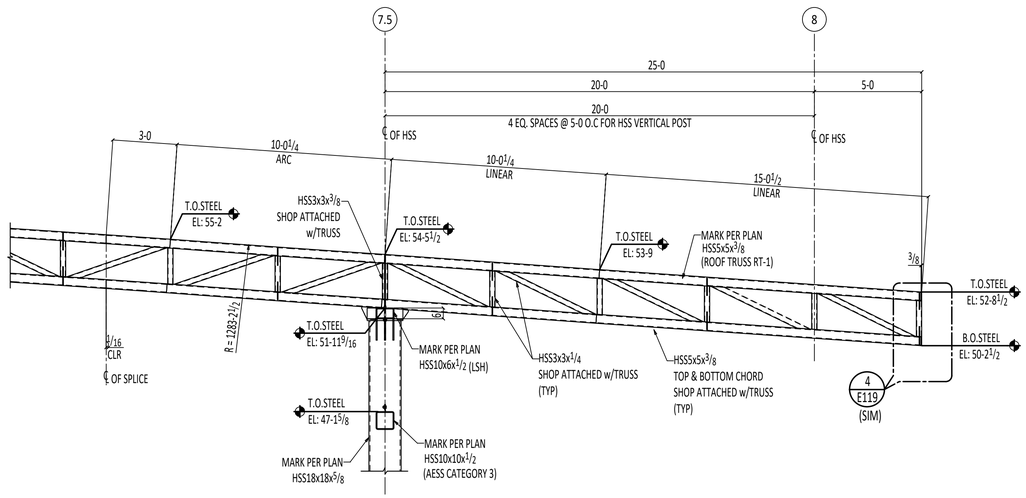

2 E111 ROOF TRUSS ELEVATION VIEW-4 (RT-1)

(REF: D/S-CP-6)
(OTHERS NOT SHOWN FOR CLARITY)

REFERENCE : S-CP-4, 5 & 6

FIELD CONNECTIONS :
HOLES : 13/16" U.N.O
PAINT :

morrow steel Fabricators, Inc.

AISC CERTIFIED FABRICATOR AND ERECTOR

3620 COPELAND DRIVE
ZEPHYRHILLS, FL. 33542

	PRINTS FOR	DATE	MK	REVISIONS	DATE
			0	RELEASED FOR APPROVAL	Nov 18 2025
			1	RELEASED FOR RE-APPROVAL	Jul 13 2026
			2	RELEASED FOR RE-APPROVAL	Aug 26 2026

STRUCTURE:- PINELLAS SUNCOAST TRANSIT AUTHORITY
LOCATION:- CLEARWATER STATION,CLEARWATER,FL.
DETAILER:- VECTORSHADES LLC
CUSTOMER:- KOKOLAKIS
ARCH./ENG.:- CDM SMITH
DESCRIPTION:- ROOF TRUSS ELEVATION VIEWS
DRAWN:- SHR DATE:- 11-10-2025 CHK.D:- RAG DATE:- 11-11-2025

SHOP BILL	WORK ORDER NO.	DRWG. NO.
	2553	E111

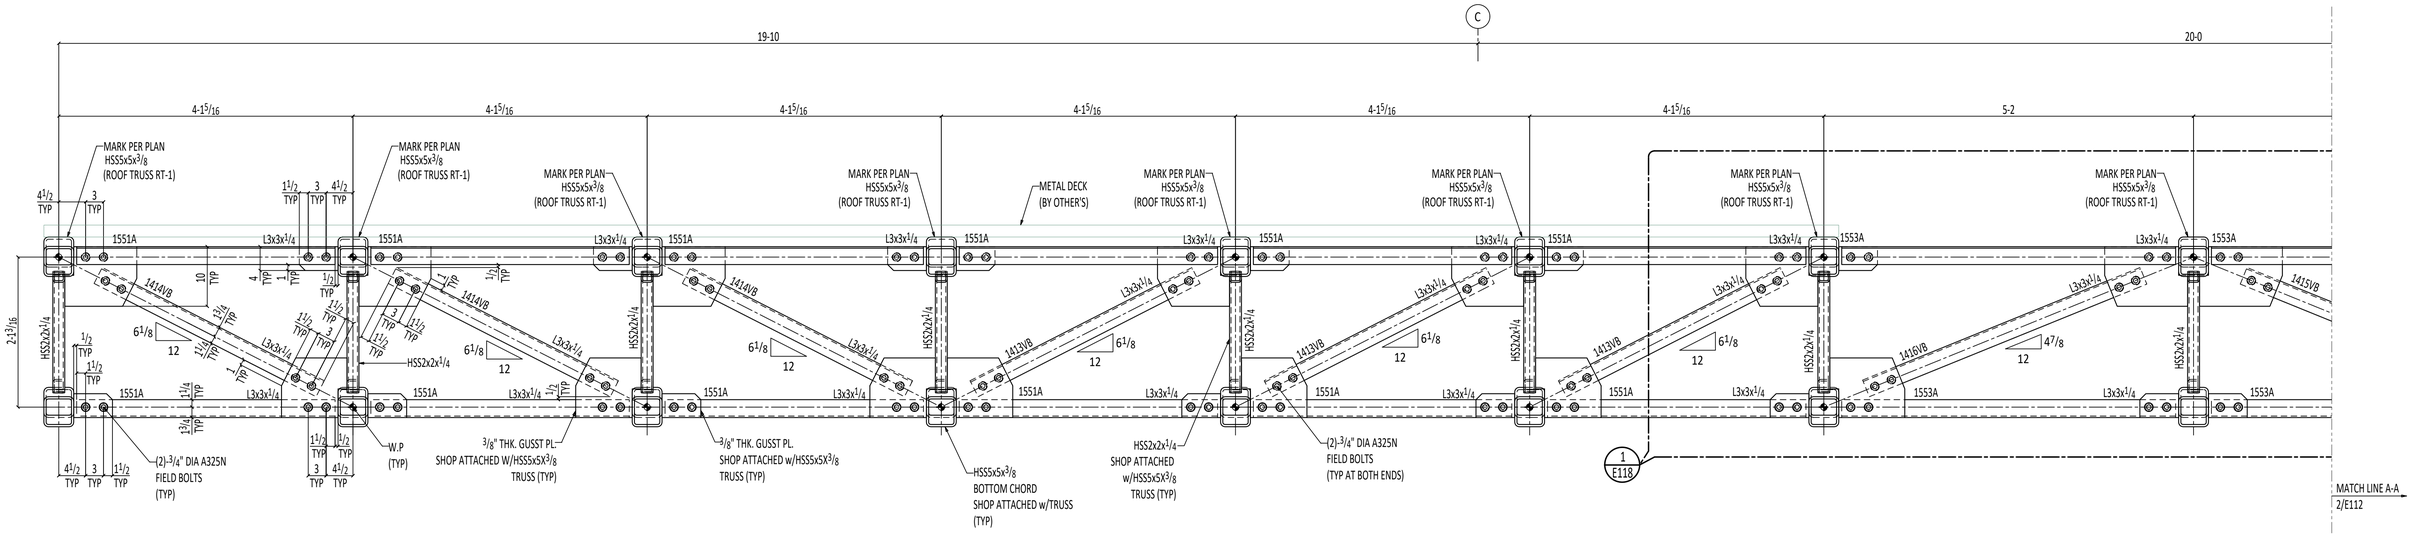

ROOF TRUSS ELEVATION VIEW-RT-2
TYPICAL AT NORTH OF EXPANSION JOINT

1 / E112

(REF: 1/S-CP-6)

(OTHERS NOT SHOWN FOR CLARITY)

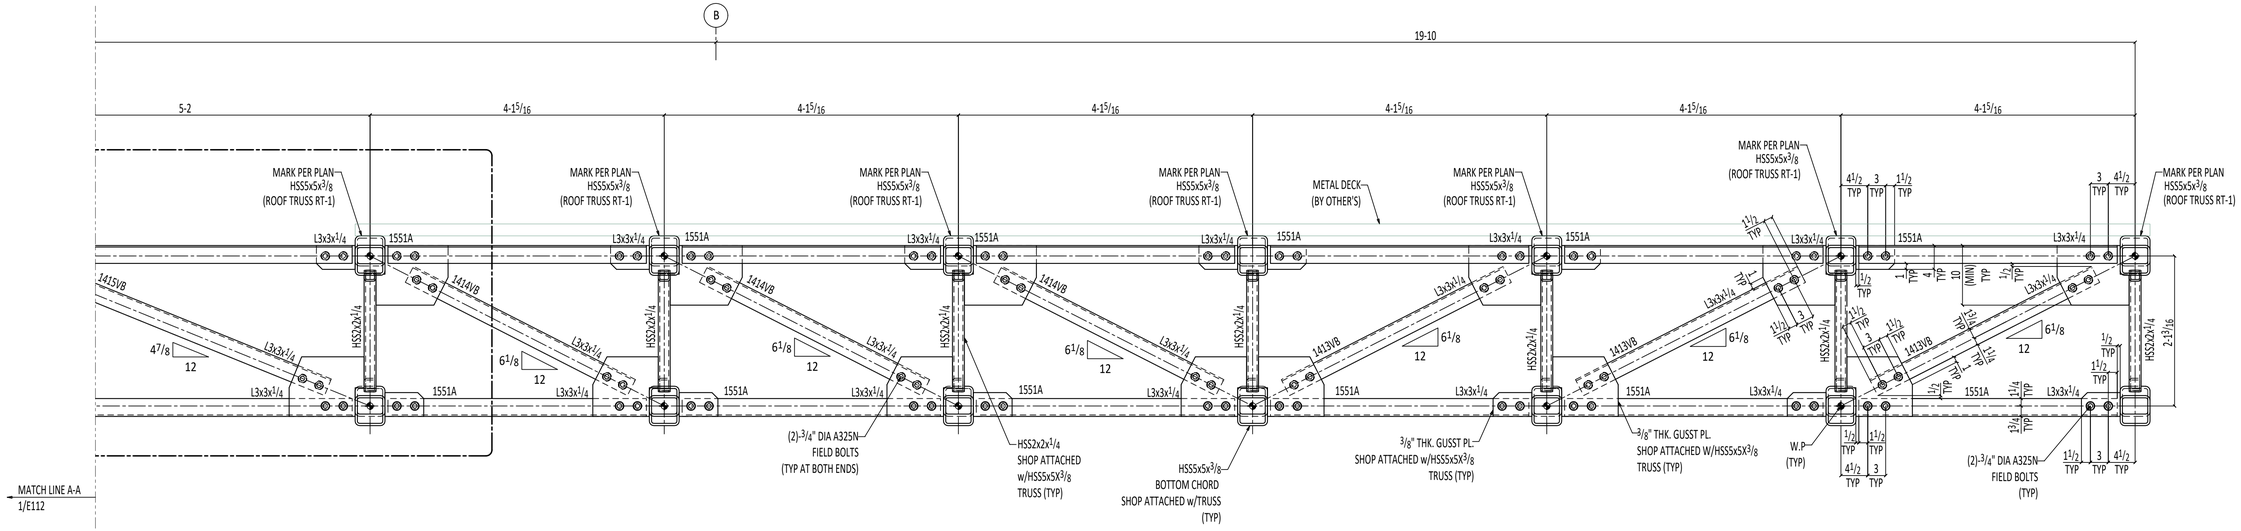

ROOF TRUSS ELEVATION VIEW-RT-2
TYPICAL AT NORTH OF EXPANSION JOINT

2 / E112

(REF: 1/S-CP-6)

(OTHERS NOT SHOWN FOR CLARITY)

REFERENCE : 1/S-CP-6

FIELD CONNECTIONS : ____
HOLES : 13/16" U.N.O
PAINT : ____

morrow steel Fabricators, Inc.

3620 COPELAND DRIVE
ZEPHYRHILLS, FL. 33542

	PRINTS FOR	DATE	MK	REVISIONS	DATE
			0	RELEASED FOR APPROVAL	Nov 18 2025
			1	RELEASED FOR RE-APPROVAL	Jul 13 2026
			2	RELEASED FOR RE-APPROVAL	Aug 26 2026

STRUCTURE:-	PINELLAS SUNCOAST TRANSIT AUTHORITY
LOCATION:-	CLEARWATER STATION,CLEARWATER,FL.
DETAILER:-	VECTORSHADES LLC
CUSTOMER:-	KOKOLAKIS
ARCH./ENG.:-	CDM SMITH
DESCRIPTION:-	ROOF TRUSS ELEVATION VIEWS
DRAWN:- SHR	DATE:- 11-10-2025 CHK.D:- RAG DATE:- 11-11-2025

SHOP BILL	WORK ORDER NO.	DRWG. NO.
	2553	E112 ⚠1

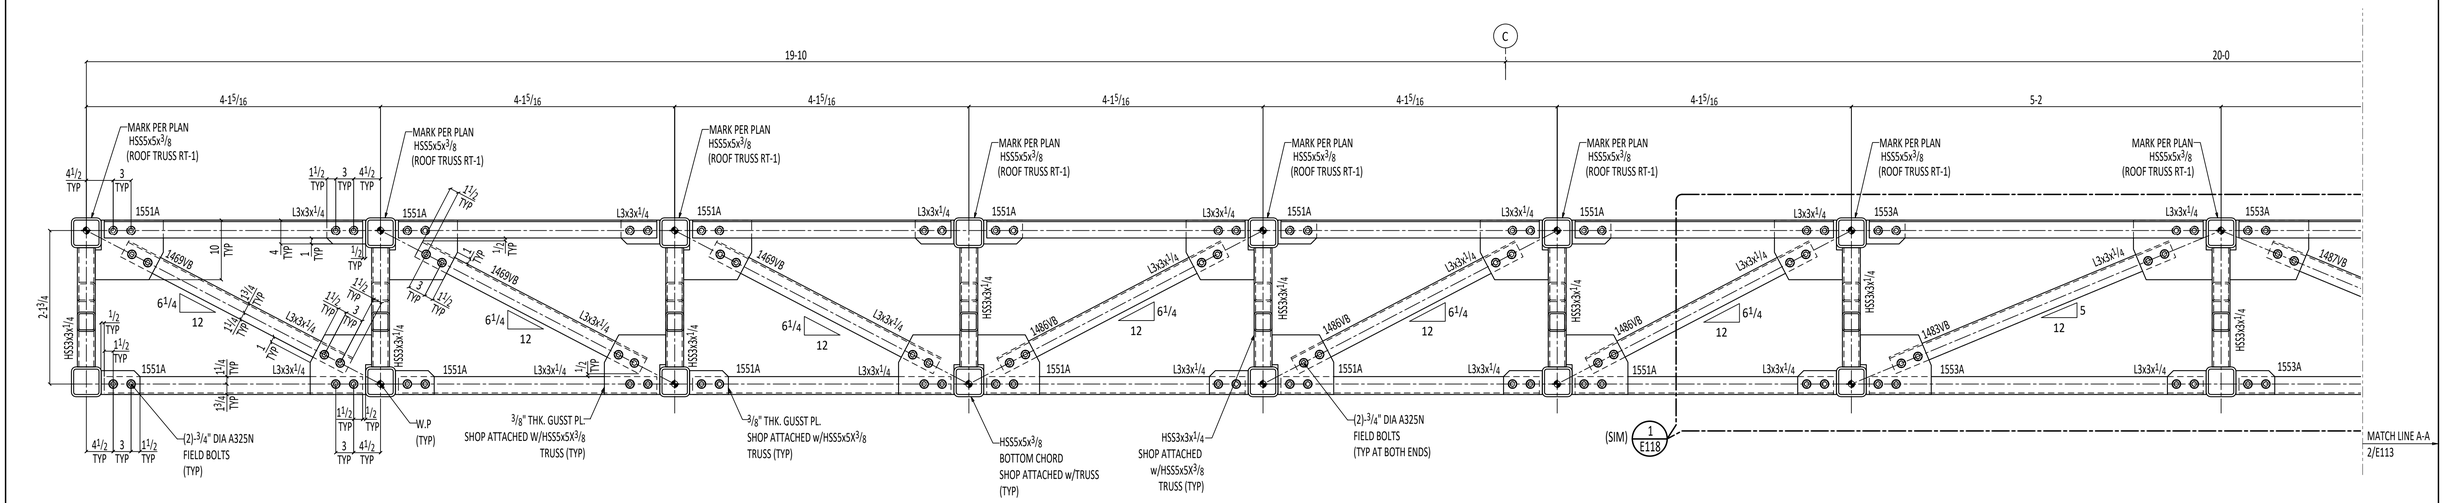

ROOF TRUSS ELEVATION VIEW-RT-3
TYPICAL AT SOUTH OF EXPANSION JOINT

1/E113

(REF: 2/S-CP-6)
(OTHERS NOT SHOWN FOR CLARITY)

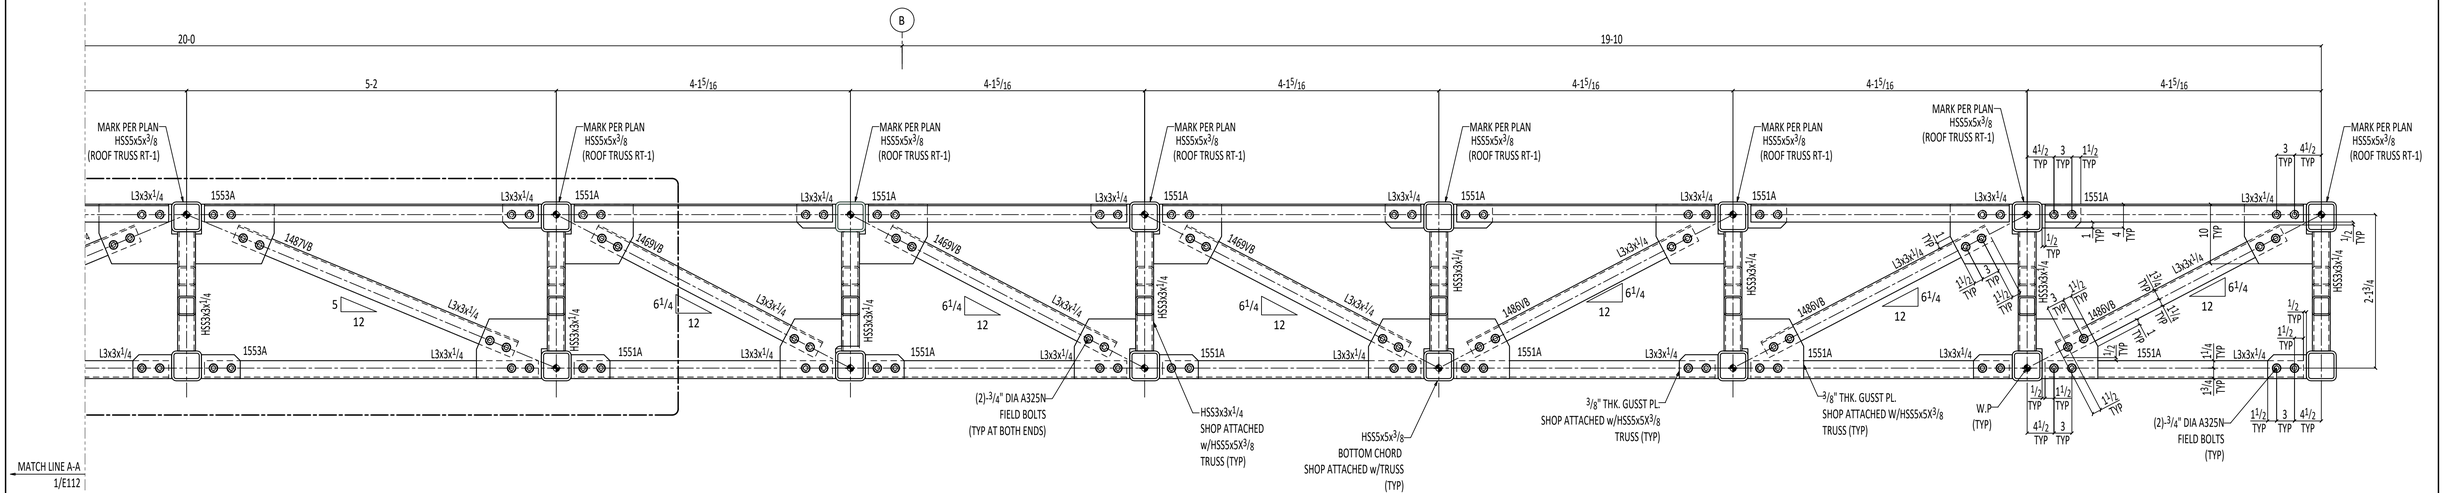

ROOF TRUSS ELEVATION VIEW-RT-3
TYPICAL AT SOUTH OF EXPANSION JOINT

2/E113

(REF: 2/S-CP-6)
(OTHERS NOT SHOWN FOR CLARITY)

REFERENCE : S-CP-4, 5 & 6

FIELD CONNECTIONS : "
HOLES : 13/16" U.N.O
PAINT :

morrow steel Fabricators, Inc.

3620 COPELAND DRIVE
ZEPHYRHILLS, FL. 33542

	PRINTS FOR	DATE	MK	REVISIONS	DATE
			0	RELEASED FOR APPROVAL	Nov 18 2025
			1	RELEASED FOR RE-APPROVAL	Jul 13 2026
			2	RELEASED FOR RE-APPROVAL	Aug 26 2026

STRUCTURE:-	PINELLAS SUNCOAST TRANSIT AUTHORITY
LOCATION:-	CLEARWATER STATION,CLEARWATER,FL.
DETAILER:-	VECTORSHADES LLC
CUSTOMER:-	KOKOLAKIS
ARCH./ENG.:-	CDM SMITH
DESCRIPTION:-	ROOF TRUSS ELEVATION VIEWS
DRAWN:- SHR	DATE:- 11-10-2025 CHK,D:- RAG DATE:- 11-11-2025

SHOP BILL	WORK ORDER NO.	DRWG. NO.
	2553	E113 ⚠1

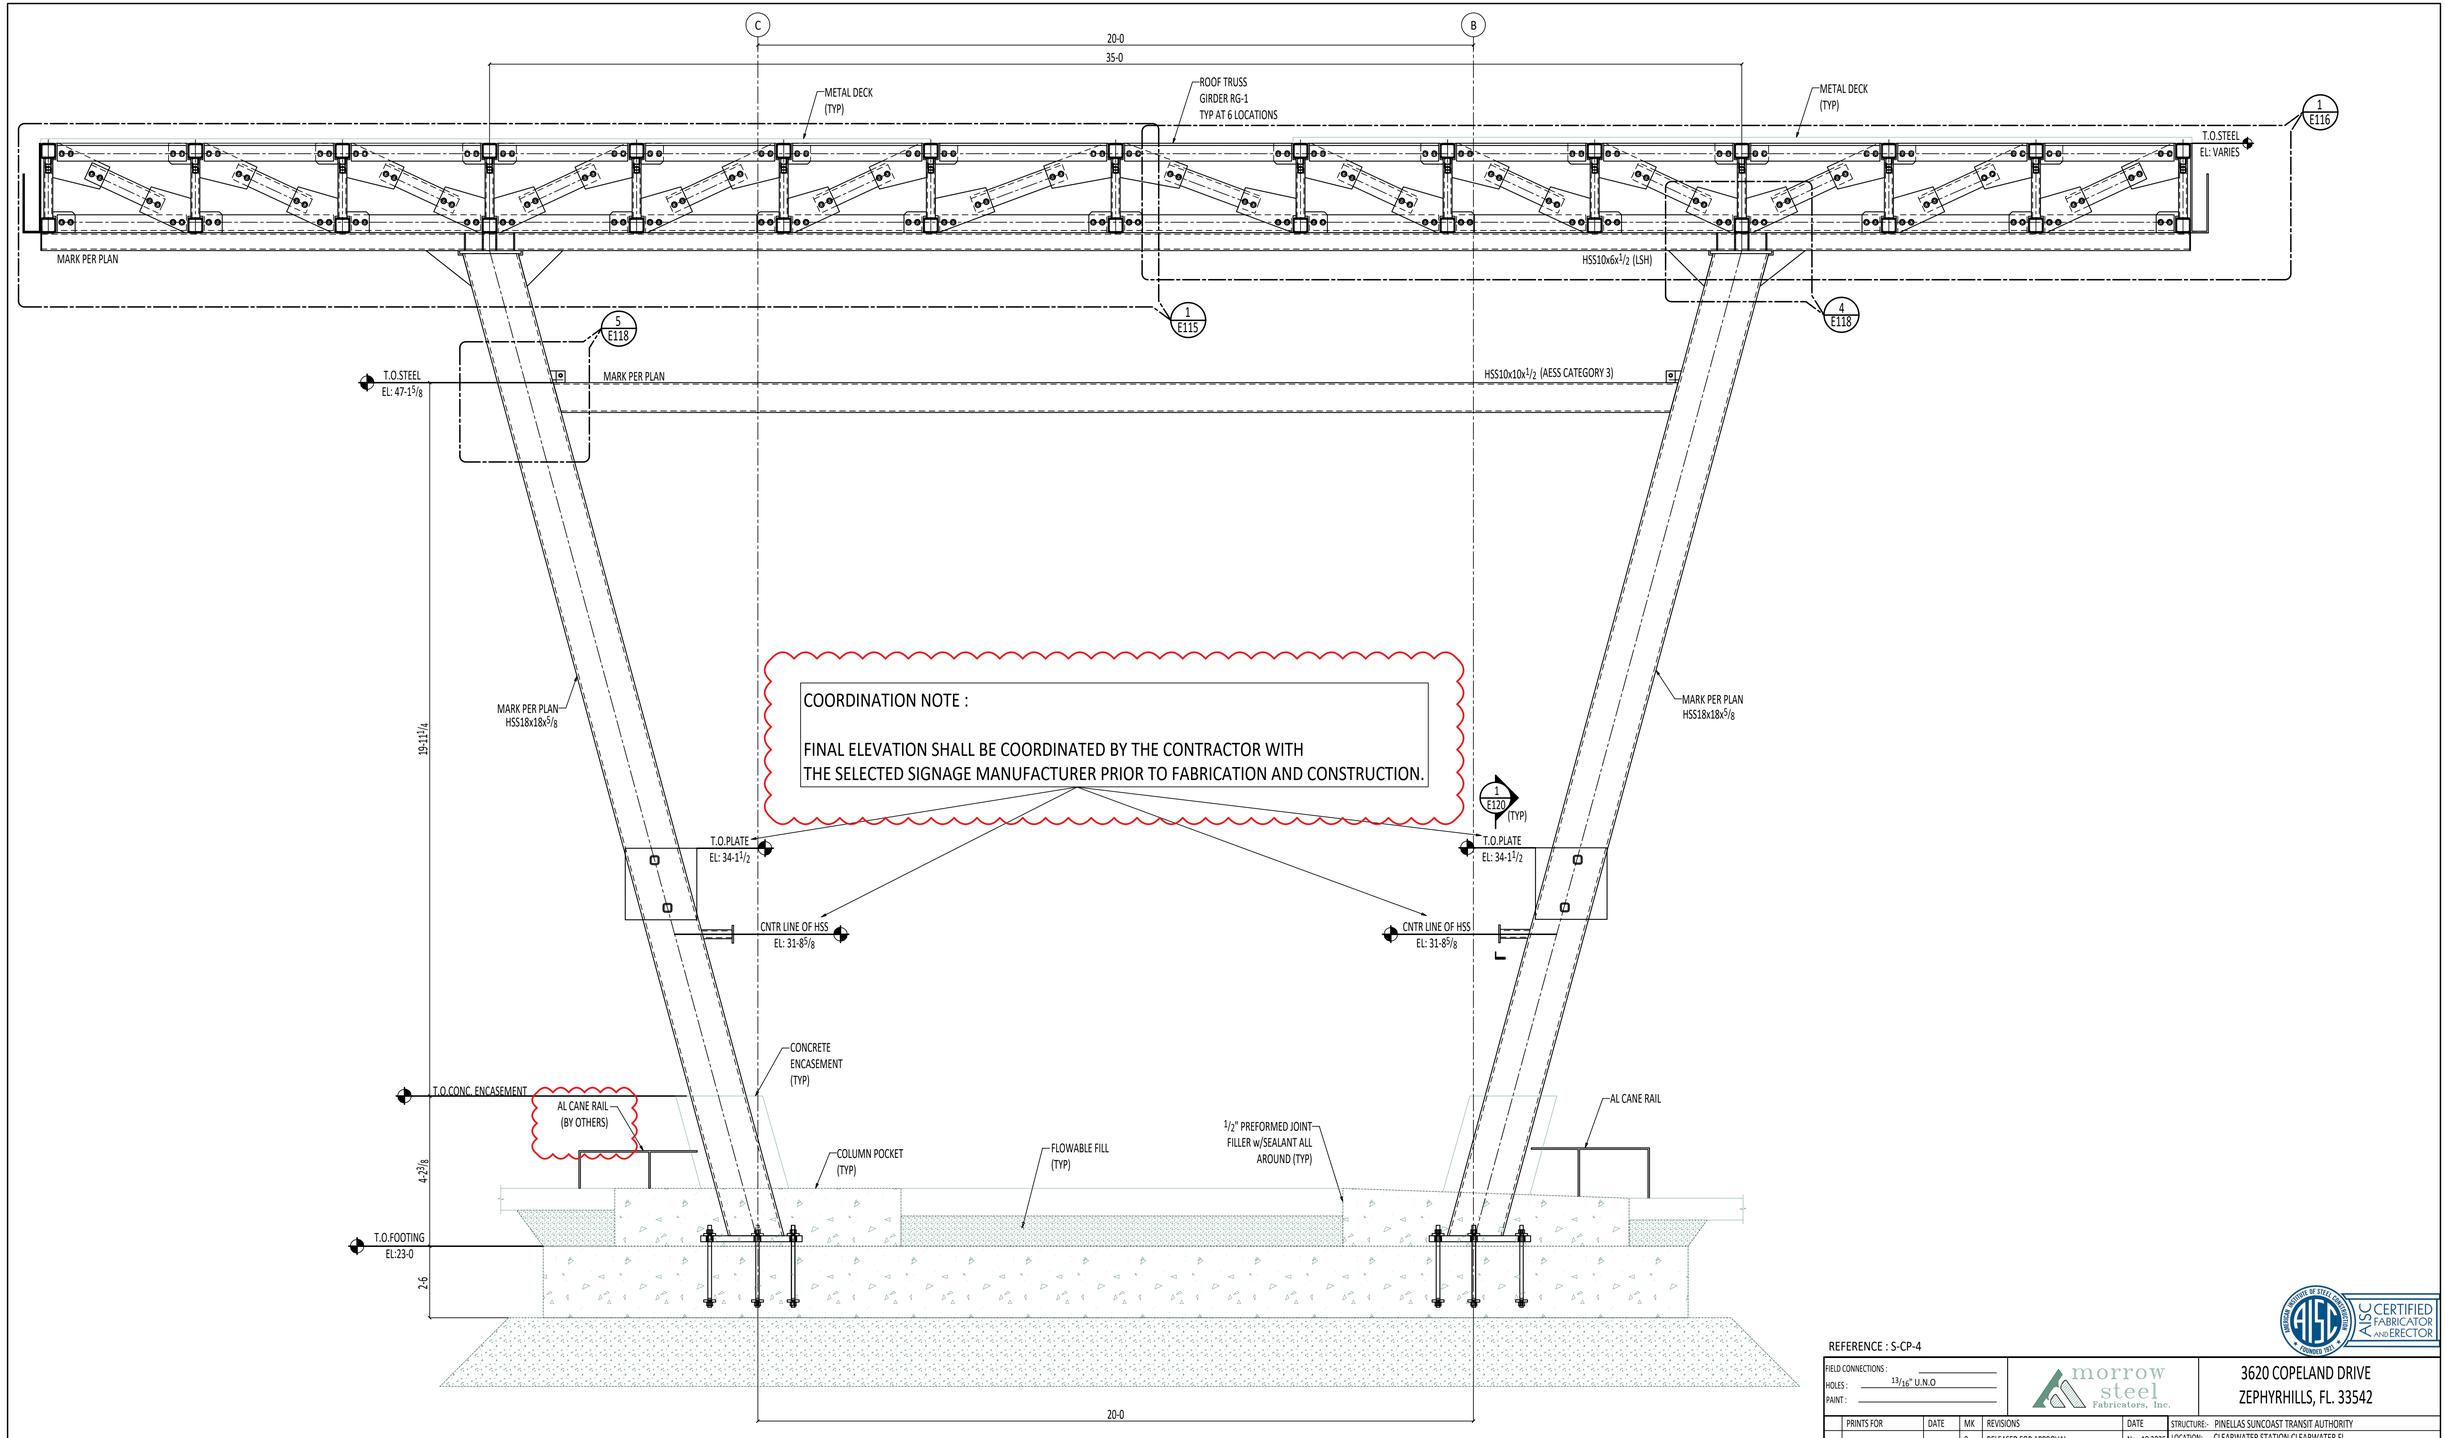

1 / E114 ROOF TRUSS GIRDER ELEVATION VIEW-(RG-1)

(REF: 2/S-CP-4)

(OTHERS NOT SHOWN FOR CLARITY)

REFERENCE : S-CP-4

FIELD CONNECTIONS :

HOLES : 13/16" U.N.O

PAINT :

morrow steel Fabricators, Inc.

3620 COPELAND DRIVE
ZEPHYRHILLS, FL. 33542

	PRINTS FOR	DATE	MK	REVISIONS	DATE
			0	RELEASED FOR APPROVAL	Nov 18 2025
			1	RELEASED FOR RE-APPROVAL	Jul 13 2026
			2	RELEASED FOR RE-APPROVAL	Aug 26 2026

STRUCTURE:- PINELLAS SUNCOAST TRANSIT AUTHORITY
LOCATION:- CLEARWATER STATION,CLEARWATER,FL.
DETAILER:- VECTORSHADES LLC
CUSTOMER:- KOKOLAKIS
ARCH./ENG.:- CDM SMITH
DESCRIPTION:- OVERALL ROOF TRUSS GIRDER ELEVATION VIEW-(RG-1)
DRAWN:- SHR DATE:- 11-10-2025 CHK.D:- RAG DATE:- 11-11-2025

SHOP BILL	WORK ORDER NO.	DRWG. NO.
	2553	E114 ⚠

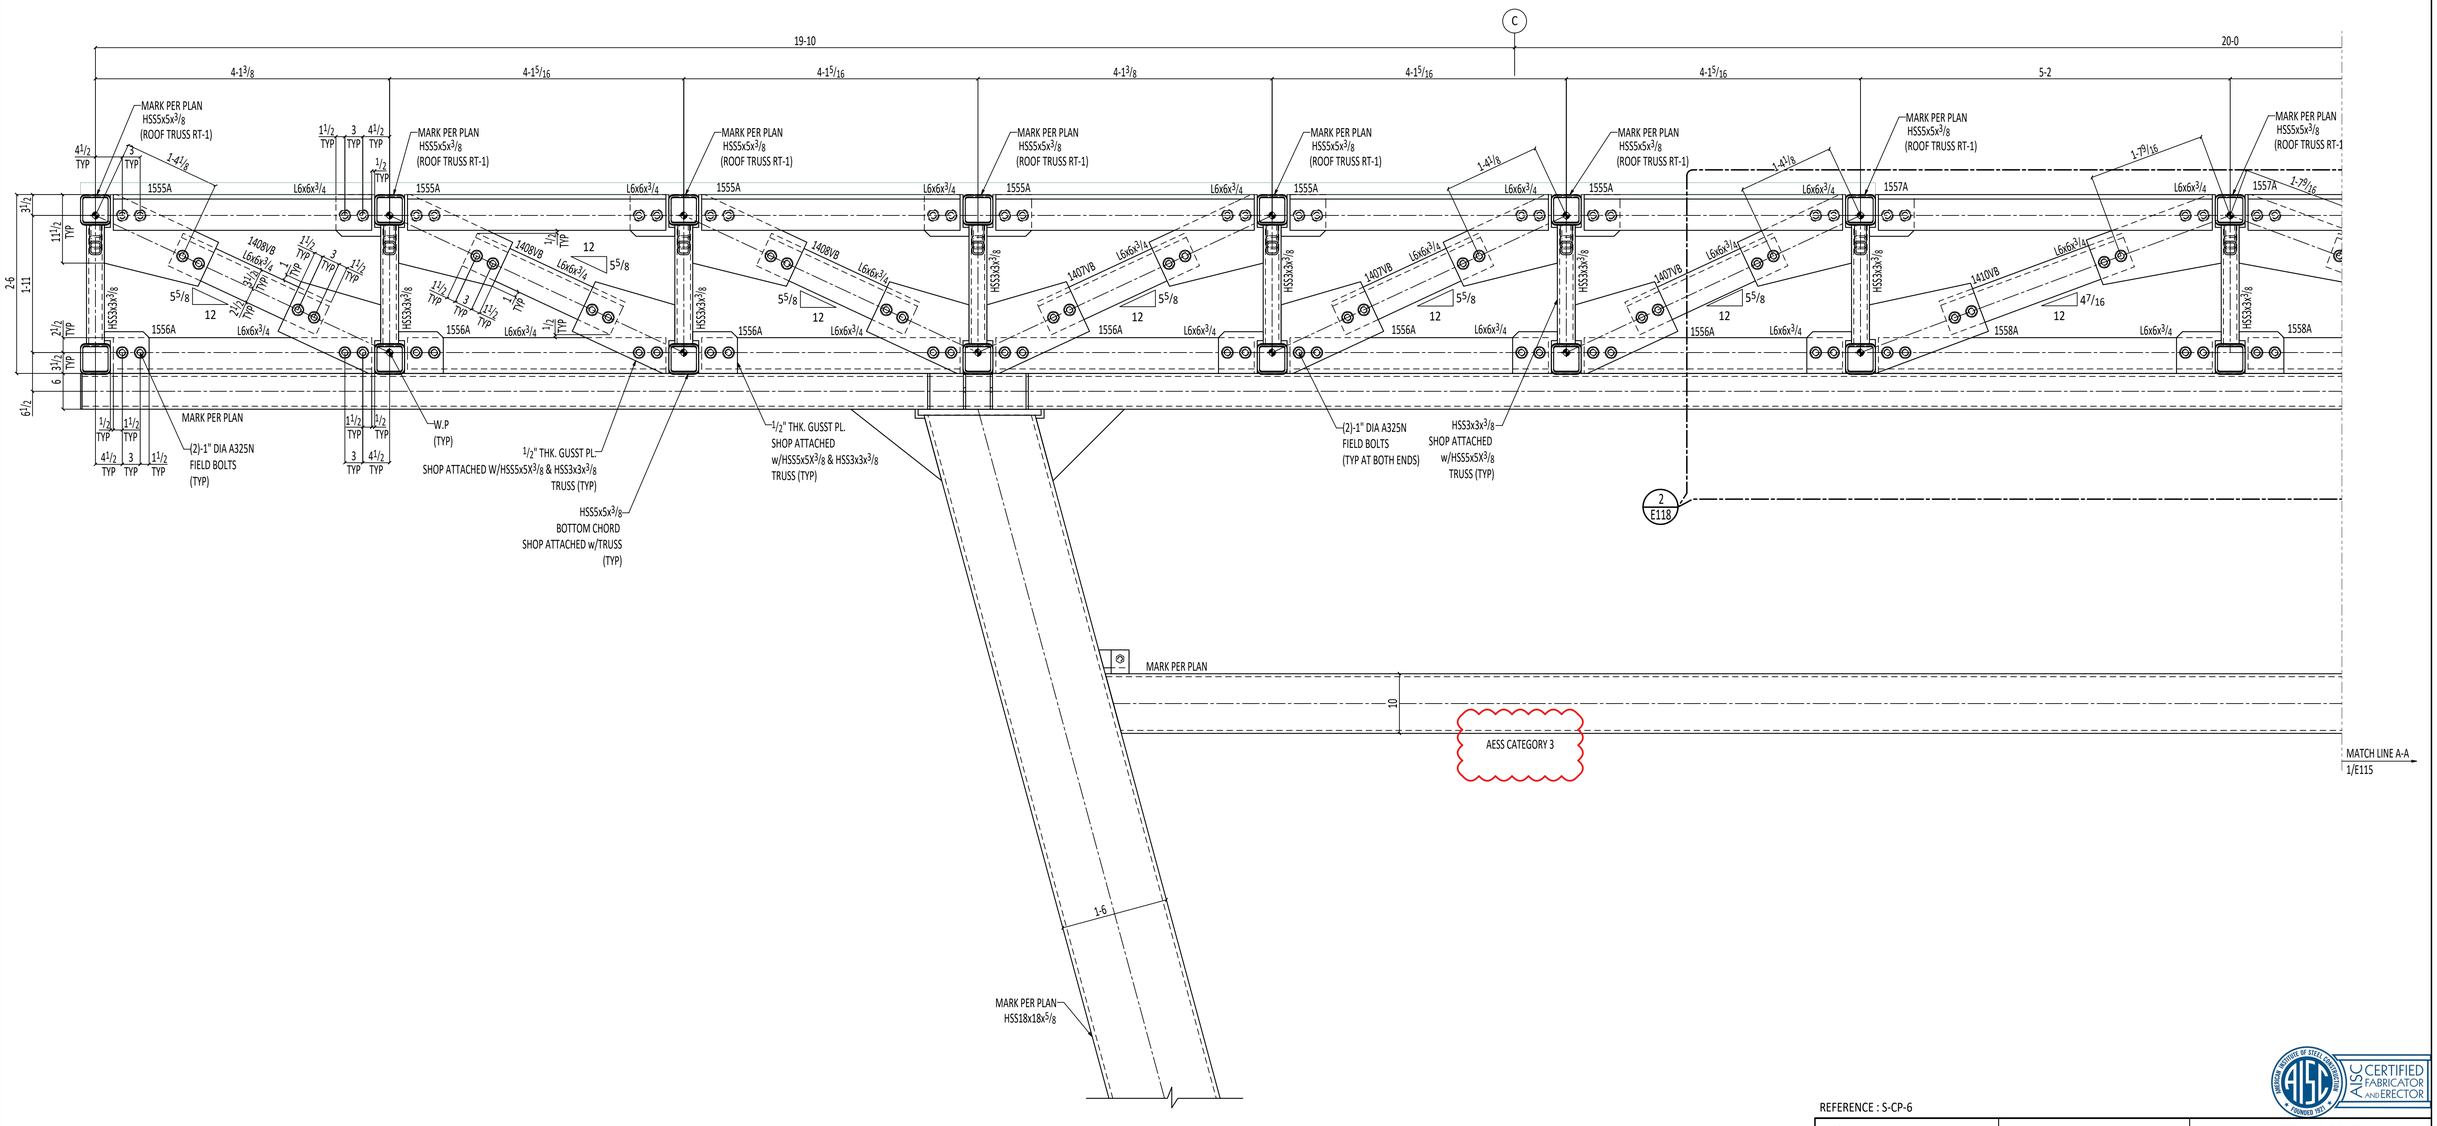

ROOF TRUSS GIRDER ELEVATION VIEW-RG-1
TYPICAL AT COLUMN GRIDS

1 / E115

(REF: 3/S-CP-6)
(OTHERS NOT SHOWN FOR CLARITY)

REFERENCE : S-CP-6

FIELD CONNECTIONS :
HOLES : 13/16" U.N.O
PAINT :

morrow steel Fabricators, Inc.

3620 COPELAND DRIVE
ZEPHYRHILLS, FL. 33542

	PRINTS FOR	DATE	MK	REVISIONS	DATE
			0	RELEASED FOR APPROVAL	Nov 18 2025
			1	RELEASED FOR RE-APPROVAL	Jul 13 2026
			2	RELEASED FOR RE-APPROVAL	Aug 26 2026

STRUCTURE:-	PINELLAS SUNCOAST TRANSIT AUTHORITY
LOCATION:-	CLEARWATER STATION,CLEARWATER,FL.
DETAILER:-	VECTORSHADES LLC
CUSTOMER:-	KOKOLAKIS
ARCH./ENG.:-	CDM SMITH
DESCRIPTION:-	RG-1 TRUSS ELEVATION VIEW
DRAWN:- SHR	DATE:-10-09-2025 CHK.D:- RAG DATE:-10-10-2025

SHOP BILL	WORK ORDER NO.	DRWG. NO.
	2553	E115 ⚠

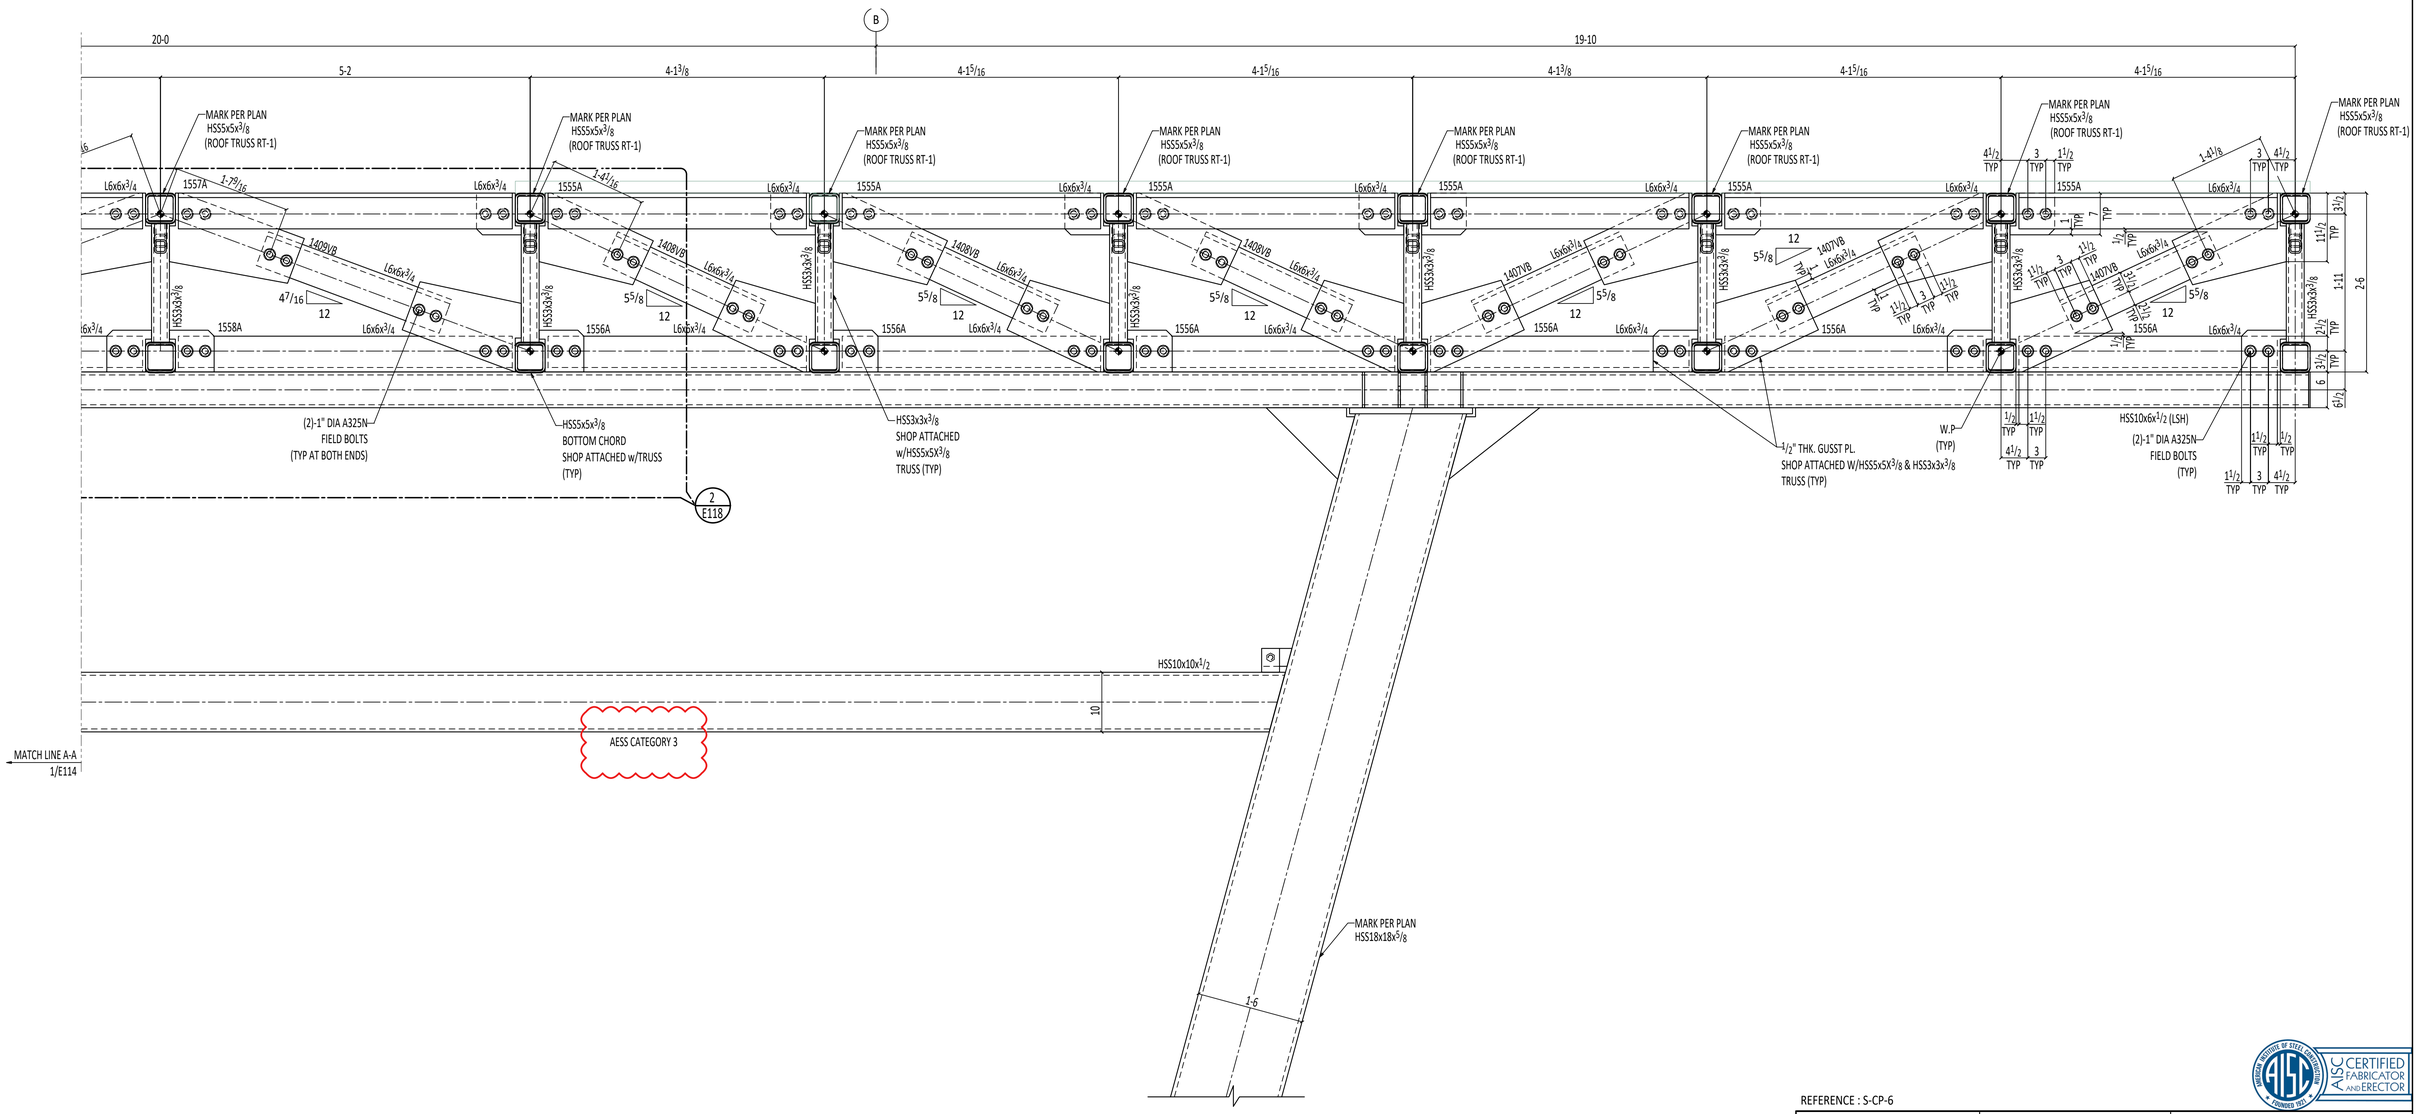

ROOF TRUSS GIRDER ELEVATION VIEW-RG-1
TYPICAL AT COLUMN GRIDS

1
E116

(REF: 3/S-CP-6)
(OTHERS NOT SHOWN FOR CLARITY)

REFERENCE : S-CP-6

FIELD CONNECTIONS :
HOLES : 13/16" U.N.O
PAINT :

morrow steel Fabricators, Inc.

3620 COPELAND DRIVE
ZEPHYRHILLS, FL. 33542

	PRINTS FOR	DATE	MK	REVISIONS	DATE
			0	RELEASED FOR APPROVAL	Nov 18 2025
			1	RELEASED FOR RE-APPROVAL	Jul 13 2026
			2	RELEASED FOR RE-APPROVAL	Aug 26 2026

STRUCTURE:- PINELLAS SUNCOAST TRANSIT AUTHORITY
LOCATION:- CLEARWATER STATION,CLEARWATER,FL.
DETAILER:- VECTORSHADES LLC
CUSTOMER:- KOKOLAKIS
ARCH./ENG.:- CDM SMITH
DESCRIPTION:- RG-1 TRUSS ELEVATION VIEW
DRAWN:- SHR DATE:-10-09-2025 CHK.D:- RAG DATE:-10-10-2025

SHOP BILL	WORK ORDER NO.	DRWG. NO.
	2553	E116 1

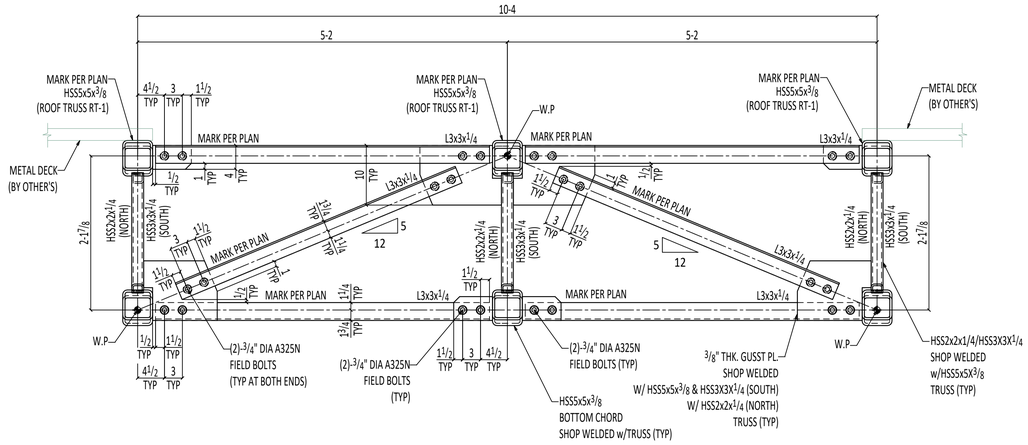

1 E117 TYPICAL NORTH & SOUTH OF EXPANSION JOINT

(REF: 9/S-CP-9)
(OTHERS NOT SHOWN FOR CLARITY)

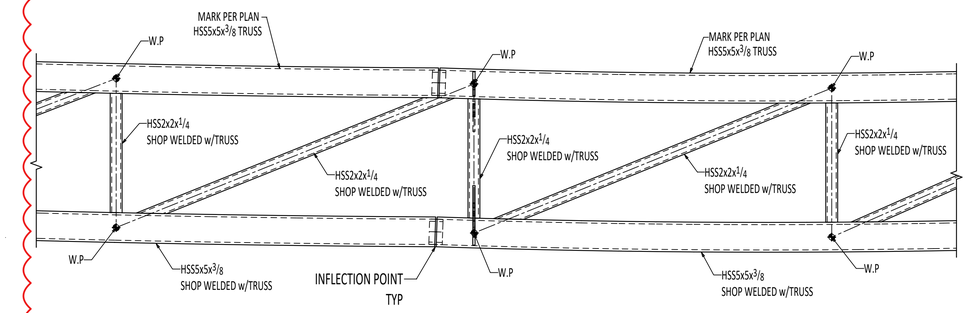

2 E117 TYPICAL NORTH OF EXPANSION JOINT

(REF: C/S-CP-8)
(OTHERS NOT SHOWN FOR CLARITY)

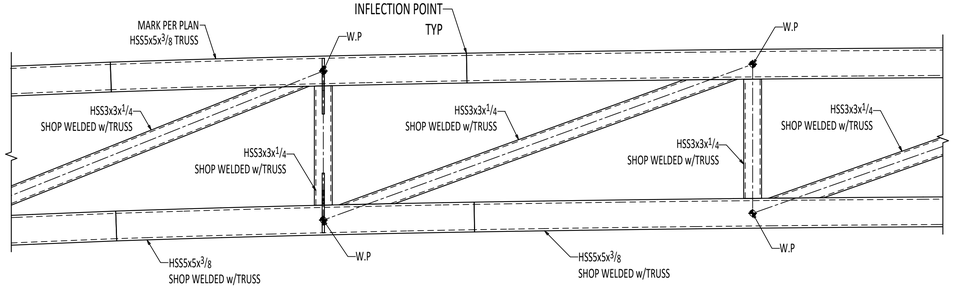

3 E117 TYPICAL SOUTH OF EXPANSION JOINT

(REF: D/S-CP-8)
(OTHERS NOT SHOWN FOR CLARITY)

REFERENCE : -

FIELD CONNECTIONS : —
HOLES : 13/16" U.N.O
PAINT : —

morrow steel Fabricators, Inc.

3620 COPELAND DRIVE
ZEPHYRHILLS, FL. 33542

	PRINTS FOR	DATE	MK	REVISIONS	DATE
			0	RELEASED FOR APPROVAL	Nov 18 2025
			1	RELEASED FOR RE-APPROVAL	Jul 13 2026
			2	RELEASED FOR RE-APPROVAL	Aug 26 2026

STRUCTURE:- PINELLAS SUNCOAST TRANSIT AUTHORITY
LOCATION:- CLEARWATER STATION,CLEARWATER,FL.
DETAILER:- VECTORSHADES LLC
CUSTOMER:- KOKOLAKIS
ARCH./ENG.:- CDM SMITH
DESCRIPTION:- TYPICAL SECTIONS
DRAWN:- SHR DATE:-10-09-2025 CHK.D:- RAG DATE:-10-10-2025

SHOP BILL	WORK ORDER NO.	DRWG. NO.
	2553	E117 ⚠

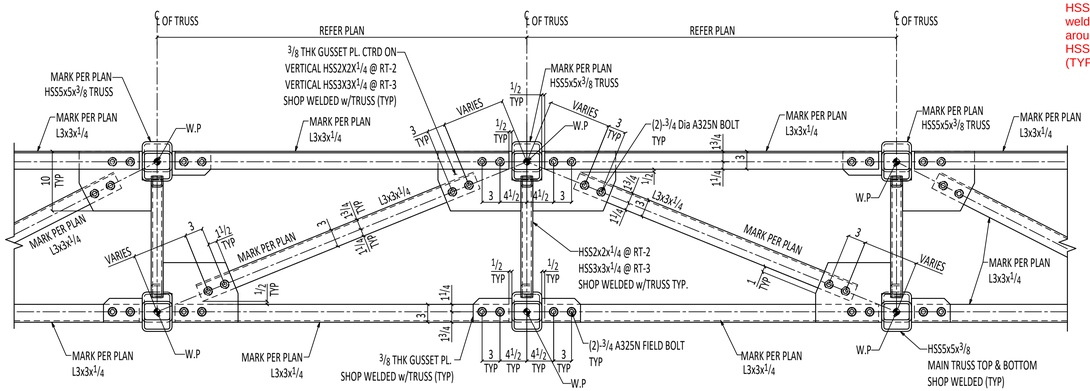

1 E118 TYPICAL RT-2 & RT-3 TRUSS CONNECTION ARRANGEMENT

(REF: A/S-CP-8)
(OTHERS NOT SHOWN FOR CLARITY)

NOTE:
METAL DECK NOT SHOWN FOR CLARITY.

HSS3X3X3/8 TO HSS5X5X3/8 Connection weld information is missing. Provide 5/16" all around fillet weld to connect HSS3x3x3/8 to HSS5x5x3/8 as shown in detail B/S-CP-8 (TYP at all the wave canopy grid locations)

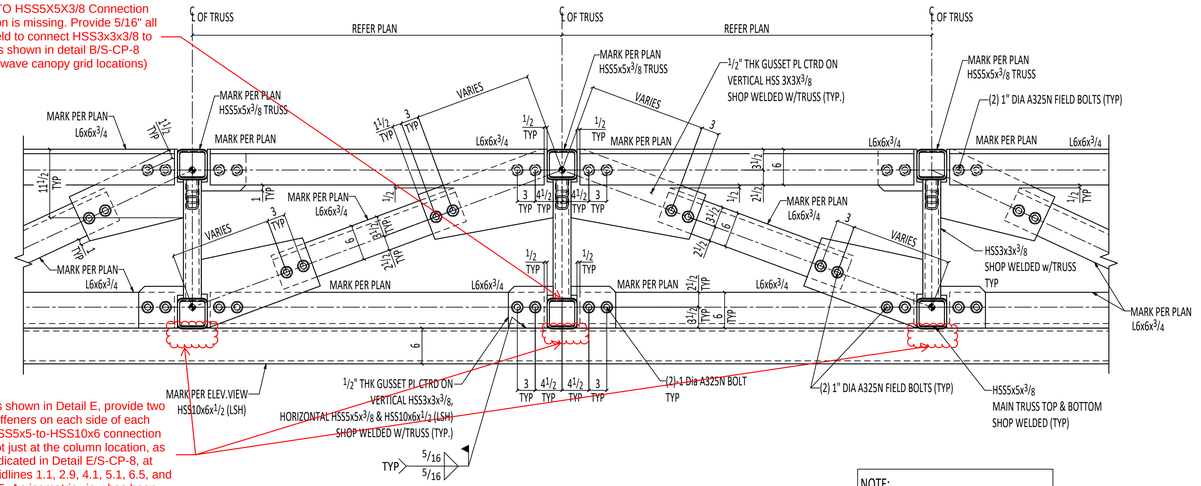

2 E118 TYPICAL RG-1 TRUSS CONNECTION ARRANGEMENT

(REF: B/S-CP-8)
(OTHERS NOT SHOWN FOR CLARITY)

NOTE:
METAL DECK NOT SHOWN FOR CLARITY.

As shown in Detail E, provide two stiffeners on each side of each HSS5x5-to-HSS10x6 connection not just at the column location, as indicated in Detail E/S-CP-8, at gridlines 1.1, 2.9, 4.1, 5.1, 6.5, and 7.5. An isometric view has been provided for clarity

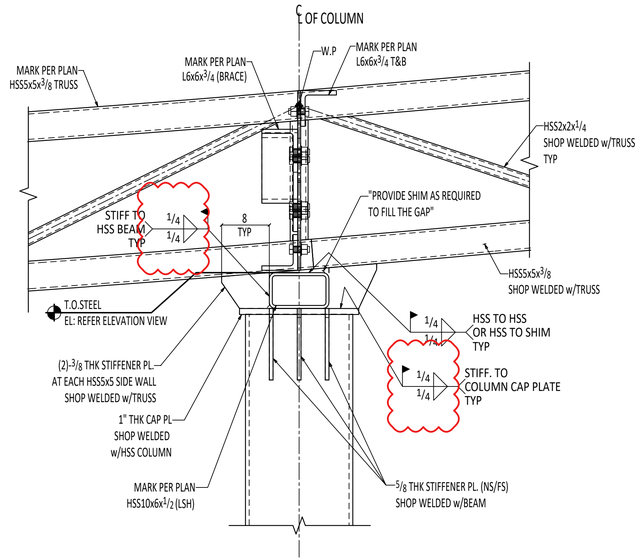

3 E118 SECTION VIEW

(REF: E/S-CP-8)
(OTHERS NOT SHOWN FOR CLARITY)

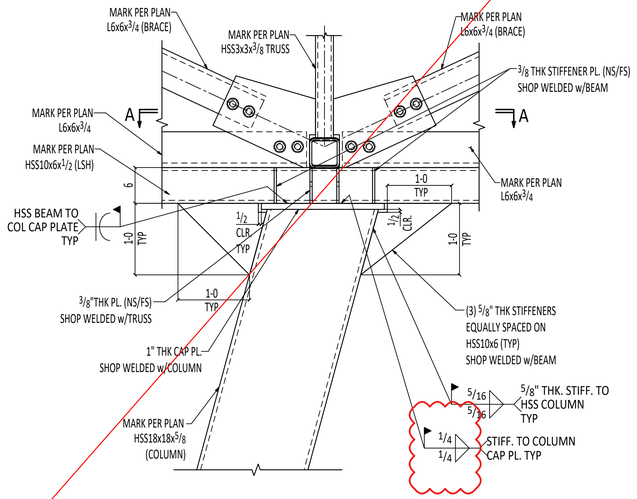

4 E118 SECTION VIEW

(REF: F/S-CP-8)
(OTHERS NOT SHOWN FOR CLARITY)

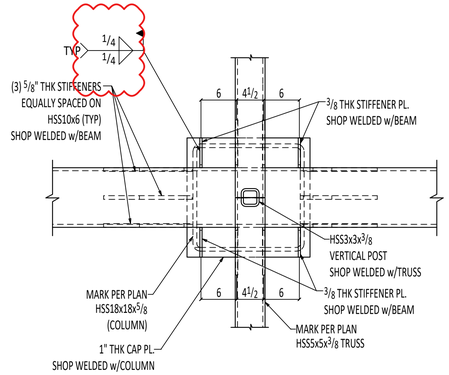

SECTION A-A

(REF: F/S-CP-8)

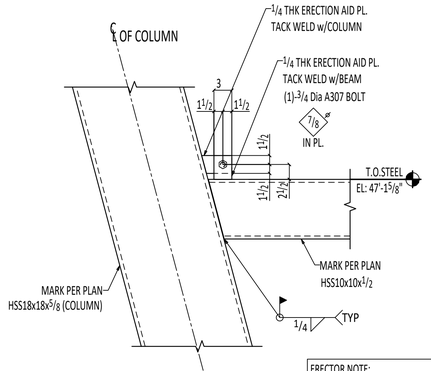

ERECTOR NOTE:
PLEASE REMOVE ERECTION AID AFTER FIELD WELD IS DONE, IF REQUIRED.

5 E118 SECTION VIEW

(REF: 2/S-CP-4)
(OTHERS NOT SHOWN FOR CLARITY)

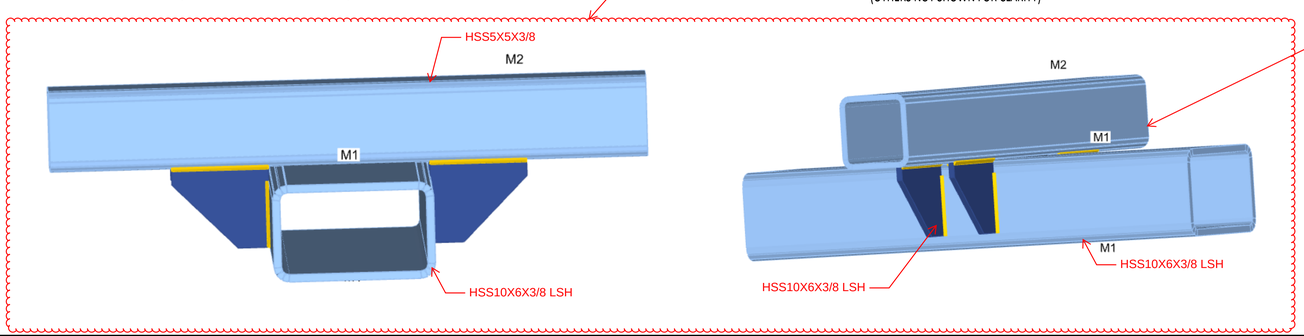

REFERENCE : -

FIELD CONNECTIONS : —
HOLES : 13/16" U.N.O
PAINT : —

morrow steel Fabricators, Inc.

3620 COPELAND DRIVE
ZEPHYRHILLS, FL. 33542

AISC CERTIFIED FABRICATOR AND ERECTOR

	PRINTS FOR	DATE	MK	REVISIONS	DATE
			0	RELEASED FOR APPROVAL	Nov 18 2025
			1	RELEASED FOR RE-APPROVAL	Jul 13 2026
			2	RELEASED FOR RE-APPROVAL	Aug 26 2026

STRUCTURE:-	PINELLAS SUNCOAST TRANSIT AUTHORITY
LOCATION:-	CLEARWATER STATION,CLEARWATER,FL.
DETAILER:-	VECTORSHADES LLC
CUSTOMER:-	KOKOLAKIS
ARCH./ENG.:-	CDM SMITH
DESCRIPTION:-	SECTION VIEWS
DRAWN:- SHR	DATE:-10-09-2025 CHK.D:- RAG DATE:-10-10-2025

SHOP BILL	WORK ORDER NO.	DRWG. NO.
	2553	E118 2

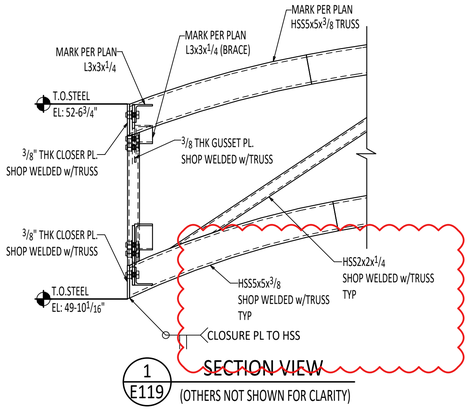

1 E119 SECTION VIEW
(OTHERS NOT SHOWN FOR CLARITY)

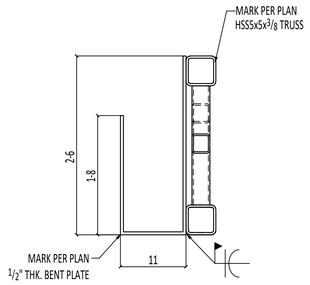

2 E119 SECTION VIEW
(REF: G/S-CP-8)
(OTHERS NOT SHOWN FOR CLARITY)

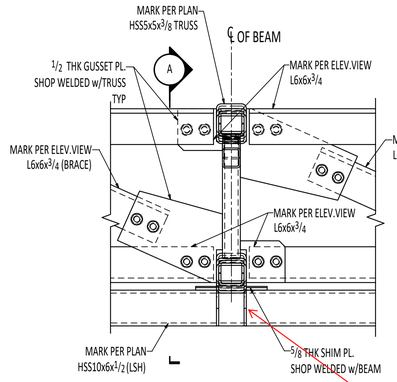

3 E119 SECTION VIEW
(OTHERS NOT SHOWN
FOR CLARITY)

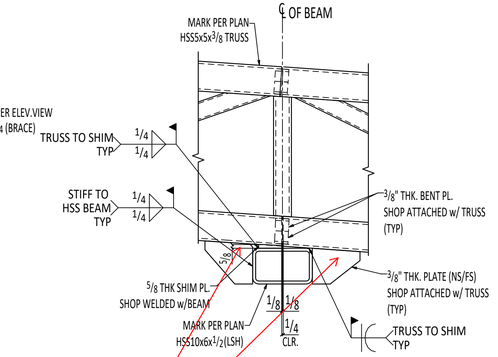

SECTION A-A

These stiffeners should be added at all HSS5x5 to HSS10x6 connections. See previous page for additional info

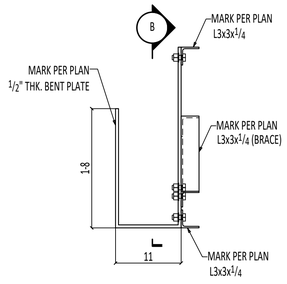

4 E119 SECTION VIEW
(REF: G/S-CP-8)(SIM)
(OTHERS NOT SHOWN FOR CLARITY)

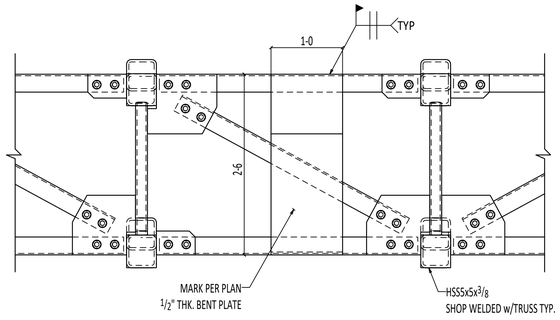

SECTION B-B

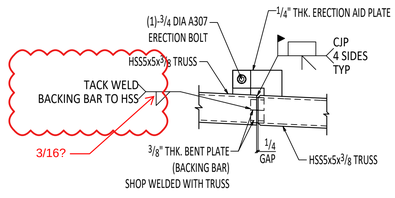

5 E119 TYPICAL SPLICE LOCATION FIELD WELD CONNECTION
(REF: H/S-CP-8)
(OTHERS NOT SHOWN FOR CLARITY)

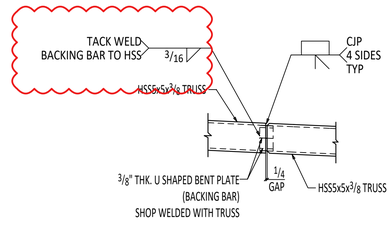

6 E119 TYPICAL TRUSS HSS TO HSS SHOP WELD DETAILS
(OTHERS NOT SHOWN FOR CLARITY)

REFERENCE : S-CP-1

FIELD CONNECTIONS :
HOLES : 13/16" U.N.O
PAINT :

morrow steel Fabricators, Inc.

3620 COPELAND DRIVE
ZEPHYRHILLS, FL. 33542

	PRINTS FOR	DATE	MK	REVISIONS	DATE
			0	RELEASED FOR APPROVAL	Nov 18 2025
			1	RELEASED FOR RE-APPROVAL	Jul 13 2026
			2	RELEASED FOR RE-APPROVAL	Aug 26 2026

STRUCTURE:- PINELLAS SUNCOAST TRANSIT AUTHORITY
LOCATION:- CLEARWATER STATION,CLEARWATER,FL.
DETAILER:- VECTORSHADES LLC
CUSTOMER:- KOKOLAKIS
ARCH./ENG.:- CDM SMITH
DESCRIPTION:- SECTION VIEWS
DRAWN:- SHR DATE:-10-09-2025 CHK.D:-RAG DATE:-10-10-2025

SHOP BILL	WORK ORDER NO.	DRWG. NO.
	2553	E119 1

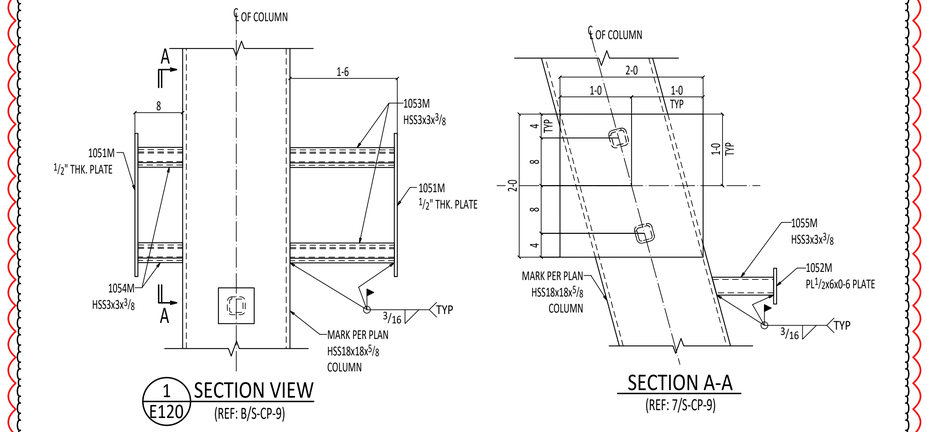

1 E120 SECTION VIEW
(REF: B/S-CP-9)

SECTION A-A
(REF: 7/S-CP-9)

COORDINATION NOTE :

FINAL DRAWING SHALL BE COORDINATED BY THE CONTRACTOR WITH
THE SELECTED SIGNAGE MANUFACTURER PRIOR TO FABRICATION AND CONSTRUCTION.

REFERENCE : S-CP-9

FIELD CONNECTIONS :
HOLES : 13/16" U.N.O
PAINT :

morrow steel Fabricators, Inc.

3620 COPELAND DRIVE
ZEPHYRHILLS, FL. 33542

	PRINTS FOR	DATE	MK	REVISIONS	DATE
			0	RELEASED FOR APPROVAL	Nov 18 2025
			1	RELEASED FOR RE-APPROVAL	Jul 13 2026
			2	RELEASED FOR RE-APPROVAL	Aug 26 2026

STRUCTURE:- PINELLAS SUNCOAST TRANSIT AUTHORITY
LOCATION:- CLEARWATER STATION,CLEARWATER,FL.
DETAILER:- VECTORSHADES LLC
CUSTOMER:- KOKOLAKIS
ARCH./ENG:- CDM SMITH
DESCRIPTION:- PARTIAL ANCHOR BOLT SETTING PLAN
DRAWN:- SHR DATE:-10-09-2025 CHK.D:- RAG DATE:-10-10-2025

SHOP BILL	WORK ORDER NO.	DRWG. NO.
	2553	E120 ⚠1

Access hatch clear dimensions shall be coordinated with the approved hatch submittal and location on architectural drawings

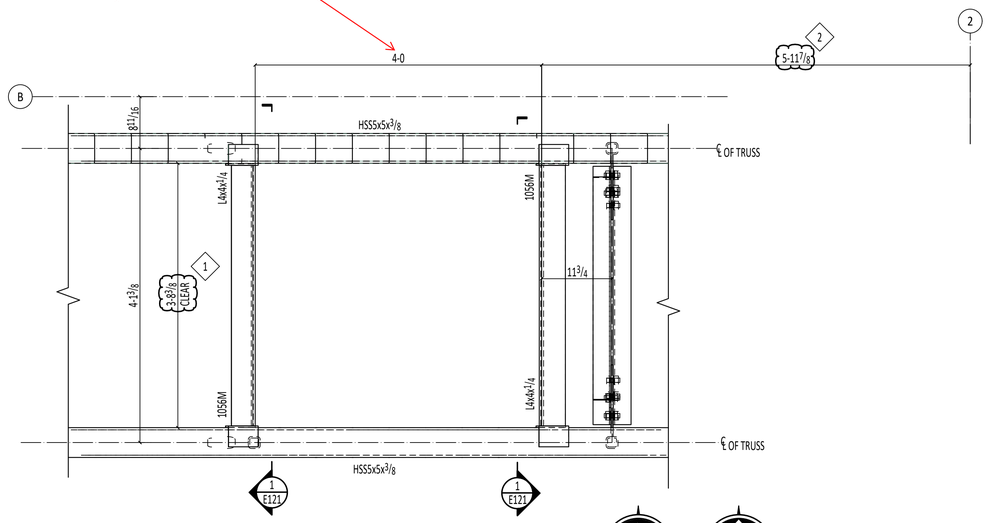

ROOF OPENING PLAN AT WAVE CANOPY

(REF: A/S-CP-3)

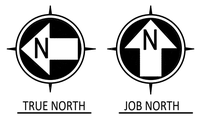

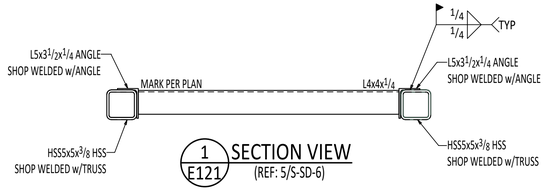

1 / E121 SECTION VIEW

(REF: 5/S-SD-6)

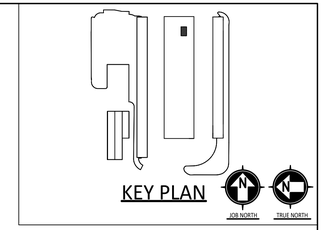

Access hatch clear dimensions shall be coordinated with the approved hatch submittal and location on architectural drawings

APPROVER PLEASE REVIEW AND CONFIRM THE FOLLOWING ITEMS:

1 -WHEN FOLLOWING THE TRUSS SPACING PER CD, WE GOT THE CLEAR DIMENSION AS SHOWN SINCE ARCH DRAWING SHOWS 4'-0" OPENING.PLEASE CONFIRM WITH ROOF HATCH MANUFACTURER.

2 - PLEASE REVIEW AND CONFIRM THE CLOUDED OPENING LOCATING DIMENSION WITH ROOF HATCH MANUFACTURER.

Responses have been provided to all clouds. If a response has not been provided, please ensure Engineer is aware to respond to.

APPROVER NOTE:
ALL CLOUDED INFORMATION NOT VERIFIED/CONFIRMED ON RETURNED APPROVAL SUBMITTAL WILL BE CONSIDERED APPROVED AS DETAILED.

REFERENCE : S-CP-3

FIELD CONNECTIONS :
HOLES : 13/16" U.N.O
PAINT :

morrow steel Fabricators, Inc.

3620 COPELAND DRIVE
ZEPHYRHILLS, FL. 33542

AISC CERTIFIED FABRICATOR AND ERECTOR

	PRINTS FOR	DATE	MK	REVISIONS	DATE
			0	RELEASED FOR APPROVAL	Nov 18 2025
			1	RELEASED FOR RE-APPROVAL	Jul 13 2026
			2	RELEASED FOR RE-APPROVAL	Aug 26 2026

STRUCTURE:- PINELLAS SUNCOAST TRANSIT AUTHORITY
LOCATION:- CLEARWATER STATION,CLEARWATER,FL.
DETAILER:- VECTORSHADES LLC
CUSTOMER:- KOKOLAKIS
ARCH./ENG.:- CDM SMITH
DESCRIPTION:- WAVE CANOP ROOF OPENING PLAN
DRAWN:- NMN DATE:-11-07-2025 CHK.D:- RAG DATE:-11-14-2025

SHOP BILL	WORK ORDER NO.	DRWG. NO.
	2553	E121

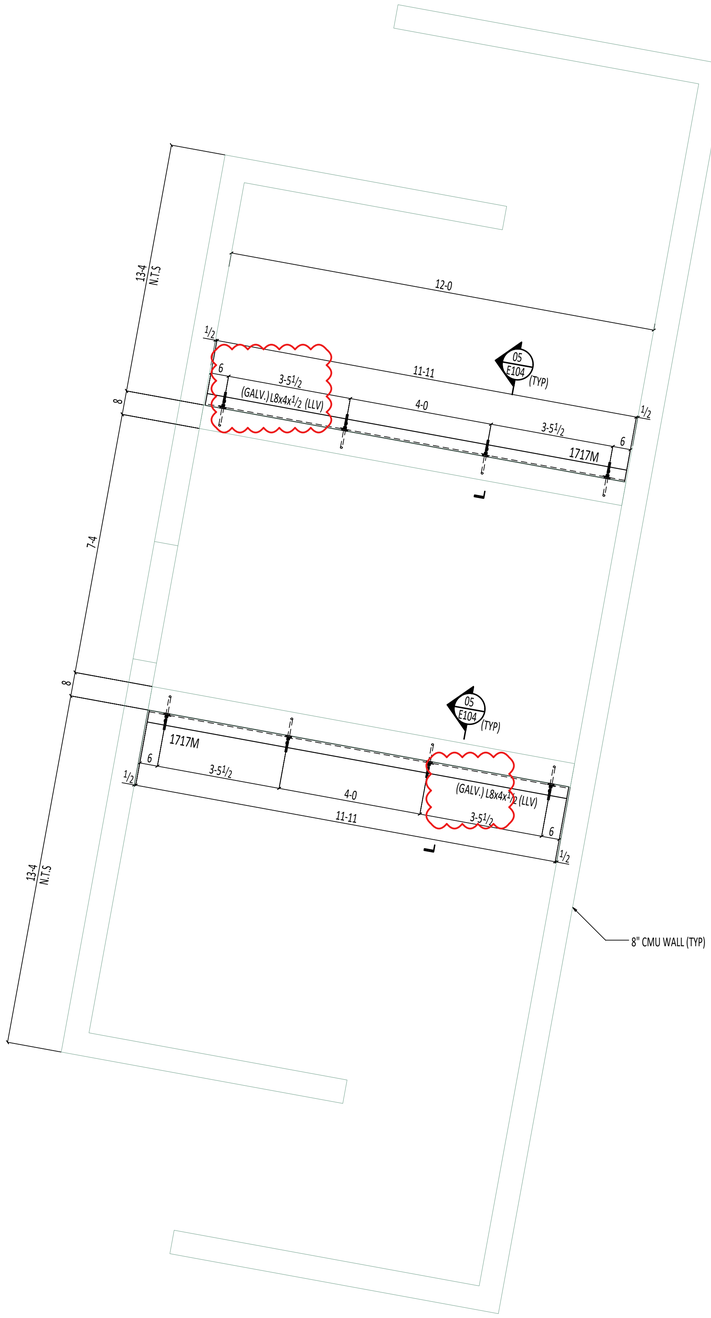

INTERIOR NON-BEARING CMU WALL SUPPORT PLAN
AT RESTROOM BUILDING
(REF: S-RB-1)

JOB NORTH

NOTE:
- FOR SECTIONS AND DETAILS REFER SHEET E104

KEY PLAN

JOB NORTH TRUE NORTH

REFERENCE : S-RB-1

FIELD CONNECTIONS :
HOLES : 13/16" U.N.O
PAINT :

morrow steel Fabricators, Inc.

3620 COPELAND DRIVE
ZEPHYRHILLS, FL. 33542

	PRINTS FOR	DATE	MK	REVISIONS	DATE
			0	RELEASED FOR APPROVAL	Jul 13 2026
			1	RELEASED FOR RE-APPROVAL	Aug 26 2026

STRUCTURE:-	PINELLAS SUNCOAST TRANSIT AUTHORITY
LOCATION:-	CLEARWATER STATION,CLEARWATER,FL.
DETAILER:-	VECTORSHADES LLC
CUSTOMER:-	KOKOLAKIS
ARCH./ENG.:-	CDM SMITH
DESCRIPTION:-	INTERIOR NON-BEARING CMU WALL SUPPORT PLAN AT RESTROOM BUILDING
DRAWN:- NMN	DATE:-11-07-2025 CHK.D:- RAG DATE:-11-14-2025

SHOP BILL	WORK ORDER NO.	DRWG. NO.
	2553	E131 1

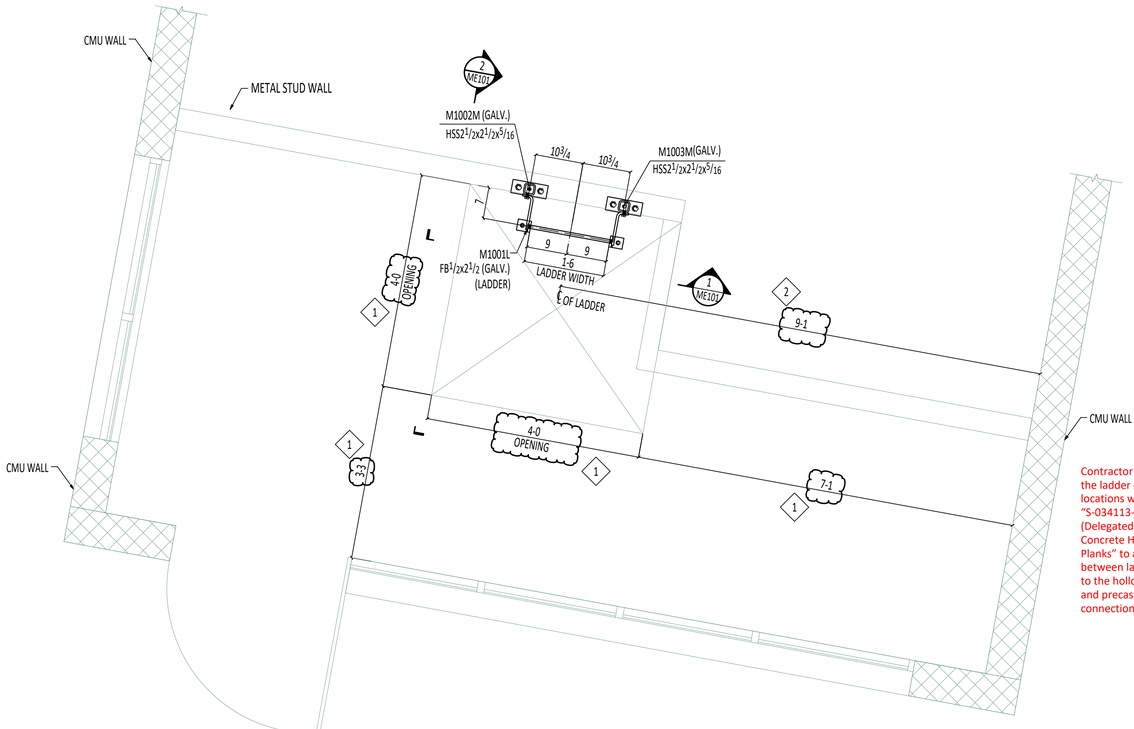

Contractor shall coordinate the ladder connection locations with submittal "S-034113-001-A – (Delegated Design) Precast Concrete Hollow Core Planks" to avoid conflicts between ladder connections to the hollow core planks and precast panel embed connections at openings.

ROOF HATCH LADDER PLAN AT WAITING PAVILION BUILDING

(REF: 1/A-PB-01 & A-PB-02)

NOTE:
- FOR SECTIONS AND DETAILS REFER SHEET ME101 & ME102.

JOB NORTH

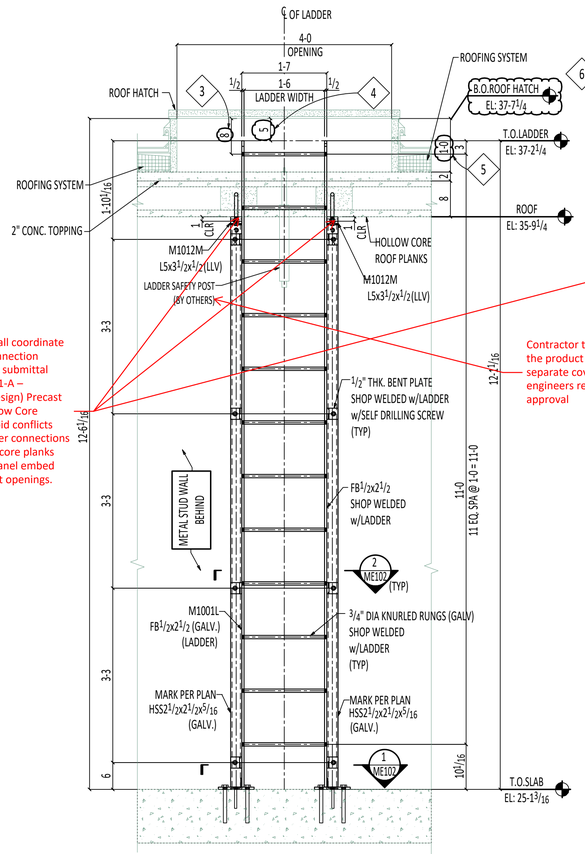

1 ME101 SECTION VIEW
(REF: C/S-SD-6)
(OTHERS NOT SHOWN FOR CLARITY)

Contractor to submit the product data under separate cover for engineers review and approval

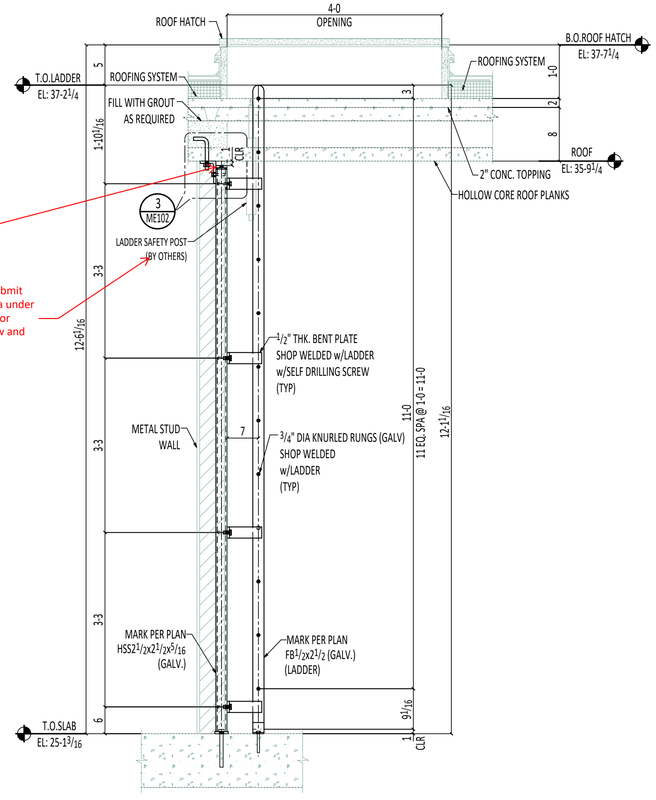

2 ME101 SECTION VIEW
(REF: C/S-SD-6)
(OTHERS NOT SHOWN FOR CLARITY)

APPROVER PLEASE REVIEW AND CONFIRM THE FOLLOWING ITEMS:

1. - PLEASE VERIFY AND CONFIRM THE OPENING DIMENSION & ITS LOCATION FROM WALL WITH ROOF HATCH MANUFACTURER. SINCE, WE HAVE CONFLICT IN ARCH DRAWINGS.
2. - PLEASE VERIFY AND CONFIRM THE CENTER OF LADDER LOCATING DIMENSION FROM WALL WITH ROOF HATCH MANUFACTURER.
3. - PLEASE VERIFY AND CONFIRM THE DIMENSION FROM BOTTOM OF ROOF HATCH TO CENTER OF TOP RUNG WITH HATCH MANUFACTURER.
4. - PLEASE VERIFY AND CONFIRM THE CLEAR DIMENSION BETWEEN BOTTOM OF ROOF HATCH TO TOP OF SIDE RAIL WITH HATCH MANUFACTURER.
5. - PLEASE VERIFY AND CONFIRM THE DIMENSION FROM BOTTOM OF ROOF HATCH TO TOP OF TOPPING WITH HATCH MANUFACTURER.
6. - PLEASE VERIFY AND CONFIRM THE BOTTOM OF ROOF HATCH ELEVATION WITH HATCH MANUFACTURER.

Contractor to coordinate with approved hatch submittal (not yet received)

Contractor to coordinate with conformed Arch drawings

Keep the last rung as close as possible to the bottom of hatch. Contractor to coordinate with the selected access hatch manufacturer

Contractor to coordinate

Responses have been provided to all clouds. If a response has not been provided, please ensure Engineer is aware to respond to.

APPROVER NOTE:
ALL CLOUDED INFORMATION NOT VERIFIED/CONFIRMED ON RETURNED APPROVAL SUBMITTAL WILL BE CONSIDERED APPROVED AS DETAILED.

LEGEND:
LLV - LONG LEG VERTICAL

REFERENCE : A-PB-01, A-PB-02 & S-SD-6

FIELD CONNECTIONS :
HOLES : 13/16" U.N.O
PAINT :

morrow steel Fabricators, Inc.

3620 COPELAND DRIVE
ZEPHYRHILLS, FL. 33542

	PRINTS FOR	DATE	MK	REVISIONS	DATE
			0	RELEASED FOR APPROVAL	Nov 18 2025
			1	RELEASED FOR RE-APPROVAL	Jul 13 2026
			2	RELEASED FOR RE-APPROVAL	Aug 26 2026

STRUCTURE:- PINELLAS SUNCOAST TRANSIT AUTHORITY
LOCATION:- CLEARWATER STATION,CLEARWATER,FL.
DETAILER:- VECTORSHADES LLC
CUSTOMER:- KOKOLAKIS
ARCH./ENG.:- CDM SMITH
DESCRIPTION:- ROOF HATCH LADDER PLAN AT WAITING PAVILION BUILDING & SECTIONS
DRAWN:- NMN DATE:- 11-07-2025 CHK.D:- RAG DATE:- 11-14-2025

SHOP BILL	WORK ORDER NO.	DRWG. NO.
	2553	ME101

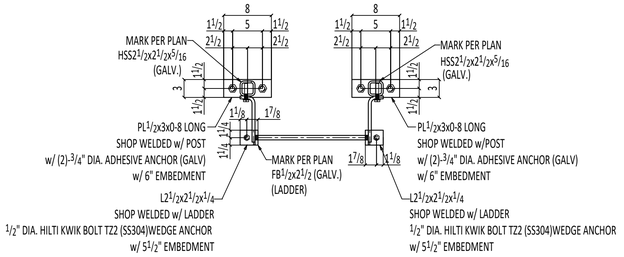

1 ME102 SECTION VIEW
(REF: C/S-SD-6)
(OTHERS NOT SHOWN FOR CLARITY)

PLEASE CONFIRM THE LINDAPTER BOLT DETAILS SHOWN.

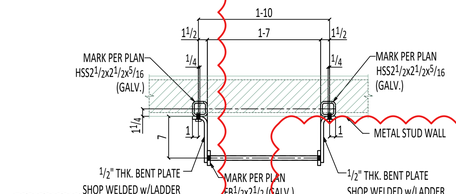

2 ME102 SECTION VIEW
(REF: C/S-SD-6)
(OTHERS NOT SHOWN FOR CLARITY)

PLEASE CONFIRM THE LINDAPTER BOLT DETAILS SHOWN.

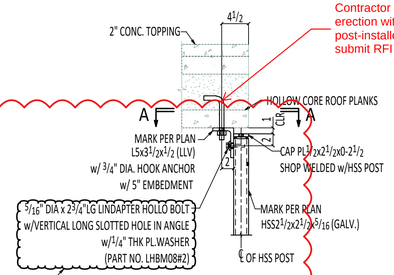

3 ME102 DETAIL VIEW
(REF: C/S-SD-6)
(OTHERS NOT SHOWN FOR CLARITY)

Contractor to verify question in erection with hollow core mfr. If post-installed anchor is required, submit RFI with details (TYP)

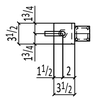

SECTION A-A

Confirm

Responses have been provided to all clouds. If a response has not been provided, please ensure Engineer is aware to respond to.

APPROVER NOTE:
ALL CLOUDED INFORMATION NOT VERIFIED/CONFIRMED ON RETURNED APPROVAL SUBMITTAL WILL BE CONSIDERED APPROVED AS DETAILED.

LEGEND:
LLV - LONG LEG VERTICAL

REFERENCE : S-SD-6

FIELD CONNECTIONS :
HOLES : 13/16" U.N.O
PAINT :

morrow steel Fabricators, Inc.

3620 COPELAND DRIVE
ZEPHYRHILLS, FL. 33542

	PRINTS FOR	DATE	MK	REVISIONS	DATE
			0	RELEASED FOR APPROVAL	Nov 18 2025
			1	RELEASED FOR RE-APPROVAL	Jul 13 2026
			2	RELEASED FOR RE-APPROVAL	Aug 26 2026

STRUCTURE:- PINELLAS SUNCOAST TRANSIT AUTHORITY
LOCATION:- CLEARWATER STATION,CLEARWATER,FL.
DETAILER:- VECTORSHADES LLC
CUSTOMER:- KOKOLAKIS
ARCH./ENG.:- CDM SMITH
DESCRIPTION:- SECTION VIEWS
DRAWN:- NMM DATE:- 11-07-2025 CHK.D:- RAG DATE:- 11-14-2025

SHOP BILL	WORK ORDER NO.	DRWG. NO.
	2553	ME102 ⚠

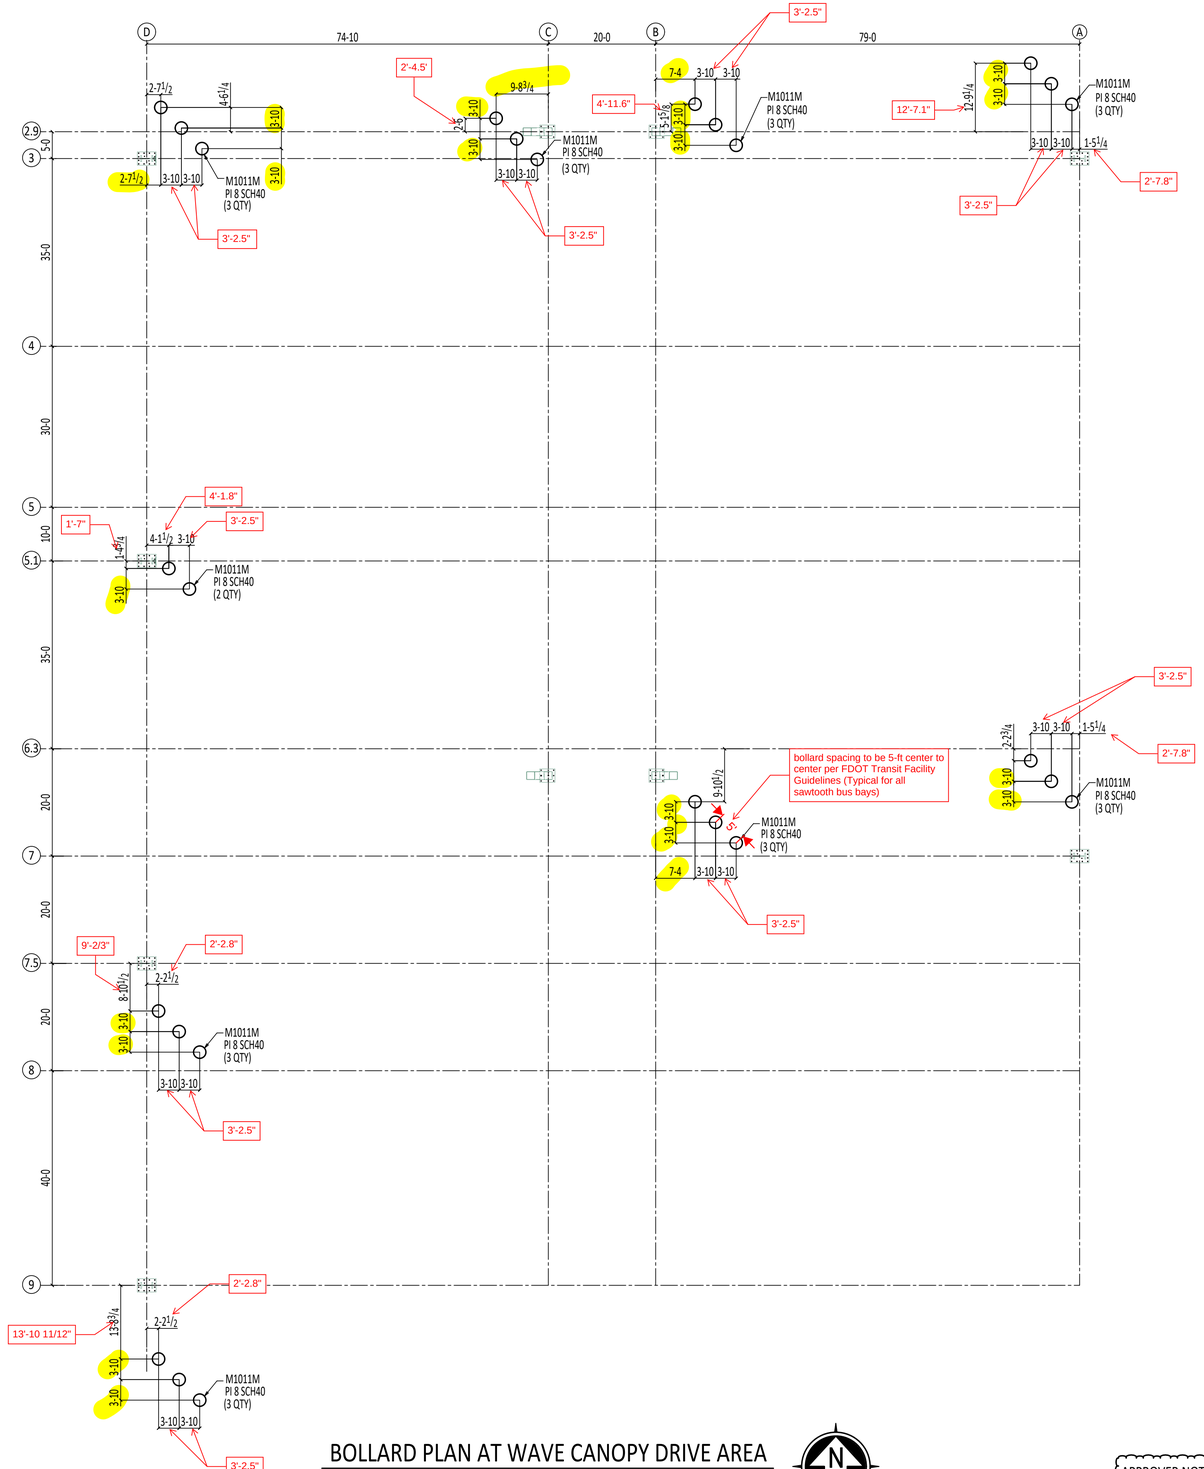

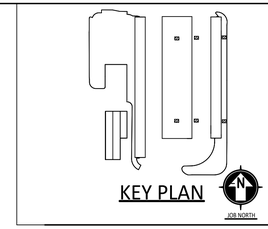

BOLLARD PLAN AT WAVE CANOPY DRIVE AREA

(REF: C-3)

NOTE:
- FOR TYPICAL DETAIL REFER SHEET ME112.

JOB NORTH

APPROVER NOTE:
ALL CLOUDED INFORMATION NOT VERIFIED/CONFIRMED ON RETURNED APPROVAL SUBMITTAL WILL BE CONSIDERED APPROVED AS DETAILED.

PLEASE VERIFY ALL BOLLARD LOCATING DIMENSIONS WITH GC.

REFERENCE : A-DE-01, A-DE-03 & C-15

FIELD CONNECTIONS : _____
HOLES : 13/16" U.N.O
PAINT : _____

morrow steel Fabricators, Inc.

AISC CERTIFIED FABRICATOR AND ERECTOR

3620 COPELAND DRIVE
ZEPHYRHILLS, FL. 33542

	PRINTS FOR	DATE	MK	REVISIONS	DATE
			0	RELEASED FOR APPROVAL	Nov 18 2025
			1	RELEASED FOR RE-APPROVAL	Jul 13 2026
			2	RELEASED FOR RE-APPROVAL	Aug 26 2026

STRUCTURE:- PINELLAS SUNCOAST TRANSIT AUTHORITY
LOCATION:- CLEARWATER STATION,CLEARWATER,FL.
DETAILER:- VECTORSHADES LLC
CUSTOMER:- KOKOLAKIS
ARCH./ENG.:- CDM SMITH
DESCRIPTION:- BOLLARD PLAN AT WAVE CANOPY DRIVE AREA
DRAWN:- NMN DATE:- 11-07-2025 CHK.D:- RAG DATE:- 11-14-2025

SHOP BILL	WORK ORDER NO.	DRWG. NO.
	2553	ME111 ⚠1

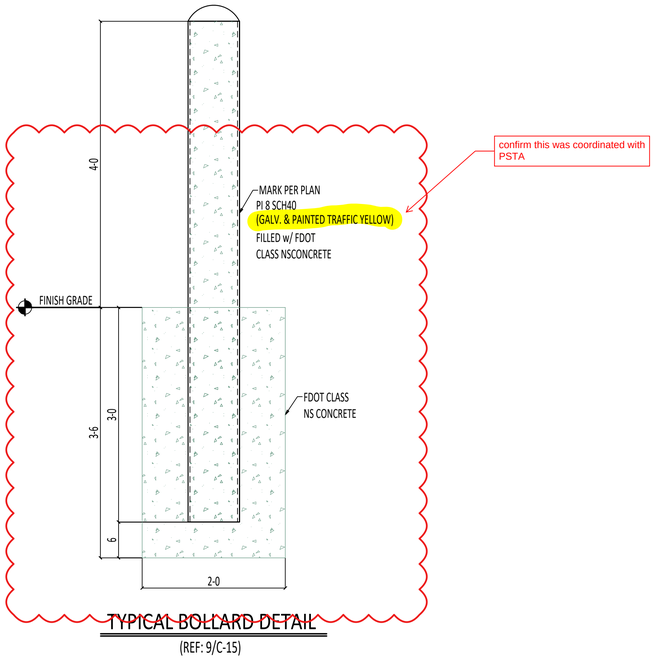

confirm this was coordinated with PSTA

TYPICAL BOLLARD DETAIL

(REF: 9/C-15)

REFERENCE : A-DE-01, A-DE-03 & C-15

FIELD CONNECTIONS :

HOLES : $^{13}/_{16}$" U.N.O

PAINT :

morrow steel Fabricators, Inc.

3620 COPELAND DRIVE
ZEPHYRHILLS, FL. 33542

AISC CERTIFIED FABRICATOR AND ERECTOR

	PRINTS FOR	DATE	MK	REVISIONS	DATE
			0	RELEASED FOR APPROVAL	Nov 18 2025
			1	RELEASED FOR RE-APPROVAL	Jul 13 2026
			2	RELEASED FOR RE-APPROVAL	Aug 26 2026

STRUCTURE:- PINELLAS SUNCOAST TRANSIT AUTHORITY
LOCATION:- CLEARWATER STATION,CLEARWATER,FL.
DETAILER:- VECTORSHADES LLC
CUSTOMER:- KOKOLAKIS
ARCH./ENG.:- CDM SMITH
DESCRIPTION:- TYPICAL BOLLARD DETAIL
DRAWN:- NMN DATE:- 11-07-2025 CHK.D:- RAG DATE:- 11-14-2025

SHOP BILL	WORK ORDER NO.	DRWG. NO.
	2553	ME112 ⚠

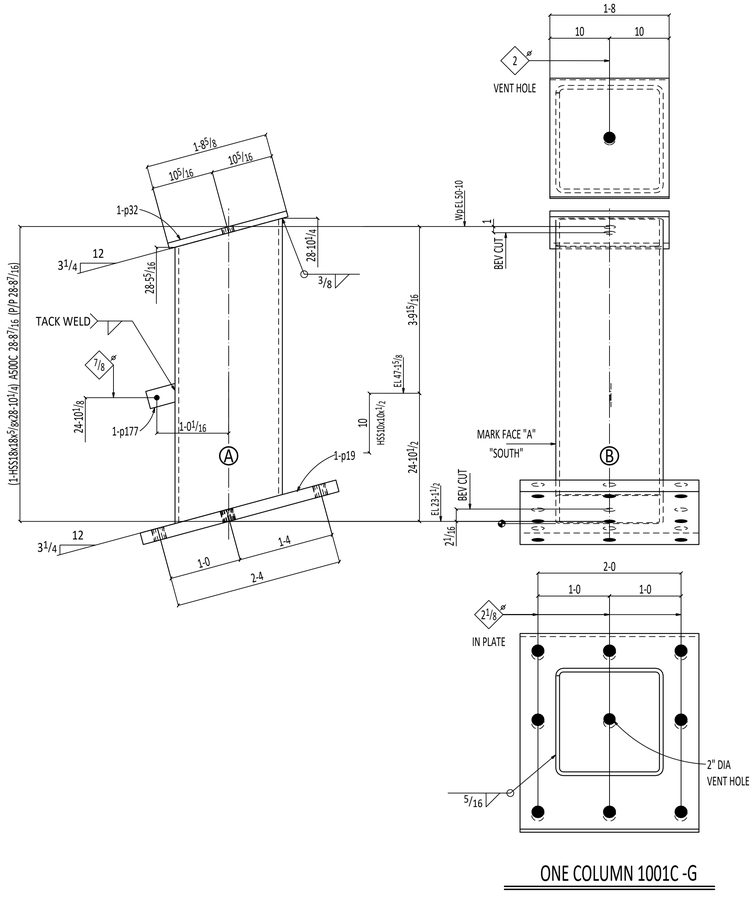

ONE COLUMN 1001C -G

AT GRID:
1.1 & B

SHIPPING LIST

MATERIAL BILL

ITEM NO	TOTAL QTY	DESCRIPTION	MAJOR MARK	PAINT CODE	TOTAL WEIGHT	ABM NO	UNIT QTY	LENGTH FT.	LENGTH IN.	MINOR MARK	REMARKS	UNIT WEIGHT	GRADE
	ONE	COLUMN	1001C	G	4862						Galv	4862	
	1	HSS18x18x5/8			4166		1	28	10 1/4	1001C	B2E	4166	A500C
	1	PL2x30			578		1	2	10	p19		578	A572-50
	1	PL1x20			117		1	1	8 5/8	p32		117	A572-50
	1	PL 1/4x3			1		1	0	5 1/16	p177		1	A572-50

Total weight : 4862

REFERENCE :----

PAGE TOTALS | REVISION NO.

SPECIAL NOTES:-

1. SEAL ALL WELDS FOR GALVANIZE.
2. ALL VENT HOLES TO BE PLUGGED AFTER GALVANIZING.

MATERIAL:-

ASTM:	A36 U.N.O.
S.S.:	-----
ALUM.:	-----
PIPE:	A53 GR.B
TUBES:	A500 GR.B
HOLES:	13/16 U.N.O
WELDING:	E70XX

MATERIAL PREP.:-

CLEAN: SSPC-SP2
SHOP PAINT: TWO COAT OF STD SHOP PRIMER
GALV: GALVANIZED & PAINTED

GEN. NOTES:-

BUY AMERICAN:
DOMESTIC:
CERT/CONFORMANCE:
CERT/COMPLIANCE:

ALL WIDE FLANGE SHAPES TO BE PER A992-G50

FIELD CONNECTIONS :
HOLES : 13/16" U.N.O
PAINT :

morrow steel Fabricators, Inc.

3620 COPELAND DRIVE
ZEPHYRHILLS, FL. 33542

	PRINTS FOR	DATE	MK	REVISIONS	DATE
			0	RELEASED FOR APPROVAL	Nov 18 2025
			1	RELEASED FOR RE-APPROVAL	Jul 13 2026
			2	RELEASED FOR RE-APPROVAL	Aug 26 2026

STRUCTURE:- PINELLAS SUNCOAST TRANSIT AUTHORITY
LOCATION:- CLEARWATER STATION,CLEARWATER,FL.
DETAILER:- VECTORSHADES LLC
CUSTOMER:- KOKOLAKIS
ARCH./ENG.:- CDM SMITH
DESCRIPTION:- WAVE CANOPY COLUMN DETAIL
DRAWN:- PBI DATE:- 10-27-2025 CHK.D:- RAG DATE:- 10-27-2025

SHOP BILL	WORK ORDER NO.	DRWG. NO.
	2553	1001 1

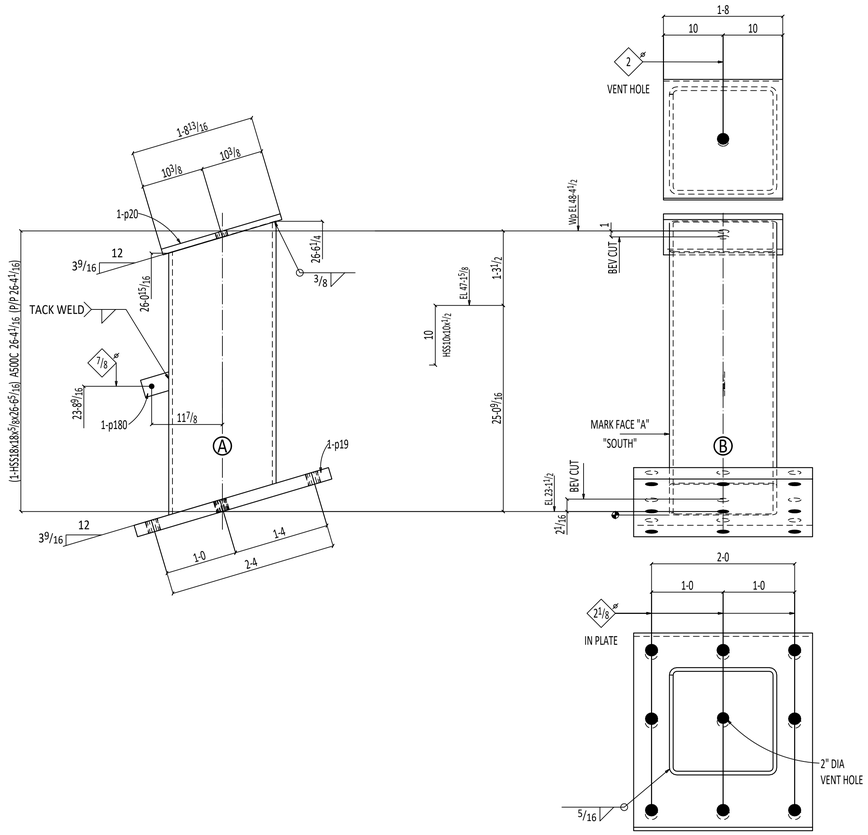

ONE COLUMN 1002C -G

AT GRID:
2.9 & B

SHIPPING LIST

ITEM NO	TOTAL QTY	DESCRIPTION	MAJOR MARK	PAINT CODE	TOTAL WEIGHT
	ONE	COLUMN	1002C	G	4528
	1	HSS18x18x5/8			3830
	1	PL2x30			578
	1	PL1x20			118
	1	PL1/4x3			1

MATERIAL BILL

ABM NO	UNIT QTY	LENGTH FT.	LENGTH IN.	MINOR MARK	REMARKS	UNIT WEIGHT	GRADE
					Galv	4528	
	1	26	6 5/16	1002C	B2E	3830	A500C
	1	2	10	p19		578	A572-50
	1	1	8 13/16	p20		118	A572-50
	1	0	4 15/16	p180		1	A572-50

Total weight : 4528

REFERENCE :----

PAGE TOTALS

REVISION NO.

SPECIAL NOTES:-

1. SEAL ALL WELDS FOR GALVANIZE.
2. ALL VENT HOLES TO BE PLUGGED AFTER GALVANIZING.

MATERIAL:-

ASTM: A36 U.N.O.
S. S.: -----
ALUM.: -----
PIPE: A53 GR.B
TUBES: A500 GR.B
HOLES: 13/16 U.N.O
WELDING: E70XX

MATERIAL PREP.:-

CLEAN: SSPC-SP2
SHOP PAINT: TWO COAT OF STD SHOP PRIMER
GALV: GALVANIZED & PAINTED

GEN. NOTES:-

BUY AMERICAN:
DOMESTIC:
CERT/CONFORMANCE:
CERT/COMPLIANCE:

ALL WIDE FLANGE SHAPES TO BE PER A992-G50

FIELD CONNECTIONS :
HOLES : 13/16" U.N.O
PAINT :

morrow steel Fabricators, Inc.

3620 COPELAND DRIVE
ZEPHYRHILLS, FL. 33542

	PRINTS FOR	DATE	MK	REVISIONS	DATE
			0	RELEASED FOR APPROVAL	Nov 18 2025
			1	RELEASED FOR RE-APPROVAL	Jul 13 2026
			2	RELEASED FOR RE-APPROVAL	Aug 26 2026

STRUCTURE:-PINELLAS SUNCOAST TRANSIT AUTHORITY
LOCATION:- CLEARWATER STATION,CLEARWATER,FL.
DETAILER:- VECTORSHADES LLC
CUSTOMER:- KOKOLAKIS
ARCH./ENG.:- CDM SMITH
DESCRIPTION:-WAVE CANOPY COLUMN DETAIL
DRAWN:- PBI DATE:-10-27-2025 CHK.D:-RAG DATE:- 10-27-2025

SHOP BILL	WORK ORDER NO.	DRWG. NO.
	2553	1002

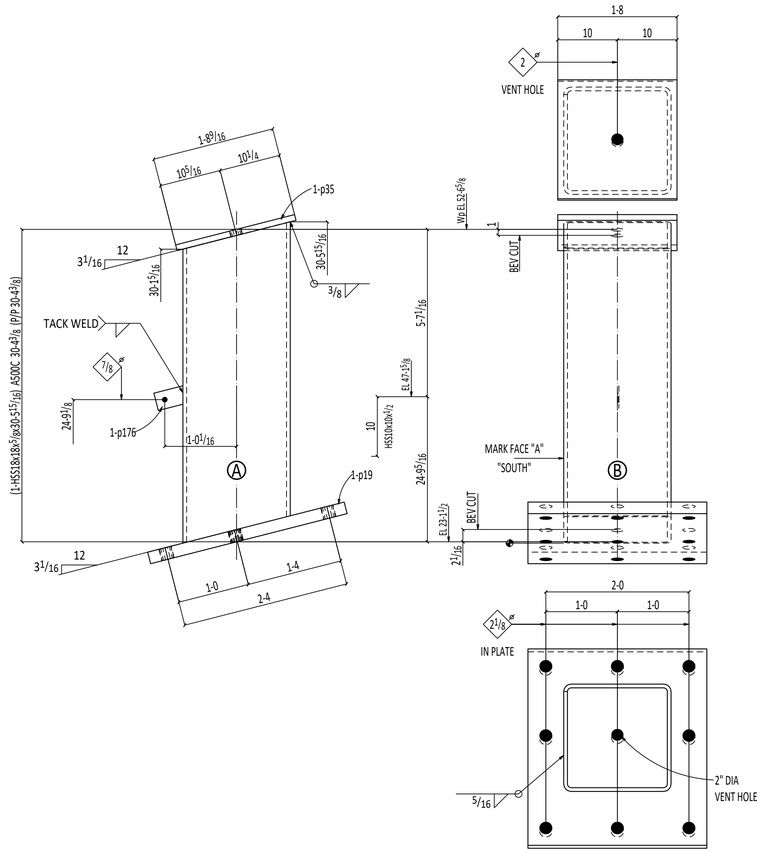

ONE COLUMN 1003C -G

AT GRID:
4.1 & B

SHIPPING LIST

ITEM NO	TOTAL QTY	DESCRIPTION	MAJOR MARK	PAINT CODE	TOTAL WEIGHT
	ONE	COLUMN	1003C	G	5099
	1	HSS18x18x5/8			4403
	1	PL2x30			578
	1	PL1x20			117
	1	PL1/4x3			1

Total weight : 5099

MATERIAL BILL

ABM NO	UNIT QTY	LENGTH FT.	LENGTH IN.	MINOR MARK	REMARKS	UNIT WEIGHT	GRADE
	1	30	5 15/16	1003C	B2E	4403	A500C
	1	2	10	p19		578	A572-50
	1	1	8 9/16	p35		117	A572-50
	1	0	5	p176		1	A572-50

REFERENCE :----

PAGE TOTALS

REVISION NO.

SPECIAL NOTES:-

1. SEAL ALL WELDS FOR GALVANIZE.
2. ALL VENT HOLES TO BE PLUGGED AFTER GALVANIZING.

MATERIAL:-

ASTM: A36 U.N.O.
S. S.: -----
ALUM.: -----
PIPE: A53 GR.B
TUBES: A500 GR.B
HOLES: 13/16 U.N.O
WELDING: E70XX

MATERIAL PREP.:-

CLEAN: SSPC-SP2
SHOP PAINT: TWO COAT OF STD SHOP PRIMER
GALV: GALVANIZED & PAINTED

GEN. NOTES:-

BUY AMERICAN:
DOMESTIC:
CERT/CONFORMANCE:
CERT/COMPLIANCE:

ALL WIDE FLANGE SHAPES TO BE PER A992-G50

FIELD CONNECTIONS :
HOLES : 13/16" U.N.O
PAINT :

morrow steel Fabricators, Inc.

3620 COPELAND DRIVE
ZEPHYRHILLS, FL. 33542

	PRINTS FOR	DATE	MK	REVISIONS	DATE
			0	RELEASED FOR APPROVAL	Nov 18 2025
			1	RELEASED FOR RE-APPROVAL	Jul 13 2026
			2	RELEASED FOR RE-APPROVAL	Aug 26 2026

STRUCTURE:- PINELLAS SUNCOAST TRANSIT AUTHORITY
LOCATION:- CLEARWATER STATION,CLEARWATER,FL.
DETAILER:- VECTORSHADES LLC
CUSTOMER:- KOKOLAKIS
ARCH./ENG.:- CDM SMITH
DESCRIPTION:- WAVE CANOPY COLUMN DETAIL
DRAWN:- PBI DATE:- 10-27-2025 CHK.D:- RAG DATE:- 10-27-2025

SHOP BILL	WORK ORDER NO.	DRWG. NO.
	2553	1003 1

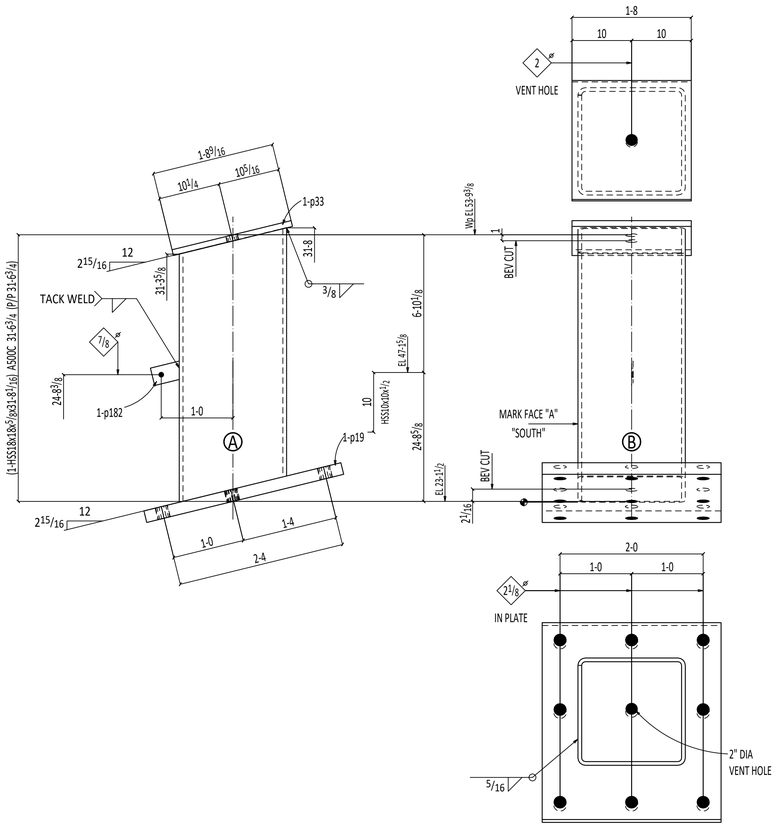

ONE COLUMN 1004C -G

AT GRID:
5.1 & B

SHIPPING LIST

MATERIAL BILL

ITEM NO	TOTAL QTY	DESCRIPTION	MAJOR MARK	PAINT CODE	TOTAL WEIGHT	ABM NO	UNIT QTY	LENGTH FT.	LENGTH IN.	MINOR MARK	REMARKS	UNIT WEIGHT	GRADE
	ONE	COLUMN	1004C	G	5269						Galv	5269	
	1	HSS18x18x5/8			4573		1	31	8 1/16	1004C	B2E	4573	A500C
	1	PL2x30			578		1	2	10	p19		578	A572-50
	1	PL1x20			117		1	1	8 9/16	p33		117	A572-50
	1	PL1/4x3			1		1	0	5	p182		1	A572-50
					Total weight : 5269								

REFERENCE :----

PAGE TOTALS

REVISION NO.

SPECIAL NOTES:-

1. SEAL ALL WELDS FOR GALVANIZE.
2. ALL VENT HOLES TO BE PLUGGED AFTER GALVANIZING.

MATERIAL:-

ASTM:	A36 U.N.O.
S. S.:	-----
ALUM.:	-----
PIPE:	A53 GR.B
TUBES:	A500 GR.B
HOLES:	13/16 U.N.O
WELDING:	E70XX

MATERIAL PREP.:-

CLEAN:	SSPC-SP2
SHOP PAINT:	TWO COAT OF STD SHOP PRIMER
GALV:	GALVANIZED & PAINTED

GEN. NOTES:-

BUY AMERICAN:
DOMESTIC:
CERT/CONFORMANCE:
CERT/COMPLIANCE:

ALL WIDE FLANGE SHAPES TO BE PER A992-G50

FIELD CONNECTIONS :
HOLES : 13/16" U.N.O
PAINT :

morrow steel Fabricators, Inc.

3620 COPELAND DRIVE
ZEPHYRHILLS, FL. 33542

	PRINTS FOR	DATE	MK	REVISIONS	DATE
			0	RELEASED FOR APPROVAL	Nov 18 2025
			1	RELEASED FOR RE-APPROVAL	Jul 13 2026
			2	RELEASED FOR RE-APPROVAL	Aug 26 2026

STRUCTURE:- PINELLAS SUNCOAST TRANSIT AUTHORITY
LOCATION:- CLEARWATER STATION,CLEARWATER,FL.
DETAILER:- VECTORSHADES LLC.
CUSTOMER:- KOKOLAKIS
ARCH./ENG.:- CDM SMITH
DESCRIPTION:- WAVE CANOPY COLUMN DETAIL
DRAWN:- PBI DATE:- 10-27-2025 CHK.D:- RAG DATE:- 10-27-2025

SHOP BILL	WORK ORDER NO.	DRWG. NO.
	2553	1004

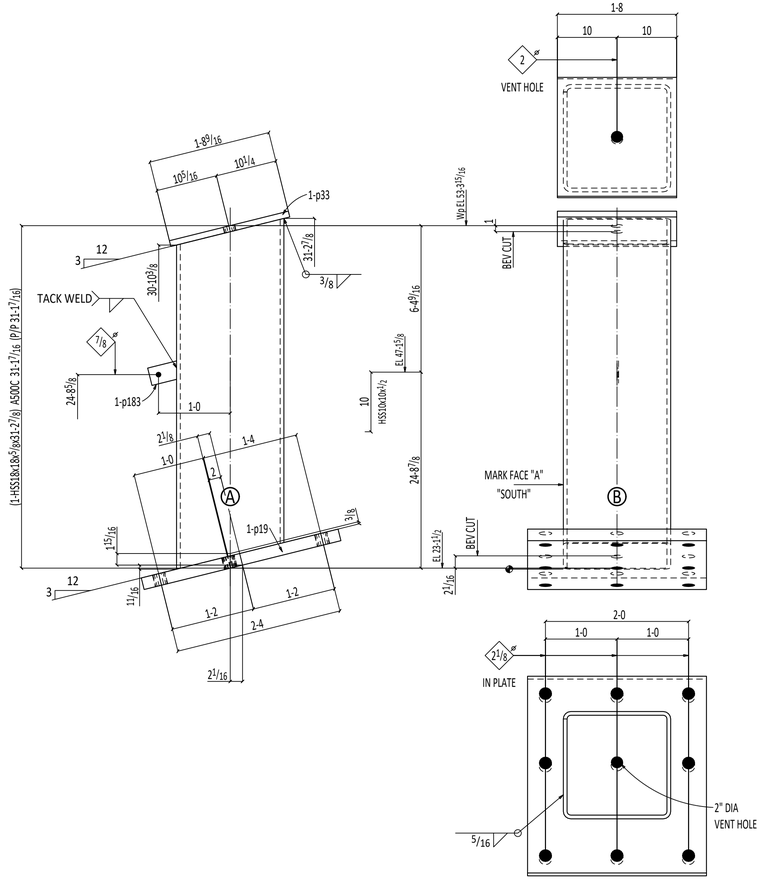

ONE COLUMN 1005C -G

AT GRID:
6.5 & B

SHIPPING LIST

MATERIAL BILL

ITEM NO	TOTAL QTY	DESCRIPTION	MAJOR MARK	PAINT CODE	TOTAL WEIGHT	ABM NO	UNIT QTY	LENGTH FT.	LENGTH IN.	MINOR MARK	REMARKS	UNIT WEIGHT	GRADE
	ONE	COLUMN	1005C	G	5206						Galv	5206	
	1	HSS18x18x5/8			4510		1	31	27/8	1005C	B2E	4510	A500C
	1	PL2x30			578		1	2	10	p19		578	A572-50
	1	PL1x20			117		1	1	89/16	p33		117	A572-50
	1	PL1/4x3			1		1	0	5	p183		1	A572-50

Total weight : 5206

REFERENCE :----

PAGE TOTALS

REVISION NO.

SPECIAL NOTES:-

1. SEAL ALL WELDS FOR GALVANIZE.
2. ALL VENT HOLES TO BE PLUGGED AFTER GALVANIZING.

MATERIAL:-

ASTM:	A36 U.N.O.
S. S.:	-----
ALUM.:	-----
PIPE:	A53 GR.B
TUBES:	A500 GR.B
HOLES:	13/16 U.N.O
WELDING:	E70XX

MATERIAL PREP.:-

CLEAN:	SSPC-SP2
SHOP PAINT:	TWO COAT OF STD SHOP PRIMER
GALV:	GALVANIZED & PAINTED

GEN. NOTES:-

BUY AMERICAN:	
DOMESTIC:	
CERT/CONFORMANCE:	
CERT/COMPLIANCE:	

ALL WIDE FLANGE SHAPES TO BE PER A992-G50

FIELD CONNECTIONS :
HOLES : 13/16" U.N.O
PAINT :

morrow steel Fabricators, Inc.

3620 COPELAND DRIVE
ZEPHYRHILLS, FL. 33542

	PRINTS FOR	DATE	MK	REVISIONS	DATE
			0	RELEASED FOR APPROVAL	Nov 18 2025
			1	RELEASED FOR RE-APPROVAL	Jul 13 2026
			2	RELEASED FOR RE-APPROVAL	Aug 26 2026

STRUCTURE:-PINELLAS SUNCOAST TRANSIT AUTHORITY
LOCATION:- CLEARWATER STATION,CLEARWATER,FL.
DETAILER:- VECTORSHADES LLC
CUSTOMER:- KOKOLAKIS
ARCH./ENG.:- CDM SMITH
DESCRIPTION:-WAVE CANOPY COLUMN DETAIL
DRAWN:- PBI DATE:-10-27-2025 CHK.D:-RAG DATE:- 10-27-2025

SHOP BILL	WORK ORDER NO.	DRWG. NO.
	2553	1005 ⚠1

AISC CERTIFIED FABRICATOR AND ERECTOR

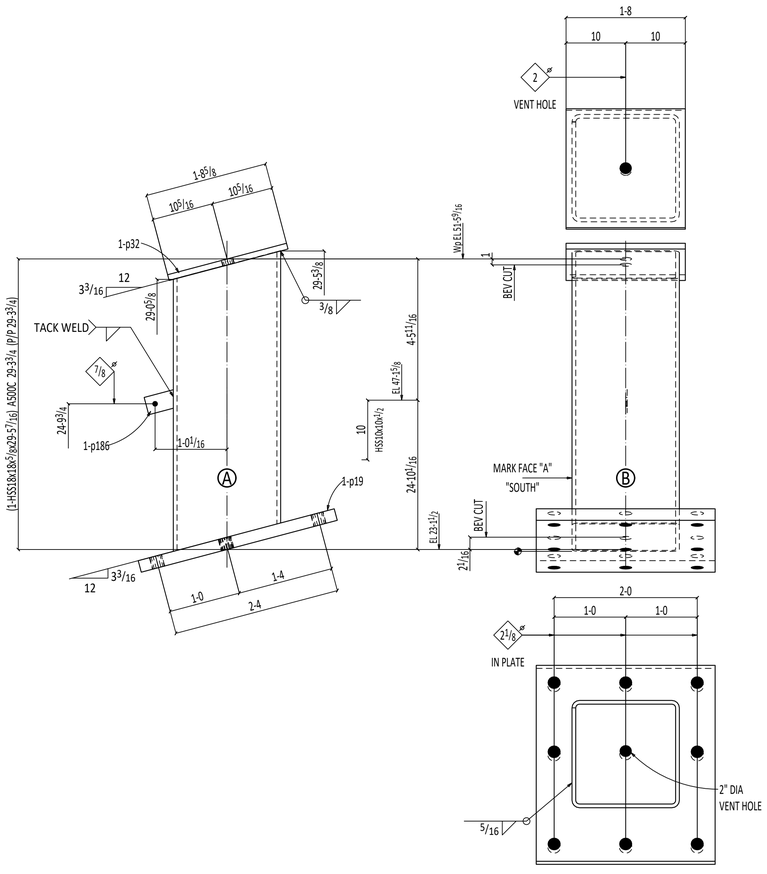

ONE COLUMN 1006C-G

AT GRID:
7.5 & B

SHIPPING LIST

MATERIAL BILL

ITEM NO	TOTAL QTY	DESCRIPTION	MAJOR MARK	PAINT CODE	TOTAL WEIGHT	ABM NO	UNIT QTY	LENGTH FT.	LENGTH IN.	MINOR MARK	REMARKS	UNIT WEIGHT	GRADE
	ONE	COLUMN	1006C	G	4949						Galv	4949	
	1	HSS18x18x5/8			4253		1	29	57/16	1006C	B2E	4253	A500C
	1	PL2x30			578		1	2	10	p19		578	A572-50
	1	PL1x20			117		1	1	85/8	p32		117	A572-50
	1	PL1/4x3			1		1	0	51/16	p186		1	A572-50

Total weight : 4949

REFERENCE :----

PAGE TOTALS

REVISION NO.

SPECIAL NOTES:-

1. SEAL ALL WELDS FOR GALVANIZE.
2. ALL VENT HOLES TO BE PLUGGED AFTER GALVANIZING.

MATERIAL:-

ASTM: A36 U.N.O.
S. S.: -----
ALUM.: -----
PIPE: A53 GR.B
TUBES: A500 GR.B
HOLES: 13/16 U.N.O
WELDING: E70XX

MATERIAL PREP.:-

CLEAN: SSPC-SP2
SHOP PAINT: TWO COAT OF STD SHOP PRIMER
GALV: GALVANIZED & PAINTED

GEN. NOTES:-

BUY AMERICAN:
DOMESTIC:
CERT/CONFORMANCE:
CERT/COMPLIANCE:

ALL WIDE FLANGE SHAPES TO BE PER A992-G50

FIELD CONNECTIONS :
HOLES : 13/16" U.N.O
PAINT :

morrow steel Fabricators, Inc.

3620 COPELAND DRIVE
ZEPHYRHILLS, FL. 33542

	PRINTS FOR	DATE	MK	REVISIONS	DATE
			0	RELEASED FOR APPROVAL	Nov 18 2025
			1	RELEASED FOR RE-APPROVAL	Jul 13 2026
			2	RELEASED FOR RE-APPROVAL	Aug 26 2026

STRUCTURE:-PINELLAS SUNCOAST TRANSIT AUTHORITY
LOCATION:- CLEARWATER STATION,CLEARWATER,FL.
DETAILER:- VECTORSHADES LLC
CUSTOMER:- KOKOLAKIS
ARCH./ENG.:- CDM SMITH
DESCRIPTION:-WAVE CANOPY COLUMN DETAIL
DRAWN:- PBI DATE:-10-27-2025 CHK.D:-RAG DATE:- 10-27-2025

SHOP BILL	WORK ORDER NO.	DRWG. NO.
	2553	1006

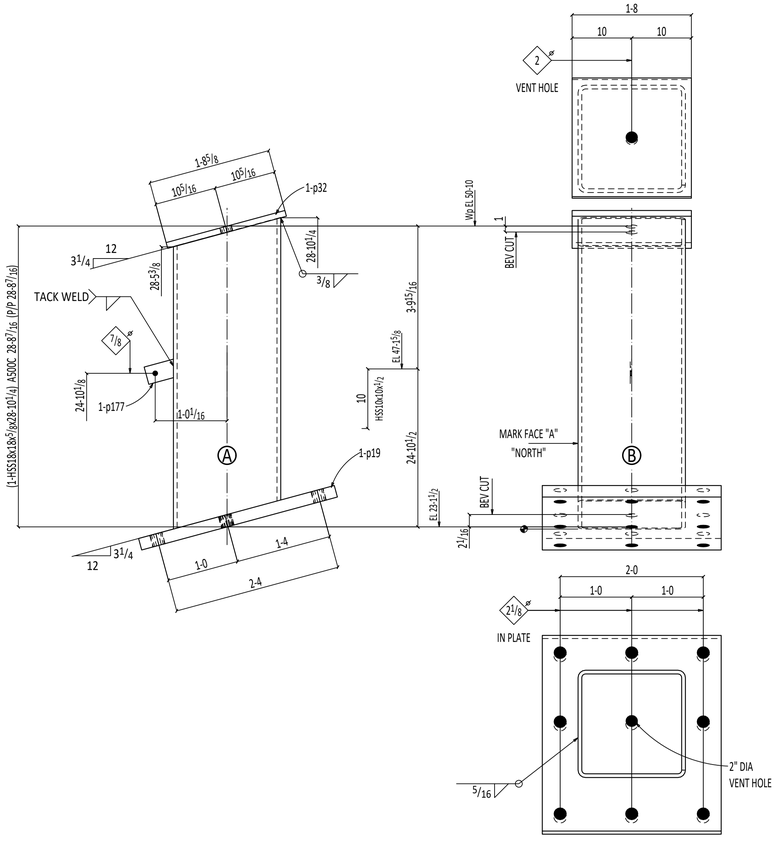

ONE COLUMN 1007C -G

AT GRID:
1.1 & C

SHIPPING LIST

MATERIAL BILL

ITEM NO	TOTAL QTY	DESCRIPTION	MAJOR MARK	PAINT CODE	TOTAL WEIGHT	ABM NO	UNIT QTY	LENGTH FT.	LENGTH IN.	MINOR MARK	REMARKS	UNIT WEIGHT	GRADE
	ONE	COLUMN	1007C	G	4863						Galv	4863	
	1	HSS18x18x5/8			4166		1	28	10 1/4	1007C	B2E	4166	A500C
	1	PL2x30			578		1	2	10	p19		578	A572-50
	1	PL1x20			117		1	1	8 5/8	p32		117	A572-50
	1	PL1/4x3			1		1	0	5 1/16	p177		1	A572-50
					Total weight :		4863						

REFERENCE :----

PAGE TOTALS

REVISION NO.

SPECIAL NOTES:-

1. SEAL ALL WELDS FOR GALVANIZE.
2. ALL VENT HOLES TO BE PLUGGED AFTER GALVANIZING.

MATERIAL:-

ASTM:	A36 U.N.O.
S. S.:	-----
ALUM.:	-----
PIPE:	A53 GR.B
TUBES:	A500 GR.B
HOLES:	13/16 U.N.O
WELDING:	E70XX

MATERIAL PREP.:-

CLEAN:	SSPC-SP2
SHOP PAINT:	TWO COAT OF STD SHOP PRIMER
GALV:	GALVANIZED & PAINTED

GEN. NOTES:-

BUY AMERICAN:	
DOMESTIC:	
CERT/CONFORMANCE:	
CERT/COMPLIANCE:	

ALL WIDE FLANGE SHAPES TO BE PER A992-G50

FIELD CONNECTIONS :
HOLES : 13/16" U.N.O
PAINT :

morrow steel Fabricators, Inc.

3620 COPELAND DRIVE
ZEPHYRHILLS, FL. 33542

	PRINTS FOR	DATE	MK	REVISIONS	DATE
			0	RELEASED FOR APPROVAL	Nov 18 2025
			1	RELEASED FOR RE-APPROVAL	Jul 13 2026
			2	RELEASED FOR RE-APPROVAL	Aug 26 2026

STRUCTURE:- PINELLAS SUNCOAST TRANSIT AUTHORITY
LOCATION:- CLEARWATER STATION,CLEARWATER,FL.
DETAILER:- VECTORSHADES LLC
CUSTOMER:- KOKOLAKIS
ARCH./ENG.:- CDM SMITH
DESCRIPTION:- WAVE CANOPY COLUMN DETAIL
DRAWN:- PBI DATE:- 10-27-2025 CHK.D:- RAG DATE:- 10-27-2025

SHOP BILL	WORK ORDER NO.	DRWG. NO.
	2553	1007 ⚠1

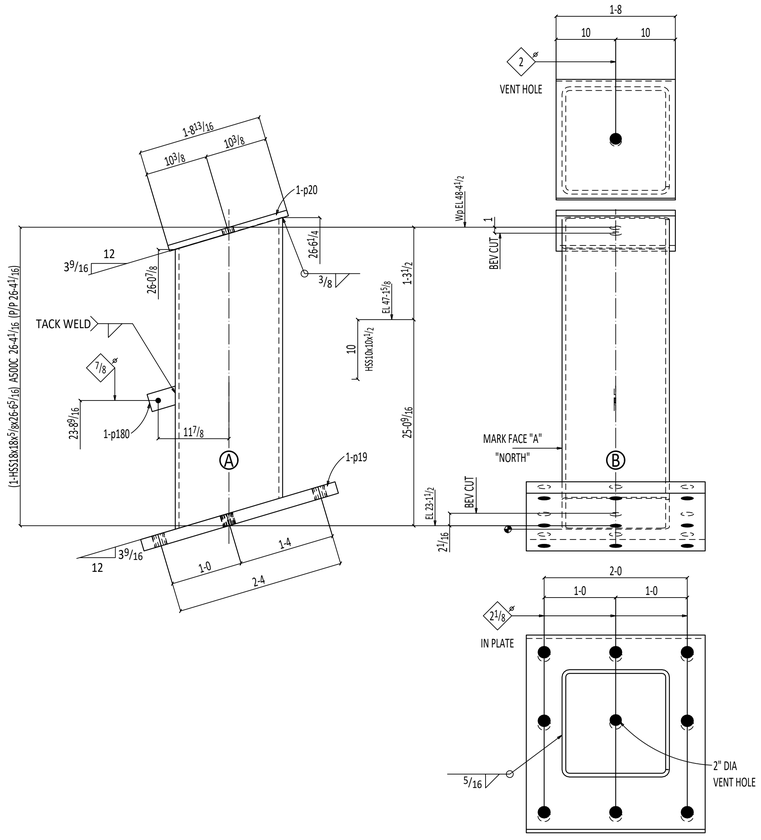

ONE COLUMN 1008C -G

AT GRID:
2.9 & C

SHIPPING LIST

ITEM NO	TOTAL QTY	DESCRIPTION	MAJOR MARK	PAINT CODE	TOTAL WEIGHT
	ONE	COLUMN	1008C	G	4528
	1	HSS18x18x5/8			3830
	1	PL2x30			578
	1	PL1x20			118
	1	PL1/4x3			1

Total weight : 4528

MATERIAL BILL

ABM NO	UNIT QTY	LENGTH FT.	LENGTH IN.	MINOR MARK	REMARKS	UNIT WEIGHT	GRADE
					Galv	4528	
	1	26	6 5/16	1008C	B2E	3830	A500C
	1	2	10	p19		578	A572-50
	1	1	8 13/16	p20		118	A572-50
	1	0	4 15/16	p180		1	A572-50

REFERENCE :----

PAGE TOTALS

REVISION NO.

SPECIAL NOTES:-

1. SEAL ALL WELDS FOR GALVANIZE.
2. ALL VENT HOLES TO BE PLUGGED AFTER GALVANIZING.

MATERIAL:-

ASTM: A36 U.N.O.
S.S.: -----
ALUM.: -----
PIPE: A53 GR.B
TUBES: A500 GR.B
HOLES: 13/16 U.N.O
WELDING: E70XX

MATERIAL PREP.:-

CLEAN: SSPC-SP2
SHOP PAINT: TWO COAT OF STD SHOP PRIMER
GALV: GALVANIZED & PAINTED

GEN. NOTES:-

BUY AMERICAN:
DOMESTIC:
CERT/CONFORMANCE:
CERT/COMPLIANCE:

ALL WIDE FLANGE SHAPES TO BE PER A992-G50

FIELD CONNECTIONS :
HOLES : 13/16" U.N.O
PAINT :

morrow steel Fabricators, Inc.

3620 COPELAND DRIVE
ZEPHYRHILLS, FL. 33542

	PRINTS FOR	DATE	MK	REVISIONS	DATE
			0	RELEASED FOR APPROVAL	Nov 18 2025
			1	RELEASED FOR RE-APPROVAL	Jul 13 2026
			2	RELEASED FOR RE-APPROVAL	Aug 26 2026

STRUCTURE:-PINELLAS SUNCOAST TRANSIT AUTHORITY
LOCATION:- CLEARWATER STATION,CLEARWATER,FL.
DETAILER:- VECTORSHADES LLC
CUSTOMER:- KOKOLAKIS
ARCH./ENG.:- CDM SMITH
DESCRIPTION:- WAVE CANOPY COLUMN DETAIL
DRAWN:- PBI DATE:- 10-27-2025 CHK.D:- RAG DATE:- 10-27-2025

SHOP BILL	WORK ORDER NO.	DRWG. NO.
	2553	1008 1

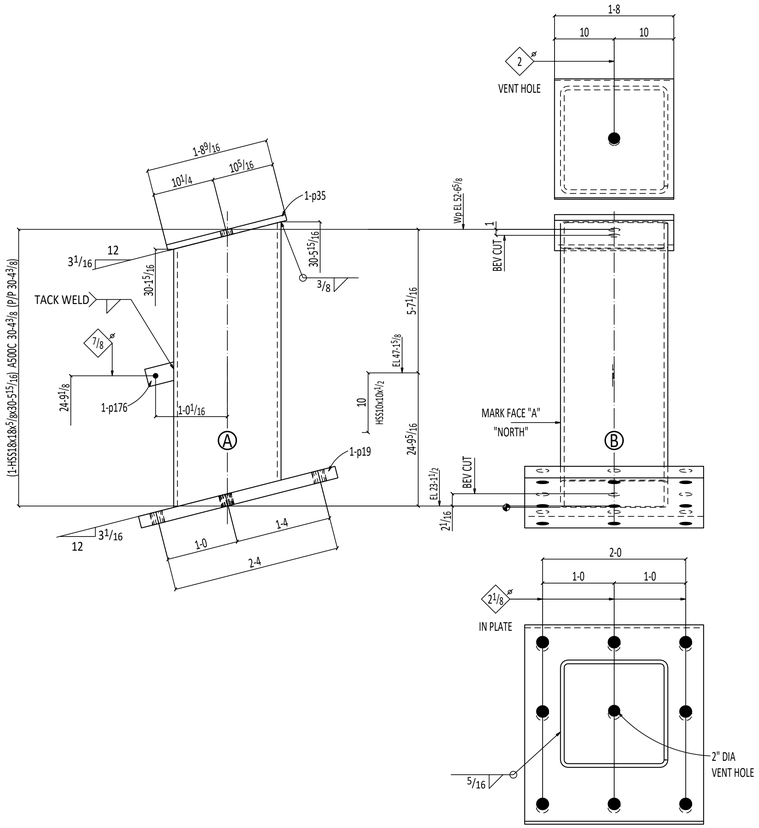

ONE COLUMN 1009C -G

AT GRID:
4.1 & C

SHIPPING LIST

MATERIAL BILL

ITEM NO	TOTAL QTY	DESCRIPTION	MAJOR MARK	PAINT CODE	TOTAL WEIGHT	ABM NO	UNIT QTY	LENGTH FT.	LENGTH IN.	MINOR MARK	REMARKS	UNIT WEIGHT	GRADE
	ONE	COLUMN	1009C	G	5099						Galv	5099	
	1	HSS18x18x5/8			4403		1	30	5 15/16	1009C	B2E	4403	A500C
	1	PL2x30			578		1	2	10	p19		578	A572-50
	1	PL1x20			117		1	1	8 9/16	p35		117	A572-50
	1	PL1/4x3			1		1	0	5	p176		1	A572-50

Total weight : 5099

REFERENCE :----

PAGE TOTALS

REVISION NO.

SPECIAL NOTES:-

1. SEAL ALL WELDS FOR GALVANIZE.
2. ALL VENT HOLES TO BE PLUGGED AFTER GALVANIZING.

MATERIAL:-

ASTM: A36 U.N.O.
S. S.: -----
ALUM.: -----
PIPE: A53 GR.B
TUBES: A500 GR.B
HOLES: 13/16 U.N.O
WELDING: E70XX

MATERIAL PREP.:-

CLEAN: SSPC-SP2
SHOP PAINT: TWO COAT OF STD SHOP PRIMER
GALV: GALVANIZED & PAINTED

GEN. NOTES:-

BUY AMERICAN:
DOMESTIC:
CERT/CONFORMANCE:
CERT/COMPLIANCE:

ALL WIDE FLANGE SHAPES TO BE PER A992-G50

FIELD CONNECTIONS :
HOLES : 13/16" U.N.O
PAINT :

morrow steel Fabricators, Inc.

3620 COPELAND DRIVE
ZEPHYRHILLS, FL. 33542

	PRINTS FOR	DATE	MK	REVISIONS	DATE
			0	RELEASED FOR APPROVAL	Nov 18 2025
			1	RELEASED FOR RE-APPROVAL	Jul 13 2026
			2	RELEASED FOR RE-APPROVAL	Aug 26 2026

STRUCTURE:- PINELLAS SUNCOAST TRANSIT AUTHORITY
LOCATION:- CLEARWATER STATION,CLEARWATER,FL.
DETAILER:- VECTORSHADES LLC
CUSTOMER:- KOKOLAKIS
ARCH./ENG.:- CDM SMITH
DESCRIPTION:- WAVE CANOPY COLUMN DETAIL
DRAWN:- PBI DATE:- 10-27-2025 CHK.D:- RAG DATE:- 10-27-2025

SHOP BILL	WORK ORDER NO.	DRWG. NO.
	2553	1009

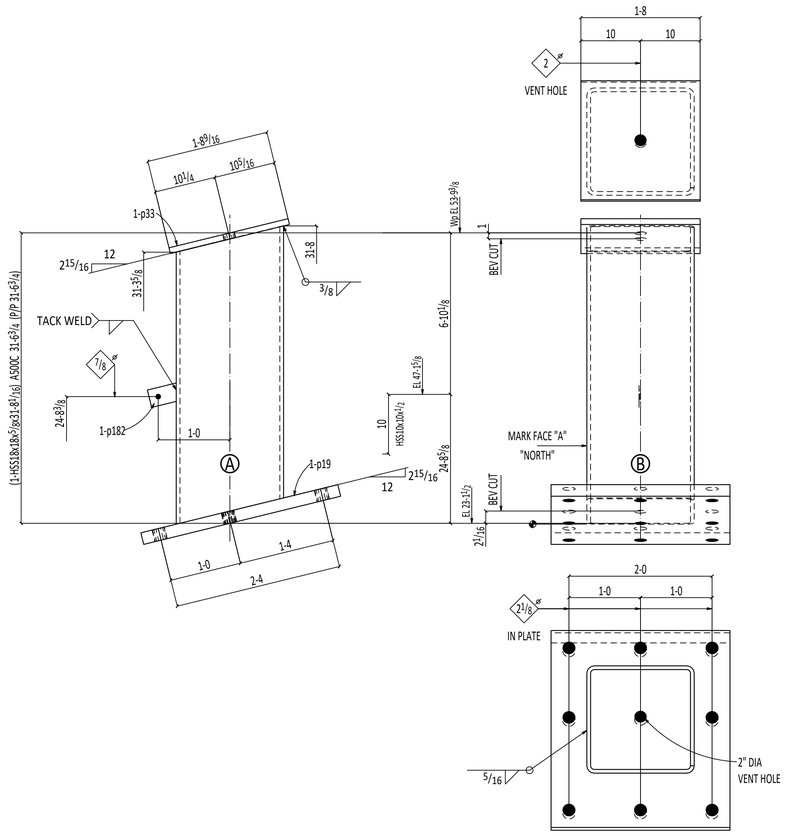

ONE COLUMN 1010C -G

AT GRID:
5.1 & C

SHIPPING LIST

MATERIAL BILL

ITEM NO	TOTAL QTY	DESCRIPTION	MAJOR MARK	PAINT CODE	TOTAL WEIGHT	ABM NO	UNIT QTY	LENGTH FT.	LENGTH IN.	MINOR MARK	REMARKS	UNIT WEIGHT	GRADE
	ONE	COLUMN	1010C	G	5269						Galv	5269	
	1	HSS18x18x5/8			4573		1	31	8 1/16	1010C	B2E	4573	A500C
	1	PL2x30			578		1	2	10	p19		578	A572-50
	1	PL1x20			117		1	1	8 9/16	p33		117	A572-50
	1	PL1/4x3			1		1	0	5	p182		1	A572-50
					Total weight : 5269								

REFERENCE :----

PAGE TOTALS

REVISION NO.

SPECIAL NOTES:-

1. SEAL ALL WELDS FOR GALVANIZE.
2. ALL VENT HOLES TO BE PLUGGED AFTER GALVANIZING.

MATERIAL:-

ASTM: A36 U.N.O.
S. S.: -----
ALUM.: -----
PIPE: A53 GR.B
TUBES: A500 GR.B
HOLES: 13/16 U.N.O
WELDING: E70XX

MATERIAL PREP.:-

CLEAN: SSPC-SP2
SHOP PAINT: TWO COAT OF STD SHOP PRIMER
GALV: GALVANIZED & PAINTED

GEN. NOTES:-

BUY AMERICAN:
DOMESTIC:
CERT/CONFORMANCE:
CERT/COMPLIANCE:

ALL WIDE FLANGE SHAPES TO BE PER A992-G50

FIELD CONNECTIONS :
HOLES : 13/16" U.N.O
PAINT :

morrow steel Fabricators, Inc.

3620 COPELAND DRIVE
ZEPHYRHILLS, FL. 33542

	PRINTS FOR	DATE	MK	REVISIONS	DATE
			0	RELEASED FOR APPROVAL	Nov 18 2025
			1	RELEASED FOR RE-APPROVAL	Jul 13 2026
			2	RELEASED FOR RE-APPROVAL	Aug 26 2026

STRUCTURE:- PINELLAS SUNCOAST TRANSIT AUTHORITY
LOCATION:- CLEARWATER STATION,CLEARWATER,FL.
DETAILER:- VECTORSHADES LLC
CUSTOMER:- KOKOLAKIS
ARCH./ENG.:- CDM SMITH
DESCRIPTION:- WAVE CANOPY COLUMN DETAIL
DRAWN:- PBI DATE:- 10-27-2025 CHK.D:- RAG DATE:- 10-27-2025

SHOP BILL	WORK ORDER NO.	DRWG. NO.
	2553	1010

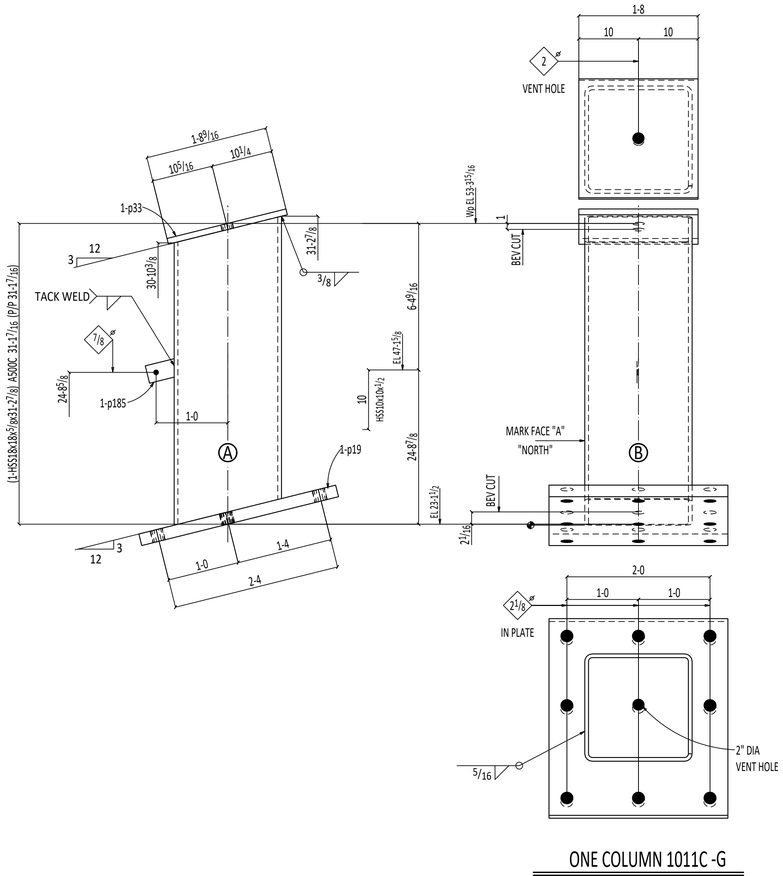

ONE COLUMN 1011C -G

AT GRID:
6.5 & C

SHIPPING LIST

MATERIAL BILL

ITEM NO	TOTAL QTY	DESCRIPTION	MAJOR MARK	PAINT CODE	TOTAL WEIGHT	ABM NO	UNIT QTY	LENGTH FT.	LENGTH IN.	MINOR MARK	REMARKS	UNIT WEIGHT	GRADE
	ONE	COLUMN	1011C	G	5206						Galv	5206	
	1	HSS18x18x5/8			4510		1	31	2 7/8	1011C	B2E	4510	A500C
	1	PL2x30			578		1	2	10	p19		578	A572-50
	1	PL1x20			117		1	1	8 9/16	p33		117	A572-50
	1	PL1/4x3			1		1	0	5	p185		1	A572-50

Total weight : 5206

REFERENCE :----

PAGE TOTALS

REVISION NO.

SPECIAL NOTES:-

1. SEAL ALL WELDS FOR GALVANIZE.
2. ALL VENT HOLES TO BE PLUGGED AFTER GALVANIZING.

MATERIAL:-

ASTM: A36 U.N.O.
S. S.: -----
ALUM.: -----
PIPE: A53 GR.B
TUBES: A500 GR.B
HOLES: 13/16 U.N.O
WELDING: E70XX

MATERIAL PREP.:-

CLEAN: SSPC-SP2
SHOP PAINT: TWO COAT OF STD SHOP PRIMER
GALV: GALVANIZED & PAINTED

GEN. NOTES:-

BUY AMERICAN:
DOMESTIC:
CERT/CONFORMANCE:
CERT/COMPLIANCE:

ALL WIDE FLANGE SHAPES TO BE PER A992-G50

FIELD CONNECTIONS :
HOLES : 13/16" U.N.O
PAINT :

morrow steel Fabricators, Inc.

3620 COPELAND DRIVE
ZEPHYRHILLS, FL. 33542

	PRINTS FOR	DATE	MK	REVISIONS	DATE
			0	RELEASED FOR APPROVAL	Nov 18 2025
			1	RELEASED FOR RE-APPROVAL	Jul 13 2026
			2	RELEASED FOR RE-APPROVAL	Aug 26 2026

STRUCTURE:-PINELLAS SUNCOAST TRANSIT AUTHORITY
LOCATION:- CLEARWATER STATION,CLEARWATER,FL.
DETAILER:- VECTORSHADES LLC
CUSTOMER:- KOKOLAKIS
ARCH./ENG.:- CDM SMITH
DESCRIPTION:-WAVE CANOPY COLUMN DETAIL
DRAWN:- PBI DATE:-10-27-2025 CHK.D:-RAG DATE:- 10-27-2025

SHOP BILL	WORK ORDER NO.	DRWG. NO.
	2553	1011 ⚠1

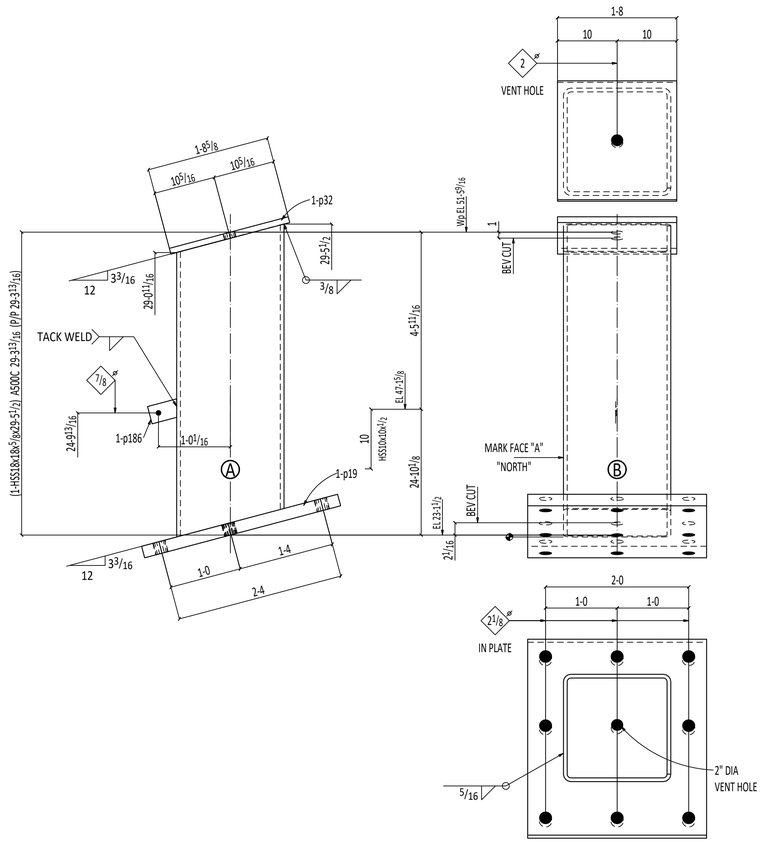

ONE COLUMN 1012C -G

AT GRID:
7.5 & C

SHIPPING LIST

MATERIAL BILL

ITEM NO	TOTAL QTY	DESCRIPTION	MAJOR MARK	PAINT CODE	TOTAL WEIGHT	ABM NO	UNIT QTY	LENGTH FT.	LENGTH IN.	MINOR MARK	REMARKS	UNIT WEIGHT	GRADE
	ONE	COLUMN	1012C	G	4950						Galv	4950	
	1	HSS18x18x5/8			4254		1	29	5 1/2	1012C	B2E	4254	A500C
	1	PL2x30			578		1	2	10	p19		578	A572-50
	1	PL1x20			117		1	1	8 5/8	p32		117	A572-50
	1	PL1/4x3			1		1	0	5 1/16	p186		1	A572-50

Total weight : 4950

REFERENCE :----

PAGE TOTALS

REVISION NO.

SPECIAL NOTES:-

1. SEAL ALL WELDS FOR GALVANIZE.
2. ALL VENT HOLES TO BE PLUGGED AFTER GALVANIZING.

MATERIAL:-

ASTM: A36 U.N.O.
S. S.: -----
ALUM.: -----
PIPE: A53 GR.B
TUBES: A500 GR.B
HOLES: 13/16 U.N.O
WELDING: E70XX

MATERIAL PREP.:-

CLEAN: SSPC-SP2
SHOP PAINT: TWO COAT OF STD SHOP PRIMER
GALV: GALVANIZED & PAINTED

GEN. NOTES:-

BUY AMERICAN:
DOMESTIC:
CERT/CONFORMANCE:
CERT/COMPLIANCE:

ALL WIDE FLANGE SHAPES TO BE PER A992-G50

FIELD CONNECTIONS :
HOLES : 13/16" U.N.O
PAINT :

morrow steel Fabricators, Inc.

3620 COPELAND DRIVE
ZEPHYRHILLS, FL. 33542

	PRINTS FOR	DATE	MK	REVISIONS	DATE
			0	RELEASED FOR APPROVAL	Nov 18 2025
			1	RELEASED FOR RE-APPROVAL	Jul 13 2026
			2	RELEASED FOR RE-APPROVAL	Aug 26 2026

STRUCTURE:- PINELLAS SUNCOAST TRANSIT AUTHORITY
LOCATION:- CLEARWATER STATION,CLEARWATER,FL.
DETAILER:- VECTORSHADES LLC
CUSTOMER:- KOKOLAKIS
ARCH./ENG.:- CDM SMITH
DESCRIPTION:- WAVE CANOPY COLUMN DETAIL
DRAWN:- PBI DATE:- 10-27-2025 CHK.D:- RAG DATE:- 10-27-2025

SHOP BILL	WORK ORDER NO.	DRWG. NO.
	2553	1012 ⚠1

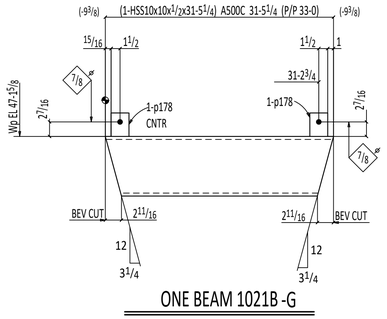

ONE BEAM 1021B -G

SHIPPING LIST

MATERIAL BILL

ITEM NO	TOTAL QTY	DESCRIPTION	MAJOR MARK	PAINT CODE	TOTAL WEIGHT	ABM NO	UNIT QTY	LENGTH FT.	LENGTH IN.	MINOR MARK	REMARKS	UNIT WEIGHT	GRADE
	ONE	BEAM	1021B	G	1965						Galv	1965	
	1	HSS10x10x1/2			1964		1	31	5¼	1021B	B2E	1964	A500C
	2	PL1/4x3			2		2	0	3 15/16	p178		1	A572-50
		FIELD BOLTS											
	2	3/4 Dia A307						0	1½				

Total weight : 1965

REFERENCE :----

PAGE TOTALS

REVISION NO.

SPECIAL NOTES:-

1. SEAL ALL WELDS FOR GALVANIZE.
2. ALL VENT HOLES TO BE PLUGGED AFTER GALVANIZING.

MATERIAL:-

ASTM: A36 U.N.O.
S. S.: -----
ALUM.: -----
PIPE: A53 GR.B
TUBES: A500 GR.B
HOLES: 13/16 U.N.O
WELDING: E70XX

ALL WIDE FLANGE SHAPES TO BE PER A992-G50

MATERIAL PREP.:-

CLEAN: SSPC-SP2
SHOP PAINT: TWO COAT OF STD SHOP PRIMER
GALV: GALVANIZED & PAINTED

GEN. NOTES:-

BUY AMERICAN:
DOMESTIC:
CERT/CONFORMANCE:
CERT/COMPLIANCE:

FIELD CONNECTIONS :
HOLES : 13/16" U.N.O
PAINT :

morrow steel Fabricators, Inc.

3620 COPELAND DRIVE
ZEPHYRHILLS, FL. 33542

	PRINTS FOR	DATE	MK	REVISIONS	DATE
			0	RELEASED FOR APPROVAL	Nov 18 2025
			1	RELEASED FOR RE-APPROVAL	Jul 13 2026
			2	RELEASED FOR RE-APPROVAL	Aug 26 2026

STRUCTURE:-PINELLAS SUNCOAST TRANSIT AUTHORITY
LOCATION:- CLEARWATER STATION,CLEARWATER,FL.
DETAILER:- VECTORSHADES LLC
CUSTOMER:- KOKOLAKIS
ARCH./ENG.:- CDM SMITH
DESCRIPTION:-WAVE CANOPY BEAM DETAIL
DRAWN:- PBI DATE:-10-27-2025 CHK.D:-RAG DATE:- 10-27-2025

SHOP BILL	WORK ORDER NO.	DRWG. NO.
	2553	1021

SHIPPING LIST

MATERIAL BILL

ITEM NO	TOTAL QTY	DESCRIPTION	MAJOR MARK	PAINT CODE	TOTAL WEIGHT	ABM NO	UNIT QTY	LENGTH FT.	LENGTH IN.	MINOR MARK	REMARKS	UNIT WEIGHT	GRADE
	ONE	BEAM	1022B	G	3354						Galv	3354	
	1	HSS10x6x1/2			2932		1	60	0 1/4	1022B		2932	A500C
	6	PL5/8x12			189		6	1	2 13/16	p857		32	A572-50
	6	PL5/8x12			194		6	1	3 1/4	p853		32	A572-50
	2	PL3/8x6			13		2	0	10	p42		6	A572-50
	8	PL3/8x5			26		8	0	6	p759		3	A572-50
					Total weight :	3354							

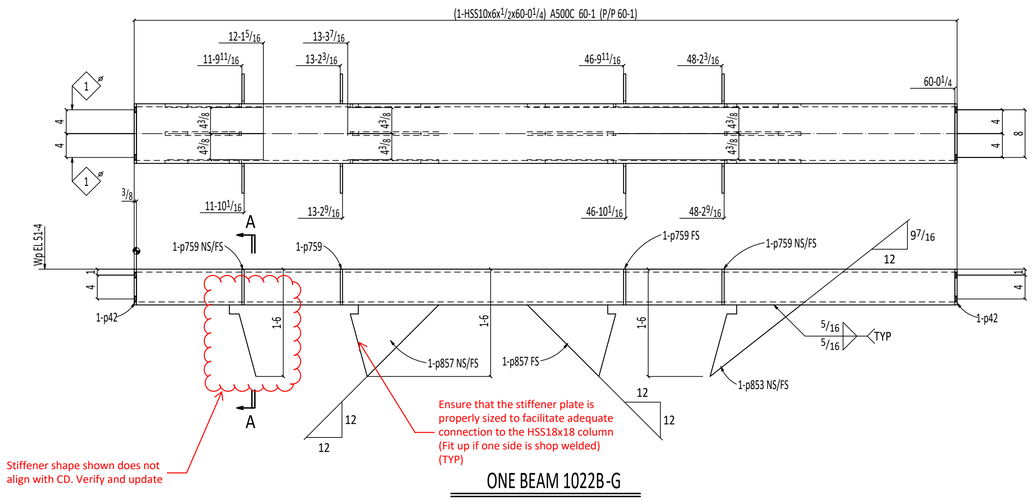

ONE BEAM 1022B-G

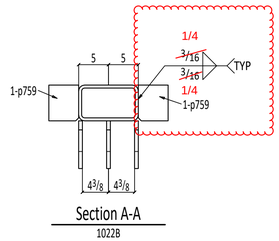

As in section Section A-A of E119, provide shim plates at all locations where the HSS5x5 bears on the HSS10x6 to facilitate fit-up. Coordinate and provide the shims at all applicable locations. TYP

REFERENCE :----

PAGE TOTALS

REVISION NO.

SPECIAL NOTES:-

1. SEAL ALL WELDS FOR GALVANIZE.
2. ALL VENT HOLES TO BE PLUGGED AFTER GALVANIZING.

MATERIAL:-

ASTM: A36 U.N.O.
S. S.: -----
ALUM.: -----
PIPE: A53 GR.B
TUBES: A500 GR.B
HOLES: 13/16 U.N.O
WELDING: E70XX

MATERIAL PREP.:-

CLEAN: SSPC-SP2
SHOP PAINT: TWO COAT OF STD SHOP PRIMER
GALV: GALVANIZED & PAINTED

GEN. NOTES:-

BUY AMERICAN:
DOMESTIC:
CERT/CONFORMANCE:
CERT/COMPLIANCE:

ALL WIDE FLANGE SHAPES TO BE PER A992-G50

FIELD CONNECTIONS :
HOLES : 13/16" U.N.O
PAINT :

morrow steel Fabricators, Inc.

3620 COPELAND DRIVE
ZEPHYRHILLS, FL. 33542

	PRINTS FOR	DATE	MK	REVISIONS	DATE
			0	RELEASED FOR APPROVAL	Nov 18 2025
			1	RELEASED FOR RE-APPROVAL	Jul 13 2026
			2	RELEASED FOR RE-APPROVAL	Aug 26 2026

STRUCTURE:-PINELLAS SUNCOAST TRANSIT AUTHORITY
LOCATION:- CLEARWATER STATION,CLEARWATER,FL.
DETAILER:- VECTORSHADES LLC
CUSTOMER:- KOKOLAKIS
ARCH./ENG.:- CDM SMITH
DESCRIPTION:-WAVE CANOPY BEAM DETAIL
DRAWN:- PBI DATE:-10-27-2025 CHK.D:-RAG DATE:- 10-27-2025

SHOP BILL	WORK ORDER NO.	DRWG. NO.
	2553	1022

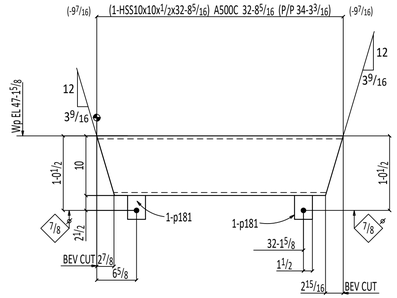

ONE BEAM 1023B -G

SHIPPING LIST

MATERIAL BILL

ITEM NO	TOTAL QTY	DESCRIPTION	MAJOR MARK	PAINT CODE	TOTAL WEIGHT	ABM NO	UNIT QTY	LENGTH FT.	LENGTH IN.	MINOR MARK	REMARKS	UNIT WEIGHT	GRADE
	ONE	BEAM	1023B	G	2044						Galv	2044	
	1	HSS10x10x1/2			2042		1	32	8 5/16	1023B	B2E	2042	A500C
	2	PL1/4x3			2		2	0	4	p181		1	A572-50
		FIELD BOLTS											
	2	3/4 Dia A307						0	1 1/2				

Total weight : 2044

REFERENCE :----

PAGE TOTALS

REVISION NO.

SPECIAL NOTES:-

1. SEAL ALL WELDS FOR GALVANIZE.
2. ALL VENT HOLES TO BE PLUGGED AFTER GALVANIZING.

MATERIAL:-

ASTM: A36 U.N.O.
S. S.: -----
ALUM.: -----
PIPE: A53 GR.B
TUBES: A500 GR.B
HOLES: 13/16 U.N.O
WELDING: E70XX

MATERIAL PREP.:-

CLEAN: SSPC-SP2
SHOP PAINT: TWO COAT OF STD SHOP PRIMER
GALV: GALVANIZED & PAINTED

GEN. NOTES:-

BUY AMERICAN:
DOMESTIC:
CERT/CONFORMANCE:
CERT/COMPLIANCE:

ALL WIDE FLANGE SHAPES TO BE PER A992-G50

FIELD CONNECTIONS :
HOLES : 13/16" U.N.O
PAINT :

morrow steel Fabricators, Inc.

3620 COPELAND DRIVE
ZEPHYRHILLS, FL. 33542

	PRINTS FOR	DATE	MK	REVISIONS	DATE
			0	RELEASED FOR APPROVAL	Nov 18 2025
			1	RELEASED FOR RE-APPROVAL	Jul 13 2026
			2	RELEASED FOR RE-APPROVAL	Aug 26 2026

STRUCTURE:-PINELLAS SUNCOAST TRANSIT AUTHORITY
LOCATION:- CLEARWATER STATION,CLEARWATER,FL.
DETAILER:- VECTORSHADES LLC.
CUSTOMER:- KOKOLAKIS
ARCH./ENG.:- CDM SMITH
DESCRIPTION:- WAVE CANOPY BEAM DETAIL
DRAWN:- PBI DATE:-10-27-2025 CHK.D:-RAG DATE:- 10-27-2025

SHOP BILL	WORK ORDER NO.	DRWG. NO.
	2553	1023

SHIPPING LIST

MATERIAL BILL

ITEM NO	TOTAL QTY	DESCRIPTION	MAJOR MARK	PAINT CODE	TOTAL WEIGHT	ABM NO	UNIT QTY	LENGTH FT.	LENGTH IN.	MINOR MARK	REMARKS	UNIT WEIGHT	GRADE
	ONE	BEAM	1024B	G	3373						Galv	3373	
	1	HSS10x6x1/2			2932		1	60	0 1/4	1024B		2932	A500C
	2	PL5/8x5			11		2	0	6 5/16	p877		6	A572-50
	6	PL5/8x12			199		6	1	3 9/16	p840		33	A572-50
	6	PL5/8x12			193		6	1	3 1/8	p839		32	A572-50
	2	PL3/8x6			13		2	0	10	p42		6	A572-50
	8	PL3/8x5			26		8	0	6	p759		3	A572-50

Total weight : 3373

Clarify whether these are shim plates. IAs in section Section A-A of E119, provide shim plates at all locations where the HSS5x5 bears on the HSS10x6 to facilitate fit-up. Coordinate and provide the shims at all applicable locations. TYP

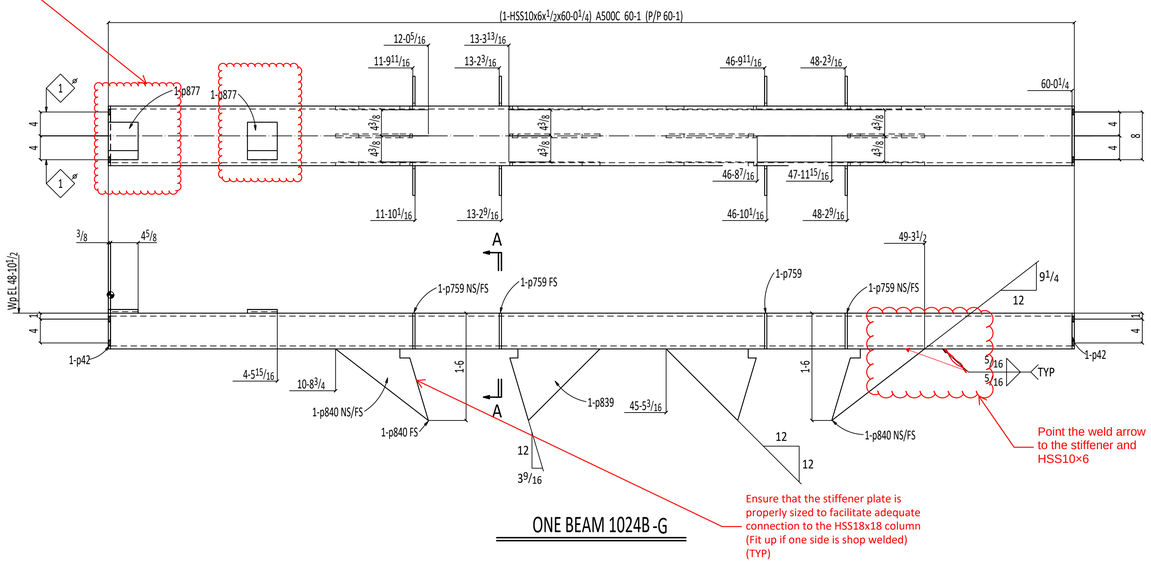

ONE BEAM 1024B -G

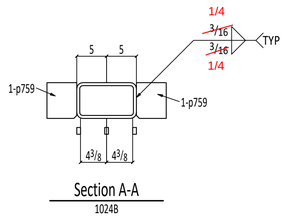

Section A-A

1024B

REFERENCE :----

PAGE TOTALS

REVISION NO.

SPECIAL NOTES:-

1. SEAL ALL WELDS FOR GALVANIZE.
2. ALL VENT HOLES TO BE PLUGGED AFTER GALVANIZING.

MATERIAL:-

ASTM: A36 U.N.O.
S.S.: -----
ALUM.: -----
PIPE: A53 GR.B
TUBES: A500 GR.B
HOLES: 13/16 U.N.O
WELDING: E70XX

MATERIAL PREP.:-

CLEAN: SSPC-SP2
SHOP PAINT: TWO COAT OF STD SHOP PRIMER
GALV: GALVANIZED & PAINTED

GEN. NOTES:-

BUY AMERICAN:
DOMESTIC:
CERT/CONFORMANCE:
CERT/COMPLIANCE:

ALL WIDE FLANGE SHAPES TO BE PER A992-G50

FIELD CONNECTIONS :
HOLES : 13/16" U.N.O
PAINT :

morrow steel Fabricators, Inc.

3620 COPELAND DRIVE
ZEPHYRHILLS, FL. 33542

	PRINTS FOR	DATE	MK	REVISIONS	DATE
			0	RELEASED FOR APPROVAL	Nov 18 2025
			1	RELEASED FOR RE-APPROVAL	Jul 13 2026
			2	RELEASED FOR RE-APPROVAL	Aug 26 2026

STRUCTURE:- PINELLAS SUNCOAST TRANSIT AUTHORITY
LOCATION:- CLEARWATER STATION,CLEARWATER,FL.
DETAILER:- VECTORSHADES LLC
CUSTOMER:- KOKOLAKIS
ARCH./ENG.:- CDM SMITH
DESCRIPTION:- WAVE CANOPY BEAM DETAIL
DRAWN:- PBI DATE:- 10-27-2025 CHK.D:- RAG DATE:- 10-27-2025

SHOP BILL	WORK ORDER NO.	DRWG. NO.
	2553	1024

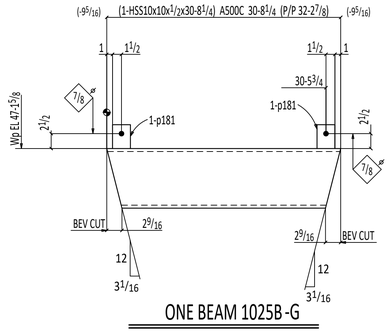

ONE BEAM 1025B -G

SHIPPING LIST

MATERIAL BILL

ITEM NO	TOTAL QTY	DESCRIPTION	MAJOR MARK	PAINT CODE	TOTAL WEIGHT	ABM NO	UNIT QTY	LENGTH FT.	LENGTH IN.	MINOR MARK	REMARKS	UNIT WEIGHT	GRADE
	ONE	BEAM	1025B	G	1918						Galv	1918	
	1	HSS10x10x1/2			1917		1	30	8¼	1025B	B2E	1917	A500C
	2	PL1/4x3			2		2	0	4	p181		1	A572-50
		FIELD BOLTS											
	2	3/4 Dia A307						0	1½				

Total weight : 1918

REFERENCE :----

PAGE TOTALS

REVISION NO.

SPECIAL NOTES:-

1. SEAL ALL WELDS FOR GALVANIZE.
2. ALL VENT HOLES TO BE PLUGGED AFTER GALVANIZING.

MATERIAL:-

ASTM: A36 U.N.O.
S. S.: -----
ALUM.: -----
PIPE: A53 GR.B
TUBES: A500 GR.B
HOLES: 13/16 U.N.O
WELDING: E70XX

MATERIAL PREP.:-

CLEAN: SSPC-SP2
SHOP PAINT: TWO COAT OF STD SHOP PRIMER
GALV: GALVANIZED & PAINTED

GEN. NOTES:-

BUY AMERICAN:
DOMESTIC:
CERT/CONFORMANCE:
CERT/COMPLIANCE:

ALL WIDE FLANGE SHAPES TO BE PER A992-G50

FIELD CONNECTIONS :
HOLES : 13/16" U.N.O
PAINT :

morrow steel Fabricators, Inc.

3620 COPELAND DRIVE
ZEPHYRHILLS, FL. 33542

	PRINTS FOR	DATE	MK	REVISIONS	DATE
			0	RELEASED FOR APPROVAL	Nov 18 2025
			1	RELEASED FOR RE-APPROVAL	Jul 13 2026
			2	RELEASED FOR RE-APPROVAL	Aug 26 2026

STRUCTURE:-PINELLAS SUNCOAST TRANSIT AUTHORITY
LOCATION:- CLEARWATER STATION,CLEARWATER,FL.
DETAILER:- VECTORSHADES LLC.
CUSTOMER:- KOKOLAKIS
ARCH./ENG.:- CDM SMITH
DESCRIPTION:- WAVE CANOPY BEAM DETAIL
DRAWN:- PBI DATE:-10-27-2025 CHK.D:-RAG DATE:- 10-27-2025

SHOP BILL	WORK ORDER NO.	DRWG. NO.
	2553	1025

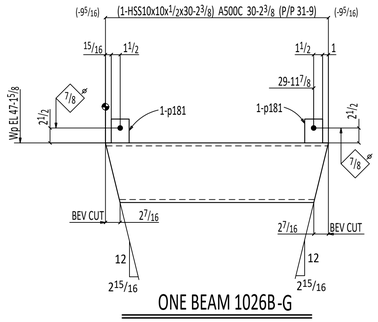

ONE BEAM 1026B-G

SHIPPING LIST

MATERIAL BILL

ITEM NO	TOTAL QTY	DESCRIPTION	MAJOR MARK	PAINT CODE	TOTAL WEIGHT	ABM NO	UNIT QTY	LENGTH FT.	LENGTH IN.	MINOR MARK	REMARKS	UNIT WEIGHT	GRADE
	ONE	BEAM	1026B	G	1888						Galv	1888	
	1	HSS10x10x1/2			1886		1	30	2 3/8	1026B	B2E	1886	A500C
	2	PL1/4x3			2		2	0	4	p181		1	A572-50
		FIELD BOLTS											
	2	3/4 Dia A307						0	1 1/2				

Total weight : 1888

REFERENCE :----

PAGE TOTALS

REVISION NO.

SPECIAL NOTES:-

1. SEAL ALL WELDS FOR GALVANIZE.
2. ALL VENT HOLES TO BE PLUGGED AFTER GALVANIZING.

MATERIAL:-

ASTM: A36 U.N.O.
S.S.: -----
ALUM.: -----
PIPE: A53 GR.B
TUBES: A500 GR.B
HOLES: 13/16 U.N.O
WELDING: E70XX

MATERIAL PREP.:-

CLEAN: SSPC-SP2
SHOP PAINT: TWO COAT OF STD SHOP PRIMER
GALV: GALVANIZED & PAINTED

GEN. NOTES:-

BUY AMERICAN:
DOMESTIC:
CERT/CONFORMANCE:
CERT/COMPLIANCE:

ALL WIDE FLANGE SHAPES TO BE PER A992-G50

FIELD CONNECTIONS :
HOLES : 13/16" U.N.O
PAINT :

morrow steel Fabricators, Inc.

3620 COPELAND DRIVE
ZEPHYRHILLS, FL. 33542

	PRINTS FOR	DATE	MK	REVISIONS	DATE
			0	RELEASED FOR APPROVAL	Nov 18 2025
			1	RELEASED FOR RE-APPROVAL	Jul 13 2026
			2	RELEASED FOR RE-APPROVAL	Aug 26 2026

STRUCTURE:- PINELLAS SUNCOAST TRANSIT AUTHORITY
LOCATION:- CLEARWATER STATION,CLEARWATER,FL.
DETAILER:- VECTORSHADES LLC
CUSTOMER:- KOKOLAKIS
ARCH./ENG.:- CDM SMITH
DESCRIPTION:- WAVE CANOPY BEAM DETAIL
DRAWN:- PBI DATE:- 10-27-2025 CHK.D:- RAG DATE:- 10-27-2025

SHOP BILL	WORK ORDER NO.	DRWG. NO.
	2553	1026

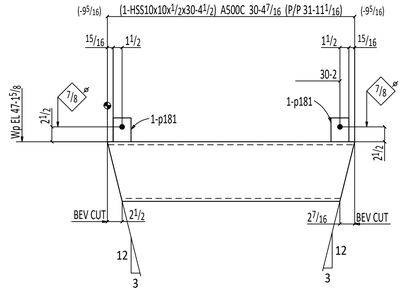

ONE BEAM 1027B-G

SHIPPING LIST

MATERIAL BILL

ITEM NO	TOTAL QTY	DESCRIPTION	MAJOR MARK	PAINT CODE	TOTAL WEIGHT	ABM NO	UNIT QTY	LENGTH FT.	LENGTH IN.	MINOR MARK	REMARKS	UNIT WEIGHT	GRADE
	ONE	BEAM	1027B	G	1899						Galv	1899	
	1	HSS10x10x1/2			1897		1	30	4 1/2	1027B	B2E	1897	A500C
	2	PL1/4x3			2		2	0	4	p181		1	A572-50
		FIELD BOLTS											
	2	3/4 Dia A307						0	1 1/2				

Total weight : 1899

REFERENCE :----

PAGE TOTALS

REVISION NO.

SPECIAL NOTES:-

1. SEAL ALL WELDS FOR GALVANIZE.
2. ALL VENT HOLES TO BE PLUGGED AFTER GALVANIZING.

MATERIAL:-

ASTM: A36 U.N.O.
S. S.: -----
ALUM.: -----
PIPE: A53 GR.B
TUBES: A500 GR.B
HOLES: 13/16 U.N.O
WELDING: E70XX

MATERIAL PREP.:-

CLEAN: SSPC-SP2
SHOP PAINT: TWO COAT OF STD SHOP PRIMER
GALV: GALVANIZED & PAINTED

GEN. NOTES:-

BUY AMERICAN:
DOMESTIC:
CERT/CONFORMANCE:
CERT/COMPLIANCE:

ALL WIDE FLANGE SHAPES TO BE PER A992-G50

FIELD CONNECTIONS :
HOLES : 13/16" U.N.O
PAINT :

morrow steel Fabricators, Inc.

3620 COPELAND DRIVE
ZEPHYRHILLS, FL. 33542

	PRINTS FOR	DATE	MK	REVISIONS	DATE
			0	RELEASED FOR APPROVAL	Nov 18 2025
			1	RELEASED FOR RE-APPROVAL	Jul 13 2026
			2	RELEASED FOR RE-APPROVAL	Aug 26 2026

STRUCTURE:-PINELLAS SUNCOAST TRANSIT AUTHORITY
LOCATION:- CLEARWATER STATION,CLEARWATER,FL.
DETAILER:- VECTORSHADES LLC
CUSTOMER:- KOKOLAKIS
ARCH./ENG.:- CDM SMITH
DESCRIPTION:- WAVE CANOPY BEAM DETAIL
DRAWN:- PBI DATE:-10-27-2025 CHK.D:-RAG DATE:- 10-27-2025

SHOP BILL	WORK ORDER NO.	DRWG. NO.
	2553	1027

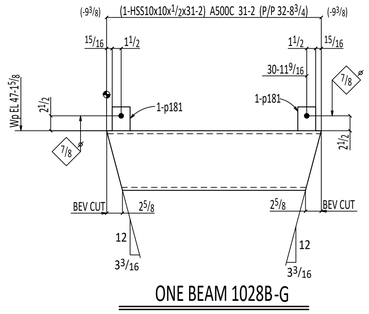

ONE BEAM 1028B-G

SHIPPING LIST

MATERIAL BILL

ITEM NO	TOTAL QTY	DESCRIPTION	MAJOR MARK	PAINT CODE	TOTAL WEIGHT	ABM NO	UNIT QTY	LENGTH FT.	LENGTH IN.	MINOR MARK	REMARKS	UNIT WEIGHT	GRADE
	ONE	BEAM	1028B	G	1948						Galv	1948	
	1	HSS10x10x1/2			1947		1	31	2	1028B	B2E	1947	A500C
	2	PL1/4x3			2		2	0	4	p181		1	A572-50
		FIELD BOLTS											
	1	3/4 Dia A307						0	1 1/2				
	1	3/4 Dia A307						0	1 1/2		GALV		

Total weight : 1948

REFERENCE :----

PAGE TOTALS

REVISION NO.

SPECIAL NOTES:-

1. SEAL ALL WELDS FOR GALVANIZE.
2. ALL VENT HOLES TO BE PLUGGED AFTER GALVANIZING.

MATERIAL:-

ASTM: A36 U.N.O.
S. S.: -----
ALUM.: -----
PIPE: A53 GR.B
TUBES: A500 GR.B
HOLES: 13/16 U.N.O
WELDING: E70XX

MATERIAL PREP.:-

CLEAN: SSPC-SP2
SHOP PAINT: TWO COAT OF STD SHOP PRIMER
GALV: GALVANIZED & PAINTED

GEN. NOTES:-

BUY AMERICAN:
DOMESTIC:
CERT/CONFORMANCE:
CERT/COMPLIANCE:

ALL WIDE FLANGE SHAPES TO BE PER A992-G50

FIELD CONNECTIONS :
HOLES : 13/16" U.N.O
PAINT :

morrow steel Fabricators, Inc.

3620 COPELAND DRIVE
ZEPHYRHILLS, FL. 33542

	PRINTS FOR	DATE	MK	REVISIONS	DATE
			0	RELEASED FOR APPROVAL	Nov 18 2025
			1	RELEASED FOR RE-APPROVAL	Jul 13 2026
			2	RELEASED FOR RE-APPROVAL	Aug 26 2026

STRUCTURE:- PINELLAS SUNCOAST TRANSIT AUTHORITY
LOCATION:- CLEARWATER STATION,CLEARWATER,FL.
DETAILER:- VECTORSHADES LLC
CUSTOMER:- KOKOLAKIS
ARCH./ENG.:- CDM SMITH
DESCRIPTION:- WAVE CANOPY BEAM DETAIL
DRAWN:- PBI DATE:- 10-27-2025 CHK.D:- RAG DATE:- 10-27-2025

SHOP BILL	WORK ORDER NO.	DRWG. NO.
	2553	1028

SHIPPING LIST

MATERIAL BILL

ITEM NO	TOTAL QTY	DESCRIPTION	MAJOR MARK	PAINT CODE	TOTAL WEIGHT	ABM NO	UNIT QTY	LENGTH FT.	LENGTH IN.	MINOR MARK	REMARKS	UNIT WEIGHT	GRADE
	ONE	BEAM	1029B	G	3358						Galv	3358	
	1	HSS10x6x1/2			2932		1	60	0 1/4	1029B		2932	A500C
	6	PL5/8x12			187		6	1	2 11/16	p818		31	A572-50
	6	PL5/8x12			192		6	1	3 1/16	p814		32	A572-50
	1	PL1/2x4 15/16			8		1	1	0	p874		8	A572-50
	2	PL3/8x6			13		2	0	10	p42		6	A572-50
	8	PL3/8x5			26		8	0	6	p759		3	A572-50

As in section Section A-A of E119, provide shim plates at all locations where the HSS5x5 bears on the HSS10x6 to facilitate fit-up. Coordinate and provide the shims at all applicable locations. TYP

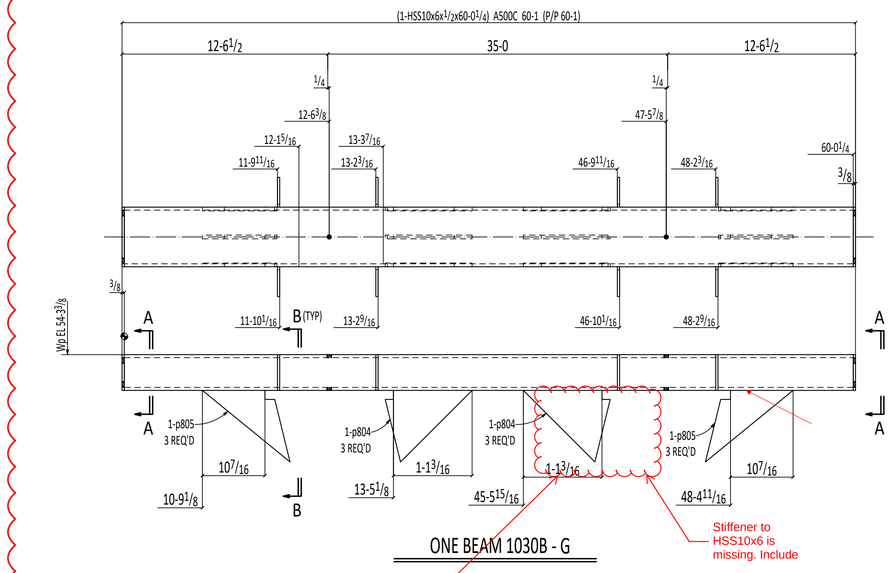

ONE BEAM 1030B - G

Stiffener to HSS10x6 is missing. Include

Ensure that the stiffener plate is properly sized to facilitate adequate connection to the HSS18x18 column (Fit up if one side is shop welded) (TYP)

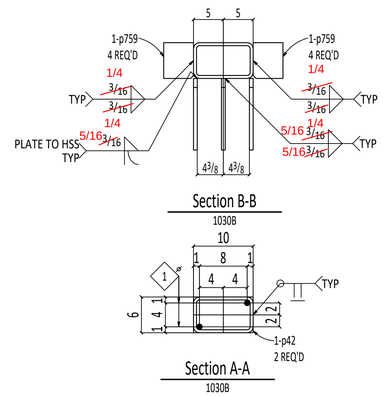

SHIPPING LIST

ITEM NO	TOTAL QTY	DESCRIPTION	MAJOR MARK	PAINT CODE	TOTAL WEIGHT
	ONE	BEAM	1030B	G	3344
	1	HSS10x6x1/2			2932
	6	PL5/gx12			186
	6	PL5/gx12			188
	2	PL3/gx6			13
	8	PL3/gx5			26
		FIELD BOLTS			
	2	3/4 Dia A325N			

Total weight : 3344

MATERIAL BILL

ABM NO	UNIT QTY	LENGTH FT.	LENGTH IN.	MINOR MARK	REMARKS	UNIT WEIGHT	GRADE
	1	60	0 1/4	1030B	Galv	3344	
	6	1	2 9/16	p804		31	A572-50
	6	1	2 11/16	p805		31	A572-50
	2	0	10	p42		6	A572-50
	8	0	6	p759		3	A572-50
	2	0	8 1/2		+1HD WASH GALV		

REFERENCE :----

PAGE TOTALS

REVISION NO.

SPECIAL NOTES:-

1. SEAL ALL WELDS FOR GALVANIZE.
2. ALL VENT HOLES TO BE PLUGGED AFTER GALVANIZING.

MATERIAL:-

ASTM: A36 U.N.O.
S.S.: -----
ALUM.: -----
PIPE: A53 GR.B
TUBES: A500 GR.B
HOLES: 13/16 U.N.O
WELDING: E70XX

MATERIAL PREP.:-

CLEAN: SSPC-SP2
SHOP PAINT: TWO COAT OF STD SHOP PRIMER
GALV: GALVANIZED & PAINTED

GEN. NOTES:-

BUY AMERICAN:
DOMESTIC:
CERT/CONFORMANCE:
CERT/COMPLIANCE:

ALL WIDE FLANGE SHAPES TO BE PER A992-G50

FIELD CONNECTIONS :
HOLES : 13/16" U.N.O
PAINT :

morrow steel Fabricators, Inc.

3620 COPELAND DRIVE
ZEPHYRHILLS, FL. 33542

	PRINTS FOR	DATE	MK	REVISIONS	DATE
			0	RELEASED FOR APPROVAL	Nov 18 2025
			1	RELEASED FOR RE-APPROVAL	Jul 13 2026
			2	RELEASED FOR RE-APPROVAL	Aug 26 2026

STRUCTURE:-PINELLAS SUNCOAST TRANSIT AUTHORITY
LOCATION:- CLEARWATER STATION,CLEARWATER,FL.
DETAILER:- VECTORSHADES LLC
CUSTOMER:- KOKOLAKIS
ARCH./ENG.:- CDM SMITH
DESCRIPTION:- WAVE CANOPY BEAM DETAIL
DRAWN:- PBI DATE:- 10-27-2025 CHK.D:- RAG DATE:- 10-27-2025

SHOP BILL	WORK ORDER NO.	DRWG. NO.
	2553	1030

SHIPPING LIST

MATERIAL BILL

ITEM NO	TOTAL QTY	DESCRIPTION	MAJOR MARK	PAINT CODE	TOTAL WEIGHT	ABM NO	UNIT QTY	LENGTH FT.	LENGTH IN.	MINOR MARK	REMARKS	UNIT WEIGHT	GRADE
	ONE	BEAM	1031B	G	3358						Galv	3358	
	1	HSS10x6x1/2			2932		1	60	0 1/4	1031B		2932	A500C
	6	PL5/gx12			186		6	1	2 5/8	p792		31	A572-50
	6	PL5/gx12			191		6	1	3	p793		32	A572-50
	1	PL3/gx6 1/4			5		1	0	8	p847		5	A572-50
	1	PL3/gx6			5		1	0	8	p846		5	A572-50
	2	PL3/gx6			13		2	0	10	p42		6	A572-50
	8	PL3/gx5			26		8	0	6	p759		3	A572-50
					Total weight : 3358								

As in section Section A-A of E119, provide shim plates at all locations where the HSS5x5 bears on the HSS10x6 to facilitate fit-up. Coordinate and provide the shims at all applicable locations. TYP

What is this additional plate for? That too at only one location

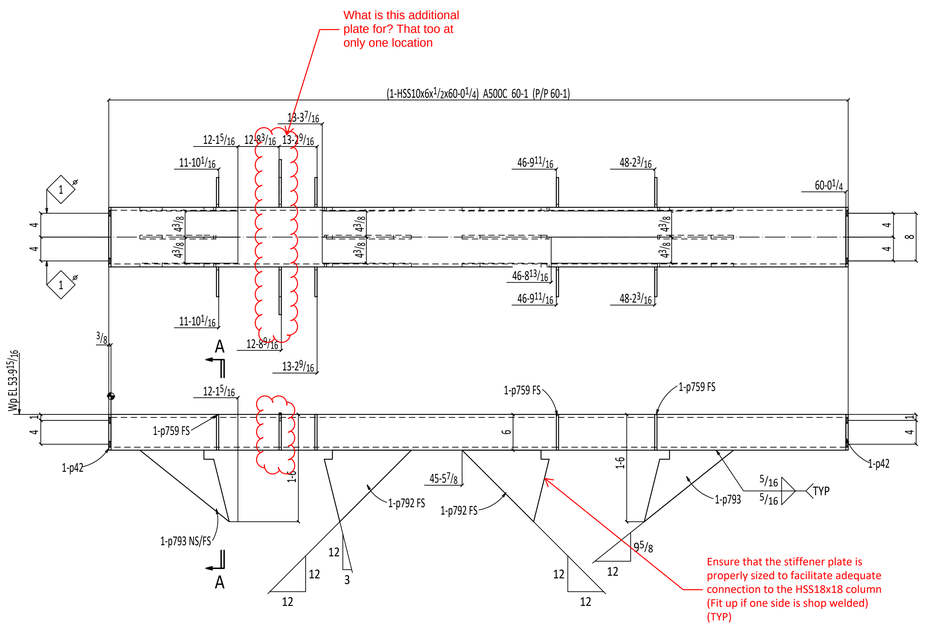

ONE BEAM 1031B-G

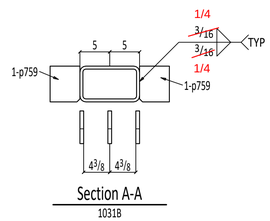

REFERENCE :----

PAGE TOTALS

REVISION NO.

SPECIAL NOTES:-

1. SEAL ALL WELDS FOR GALVANIZE.
2. ALL VENT HOLES TO BE PLUGGED AFTER GALVANIZING.

MATERIAL:-

ASTM: A36 U.N.O.
S. S.: -----
ALUM.: -----
PIPE: A53 GR.B
TUBES: A500 GR.B
HOLES: 13/16 U.N.O
WELDING: E70XX

MATERIAL PREP.:-

CLEAN: SSPC-SP2
SHOP PAINT: TWO COAT OF STD SHOP PRIMER
GALV: GALVANIZED & PAINTED

GEN. NOTES:-

BUY AMERICAN:
DOMESTIC:
CERT/CONFORMANCE:
CERT/COMPLIANCE:

ALL WIDE FLANGE SHAPES TO BE PER A992-G50

FIELD CONNECTIONS :
HOLES : 13/16" U.N.O
PAINT :

morrow steel Fabricators, Inc.

3620 COPELAND DRIVE
ZEPHYRHILLS, FL. 33542

	PRINTS FOR	DATE	MK	REVISIONS	DATE
			0	RELEASED FOR APPROVAL	Nov 18 2025
			1	RELEASED FOR RE-APPROVAL	Jul 13 2026
			2	RELEASED FOR RE-APPROVAL	Aug 26 2026

STRUCTURE:-PINELLAS SUNCOAST TRANSIT AUTHORITY
LOCATION:- CLEARWATER STATION,CLEARWATER,FL.
DETAILER:- VECTORSHADES LLC
CUSTOMER:- KOKOLAKIS
ARCH./ENG.:- CDM SMITH
DESCRIPTION:-WAVE CANOPY BEAM DETAIL
DRAWN:- PBI DATE:-10-27-2025 CHK.D:-RAG DATE:- 10-27-2025

SHOP BILL	WORK ORDER NO.	DRWG. NO.
	2553	1031

Clarify whether these are shim plates. IAs in section Section A-A of E119, provide shim plates at all locations where the HSS5x5 bears on the HSS10x6 to facilitate fit-up. Coordinate and provide the shims at all applicable locations. TYP

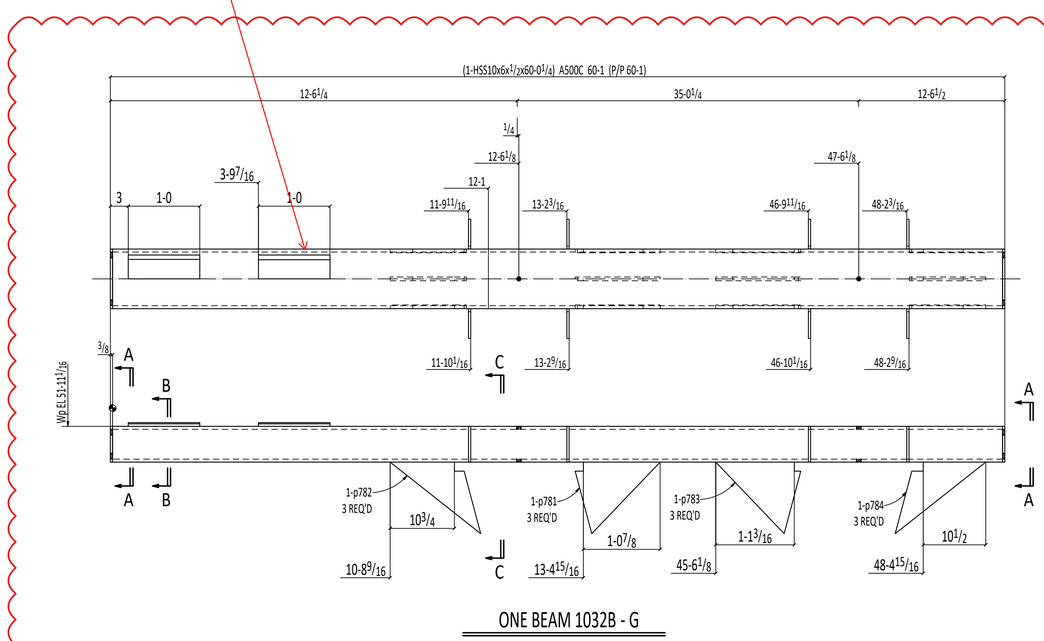

ONE BEAM 1032B - G

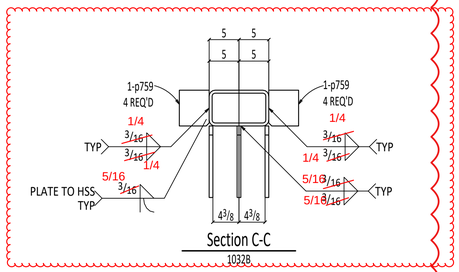

Section C-C
1032B

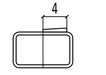

Section B-B
1032B

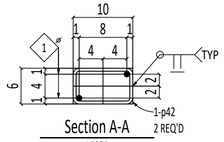

Section A-A
1032B

SHIPPING LIST

ITEM NO	TOTAL QTY	DESCRIPTION	MAJOR MARK	PAINT CODE	TOTAL WEIGHT
	ONE	BEAM	1032B	G	3363
	1	HSS10x6x1/2			2932
	3	PL5/8x12			91
	3	PL5/8x12			91
	3	PL5/8x12			97
	3	PL5/8x12			97
	1	PL5/8x4			9
	1	PL5/8x4			9
	2	PL3/8x6			13
	8	PL3/8x5			26
		FIELD BOLTS			
	2	3/4 Dia A325N			

Total weight : 3363

MATERIAL BILL

ABM NO	UNIT QTY	LENGTH FT.	LENGTH IN.	MINOR MARK	REMARKS	UNIT WEIGHT	GRADE
					Galv	3363	
	1	60	0 1/4	1032B		2932	A500C
	3	1	2 1/4	p781		30	A572-50
	3	1	2 1/4	p783		30	A572-50
	3	1	3 3/16	p782		32	A572-50
	3	1	3 3/16	p784		32	A572-50
	1	1	0	p865		9	A572-50
	1	1	0	p872		9	A572-50
	2	0	10	p42		6	A572-50
	8	0	6	p759		3	A572-50
	2	0	8		+1HD WASH GALV		

REFERENCE :----

PAGE TOTALS

REVISION NO.

SPECIAL NOTES:-

1. SEAL ALL WELDS FOR GALVANIZE.
2. ALL VENT HOLES TO BE PLUGGED AFTER GALVANIZING.

MATERIAL:-

ASTM: A36 U.N.O.
S. S.: -----
ALUM.: -----
PIPE: A53 GR.B
TUBES: A500 GR.B
HOLES: 13/16 U.N.O
WELDING: E70XX

MATERIAL PREP.:-

CLEAN: SSPC-SP2
SHOP PAINT: TWO COAT OF STD SHOP PRIMER
GALV: GALVANIZED & PAINTED

GEN. NOTES:-

BUY AMERICAN:
DOMESTIC:
CERT/CONFORMANCE:
CERT/COMPLIANCE:

ALL WIDE FLANGE SHAPES TO BE PER A992-G50

FIELD CONNECTIONS :
HOLES : 13/16" U.N.O
PAINT :

morrow steel Fabricators, Inc.

3620 COPELAND DRIVE
ZEPHYRHILLS, FL. 33542

	PRINTS FOR	DATE	MK	REVISIONS	DATE
			0	RELEASED FOR APPROVAL	Nov 18 2025
			1	RELEASED FOR RE-APPROVAL	Jul 13 2026
			2	RELEASED FOR RE-APPROVAL	Aug 26 2026

STRUCTURE:- PINELLAS SUNCOAST TRANSIT AUTHORITY
LOCATION:- CLEARWATER STATION,CLEARWATER,FL.
DETAILER:- VECTORSHADES LLC
CUSTOMER:- KOKOLAKIS
ARCH./ENG.:- CDM SMITH
DESCRIPTION:- WAVE CANOPY BEAM DETAIL
DRAWN:- PBI DATE:- 10-27-2025 CHK.D:- RAG DATE:- 10-27-2025

SHOP BILL	WORK ORDER NO.	DRWG. NO.
	2553	1032 1

SHIPPING LIST

MATERIAL BILL

ITEM NO	TOTAL QTY	DESCRIPTION	MAJOR MARK	PAINT CODE	TOTAL WEIGHT	ABM NO	UNIT QTY	LENGTH FT.	LENGTH IN.	MINOR MARK	REMARKS	UNIT WEIGHT	GRADE
	24	MISC	1051M	G	1960						Galv	82	
	24	PL1/2x24			1960		1	2	0	1051M		82	A572-50

Total weight : 1960

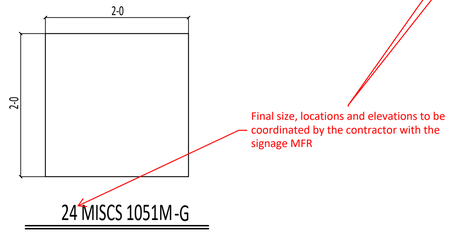

REFERENCE :----

PAGE TOTALS

REVISION NO.

SPECIAL NOTES:-

MATERIAL:-

ASTM: A36 U.N.O.
S. S.: -----
ALUM.: -----
PIPE: A53 GR.B
TUBES: A500 GR.B
HOLES: 13/16 U.N.O
WELDING: E70XX

MATERIAL PREP.:-

CLEAN: SSPC-SP2
SHOP PAINT: TWO COAT OF STD SHOP PRIMER
GALV: GALVANIZED

GEN. NOTES:-

BUY AMERICAN:
DOMESTIC:
CERT/CONFORMANCE:
CERT/COMPLIANCE:

ALL WIDE FLANGE SHAPES TO BE PER A992-G50

FIELD CONNECTIONS :
HOLES : 13/16" U.N.O
PAINT :

morrow steel Fabricators, Inc.

3620 COPELAND DRIVE
ZEPHYRHILLS, FL. 33542

	PRINTS FOR	DATE	MK	REVISIONS	DATE
			0	RELEASED FOR APPROVAL	Nov 18 2025
			1	RELEASED FOR RE-APPROVAL	Jul 13 2026
			2	RELEASED FOR RE-APPROVAL	Aug 26 2026

STRUCTURE:-PINELLAS SUNCOAST TRANSIT AUTHORITY
LOCATION:- CLEARWATER STATION,CLEARWATER,FL.
DETAILER:- VECTORSHADES LLC
CUSTOMER:- KOKOLAKIS
ARCH./ENG.:- CDM SMITH
DESCRIPTION:-WAVE CANOPY MISC DETAIL
DRAWN:- PBI DATE:-10-27-2025 CHK.D:-RAG DATE:- 10-27-2025

SHOP BILL	WORK ORDER NO.	DRWG. NO.
	2553	1051 ⚠1

SHIPPING LIST

MATERIAL BILL

ITEM NO	TOTAL QTY	DESCRIPTION	MAJOR MARK	PAINT CODE	TOTAL WEIGHT	ABM NO	UNIT QTY	LENGTH FT.	LENGTH IN.	MINOR MARK	REMARKS	UNIT WEIGHT	GRADE
	12	MISC	1052M	G	61						Galv	5	
	12	PL 1/2x6			61		1	0	6	1052M		5	A572-50

Total weight : 61

Final size, locations and elevations to be coordinated by the contractor with the lighiting MFR

12 MISCS 1052M-G

REFERENCE :----

PAGE TOTALS

REVISION NO.

SPECIAL NOTES:-

MATERIAL:-

ASTM: A36 U.N.O.
S. S.: -----
ALUM.: -----
PIPE: A53 GR.B
TUBES: A500 GR.B
HOLES: 13/16 U.N.O
WELDING: E70XX

MATERIAL PREP.:-

CLEAN: SSPC-SP2
SHOP PAINT: TWO COAT OF STD SHOP PRIMER
GALV: GALVANIZED

GEN. NOTES:-

BUY AMERICAN:
DOMESTIC:
CERT/CONFORMANCE:
CERT/COMPLIANCE:

ALL WIDE FLANGE SHAPES TO BE PER A992-G50

FIELD CONNECTIONS :
HOLES : 13/16" U.N.O
PAINT :

morrow steel Fabricators, Inc.

3620 COPELAND DRIVE
ZEPHYRHILLS, FL. 33542

	PRINTS FOR	DATE	MK	REVISIONS	DATE
			0	RELEASED FOR APPROVAL	Nov 18 2025
			1	RELEASED FOR RE-APPROVAL	Jul 13 2026
			2	RELEASED FOR RE-APPROVAL	Aug 26 2026

STRUCTURE:- PINELLAS SUNCOAST TRANSIT AUTHORITY
LOCATION:- CLEARWATER STATION,CLEARWATER,FL.
DETAILER:- VECTORSHADES LLC
CUSTOMER:- KOKOLAKIS
ARCH./ENG.:- CDM SMITH
DESCRIPTION:- WAVE CANOPY MISC DETAIL
DRAWN:- PBI DATE:-10-27-2025 CHK.D:-RAG DATE:- 10-27-2025

SHOP BILL	WORK ORDER NO.	DRWG. NO.
	2553	1052

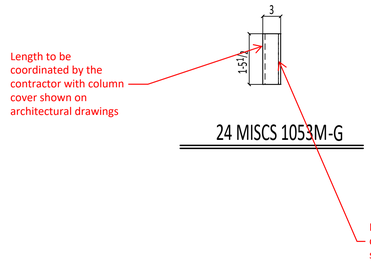

SHIPPING LIST

MATERIAL BILL

ITEM NO	TOTAL QTY	DESCRIPTION	MAJOR MARK	PAINT CODE	TOTAL WEIGHT	ABM NO	UNIT QTY	LENGTH FT.	LENGTH IN.	MINOR MARK	REMARKS	UNIT WEIGHT	GRADE
	24	MISC	1053M	G	426						Galv	18	
	24	HSS3x3x$^{3}/_{8}$			426		1	1	$5^{1}/_{2}$	1053M		18	A500C

SHIPPING LIST

MATERIAL BILL

ITEM NO	TOTAL QTY	DESCRIPTION	MAJOR MARK	PAINT CODE	TOTAL WEIGHT	ABM NO	UNIT QTY	LENGTH FT.	LENGTH IN.	MINOR MARK	REMARKS	UNIT WEIGHT	GRADE
	24	MISC	1054M	G	183						Galv	8	
	24	HSS3x3x$^{3}/_{8}$			183		1	0	$7^{1}/_{2}$	1054M		8	A500C

Total weight : 183

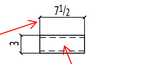

Length to be coordinated by the contractor with column cover shown on architectural drawings

24 MISCS 1054M -G

Final size, locations and elevations to be coordinated by the contractor with the signage MFR

REFERENCE :----

PAGE TOTALS

REVISION NO.

SPECIAL NOTES:-

MATERIAL:-

ASTM: A36 U.N.O.
S. S.: -----
ALUM.: -----
PIPE: A53 GR.B
TUBES: A500 GR.B
HOLES: $^{13}/_{16}$ U.N.O
WELDING: E70XX

MATERIAL PREP.:-

CLEAN: SSPC-SP2
SHOP PAINT: TWO COAT OF STD SHOP PRIMER
GALV: GALVANIZED

GEN. NOTES:-

BUY AMERICAN:
DOMESTIC:
CERT/CONFORMANCE:
CERT/COMPLIANCE:

ALL WIDE FLANGE SHAPES TO BE PER A992-G50

FIELD CONNECTIONS :
HOLES : $^{13}/_{16}$" U.N.O
PAINT :

morrow steel Fabricators, Inc.

3620 COPELAND DRIVE
ZEPHYRHILLS, FL. 33542

	PRINTS FOR	DATE	MK	REVISIONS	DATE
			0	RELEASED FOR APPROVAL	Nov 18 2025
			1	RELEASED FOR RE-APPROVAL	Jul 13 2026
			2	RELEASED FOR RE-APPROVAL	Aug 26 2026

STRUCTURE:- PINELLAS SUNCOAST TRANSIT AUTHORITY
LOCATION:- CLEARWATER STATION,CLEARWATER,FL.
DETAILER:- VECTORSHADES LLC
CUSTOMER:- KOKOLAKIS
ARCH./ENG.:- CDM SMITH
DESCRIPTION:- WAVE CANOPY MISC DETAIL
DRAWN:- PBI DATE:- 10-27-2025 CHK.D:- RAG DATE:- 10-27-2025

SHOP BILL	WORK ORDER NO.	DRWG. NO.
	2553	1054 ⚠1

SHIPPING LIST

ITEM NO	TOTAL QTY	DESCRIPTION	MAJOR MARK	PAINT CODE	TOTAL WEIGHT	ABM NO
	12	MISC	1055M	G	126	
	12	HSS3x3x$^{3}/_{8}$			126	

Total weight : 126

MATERIAL BILL

UNIT QTY	LENGTH FT.	LENGTH IN.	MINOR MARK	REMARKS	UNIT WEIGHT	GRADE
				Galv	10	
1	0	$10^{3}/_{8}$	1055M		10	A500C

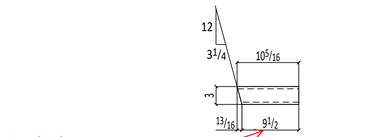

12 MISCS 1055M-G

Length to be coordinated by the contractor with column cover shown on architectural drawings

Final size, locations and elevations to be coordinated by the contractor with the lighiting MFR

REFERENCE :----

PAGE TOTALS

REVISION NO.

SPECIAL NOTES:-

MATERIAL:-

ASTM:	A36 U.N.O.
S. S.:	-----
ALUM.:	-----
PIPE:	A53 GR.B
TUBES:	A500 GR.B
HOLES:	$^{13}/_{16}$ U.N.O
WELDING:	E70XX

MATERIAL PREP.:-

CLEAN:	SSPC-SP2
SHOP PAINT:	TWO COAT OF STD SHOP PRIMER
GALV:	GALVANIZED

GEN. NOTES:-

BUY AMERICAN:

DOMESTIC:

CERT/CONFORMANCE:

CERT/COMPLIANCE:

ALL WIDE FLANGE SHAPES TO BE PER A992-G50

FIELD CONNECTIONS :

HOLES : $^{13}/_{16}$" U.N.O

PAINT :

morrow steel Fabricators, Inc.

3620 COPELAND DRIVE
ZEPHYRHILLS, FL. 33542

	PRINTS FOR	DATE	MK	REVISIONS	DATE
			0	RELEASED FOR APPROVAL	Nov 18 2025
			1	RELEASED FOR RE-APPROVAL	Jul 13 2026
			2	RELEASED FOR RE-APPROVAL	Aug 26 2026

STRUCTURE:-PINELLAS SUNCOAST TRANSIT AUTHORITY
LOCATION:- CLEARWATER STATION,CLEARWATER,FL.
DETAILER:- VECTORSHADES LLC
CUSTOMER:- KOKOLAKIS
ARCH./ENG.:- CDM SMITH
DESCRIPTION:-WAVE CANOPY MISC DETAIL
DRAWN:- PBI DATE:-10-27-2025 CHK.D:-RAG DATE:- 10-27-2025

SHOP BILL	WORK ORDER NO.	DRWG. NO.
	2553	1055 ⚠1

SHIPPING LIST

MATERIAL BILL

ITEM NO	TOTAL QTY	DESCRIPTION	MAJOR MARK	PAINT CODE	TOTAL WEIGHT	ABM NO	UNIT QTY	LENGTH FT.	LENGTH IN.	MINOR MARK	REMARKS	UNIT WEIGHT	GRADE
	2	MISC	1056M	G	60						Galv	30	
	2	L4x4x1/4			48		1	3	7 11/16	1056M		24	A572-50
	4	L5x3 1/2x1/4			12		2	0	5	a1083		3	A572-50

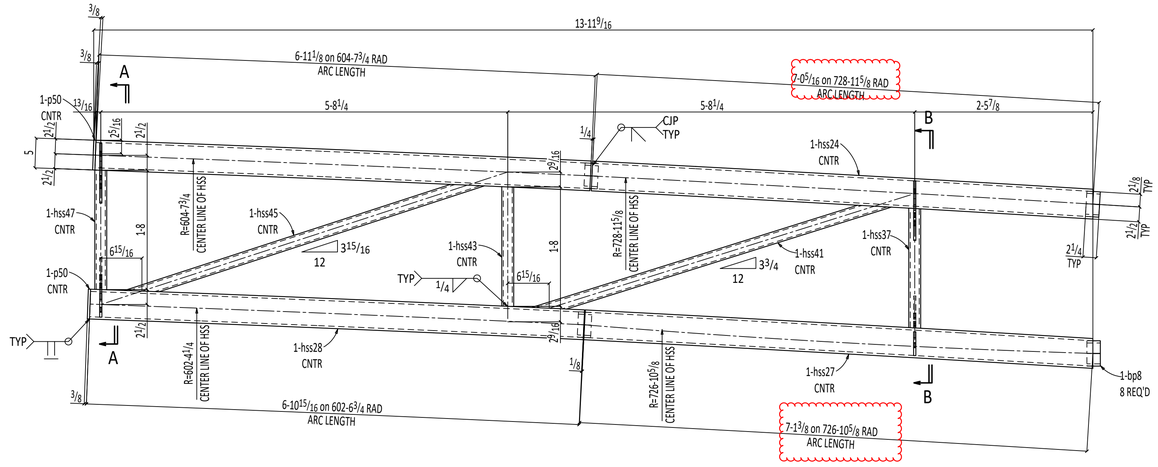

ONE TRUSS 1176TR-G

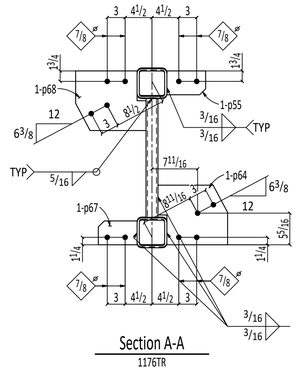

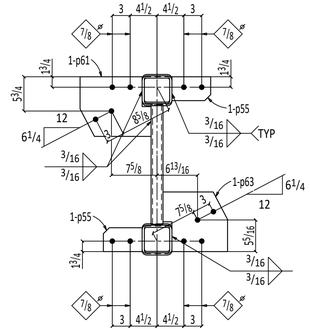

NOTE:
SHOP DRAWINGS HAVE BEEN SUBMITTED FOR ONE REPRESENTATIVE TRUSS.
PLEASE CONSIDER THIS DRAWING AS TYPICAL FOR ALL SIMILAR TRUSSES AND PROVIDE YOUR COMMENTS, IF ANY.

SHIPPING LIST

MATERIAL BILL

ITEM NO	TOTAL QTY	DESCRIPTION	MAJOR MARK	PAINT CODE	TOTAL WEIGHT	ABM NO	UNIT QTY	LENGTH FT.	LENGTH IN.	MINOR MARK	REMARKS	UNIT WEIGHT	GRADE
	ONE	TRUSS	1176TR	G	789						Galv	789	
	1	HSS5x5x3/8			155		1	6	11 1/8	1176TR		155	A500C
	1	HSS5x5x3/8			159		1	7	1 9/16	hss391		159	A500C
	1	HSS5x5x3/8			157		1	7	0 5/16	hss162		157	A500C
	1	HSS5x5x3/8			155		1	6	10 15/16	hss28		155	A500C
	1	HSS2x2x1/4			28		1	5	2 13/16	hss45		28	A500C
	1	HSS2x2x1/4			28		1	5	2 9/16	hss41		28	A500C
	1	HSS2x2x1/4			9		1	1	8 1/8	hss37		9	A500C
	1	HSS2x2x1/4			9		1	1	8 1/8	hss43		9	A500C
	1	HSS2x2x1/4			9		1	1	8 1/16	hss47		9	A500C
	1	PL3/8x10			13		1	0	11 7/8	p61		13	A572-50
	1	PL3/8x10			13		1	0	11 13/16	p68		13	A572-50
	1	PL3/8x10			12		1	0	11 11/16	p64		12	A572-50
	1	PL3/8x10			12		1	0	10 13/16	p63		12	A572-50
	2	PL3/8x5			5		2	0	5	p50		3	A572-50
	3	PL3/8x4			8		3	0	6 1/2	p55		3	A572-50
	1	PL3/8x4			3		1	0	6 1/2	p67		3	A572-50
	8	BPL3/8x2 1/4			14		8	0	7 5/16	bp8	BENT	2	A572-50

Total weight : 789

REFERENCE :----

PAGE TOTALS

REVISION NO.

SPECIAL NOTES:-

1. SEAL ALL WELDS FOR GALVANIZE.
2. ALL VENT HOLES TO BE PLUGGED AFTER GALVANIZING.

MATERIAL:-

ASTM:	A36 U.N.O.
S. S.:	-----
ALUM.:	-----
PIPE:	A53 GR.B
TUBES:	A500 GR.B
HOLES:	13/16 U.N.O
WELDING:	E70XX

MATERIAL PREP.:-

CLEAN:	SSPC-SP2
SHOP PAINT:	TWO COAT OF STD SHOP PRIMER
GALV:	GALVANIZED & PAINTED

GEN. NOTES:-

BUY AMERICAN:	
DOMESTIC:	
CERT/CONFORMANCE:	
CERT/COMPLIANCE:	

ALL WIDE FLANGE SHAPES TO BE PER A992-G50

FIELD CONNECTIONS :
HOLES : 13/16" U.N.O
PAINT :

morrow steel Fabricators, Inc.

3620 COPELAND DRIVE
ZEPHYRHILLS, FL. 33542

	PRINTS FOR	DATE	MK	REVISIONS	DATE
			0	RELEASED FOR APPROVAL	Nov 18 2025
			1	RELEASED FOR RE-APPROVAL	Jul 13 2026
			2	RELEASED FOR RE-APPROVAL	Aug 26 2026

STRUCTURE:- PINELLAS SUNCOAST TRANSIT AUTHORITY
LOCATION:- CLEARWATER STATION,CLEARWATER,FL.
DETAILER:- VECTORSHADES LLC
CUSTOMER:- KOKOLAKIS
ARCH./ENG.:- CDM SMITH
DESCRIPTION:- WAVE CANOPY TRUSS DETAIL
DRAWN:- PBI DATE:- 10-27-2025 CHK.D:- RAG DATE:- 10-27-2025

SHOP BILL	WORK ORDER NO.	DRWG. NO.
	2553	1176

SHIPPING LIST

ITEM NO	TOTAL QTY	DESCRIPTION	MAJOR MARK	PAINT CODE	TOTAL WEIGHT
	ONE	BEAM	1185TR	G	2377
	1	HSS5x5x3/8			336
	1	HSS5x5x3/8			339
	1	HSS5x5x3/8			228
	1	HSS5x5x3/8			224
	1	HSS5x5x3/8			223
	1	HSS5x5x3/8			221
	1	HSS5x5x3/8			67
	1	HSS5x5x3/8			64
	1	HSS3x3x3/8			21
	1	HSS3x3x1/4			45
	1	HSS3x3x1/4			45
	1	HSS3x3x1/4			45
	1	HSS3x3x1/4			45
	1	HSS3x3x1/4			44
	1	HSS3x3x1/4			43
	1	HSS3x3x1/4			43
	3	HSS3x3x1/4			45
	1	HSS3x3x1/4			15
	2	HSS3x3x1/4			30
	1	HSS3x3x1/4			15
	1	PL1/2x15 5/16			43
	1	PL1/2x15 5/16			38
	2	PL1/2x7			15
	2	PL3/8x10			25
	1	PL3/8x10			12
	2	PL3/8x10			22
	1	PL3/8x10			11
	1	PL3/8x10			12
	1	PL3/8x10			11
	2	PL3/8x5			5
	8	PL3/8x4			21
	16	BPL3/8x2 1/4			38
				Total weight :	2377

MATERIAL BILL

ITEM NO	UNIT QTY	LENGTH FT.	LENGTH IN.	MINOR MARK	REMARKS	UNIT WEIGHT	GRADE
					Galv	2377	
	1	15	0 3/8	1185TR	B1E	336	A500C
	1	15	2	hss377		339	A500C
	1	10	2 1/16	hss376		228	A500C
	1	10	0	hss385		224	A500C
	1	9	11 7/8	hss372		223	A500C
	1	9	10 5/16	hss379		221	A500C
	1	3	0 1/16	hss392		67	A500C
	1	2	10 1/4	hss393		64	A500C
	1	1	8 1/4	hss283		21	A500C
	1	5	0 7/8	hss284		45	A500C
	1	5	0 7/8	hss85		45	A500C
	1	5	0 7/8	hss86		45	A500C
	1	5	0 13/16	hss73		45	A500C
	1	4	11 3/8	hss30		44	A500C
	1	4	10 1/4	hss292		43	A500C
	1	4	10 1/8	hss293		43	A500C
	3	1	8 5/16	hss60		15	A500C
	1	1	8 1/4	hss59		15	A500C
	2	1	8 1/4	hss61		15	A500C
	1	1	8 3/16	hss298		15	A500C
	1	1	7 5/8	p680		43	A572-50
	1	1	5 5/8	p688		38	A572-50
	2	0	7 1/2	p469		7	A572-50
	2	0	11 9/16	p233		12	A572-50
	1	0	11 9/16	p234		12	A572-50
	2	0	10 7/16	p89		11	A572-50
	1	0	10 7/16	p235		11	A572-50
	1	0	11 1/2	p237		12	A572-50
	1	0	10 3/8	p236		11	A572-50
	2	0	5	p7		3	A572-50
	8	0	6 1/2	p55		3	A572-50
	16	0	3 5/16	bp8	BENT	2	A572-50

We are not sure why these vertical HSS members are sloped. They should remain vertical and straight, regardless of the truss slope

The 1/4" weld applies to the HSS2×2×1/4-to-HSS5×5 and HSS3×3×1/4-to-HSS5×5 connections. For the HSS3×3×3/8-to-HSS5×5 connection, provide a 5/16" weld. Refer to Detail B/S-CP-8

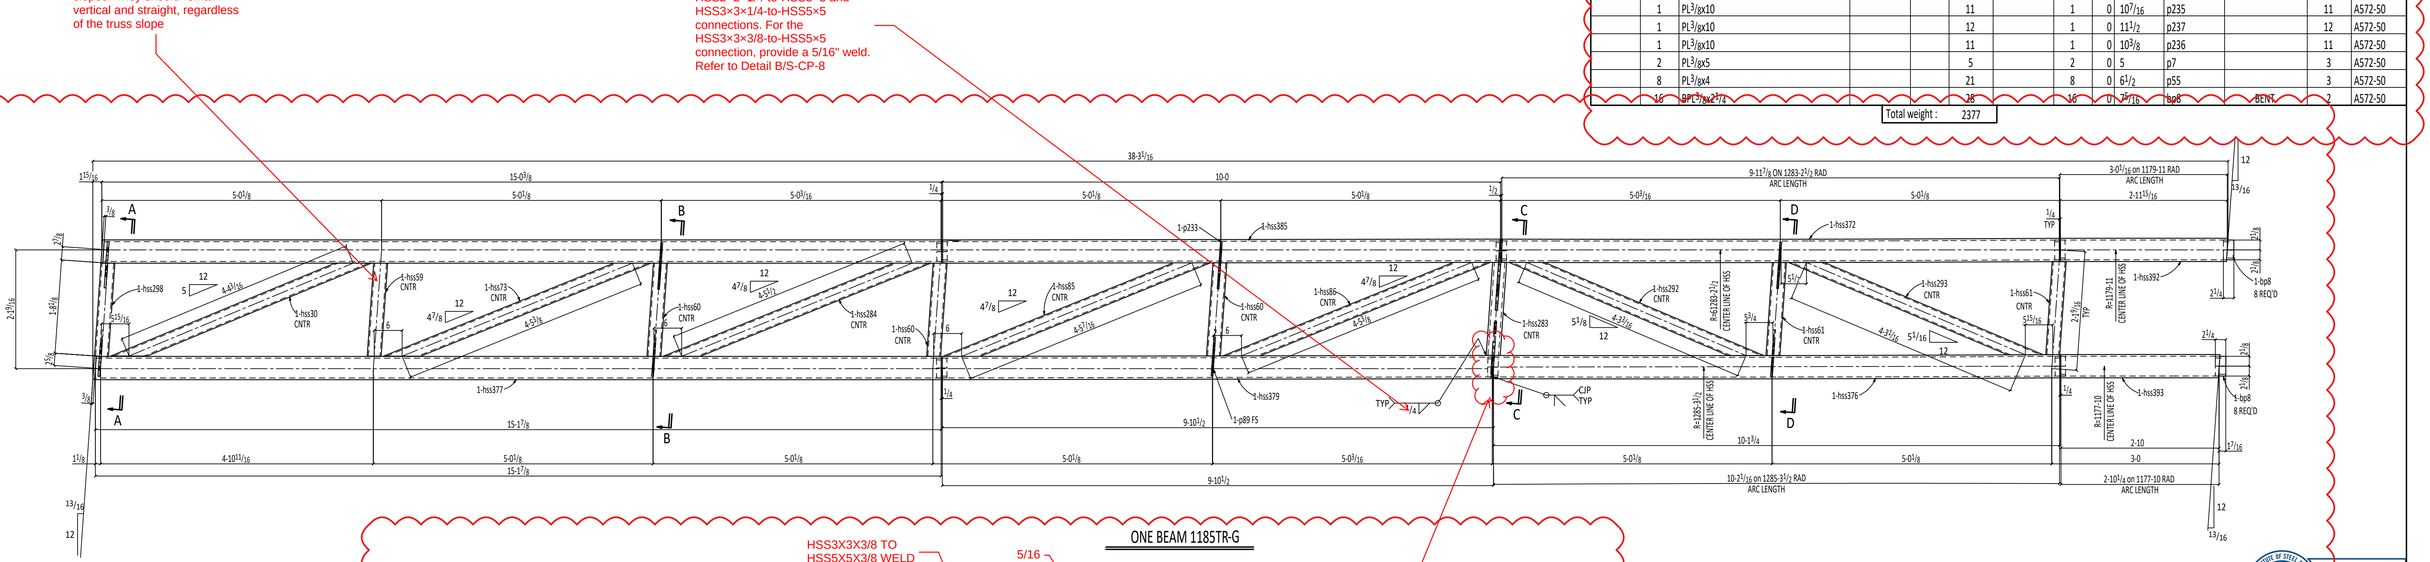

ONE BEAM 1185TR-G

HSS3X3X3/8 TO HSS5X5X3/8 WELD

5/16

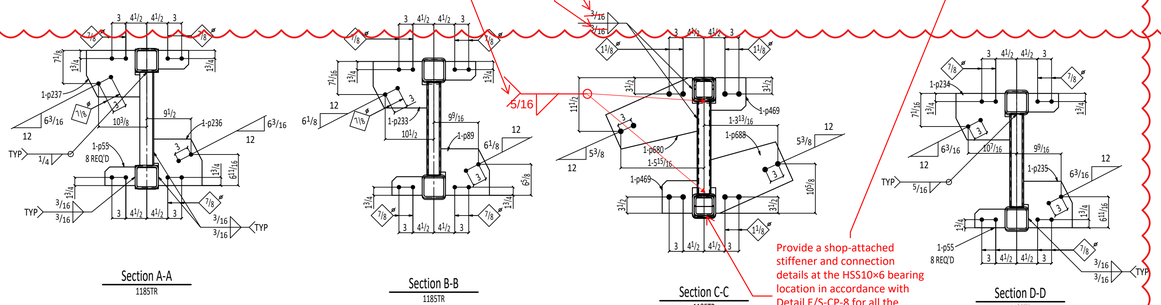

Provide a shop-attached stiffener and connection details at the HSS10×6 bearing location in accordance with Detail E/S-CP-8 for all the longitudinal trusses RT-1. See comments on E118 for further clarification

NOTE:
SHOP DRAWINGS HAVE BEEN SUBMITTED FOR ONE REPRESENTATIVE TRUSS.
PLEASE CONSIDER THIS DRAWING AS TYPICAL FOR ALL SIMILAR TRUSSES AND PROVIDE YOUR COMMENTS, IF ANY.

REFERENCE :----

PAGE TOTALS | REVISION NO.

SPECIAL NOTES:-

1. SEAL ALL WELDS FOR GALVANIZE.
2. ALL VENT HOLES TO BE PLUGGED AFTER GALVANIZING.

MATERIAL:-

ASTM:	A36 U.N.O.
S. S.:	-----
ALUM.:	-----
PIPE:	A53 GR.B
TUBES:	A500 GR.B
HOLES:	13/16 U.N.O
WELDING:	E70XX

MATERIAL PREP.:-

CLEAN:	SSPC-SP2
SHOP PAINT:	TWO COAT OF STD SHOP PRIMER
GALV:	GALVANIZED & PAINTED

GEN. NOTES:-

BUY AMERICAN:
DOMESTIC:
CERT/CONFORMANCE:
CERT/COMPLIANCE:

ALL WIDE FLANGE SHAPES TO BE PER A992-G50

FIELD CONNECTIONS :
HOLES : 13/16" U.N.O
PAINT :

morrow steel Fabricators, Inc.

3620 COPELAND DRIVE
ZEPHYRHILLS, FL. 33542

	PRINTS FOR	DATE	MK	REVISIONS	DATE
			0	RELEASED FOR APPROVAL	Jul 13 2026
			1	RELEASED FOR RE-APPROVAL	Aug 26 2026

STRUCTURE:-PINELLAS SUNCOAST TRANSIT AUTHORITY
LOCATION:- CLEARWATER STATION,CLEARWATER,FL.
DETAILER:- VECTORSHADES LLC
CUSTOMER:- KOKOLAKIS
ARCH./ENG.:- CDM SMITH
DESCRIPTION:-WAVE CANOPY TRUSS DETAIL
DRAWN:- PBI DATE:-10-27-2025 CHK.D:-RAG DATE:- 10-27-2025

SHOP BILL	WORK ORDER NO.	DRWG. NO.
	2553	1185

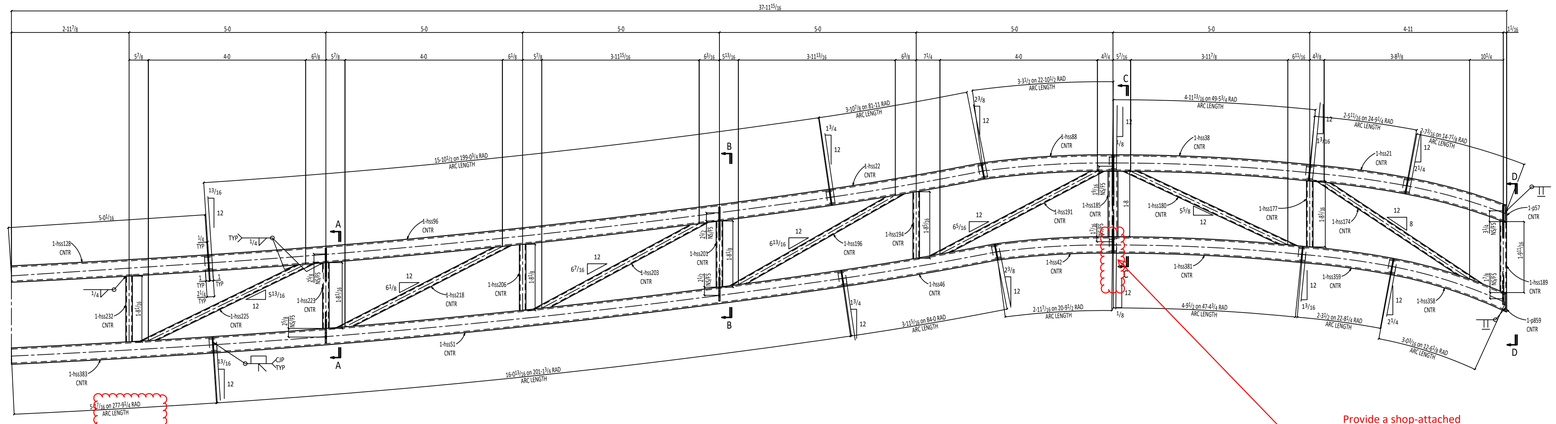

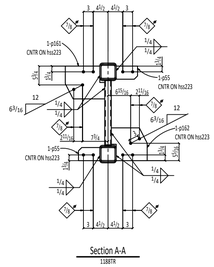
Section A-A
1188TR

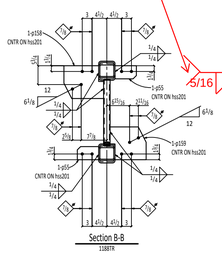
Section B-B
1188TR

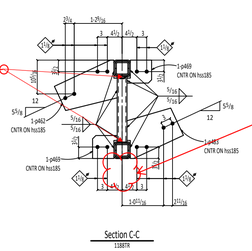
Section C-C
1188TR

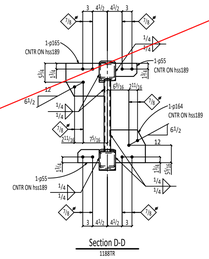
Section D-D
1188TR

NOTE:
SHOP DRAWINGS HAVE BEEN SUBMITTED FOR ONE REPRESENTATIVE TRUSS.
PLEASE CONSIDER THIS DRAWING AS TYPICAL FOR ALL SIMILAR TRUSSES AND PROVIDE YOUR COMMENTS, IF ANY.

SHIPPING LIST

ITEM NO	TOTAL QTY	DESCRIPTION	MAJOR MARK	PAINT CODE	TOTAL WEIGHT	ABM NO
	ONE	TRUSS	1188TR	G	2221	
	1	HSS5x5x3/8			61	
	1	HSS5x5x3/8			360	
	1	HSS5x5x3/8			355	
	1	HSS5x5x3/8			115	
	1	HSS5x5x3/8			112	
	1	HSS5x5x3/8			112	
	1	HSS5x5x3/8			108	
	1	HSS5x5x3/8			88	
	1	HSS5x5x3/8			88	
	1	HSS5x5x3/8			75	
	1	HSS5x5x3/8			71	
	1	HSS5x5x3/8			67	
	1	HSS5x5x3/8			56	
	1	HSS5x5x3/8			52	
	1	HSS3x3x3/8			20	
	1	HSS2x2x1/4			27	
	1	HSS2x2x1/4			27	
	1	HSS2x2x1/4			27	
	1	HSS2x2x1/4			27	
	1	HSS2x2x1/4			27	
	1	HSS2x2x1/4			27	
	1	HSS2x2x1/4			26	
	1	HSS2x2x1/4			26	
	1	HSS2x2x1/4			10	
	1	HSS2x2x1/4			9	
	1	HSS2x2x1/4			9	
	1	HSS2x2x1/4			9	
	1	HSS2x2x1/4			9	
	1	HSS2x2x1/4			9	
	1	HSS2x2x1/4			9	
	1	PL1/2x153/8			42	
	1	PL1/2x153/8			38	
	2	PL1/2x7			15	
	1	PL3/8x10			13	
	1	PL3/8x10			13	
	1	PL3/8x10			12	
	1	PL3/8x10			12	
	1	PL3/8x10			11	
	1	PL3/8x10			12	
	1	PL3/8x5			3	
	1	PL3/8x5			3	
	6	PL3/8x4			16	
	24	BPL3/8x21/4			42	

Total weight : 2221

MATERIAL BILL

ITEM NO	UNIT QTY	LENGTH FT.	LENGTH IN.	MINOR MARK	REMARKS	UNIT WEIGHT	GRADE
	1	2	8 9/16	1188TR		61	A500C
	1	16	1	hss51		360	A500C
	1	15	10 11/16	hss96		355	A500C
	1	5	1 5/8	hss383	B1E	115	A500C
	1	5	0 1/4	hss128	B1E	112	A500C
	1	5	0 1/16	hss38	B1E	112	A500C
	1	4	9 13/16	hss381	B1E	108	A500C
	1	3	11 7/16	hss46		88	A500C
	1	3	11	hss22		88	A500C
	1	3	4 1/16	hss88	B1E	75	A500C
	1	3	1 15/16	hss358		71	A500C
	1	2	11 15/16	hss42	B1E	67	A500C
	1	2	6	hss21	B1E	56	A500C
	1	2	3 13/16	hss359	B1E	52	A500C
	1	1	8	hss185		20	A500C
	1	5	0 1/4	hss196		27	A500C
	1	4	11 9/16	hss203		27	A500C
	1	4	11 7/16	hss174		27	A500C
	1	4	11 5/16	hss191		27	A500C
	1	4	10 7/8	hss218		27	A500C
	1	4	10 5/16	hss225		26	A500C
	1	4	9 7/8	hss180		26	A500C
	1	1	10 5/16	hss189		10	A500C
	1	1	8 5/8	hss194		9	A500C
	1	1	8 7/16	hss201		9	A500C
	1	1	8 5/16	hss206		9	A500C
	1	1	8 1/4	hss177		9	A500C
	1	1	8 1/4	hss223		9	A500C
	1	1	8 1/8	hss232		9	A500C
	1	1	7 1/8	p462		42	A572-50
	1	1	5 3/16	p483		38	A572-50
	2	0	7 1/2	p469		7	A572-50
	1	1	0 1/16	p161		13	A572-50
	1	1	0 1/16	p158		13	A572-50
	1	0	11	p159		12	A572-50
	1	0	11 5/8	p165		12	A572-50
	1	0	10 9/16	p164		11	A572-50
	1	0	10 15/16	p162		12	A572-50
	1	0	5 5/8	p859		3	A572-50
	1	0	5 3/8	p57		3	A572-50
	6	0	6 1/2	p55		3	A572-50
	24	0	7 5/16	bp8	BENT	2	A572-50

REFERENCE :----

PAGE TOTALS

REVISION NO.

SPECIAL NOTES:-

1. SEAL ALL WELDS FOR GALVANIZE.
2. ALL VENT HOLES TO BE PLUGGED AFTER GALVANIZING.

MATERIAL:-

ASTM: A36 U.N.O.
S. S.: -----
ALUM.: -----
PIPE: A53 GR.B
TUBES: A500 GR.B
HOLES: 13/16 U.N.O
WELDING: E70XX

MATERIAL PREP.:-

CLEAN: SSPC-SP2
SHOP PAINT: TWO COAT OF STD SHOP PRIMER
GALV: GALVANIZED & PAINTED

GEN. NOTES:-

BUY AMERICAN:
DOMESTIC:
CERT/CONFORMANCE:
CERT/COMPLIANCE:

ALL WIDE FLANGE SHAPES TO BE PER A992-G50

FIELD CONNECTIONS :
HOLES : 13/16" U.N.O
PAINT :

morrow steel Fabricators, Inc.

3620 COPELAND DRIVE
ZEPHYRHILLS, FL. 33542

	PRINTS FOR	DATE	MK	REVISIONS	DATE
			0	RELEASED FOR APPROVAL	Jul 13 2026
			1	RELEASED FOR RE-APPROVAL	Aug 26 2026

STRUCTURE:-PINELLAS SUNCOAST TRANSIT AUTHORITY
LOCATION:- CLEARWATER STATION,CLEARWATER,FL.
DETAILER:- VECTORSHADES LLC
CUSTOMER:- KOKOLAKIS
ARCH./ENG.:- CDM SMITH
DESCRIPTION:- WAVE CANOPY TRUSS DETAIL
DRAWN:- PBI DATE:- 10-27-2025 CHK.D:-RAG DATE:- 10-27-2025

SHOP BILL	WORK ORDER NO.	DRWG. NO.
	2553	1188

NOTE:
SHOP DRAWINGS HAVE BEEN SUBMITTED FOR ONE REPRESENTATIVE TRUSS.
PLEASE CONSIDER THIS DRAWING AS TYPICAL FOR ALL SIMILAR TRUSSES AND PROVIDE YOUR COMMENTS, IF ANY.

SHIPPING LIST

MATERIAL BILL

ITEM NO	TOTAL QTY	DESCRIPTION	MAJOR MARK	PAINT CODE	TOTAL WEIGHT	ABM NO	UNIT QTY	LENGTH FT.	LENGTH IN.	MINOR MARK	REMARKS	UNIT WEIGHT	GRADE
	ONE	TRUSS	1191TR	G	2266						Galv	2266	
	1	HSS5x5x3/8			287		1	12	10	1191TR		287	A500C
	1	HSS5x5x3/8			291		1	12	11 15/16	hss65		291	A500C
	1	HSS5x5x3/8			258		1	11	6 3/16	hss133	B1E	258	A500C
	1	HSS5x5x3/8			257		1	11	5 3/4	hss384	B1E	257	A500C
	1	HSS5x5x3/8			180		1	8	0 5/16	hss145	B1E	180	A500C
	1	HSS5x5x3/8			176		1	7	10 3/16	hss387	B1E	176	A500C
	1	HSS5x5x3/8			173		1	7	8 13/16	hss67		173	A500C
	1	HSS5x5x3/8			172		1	7	8 1/8	hss136		172	A500C
	1	HSS3x3x3/8			21		1	1	8 5/16	hss279		21	A500C
	1	HSS2x2x1/4			26		1	4	10 1/2	hss273		26	A500C
	1	HSS2x2x1/4			26		1	4	10 1/16	hss268		26	A500C
	1	HSS2x2x1/4			26		1	4	9 5/16	hss262		26	A500C
	1	HSS2x2x1/4			26		1	4	8 11/16	hss249		26	A500C
	1	HSS2x2x1/4			25		1	4	8 9/16	hss257		25	A500C
	1	HSS2x2x1/4			25		1	4	8 3/16	hss241		25	A500C
	1	HSS2x2x1/4			25		1	4	7 3/16	hss92		25	A500C
	1	HSS2x2x1/4			9		1	1	8 1/4	hss101	B1E	9	A500C
	1	HSS2x2x1/4			9		1	1	8 3/16	hss269		9	A500C
	1	HSS2x2x1/4			9		1	1	8 1/8	hss265		9	A500C
	1	HSS2x2x1/4			9		1	1	8 1/8	hss240		9	A500C
	1	HSS2x2x1/4			9		1	1	8 1/16	hss253		9	A500C
	1	HSS2x2x1/4			9		1	1	8 1/16	hss244		9	A500C
	1	HSS2x2x1/4			9		1	1	8	hss259		9	A500C
	1	PL1/2x15 3/8			42		1	1	7 1/16	p564		42	A572-50
	1	PL1/2x15 3/8			37		1	1	5 1/8	p553		37	A572-50
	2	PL1/2x7			15		2	0	7 1/2	p469		7	A572-50
	1	PL3/8x10			13		1	0	11 15/16	p215		13	A572-50
	1	PL3/8x10			13		1	1	0 1/16	p213		13	A572-50
	1	PL3/8x10			13		1	0	11 7/8	p61		13	A572-50
	1	PL3/8x10			12		1	0	10 15/16	p216		12	A572-50
	1	PL3/8x10			12		1	0	10 7/8	p214		12	A572-50
	1	PL3/8x10			12		1	0	10 13/16	p63		12	A572-50
	6	PL3/8x4			16		6	0	6 1/2	p55		3	A572-50
	16	BPL3/8x2 1/4			28		16	0	7 5/16	bp8	BENT	2	A572-50

Total weight : 2266

The 1/4" weld applies to the HSS2×2×1/4-to-HSS5×5 and HSS3×3×1/4-to-HSS5×5 connections. For the HSS3×3×3/8-to-HSS5×5 connection, provide a 5/16" weld. Refer to Detail B/S-CP-8

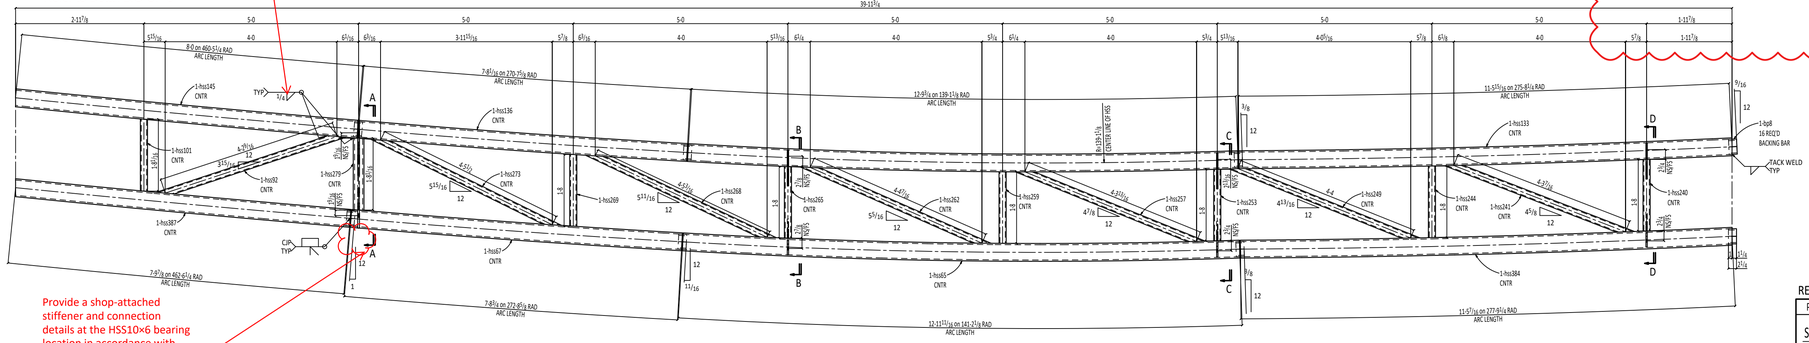

Provide a shop-attached stiffener and connection details at the HSS10×6 bearing location in accordance with Detail E/S-CP-8 for all the longitudinal trusses RT-1. See comments on E118 for further clarification

HSS3X3X3/8 TO HSS5X5X3/8 WELD 5/16

ONE TRUSS 1191TR-G

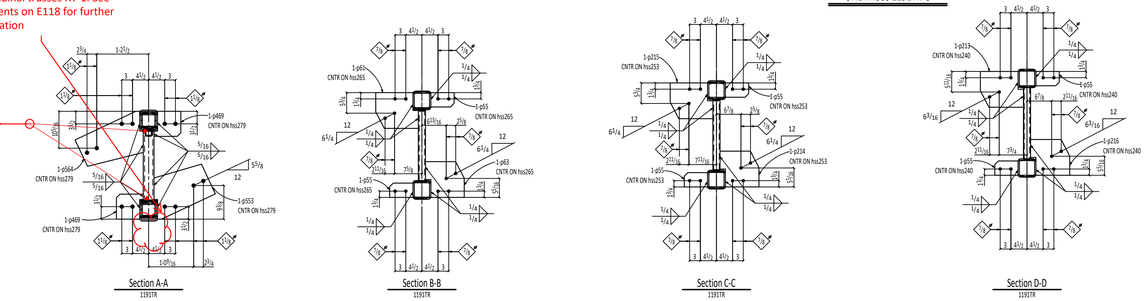

REFERENCE :----

PAGE TOTALS	REVISION NO.

SPECIAL NOTES:-

1. SEAL ALL WELDS FOR GALVANIZE.
2. ALL VENT HOLES TO BE PLUGGED AFTER GALVANIZING.

MATERIAL:-

ASTM:	A36 U.N.O.
S. S.:	-----
ALUM.:	-----
PIPE:	A53 GR.B
TUBES:	A500 GR.B
HOLES:	13/16 U.N.O
WELDING:	E70XX

MATERIAL PREP.:-

CLEAN:	SSPC-SP2
SHOP PAINT:	TWO COAT OF STD SHOP PRIMER
GALV:	GALVANIZED & PAINTED

GEN. NOTES:-

BUY AMERICAN:	
DOMESTIC:	
CERT/CONFORMANCE:	
CERT/COMPLIANCE:	

ALL WIDE FLANGE SHAPES TO BE PER A992-G50

FIELD CONNECTIONS :
HOLES : 13/16" U.N.O
PAINT :

morrow steel Fabricators, Inc.

3620 COPELAND DRIVE
ZEPHYRHILLS, FL. 33542

PRINTS FOR	DATE	MK	REVISIONS	DATE
		0	RELEASED FOR APPROVAL	Nov 18 2025
		1	RELEASED FOR RE-APPROVAL	Jul 13 2026
		2	RELEASED FOR RE-APPROVAL	Aug 26 2026

STRUCTURE:- PINELLAS SUNCOAST TRANSIT AUTHORITY
LOCATION:- CLEARWATER STATION,CLEARWATER,FL.
DETAILER:- VECTORSHADES LLC
CUSTOMER:- KOKOLAKIS
ARCH./ENG.:- CDM SMITH
DESCRIPTION:- WAVE CANOPY TRUSS DETAIL
DRAWN:- PBI DATE:- 10-27-2025 CHK.D:- RAG DATE:- 10-27-2025

SHOP BILL	WORK ORDER NO.	DRWG. NO.
	2553	1191

SHIPPING LIST

MATERIAL BILL

ITEM NO	TOTAL QTY	DESCRIPTION	MAJOR MARK	PAINT CODE	TOTAL WEIGHT	ABM NO	UNIT QTY	LENGTH FT.	LENGTH IN.	MINOR MARK	REMARKS	UNIT WEIGHT	GRADE
	ONE	TRUSS	1194TR	G	2314						Galv	2314	
	1	HSS5x5x3/8			112		1	4	11 7/8	1194TR		112	A500C
	1	HSS5x5x3/8			224		1	10	0 3/8	hss156		224	A500C
	1	HSS5x5x3/8			224		1	10	0 1/4	hss157		224	A500C
	1	HSS5x5x3/8			224		1	10	0 1/8	hss75		224	A500C
	1	HSS5x5x3/8			223		1	9	11 5/8	hss77		223	A500C
	1	HSS5x5x3/8			221		1	9	10 5/8	hss155	B1E	221	A500C
	1	HSS5x5x3/8			221		1	9	10 3/8	hss71	B1E	221	A500C
	1	HSS5x5x3/8			111		1	4	11 13/16	hss79		111	A500C
	1	HSS5x5x3/8			67		1	2	11 3/4	hss160		67	A500C
	1	HSS5x5x3/8			64		1	2	10 1/8	hss390		64	A500C
	1	HSS5x5x3/8			54		1	2	5 3/16	hss389	B1E	54	A500C
	1	HSS5x5x3/8			49		1	2	3 3/8	hss149	B1E	49	A500C
	1	HSS3x3x3/8			21		1	1	8 1/4	hss320	B1E	21	A500C
	1	HSS2x2x1/4			27		1	4	11 5/16	hss299		27	A500C
	1	HSS2x2x1/4			27		1	4	11 1/8	hss302		27	A500C
	1	HSS2x2x1/4			26		1	4	10 3/4	hss308		26	A500C
	1	HSS2x2x1/4			26		1	4	10 7/16	hss314		26	A500C
	1	HSS2x2x1/4			26		1	4	10 5/16	hss317		26	A500C
	1	HSS2x2x1/4			25		1	4	8 3/16	hss134		25	A500C
	1	HSS2x2x1/4			24		1	4	5 7/16	hss125		24	A500C
	1	HSS2x2x1/4			9		1	1	8 5/16	hss130	B1E	9	A500C
	1	HSS2x2x1/4			9		1	1	8 5/16	hss114		9	A500C
	1	HSS2x2x1/4			9		1	1	8 5/16	hss300	B1E	9	A500C
	1	HSS2x2x1/4			9		1	1	8 5/16	hss137	B1E	9	A500C
	1	HSS2x2x1/4			9		1	1	8 1/4	hss306	B1E	9	A500C
	1	HSS2x2x1/4			9		1	1	8 1/4	hss310	B1E	9	A500C
	1	HSS2x2x1/4			9		1	1	8 3/16	hss315	B1E	9	A500C
	1	PL1/2x15 3/8			37		1	1	5 3/16	p600		37	A572-50
	1	PL1/2x15 3/8			42		1	1	7 1/8	p603		42	A572-50
	2	PL1/2x7			15		2	0	7 1/2	p469		7	A572-50
	1	PL3/8x10			11		1	0	10 3/4	p172		11	A572-50
	2	PL3/8x10			25		2	0	11 7/8	p61		13	A572-50
	1	PL3/8x10			13		1	0	11 7/8	p168		13	A572-50
	1	PL3/8x10			13		1	0	11 7/8	p170		13	A572-50
	1	PL3/8x10			12		1	0	10 13/16	p63		12	A572-50
	1	PL3/8x10			11		1	0	10 13/16	p169		11	A572-50
	1	PL3/8x10			11		1	0	10 13/16	p166		11	A572-50
	8	PL3/8x4			21		8	0	6 1/2	p55		3	A572-50
	24	BPL3/8x2 1/4			42		24	0	7 5/16	bp8	BENT	2	A572-50

Total weight : 2314

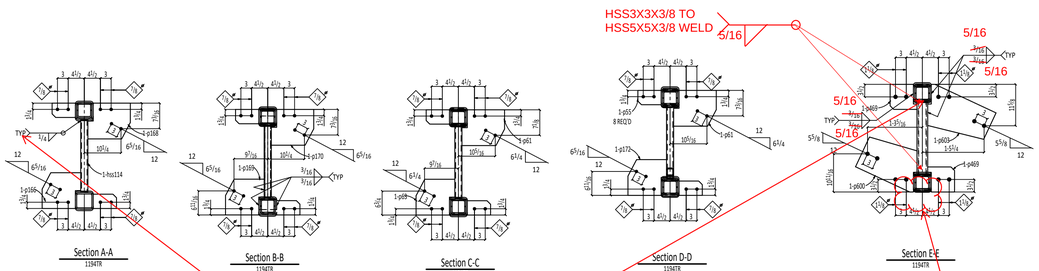

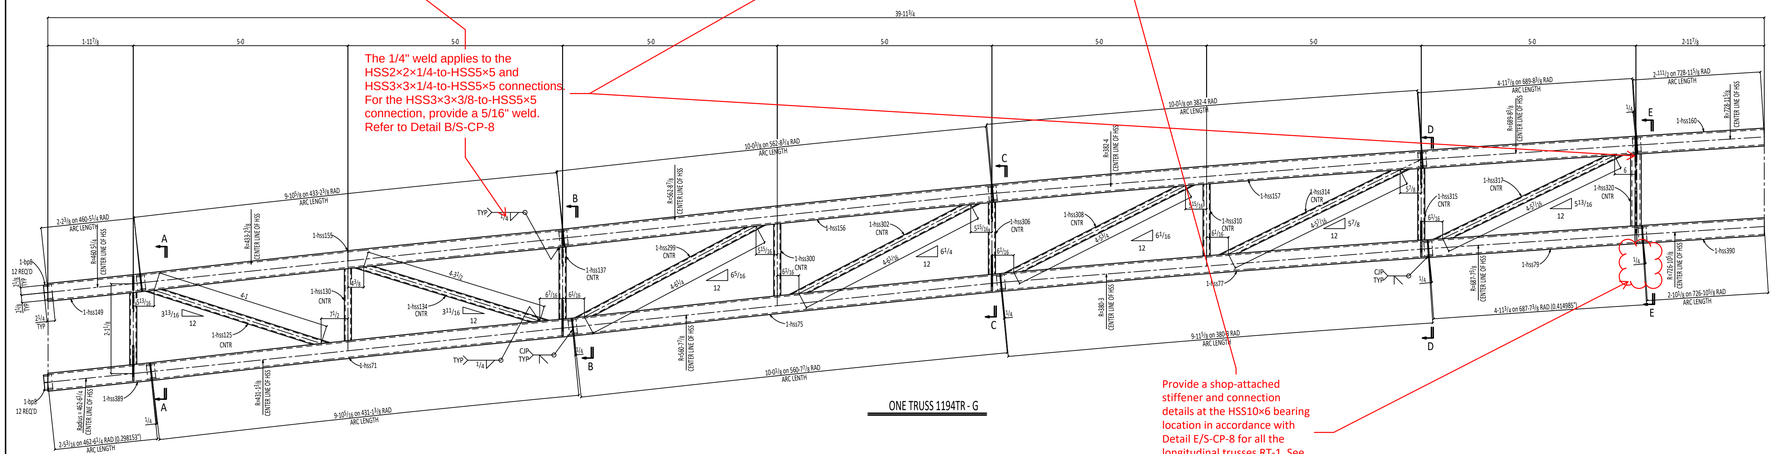

NOTE:
SHOP DRAWINGS HAVE BEEN SUBMITTED FOR ONE REPRESENTATIVE TRUSS.
PLEASE CONSIDER THIS DRAWING AS TYPICAL FOR ALL SIMILAR TRUSSES AND PROVIDE YOUR COMMENTS, IF ANY.

REFERENCE :----

PAGE TOTALS | REVISION NO.

SPECIAL NOTES:-

1. SEAL ALL WELDS FOR GALVANIZE.
2. ALL VENT HOLES TO BE PLUGGED AFTER GALVANIZING.

MATERIAL:-

ASTM:	A36 U.N.O.
S. S.:	-----
ALUM.:	-----
PIPE:	A53 GR.B
TUBES:	A500 GR.B
HOLES:	13/16 U.N.O
WELDING:	E70XX

MATERIAL PREP.:-

CLEAN:	SSPC-SP2
SHOP PAINT:	TWO COAT OF STD SHOP PRIMER
GALV:	GALVANIZED & PAINTED

GEN. NOTES:-

BUY AMERICAN:
DOMESTIC:
CERT/CONFORMANCE:
CERT/COMPLIANCE:

ALL WIDE FLANGE SHAPES TO BE PER A992-G50

FIELD CONNECTIONS :
HOLES : 13/16" U.N.O
PAINT :

morrow steel Fabricators, Inc.

3620 COPELAND DRIVE
ZEPHYRHILLS, FL. 33542

PRINTS FOR	DATE	MK	REVISIONS	DATE
		0	RELEASED FOR APPROVAL	Nov 18 2025
		1	RELEASED FOR RE-APPROVAL	Jul 13 2026
		2	RELEASED FOR RE-APPROVAL	Aug 26 2026

STRUCTURE:-PINELLAS SUNCOAST TRANSIT AUTHORITY
LOCATION:- CLEARWATER STATION,CLEARWATER,FL.
DETAILER:- VECTORSHADES LLC
CUSTOMER:- KOKOLAKIS
ARCH./ENG.:- CDM SMITH
DESCRIPTION:-WAVE CANOPY TRUSS DETAIL
DRAWN:- PBI DATE:-10-27-2025 CHK.D:-RAG DATE:- 10-27-2025

SHOP BILL	WORK ORDER NO.	DRWG. NO.
	2553	1194 A

NOTE:
SHOP DRAWINGS HAVE BEEN SUBMITTED FOR ONE REPRESENTATIVE TRUSS.
PLEASE CONSIDER THIS DRAWING AS TYPICAL FOR ALL SIMILAR TRUSSES AND PROVIDE YOUR COMMENTS, IF ANY.

SHIPPING LIST / MATERIAL BILL

ITEM NO	TOTAL QTY	DESCRIPTION	MAJOR MARK	PAINT CODE	TOTAL WEIGHT	ABM NO	UNIT QTY	LENGTH FT.	LENGTH IN.	MINOR MARK	REMARKS	UNIT WEIGHT	GRADE
	ONE	TRUSS	1197TR	G	2471						Galv	2471	
	1	HSS5x5x3/8			65		1	2	11 1/8	1197TR	B1E	65	A500C
	1	HSS5x5x3/8			335		1	14	11 3/4	hss362	B1E	335	A500C
	1	HSS5x5x3/8			335		1	14	11 3/4	hss365	B1E	335	A500C
	1	HSS5x5x3/8			223		1	9	11 3/4	hss360		223	A500C
	1	HSS5x5x3/8			222		1	9	11 5/16	hss364		222	A500C
	1	HSS5x5x3/8			156		1	6	11 15/16	hss397		156	A500C
	1	HSS5x5x3/8			156		1	6	11 13/16	hss401		156	A500C
	1	HSS5x5x3/8			111		1	4	11 1/2	hss166		111	A500C
	1	HSS5x5x3/8			110		1	4	11	hss363		110	A500C
	1	HSS5x5x3/8			65		1	2	10 15/16	hss165	B1E	65	A500C
	1	HSS3x3x3/8			20		1	1	8	hss309		20	A500C
	1	HSS3x3x1/4			51		1	5	9 15/16	hss202		51	A500C
	1	HSS3x3x1/4			51		1	5	9 3/4	hss211		51	A500C
	1	HSS3x3x1/4			50		1	5	7 9/16	hss197		50	A500C
	1	HSS3x3x1/4			44		1	4	11 1/4	hss322	B1E	44	A500C
	3	HSS3x3x1/4			130		3	4	11 3/16	hss87	B1E	43	A500C
	1	HSS3x3x1/4			15		1	1	8 1/8	hss301		15	A500C
	1	HSS3x3x1/4			15		1	1	8 1/16	hss199		15	A500C
	1	HSS3x3x1/4			15		1	1	8 1/16	hss207		15	A500C
	1	HSS3x3x1/4			15		1	1	8	hss324	B1E	15	A500C
	1	HSS3x3x1/4			15		1	1	8	hss319	B1E	15	A500C
	2	HSS3x3x1/4			29		2	1	8	hss89	B1E	15	A500C
	1	PL 1/2x15 3/8			42		1	1	7 1/8	p462		42	A572-50
	1	PL 1/2x15 3/8			38		1	1	5 3/16	p483		38	A572-50
	2	PL 1/2x7			15		2	0	7 1/2	p469		7	A572-50
	1	PL 3/8x10			11		1	0	10 5/16	p116		11	A572-50
	3	PL 3/8x10			36		3	0	11 3/8	p111		12	A572-50
	1	PL 3/8x10			12		1	0	11 5/16	p121		12	A572-50
	1	PL 3/8x10			12		1	0	11 3/16	p119		12	A572-50
	2	PL 3/8x10			22		2	0	10 5/16	p115		11	A572-50
	2	PL 3/8x5			5		2	0	5	p50		3	A572-50
	7	PL 3/8x4			18		7	0	6 1/2	p55		3	A572-50
	1	PL 3/8x4			3		1	0	6 1/2	p67		3	A572-50
	16	BPL 3/8x2 1/4			28		16	0	7 5/16	bp8	BENT	2	A572-50

Total weight : 2471

The 1/4" weld applies to the HSS2×2×1/4-to-HSS5×5 and HSS3×3×1/4-to-HSS5×5 connections. For the HSS3×3×3/8-to-HSS5×5 connection, provide a 5/16" weld. Refer to Detail B/S-CP-8

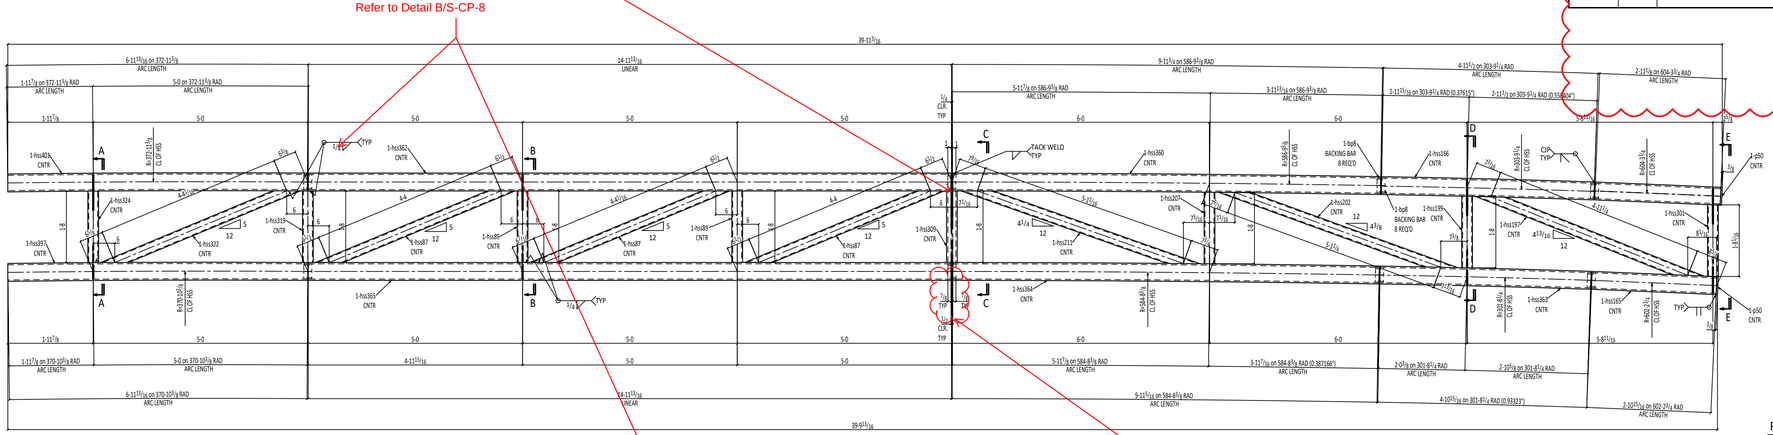

HSS3X3X3/8 TO HSS5X5X3/8 WELD 5/16

ONE TRUSS 1197TR - G

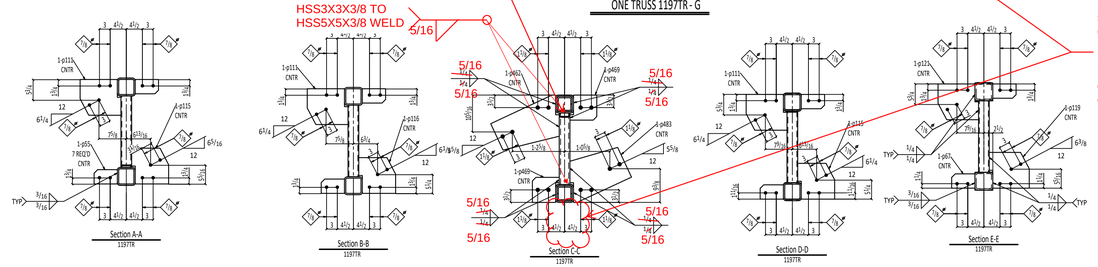

Provide a shop-attached stiffener and connection details at the HSS10×6 bearing location in accordance with Detail E/S-CP-8 for all the longitudinal trusses RT-1. See comments on E118 for further clarification

REFERENCE :---

PAGE TOTALS | REVISION NO.

SPECIAL NOTES:-

1. SEAL ALL WELDS FOR GALVANIZE.
2. ALL VENT HOLES TO BE PLUGGED AFTER GALVANIZING.

MATERIAL:-

ASTM: A36 U.N.O.
S.S.: -----
ALUM.: -----
PIPE: A53 GR.B
TUBES: A500 GR.B
HOLES: 13/16 U.N.O
WELDING: E70XX

MATERIAL PREP.:-

CLEAN: SSPC-SP2
SHOP PAINT: TWO COAT OF STD SHOP PRIMER
GALV: GALVANIZED & PAINTED

GEN. NOTES:-

BUY AMERICAN:
DOMESTIC:
CERT/CONFORMANCE:
CERT/COMPLIANCE:

ALL WIDE FLANGE SHAPES TO BE PER A992-G50

FIELD CONNECTIONS :
HOLES : 13/16" U.N.O
PAINT :

morrow steel Fabricators, Inc.

3620 COPELAND DRIVE
ZEPHYRHILLS, FL. 33542

	PRINTS FOR	DATE	MK	REVISIONS	DATE
			0	RELEASED FOR APPROVAL	Nov 18 2025
			1	RELEASED FOR RE-APPROVAL	Jul 13 2026
			2	RELEASED FOR RE-APPROVAL	Aug 26 2026

STRUCTURE:- PINELLAS SUNCOAST TRANSIT AUTHORITY
LOCATION:- CLEARWATER STATION,CLEARWATER,FL.
DETAILER:- VECTORSHADES LLC
CUSTOMER:- KOKOLAKIS
ARCH./ENG.:- CDM SMITH
DESCRIPTION:- WAVE CANOPY TRUSS DETAIL
DRAWN:- PBI DATE:- 10-27-2025 CHK.D:- RAG DATE:- 10-27-2025

SHOP BILL	WORK ORDER NO.	DRWG. NO.
	2553	1197

SHIPPING LIST

ITEM NO	TOTAL QTY	DESCRIPTION	MAJOR MARK	PAINT CODE	TOTAL WEIGHT	ABM NO
	ONE	TRUSS	1200TR	G	2427	
	1	HSS5x5x3/8			223	
	1	HSS5x5x3/8			336	
	1	HSS5x5x3/8			333	
	1	HSS5x5x3/8			225	
	1	HSS5x5x3/8			179	
	1	HSS5x5x3/8			177	
	1	HSS5x5x3/8			160	
	1	HSS5x5x3/8			157	
	1	HSS3x3x3/8			20	
	1	HSS3x3x1/4			45	
	1	HSS3x3x1/4			44	
	1	HSS3x3x1/4			44	
	1	HSS3x3x1/4			44	
	1	HSS3x3x1/4			43	
	1	HSS3x3x1/4			43	
	1	HSS3x3x1/4			43	
	1	HSS3x3x1/4			15	
	1	HSS3x3x1/4			15	
	1	HSS3x3x1/4			15	
	1	HSS3x3x1/4			15	
	1	HSS3x3x1/4			15	
	1	HSS3x3x1/4			15	
	1	HSS3x3x1/4			15	
	1	PL1/2x15 3/8			42	
	1	PL1/2x15 3/8			38	
	2	PL1/2x7			15	
	1	PL3/8x10			11	
	1	PL3/8x10			11	
	1	PL3/8x10			11	
	1	PL3/8x10			12	
	2	PL3/8x10			24	
	6	PL3/8x4			16	
	16	BPL3/8x2 1/4			28	

Total weight : 2427

MATERIAL BILL

ITEM NO	UNIT QTY	LENGTH FT.	LENGTH IN.	MINOR MARK	REMARKS	UNIT WEIGHT	GRADE
	1	9	11 7/8	1200TR	B1E	223	A500C
	1	15	0	hss370		336	A500C
	1	14	10 3/4	hss374		333	A500C
	1	10	0 7/16	hss373	B1E	225	A500C
	1	7	11 7/8	hss400		179	A500C
	1	7	11 3/16	hss399		177	A500C
	1	7	1 9/16	hss394		160	A500C
	1	7	0 1/16	hss395		157	A500C
	1	1	8 1/16	hss342		20	A500C
	1	5	0 11/16	hss354		45	A500C
	1	5	0 3/8	hss246		44	A500C
	1	4	11 15/16	hss234		44	A500C
	1	4	11 9/16	hss214		44	A500C
	1	4	10 3/4	hss190		43	A500C
	1	4	10 5/8	hss331		43	A500C
	1	4	10 9/16	hss184		43	A500C
	1	1	8 1/4	hss356		15	A500C
	1	1	8 1/4	hss351		15	A500C
	1	1	8 1/8	hss238		15	A500C
	1	1	8 1/8	hss335		15	A500C
	1	1	8 1/16	hss187		15	A500C
	1	1	8 1/16	hss224		15	A500C
	1	1	8 1/16	hss328		15	A500C
	1	1	7 1/4	p638		42	A572-50
	1	1	5 1/4	p644		38	A572-50
	2	0	7 1/2	p469		7	A572-50
	1	0	10 3/8	p85		11	A572-50
	1	0	10 7/16	p89		11	A572-50
	1	0	10 3/8	p84		11	A572-50
	1	0	11 1/2	p88		12	A572-50
	2	0	11 1/2	p81		12	A572-50
	6	6	0	6 1/2	p55		3	A572-50
	16	16	0	7 5/16	bp8	BENT	2	A572-50

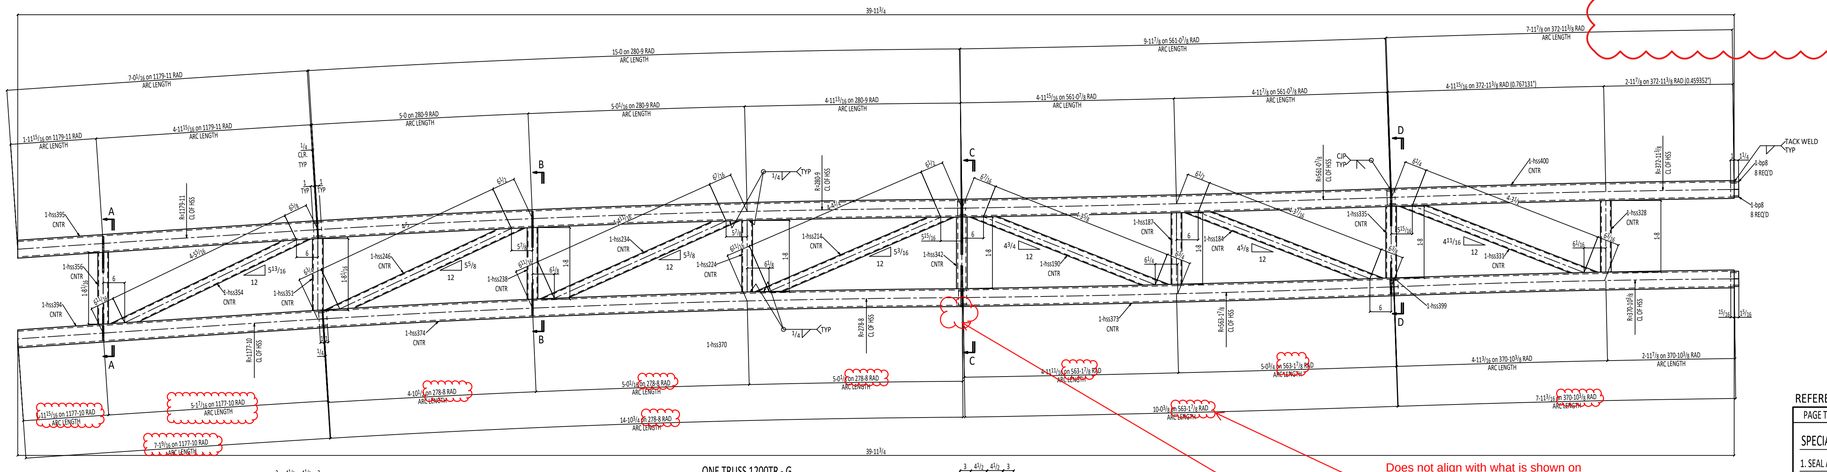

ONE TRUSS 1200TR - G

HSS3X3X3/8 TO HSS5X5X3/8 WELD

Does not align with what is shown on 2/E111. Coordinate (TYP)

Provide a shop-attached stiffener and connection details at the HSS10×6 bearing location in accordance with Detail E/S-CP-8 for all the longitudinal trusses RT-1. See comments on E118 for further clarification

NOTE:
SHOP DRAWINGS HAVE BEEN SUBMITTED FOR ONE REPRESENTATIVE TRUSS.
PLEASE CONSIDER THIS DRAWING AS TYPICAL FOR ALL SIMILAR TRUSSES AND PROVIDE YOUR COMMENTS, IF ANY.

REFERENCE :----

PAGE TOTALS

REVISION NO.

SPECIAL NOTES:-

1. SEAL ALL WELDS FOR GALVANIZE.
2. ALL VENT HOLES TO BE PLUGGED AFTER GALVANIZING.

MATERIAL:-

ASTM:	A36 U.N.O.
S. S.:	-----
ALUM.:	-----
PIPE:	A53 GR.B
TUBES:	A500 GR.B
HOLES:	13/16 U.N.O
WELDING:	E70XX

ALL WIDE FLANGE SHAPES TO BE PER A992-G50

MATERIAL PREP.:-

CLEAN:	SSPC-SP2
SHOP PAINT:	TWO COAT OF STD SHOP PRIMER
GALV:	GALVANIZED & PAINTED

GEN. NOTES:-

BUY AMERICAN:
DOMESTIC:
CERT/CONFORMANCE:
CERT/COMPLIANCE:

FIELD CONNECTIONS :
HOLES : 13/16" U.N.O
PAINT :

morrow steel Fabricators, Inc.

3620 COPELAND DRIVE
ZEPHYRHILLS, FL. 33542

PRINTS FOR	DATE	MK	REVISIONS	DATE
		0	RELEASED FOR APPROVAL	Nov 18 2025
		1	RELEASED FOR RE-APPROVAL	Jul 13 2026
		2	RELEASED FOR RE-APPROVAL	Aug 26 2026

STRUCTURE:- PINELLAS SUNCOAST TRANSIT AUTHORITY
LOCATION:- CLEARWATER STATION,CLEARWATER,FL.
DETAILER:- VECTORSHADES LLC
CUSTOMER:- KOKOLAKIS
ARCH./ENG.:- CDM SMITH
DESCRIPTION:- WAVE CANOPY TRUSS DETAIL
DRAWN:- PBJ DATE:- 10-27-2025 CHK.D:-RAG DATE:- 10-27-2025

SHOP BILL	WORK ORDER NO.	DRWG. NO.
	2553	1200

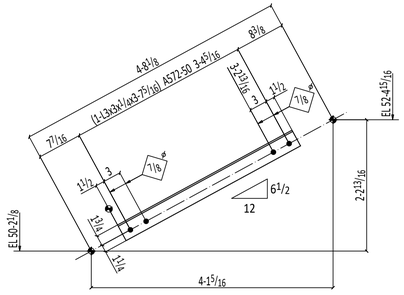

6 VERTICAL BRACES 1401VB -G

SHOP NOTE:
TOE DIRECTION NEAR SIDE

SHIPPING LIST / MATERIAL BILL

ITEM NO	TOTAL QTY	DESCRIPTION	MAJOR MARK	PAINT CODE	TOTAL WEIGHT	ABM NO	UNIT QTY	LENGTH FT.	LENGTH IN.	MINOR MARK	REMARKS	UNIT WEIGHT	GRADE
	6	VERTICAL BRACE	1401VB	G	106						Galv	18	
	6	L3x3x1/4			106		1	3	7 5/16	1401VB		18	A572-50
		FIELD BOLTS											
	24	3/4 Dia A325N						0	1 3/4		+1HD WASH		

Total weight : 106

REFERENCE :----

PAGE TOTALS

REVISION NO.

SPECIAL NOTES:-

MATERIAL:-
ASTM: A36 U.N.O.
S. S.: -----
ALUM.: -----
PIPE: A53 GR.B
TUBES: A500 GR.B
HOLES: 13/16 U.N.O
WELDING: E70XX

MATERIAL PREP.:-
CLEAN: SSPC-SP2
SHOP PAINT: TWO COAT OF STD SHOP PRIMER
GALV: GALVANIZED & PAINTED

GEN. NOTES:-
BUY AMERICAN:
DOMESTIC:
CERT/CONFORMANCE:
CERT/COMPLIANCE:

ALL WIDE FLANGE SHAPES TO BE PER A992-G50

FIELD CONNECTIONS :
HOLES : 13/16" U.N.O
PAINT :

morrow steel Fabricators, Inc.

3620 COPELAND DRIVE
ZEPHYRHILLS, FL. 33542

	PRINTS FOR	DATE	MK	REVISIONS	DATE
			0	RELEASED FOR APPROVAL	Nov 18 2025
			1	RELEASED FOR RE-APPROVAL	Jul 13 2026
			2	RELEASED FOR RE-APPROVAL	Aug 26 2026

STRUCTURE:-PINELLAS SUNCOAST TRANSIT AUTHORITY
LOCATION:- CLEARWATER STATION,CLEARWATER,FL.
DETAILER:- VECTORSHADES LLC
CUSTOMER:- KOKOLAKIS
ARCH./ENG.:- CDM SMITH
DESCRIPTION:-WAVE CANOPY VERTICAL BRACE DETAIL
DRAWN:- PBI DATE:-10-27-2025 CHK.D:-RAG DATE:- 10-27-2025

SHOP BILL	WORK ORDER NO.	DRWG. NO.
	2553	1401

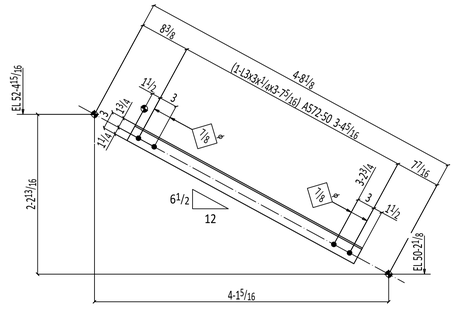

6 VERTICAL BRACES 1402VB -G

SHOP NOTE:
TOE DIRECTION NEAR SIDE

SHIPPING LIST

MATERIAL BILL

ITEM NO	TOTAL QTY	DESCRIPTION	MAJOR MARK	PAINT CODE	TOTAL WEIGHT	ABM NO	UNIT QTY	LENGTH FT.	LENGTH IN.	MINOR MARK	REMARKS	UNIT WEIGHT	GRADE
	6	VERTICAL BRACE	1402VB	G	106						Galv	18	
	6	L3x3x1/4			106		1	3	7 5/16	1402VB		18	A572-50
		FIELD BOLTS											
	24	3/4 Dia A325N						0	1 3/4		+1HD WASH		

Total weight : 106

REFERENCE :----

PAGE TOTALS

REVISION NO.

SPECIAL NOTES:-

MATERIAL:-

ASTM: A36 U.N.O.
S. S.: -----
ALUM.: -----
PIPE: A53 GR.B
TUBES: A500 GR.B
HOLES: 13/16 U.N.O
WELDING: E70XX

MATERIAL PREP.:-

CLEAN: SSPC-SP2
SHOP PAINT: TWO COAT OF STD SHOP PRIMER
GALV: GALVANIZED & PAINTED

GEN. NOTES:-

BUY AMERICAN:
DOMESTIC:
CERT/CONFORMANCE:
CERT/COMPLIANCE:

ALL WIDE FLANGE SHAPES TO BE PER A992-G50

FIELD CONNECTIONS :
HOLES : 13/16" U.N.O
PAINT :

morrow steel Fabricators, Inc.

3620 COPELAND DRIVE
ZEPHYRHILLS, FL. 33542

	PRINTS FOR	DATE	MK	REVISIONS	DATE
			0	RELEASED FOR APPROVAL	Nov 18 2025
			1	RELEASED FOR RE-APPROVAL	Jul 13 2026
			2	RELEASED FOR RE-APPROVAL	Aug 26 2026

STRUCTURE:-PINELLAS SUNCOAST TRANSIT AUTHORITY
LOCATION:- CLEARWATER STATION,CLEARWATER,FL.
DETAILER:- VECTORSHADES LLC
CUSTOMER:- KOKOLAKIS
ARCH./ENG.:- CDM SMITH
DESCRIPTION:- WAVE CANOPY VERTICAL BRACE DETAIL
DRAWN:- PBI DATE:- 10-27-2025 CHK.D:- RAG DATE:- 10-27-2025

SHOP BILL	WORK ORDER NO.	DRWG. NO.
	2553	1402 ⚠1

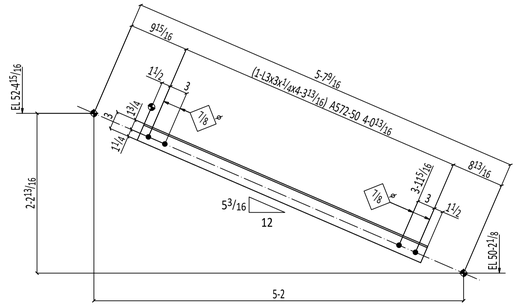

ONE VERTICAL BRACE 1403VB -G

SHOP NOTE:
TOE DIRECTION NEAR SIDE

AESS CATEGORY-3

SHIPPING LIST

MATERIAL BILL

ITEM NO	TOTAL QTY	DESCRIPTION	MAJOR MARK	PAINT CODE	TOTAL WEIGHT	ABM NO	UNIT QTY	LENGTH FT.	LENGTH IN.	MINOR MARK	REMARKS	UNIT WEIGHT	GRADE
	ONE	VERTICAL BRACE	1403VB	G	21						Galv	21	
	1	L3x3x1/4			21		1	4	3 13/16	1403VB		21	A572-50
		FIELD BOLTS											
	4	3/4 Dia A325N						0	1 3/4		+1HD WASH		

Total weight : 21

REFERENCE :----

PAGE TOTALS

REVISION NO.

SPECIAL NOTES:-

MATERIAL:-
ASTM: A36 U.N.O.
S. S.: -----
ALUM.: -----
PIPE: A53 GR.B
TUBES: A500 GR.B
HOLES: 13/16 U.N.O
WELDING: E70XX

MATERIAL PREP.:-
CLEAN: SSPC-SP2
SHOP PAINT: TWO COAT OF STD SHOP PRIMER
GALV: GALVANIZED & PAINTED

GEN. NOTES:-
BUY AMERICAN:
DOMESTIC:
CERT/CONFORMANCE:
CERT/COMPLIANCE:

ALL WIDE FLANGE SHAPES TO BE PER A992-G50

FIELD CONNECTIONS :
HOLES : 13/16" U.N.O
PAINT :

morrow steel Fabricators, Inc.

3620 COPELAND DRIVE
ZEPHYRHILLS, FL. 33542

	PRINTS FOR	DATE	MK	REVISIONS	DATE
			0	RELEASED FOR APPROVAL	Nov 18 2025
			1	RELEASED FOR RE-APPROVAL	Jul 13 2026
			2	RELEASED FOR RE-APPROVAL	Aug 26 2026

STRUCTURE:- PINELLAS SUNCOAST TRANSIT AUTHORITY
LOCATION:- CLEARWATER STATION,CLEARWATER,FL.
DETAILER:- VECTORSHADES LLC
CUSTOMER:- KOKOLAKIS
ARCH./ENG.:- CDM SMITH
DESCRIPTION:- WAVE CANOPY VERTICAL BRACE DETAIL
DRAWN:- PBI DATE:- 10-27-2025 CHK.D:- RAG DATE:- 10-27-2025

SHOP BILL	WORK ORDER NO.	DRWG. NO.
	2553	1403 1

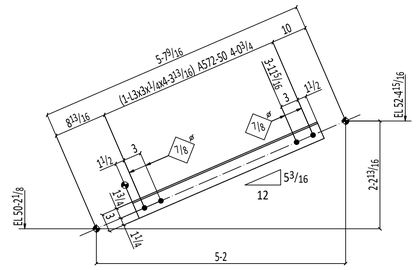

ONE VERTICAL BRACE 1404VB -G

SHOP NOTE:
TOE DIRECTION NEAR SIDE

AESS CATEGORY-3

SHIPPING LIST

MATERIAL BILL

ITEM NO	TOTAL QTY	DESCRIPTION	MAJOR MARK	PAINT CODE	TOTAL WEIGHT	ABM NO	UNIT QTY	LENGTH FT.	LENGTH IN.	MINOR MARK	REMARKS	UNIT WEIGHT	GRADE
	ONE	VERTICAL BRACE	1404VB	G	21						Galv	21	
	1	L3x3x¼			21		1	4	3 13/16	1404VB		21	A572-50
		FIELD BOLTS											
	4	¾ Dia A325N						0	1¾		+1HD WASH		

Total weight : 21

REFERENCE :----

PAGE TOTALS

REVISION NO.

SPECIAL NOTES:-

MATERIAL:-
ASTM: A36 U.N.O.
S. S.: -----
ALUM.: -----
PIPE: A53 GR.B
TUBES: A500 GR.B
HOLES: 13/16 U.N.O
WELDING: E70XX

MATERIAL PREP.:-
CLEAN: SSPC-SP2
SHOP PAINT: TWO COAT OF STD SHOP PRIMER
GALV: GALVANIZED & PAINTED

GEN. NOTES:-
BUY AMERICAN:
DOMESTIC:
CERT/CONFORMANCE:
CERT/COMPLIANCE:

ALL WIDE FLANGE SHAPES TO BE PER A992-G50

FIELD CONNECTIONS :
HOLES : 13/16" U.N.O
PAINT :

morrow steel Fabricators, Inc.

3620 COPELAND DRIVE
ZEPHYRHILLS, FL. 33542

	PRINTS FOR	DATE	MK	REVISIONS	DATE
			0	RELEASED FOR APPROVAL	Nov 18 2025
			1	RELEASED FOR RE-APPROVAL	Jul 13 2026
			2	RELEASED FOR RE-APPROVAL	Aug 26 2026

STRUCTURE:-PINELLAS SUNCOAST TRANSIT AUTHORITY
LOCATION:- CLEARWATER STATION,CLEARWATER,FL.
DETAILER:- VECTORSHADES LLC
CUSTOMER:- KOKOLAKIS
ARCH./ENG.:- CDM SMITH
DESCRIPTION:- WAVE CANOPY VERTICAL BRACE DETAIL
DRAWN:- PBI DATE:- 10-27-2025 CHK.D:- RAG DATE:- 10-27-2025

SHOP BILL	WORK ORDER NO.	DRWG. NO.
	2553	1404

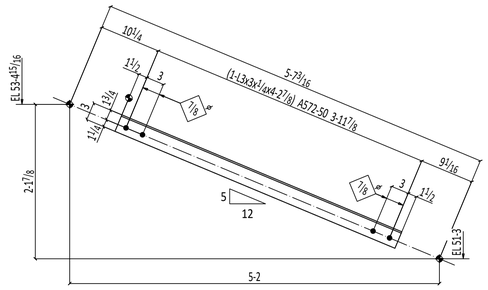

2 VERTICAL BRACES 1405VB -G

SHOP NOTE:
TOE DIRECTION NEAR SIDE

AESS CATEGORY-3

SHIPPING LIST / MATERIAL BILL

ITEM NO	TOTAL QTY	DESCRIPTION	MAJOR MARK	PAINT CODE	TOTAL WEIGHT	ABM NO	UNIT QTY	LENGTH FT.	LENGTH IN.	MINOR MARK	REMARKS	UNIT WEIGHT	GRADE
	2	VERTICAL BRACE	1405VB	G	42						Galv	21	
	2	L3x3x1/4			42		1	4	2 7/8	1405VB		21	A572-50
		FIELD BOLTS											
	8	3/4 Dia A325N						0	1 3/4		+1HD WASH		

Total weight : 42

REFERENCE :----

PAGE TOTALS

REVISION NO.

SPECIAL NOTES:-

MATERIAL:-

ASTM:	A36 U.N.O.
S. S.:	-----
ALUM.:	-----
PIPE:	A53 GR.B
TUBES:	A500 GR.B
HOLES:	13/16 U.N.O
WELDING:	E70XX

MATERIAL PREP.:-

CLEAN:	SSPC-SP2
SHOP PAINT:	TWO COAT OF STD SHOP PRIMER
GALV:	GALVANIZED & PAINTED

GEN. NOTES:-

BUY AMERICAN:
DOMESTIC:
CERT/CONFORMANCE:
CERT/COMPLIANCE:

ALL WIDE FLANGE SHAPES TO BE PER A992-G50

FIELD CONNECTIONS :
HOLES : 13/16" U.N.O
PAINT :

morrow steel Fabricators, Inc.

3620 COPELAND DRIVE
ZEPHYRHILLS, FL. 33542

	PRINTS FOR	DATE	MK	REVISIONS	DATE
			0	RELEASED FOR APPROVAL	Nov 18 2025
			1	RELEASED FOR RE-APPROVAL	Jul 13 2026
			2	RELEASED FOR RE-APPROVAL	Aug 26 2026

STRUCTURE:- PINELLAS SUNCOAST TRANSIT AUTHORITY
LOCATION:- CLEARWATER STATION,CLEARWATER,FL.
DETAILER:- VECTORSHADES LLC
CUSTOMER:- KOKOLAKIS
ARCH./ENG.:- CDM SMITH
DESCRIPTION:- WAVE CANOPY VERTICAL BRACE DETAIL
DRAWN:- PBI DATE:-10-27-2025 CHK.D.-RAG DATE:- 10-27-2025

SHOP BILL	WORK ORDER NO.	DRWG. NO.
	2553	1405

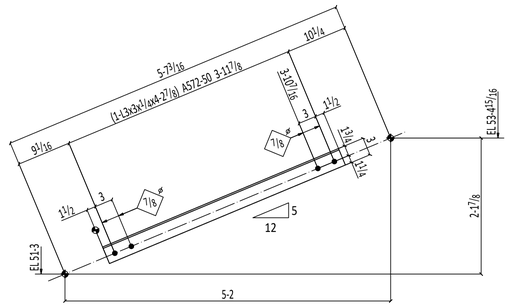

2 VERTICAL BRACES 1406VB -G

SHOP NOTE:
TOE DIRECTION NEAR SIDE

AESS CATEGORY-3

SHIPPING LIST

MATERIAL BILL

ITEM NO	TOTAL QTY	DESCRIPTION	MAJOR MARK	PAINT CODE	TOTAL WEIGHT	ABM NO	UNIT QTY	LENGTH FT.	LENGTH IN.	MINOR MARK	REMARKS	UNIT WEIGHT	GRADE
	2	VERTICAL BRACE	1406VB	G	42						Galv	21	
	2	L3x3x¼			42		1	4	27/8	1406VB		21	A572-50
		FIELD BOLTS											
	8	¾ Dia A325N						0	1¾		+1HD WASH		

Total weight : 42

REFERENCE :----

PAGE TOTALS

REVISION NO.

SPECIAL NOTES:-

MATERIAL:-
ASTM: A36 U.N.O.
S. S.: -----
ALUM.: -----
PIPE: A53 GR.B
TUBES: A500 GR.B
HOLES: 13/16 U.N.O
WELDING: E70XX

MATERIAL PREP.:-
CLEAN: SSPC-SP2
SHOP PAINT: TWO COAT OF STD SHOP PRIMER
GALV: GALVANIZED & PAINTED

GEN. NOTES:-
BUY AMERICAN:
DOMESTIC:
CERT/CONFORMANCE:
CERT/COMPLIANCE:

ALL WIDE FLANGE SHAPES TO BE PER A992-G50

FIELD CONNECTIONS :
HOLES : 13/16" U.N.O
PAINT :

morrow steel Fabricators, Inc.

3620 COPELAND DRIVE
ZEPHYRHILLS, FL. 33542

	PRINTS FOR	DATE	MK	REVISIONS	DATE
			0	RELEASED FOR APPROVAL	Nov 18 2025
			1	RELEASED FOR RE-APPROVAL	Jul 13 2026
			2	RELEASED FOR RE-APPROVAL	Aug 26 2026

STRUCTURE:- PINELLAS SUNCOAST TRANSIT AUTHORITY
LOCATION:- CLEARWATER STATION,CLEARWATER,FL.
DETAILER:- VECTORSHADES LLC
CUSTOMER:- KOKOLAKIS
ARCH./ENG.:- CDM SMITH
DESCRIPTION:- WAVE CANOPY VERTICAL BRACE DETAIL
DRAWN:- PBI DATE:-10-27-2025 CHK.D:-RAG DATE:- 10-27-2025

SHOP BILL	WORK ORDER NO.	DRWG. NO.
	2553	1406 ⚠1

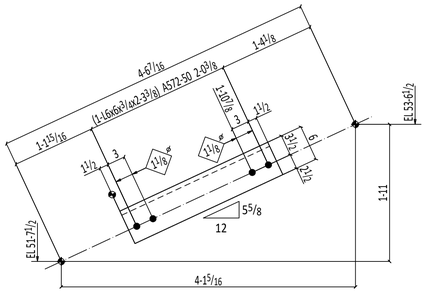

12 VERTICAL BRACES 1407VB -G

SHOP NOTE:
TOE DIRECTION FAR SIDE

SHIPPING LIST

MATERIAL BILL

ITEM NO	TOTAL QTY	DESCRIPTION	MAJOR MARK	PAINT CODE	TOTAL WEIGHT	ABM NO	UNIT QTY	LENGTH FT.	LENGTH IN.	MINOR MARK	REMARKS	UNIT WEIGHT	GRADE
	12	VERTICAL BRACE	1407VB	G	785						Galv	65	
	12	L6x6x$^3/_4$			785		1	2	$3^3/_8$	1407VB		65	A572-50
		FIELD BOLTS											
	48	1 Dia A325N						0	$2^3/_4$		+1HD WASH		

Total weight : 785

REFERENCE :----

PAGE TOTALS

REVISION NO.

SPECIAL NOTES:-

MATERIAL:-

ASTM: A36 U.N.O.
S. S.: -----
ALUM.: -----
PIPE: A53 GR.B
TUBES: A500 GR.B
HOLES: $^{13}/_{16}$ U.N.O
WELDING: E70XX

MATERIAL PREP.:-

CLEAN: SSPC-SP2
SHOP PAINT: TWO COAT OF STD SHOP PRIMER
GALV: GALVANIZED & PAINTED

GEN. NOTES:-

BUY AMERICAN:
DOMESTIC:
CERT/CONFORMANCE:
CERT/COMPLIANCE:

ALL WIDE FLANGE SHAPES TO BE PER A992-G50

FIELD CONNECTIONS :
HOLES : $^{13}/_{16}$" U.N.O
PAINT :

morrow steel Fabricators, Inc.

3620 COPELAND DRIVE
ZEPHYRHILLS, FL. 33542

	PRINTS FOR	DATE	MK	REVISIONS	DATE
			0	RELEASED FOR APPROVAL	Nov 18 2025
			1	RELEASED FOR RE-APPROVAL	Jul 13 2026
			2	RELEASED FOR RE-APPROVAL	Aug 26 2026

STRUCTURE:- PINELLAS SUNCOAST TRANSIT AUTHORITY
LOCATION:- CLEARWATER STATION,CLEARWATER,FL.
DETAILER:- VECTORSHADES LLC
CUSTOMER:- KOKOLAKIS
ARCH./ENG.:- CDM SMITH
DESCRIPTION:- WAVE CANOPY VERTICAL BRACE DETAIL
DRAWN:- PBI DATE:- 10-27-2025 CHK.D:- RAG DATE:- 10-27-2025

SHOP BILL	WORK ORDER NO.	DRWG. NO.
	2553	1407 ⚠1

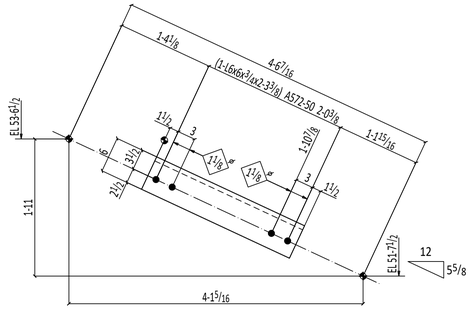

12 VERTICAL BRACES 1408VB -G

SHOP NOTE:
TOE DIRECTION FAR SIDE

SHIPPING LIST

MATERIAL BILL

ITEM NO	TOTAL QTY	DESCRIPTION	MAJOR MARK	PAINT CODE	TOTAL WEIGHT	ABM NO	UNIT QTY	LENGTH FT.	LENGTH IN.	MINOR MARK	REMARKS	UNIT WEIGHT	GRADE
	12	VERTICAL BRACE	1408VB	G	785						Galv	65	
	12	L6x6x3/4			785		1	2	3 3/8	1408VB		65	A572-50
		FIELD BOLTS											
	48	1 Dia A325N						0	2 3/4		+1HD WASH		

Total weight : 785

REFERENCE :----

PAGE TOTALS

REVISION NO.

SPECIAL NOTES:-

MATERIAL:-
ASTM: A36 U.N.O.
S.S.: -----
ALUM.: -----
PIPE: A53 GR.B
TUBES: A500 GR.B
HOLES: 13/16 U.N.O
WELDING: E70XX

MATERIAL PREP.:-
CLEAN: SSPC-SP2
SHOP PAINT: TWO COAT OF STD SHOP PRIMER
GALV: GALVANIZED & PAINTED

GEN. NOTES:-
BUY AMERICAN:
DOMESTIC:
CERT/CONFORMANCE:
CERT/COMPLIANCE:

ALL WIDE FLANGE SHAPES TO BE PER A992-G50

FIELD CONNECTIONS :
HOLES : 13/16" U.N.O
PAINT :

morrow steel Fabricators, Inc.

3620 COPELAND DRIVE
ZEPHYRHILLS, FL. 33542

	PRINTS FOR	DATE	MK	REVISIONS	DATE
			0	RELEASED FOR APPROVAL	Nov 18 2025
			1	RELEASED FOR RE-APPROVAL	Jul 13 2026
			2	RELEASED FOR RE-APPROVAL	Aug 26 2026

STRUCTURE:- PINELLAS SUNCOAST TRANSIT AUTHORITY
LOCATION:- CLEARWATER STATION,CLEARWATER,FL.
DETAILER:- VECTORSHADES LLC
CUSTOMER:- KOKOLAKIS
ARCH./ENG.:- CDM SMITH
DESCRIPTION:- WAVE CANOPY VERTICAL BRACE DETAIL
DRAWN:- PBI DATE:- 10-27-2025 CHK.D:- RAG DATE:- 10-27-2025

SHOP BILL	WORK ORDER NO.	DRWG. NO.
	2553	1408 ⚠1

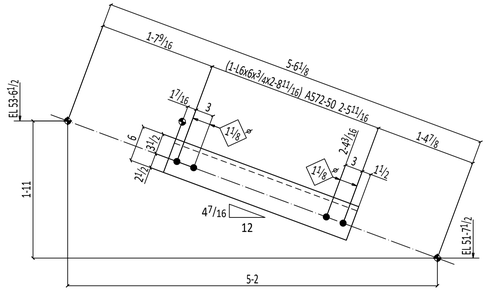

2 VERTICAL BRACES 1409VB -G

SHOP NOTE:
TOE DIRECTION FAR SIDE

AESS CATEGORY-3

SHIPPING LIST

MATERIAL BILL

ITEM NO	TOTAL QTY	DESCRIPTION	MAJOR MARK	PAINT CODE	TOTAL WEIGHT	ABM NO	UNIT QTY	LENGTH FT.	LENGTH IN.	MINOR MARK	REMARKS	UNIT WEIGHT	GRADE
	2	VERTICAL BRACE	1409VB	G	156						Galv	78	
	2	L6x6x3/4			156		1	2	8 11/16	1409VB		78	A572-50
		FIELD BOLTS											
	8	1 Dia A325N						0	2 3/4		+1HD WASH		

Total weight : 156

REFERENCE :----

PAGE TOTALS

REVISION NO.

SPECIAL NOTES:-

MATERIAL:-
ASTM: A36 U.N.O.
S.S.: -----
ALUM.: -----
PIPE: A53 GR.B
TUBES: A500 GR.B
HOLES: 13/16 U.N.O
WELDING: E70XX

MATERIAL PREP.:-
CLEAN: SSPC-SP2
SHOP PAINT: TWO COAT OF STD SHOP PRIMER
GALV: GALVANIZED & PAINTED

GEN. NOTES:-
BUY AMERICAN:
DOMESTIC:
CERT/CONFORMANCE:
CERT/COMPLIANCE:

ALL WIDE FLANGE SHAPES TO BE PER A992-G50

FIELD CONNECTIONS :
HOLES : 13/16" U.N.O
PAINT :

morrow steel Fabricators, Inc.

3620 COPELAND DRIVE
ZEPHYRHILLS, FL. 33542

	PRINTS FOR	DATE	MK	REVISIONS	DATE
			0	RELEASED FOR APPROVAL	Nov 18 2025
			1	RELEASED FOR RE-APPROVAL	Jul 13 2026
			2	RELEASED FOR RE-APPROVAL	Aug 26 2026

STRUCTURE:- PINELLAS SUNCOAST TRANSIT AUTHORITY
LOCATION:- CLEARWATER STATION,CLEARWATER,FL.
DETAILER:- VECTORSHADES LLC
CUSTOMER:- KOKOLAKIS
ARCH./ENG.:- CDM SMITH
DESCRIPTION:- WAVE CANOPY VERTICAL BRACE DETAIL
DRAWN:- PBI DATE:- 10-27-2025 CHK.D:- RAG DATE:- 10-27-2025

SHOP BILL	WORK ORDER NO.	DRWG. NO.
	2553	1409 1

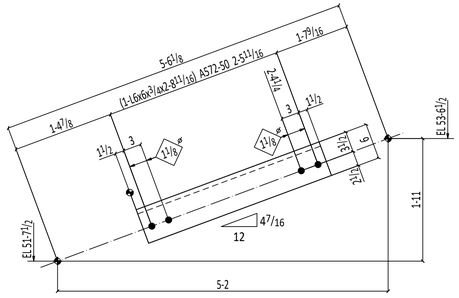

2 VERTICAL BRACES 1410VB -G

SHOP NOTE:
TOE DIRECTION FAR SIDE

AESS CATEGORY-3

SHIPPING LIST

MATERIAL BILL

ITEM NO	TOTAL QTY	DESCRIPTION	MAJOR MARK	PAINT CODE	TOTAL WEIGHT	ABM NO	UNIT QTY	LENGTH FT.	LENGTH IN.	MINOR MARK	REMARKS	UNIT WEIGHT	GRADE
	2	VERTICAL BRACE	1410VB	G	156						Galv	78	
	2	L6x6x3/4			156		1	2	8 11/16	1410VB		78	A572-50
		FIELD BOLTS											
	8	1 Dia A325N						0	2 3/4		+1HD WASH		

Total weight : 156

REFERENCE :----

PAGE TOTALS

REVISION NO.

SPECIAL NOTES:-

MATERIAL:-
ASTM: A36 U.N.O.
S. S.: -----
ALUM.: -----
PIPE: A53 GR.B
TUBES: A500 GR.B
HOLES: 13/16 U.N.O
WELDING: E70XX

MATERIAL PREP.:-
CLEAN: SSPC-SP2
SHOP PAINT: TWO COAT OF STD SHOP PRIMER
GALV: GALVANIZED & PAINTED

GEN. NOTES:-
BUY AMERICAN:
DOMESTIC:
CERT/CONFORMANCE:
CERT/COMPLIANCE:

ALL WIDE FLANGE SHAPES TO BE PER A992-G50

FIELD CONNECTIONS :
HOLES : 13/16" U.N.O
PAINT :

morrow steel Fabricators, Inc.

3620 COPELAND DRIVE
ZEPHYRHILLS, FL. 33542

	PRINTS FOR	DATE	MK	REVISIONS	DATE
			0	RELEASED FOR APPROVAL	Nov 18 2025
			1	RELEASED FOR RE-APPROVAL	Jul 13 2026
			2	RELEASED FOR RE-APPROVAL	Aug 26 2026

STRUCTURE:- PINELLAS SUNCOAST TRANSIT AUTHORITY
LOCATION:- CLEARWATER STATION,CLEARWATER,FL.
DETAILER:- VECTORSHADES LLC
CUSTOMER:- KOKOLAKIS
ARCH./ENG.:- CDM SMITH
DESCRIPTION:- WAVE CANOPY VERTICAL BRACE DETAIL
DRAWN:- PBI DATE:- 10-27-2025 CHK.D:- RAG DATE:- 10-27-2025

SHOP BILL	WORK ORDER NO.	DRWG. NO.
	2553	1410 ⚠1

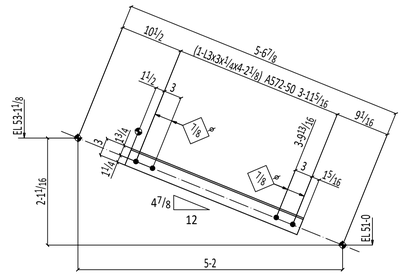

ONE VERTICAL BRACE 1411VB -G

SHOP NOTE:
TOE DIRECTION NEAR SIDE

AESS CATEGORY-3

SHIPPING LIST

MATERIAL BILL

ITEM NO	TOTAL QTY	DESCRIPTION	MAJOR MARK	PAINT CODE	TOTAL WEIGHT	ABM NO	UNIT QTY	LENGTH FT.	LENGTH IN.	MINOR MARK	REMARKS	UNIT WEIGHT	GRADE
	ONE	VERTICAL BRACE	1411VB	G	20						Galv	20	
	1	L3x3x1/4			20		1	4	2 1/8	1411VB		20	A572-50
		FIELD BOLTS											
	4	3/4 Dia A325N						0	1 3/4		+1HD WASH		

Total weight : 20

REFERENCE :----

PAGE TOTALS

REVISION NO.

SPECIAL NOTES:-

MATERIAL:-

ASTM: A36 U.N.O.
S. S.: -----
ALUM.: -----
PIPE: A53 GR.B
TUBES: A500 GR.B
HOLES: 13/16 U.N.O
WELDING: E70XX

MATERIAL PREP.:-

CLEAN: SSPC-SP2
SHOP PAINT: TWO COAT OF STD SHOP PRIMER
GALV: GALVANIZED & PAINTED

GEN. NOTES:-

BUY AMERICAN:
DOMESTIC:
CERT/CONFORMANCE:
CERT/COMPLIANCE:

ALL WIDE FLANGE SHAPES TO BE PER A992-G50

FIELD CONNECTIONS :
HOLES : 13/16" U.N.O
PAINT :

morrow steel Fabricators, Inc.

3620 COPELAND DRIVE
ZEPHYRHILLS, FL. 33542

	PRINTS FOR	DATE	MK	REVISIONS	DATE
			0	RELEASED FOR APPROVAL	Nov 18 2025
			1	RELEASED FOR RE-APPROVAL	Jul 13 2026
			2	RELEASED FOR RE-APPROVAL	Aug 26 2026

STRUCTURE:- PINELLAS SUNCOAST TRANSIT AUTHORITY
LOCATION:- CLEARWATER STATION,CLEARWATER,FL.
DETAILER:- VECTORSHADES LLC
CUSTOMER:- KOKOLAKIS
ARCH./ENG.:- CDM SMITH
DESCRIPTION:- WAVE CANOPY VERTICAL BRACE DETAIL
DRAWN:- PBI DATE:- 10-27-2025 CHK.D:- RAG DATE:- 10-27-2025

SHOP BILL	WORK ORDER NO.	DRWG. NO.
	2553	1411

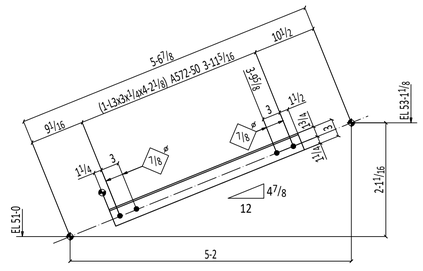

ONE VERTICAL BRACE 1412VB -G

SHOP NOTE:
TOE DIRECTION NEAR SIDE

AESS CATEGORY-3

SHIPPING LIST / MATERIAL BILL

ITEM NO	TOTAL QTY	DESCRIPTION	MAJOR MARK	PAINT CODE	TOTAL WEIGHT	ABM NO	UNIT QTY	LENGTH FT.	LENGTH IN.	MINOR MARK	REMARKS	UNIT WEIGHT	GRADE
	ONE	VERTICAL BRACE	1412VB	G	20						Galv	20	
	1	L3x3x1/4			20		1	4	2 1/8	1412VB		20	A572-50
		FIELD BOLTS											
	4	3/4 Dia A325N						0	1 3/4		+1HD WASH		

Total weight : 20

REFERENCE :----

PAGE TOTALS

REVISION NO.

SPECIAL NOTES:-

MATERIAL:-
ASTM: A36 U.N.O.
S. S.: -----
ALUM.: -----
PIPE: A53 GR.B
TUBES: A500 GR.B
HOLES: 13/16 U.N.O
WELDING: E70XX

MATERIAL PREP.:-
CLEAN: SSPC-SP2
SHOP PAINT: TWO COAT OF STD SHOP PRIMER
GALV: GALVANIZED & PAINTED

GEN. NOTES:-
BUY AMERICAN:
DOMESTIC:
CERT/CONFORMANCE:
CERT/COMPLIANCE:

ALL WIDE FLANGE SHAPES TO BE PER A992-G50

FIELD CONNECTIONS :
HOLES : 13/16" U.N.O
PAINT :

morrow steel Fabricators, Inc.

3620 COPELAND DRIVE
ZEPHYRHILLS, FL. 33542

	PRINTS FOR	DATE	MK	REVISIONS	DATE
			0	RELEASED FOR APPROVAL	Nov 18 2025
			1	RELEASED FOR RE-APPROVAL	Jul 13 2026
			2	RELEASED FOR RE-APPROVAL	Aug 26 2026

STRUCTURE:- PINELLAS SUNCOAST TRANSIT AUTHORITY
LOCATION:- CLEARWATER STATION,CLEARWATER,FL.
DETAILER:- VECTORSHADES LLC
CUSTOMER:- KOKOLAKIS
ARCH./ENG.:- CDM SMITH
DESCRIPTION:- WAVE CANOPY VERTICAL BRACE DETAIL
DRAWN:- PBI DATE:- 10-27-2025 CHK.D:- RAG DATE:- 10-27-2025

SHOP BILL	WORK ORDER NO.	DRWG. NO.
	2553	1412

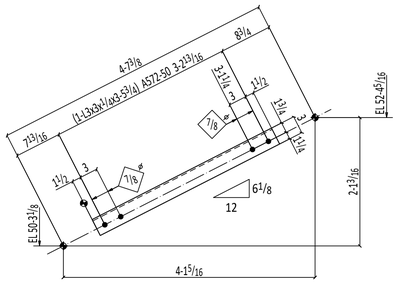

6 VERTICAL BRACES 1413VB -G

SHOP NOTE:
TOE DIRECTION FAR SIDE

SHIPPING LIST

MATERIAL BILL

ITEM NO	TOTAL QTY	DESCRIPTION	MAJOR MARK	PAINT CODE	TOTAL WEIGHT	ABM NO	UNIT QTY	LENGTH FT.	LENGTH IN.	MINOR MARK	REMARKS	UNIT WEIGHT	GRADE
	6	VERTICAL BRACE	1413VB	G	102						Galv	17	
	6	L3x3x1/4			102		1	3	5 3/4	1413VB		17	A572-50
		FIELD BOLTS											
	2	3/4 Dia A325N						0	1 3/4		+1HD WASH GALV		
	22	3/4 Dia A325N						0	1 1/2		+1HD WASH		

Total weight : 102

AISC CERTIFIED FABRICATOR AND ERECTOR

REFERENCE :----

PAGE TOTALS

REVISION NO.

SPECIAL NOTES:-

MATERIAL:-

ASTM: A36 U.N.O.
S.S.: -----
ALUM.: -----
PIPE: A53 GR.B
TUBES: A500 GR.B
HOLES: 13/16 U.N.O
WELDING: E70XX

MATERIAL PREP.:-

CLEAN: SSPC-SP2
SHOP PAINT: TWO COAT OF STD SHOP PRIMER
GALV: GALVANIZED & PAINTED

GEN. NOTES:-

BUY AMERICAN:
DOMESTIC:
CERT/CONFORMANCE:
CERT/COMPLIANCE:

ALL WIDE FLANGE SHAPES TO BE PER A992-G50

FIELD CONNECTIONS :
HOLES : 13/16" U.N.O
PAINT :

morrow steel Fabricators, Inc.

3620 COPELAND DRIVE
ZEPHYRHILLS, FL. 33542

	PRINTS FOR	DATE	MK	REVISIONS	DATE
			0	RELEASED FOR APPROVAL	Nov 18 2025
			1	RELEASED FOR RE-APPROVAL	Jul 13 2026
			2	RELEASED FOR RE-APPROVAL	Aug 26 2026

STRUCTURE:- PINELLAS SUNCOAST TRANSIT AUTHORITY
LOCATION:- CLEARWATER STATION,CLEARWATER,FL.
DETAILER:- VECTORSHADES LLC
CUSTOMER:- KOKOLAKIS
ARCH./ENG.:- CDM SMITH
DESCRIPTION:- WAVE CANOPY VERTICAL BRACE DETAIL
DRAWN:- PBI DATE:- 10-27-2025 CHK.D:- RAG DATE:- 10-27-2025

SHOP BILL	WORK ORDER NO.	DRWG. NO.
	2553	1413 1

SHIPPING LIST

MATERIAL BILL

ITEM NO	TOTAL QTY	DESCRIPTION	MAJOR MARK	PAINT CODE	TOTAL WEIGHT	ABM NO	UNIT QTY	LENGTH FT.	LENGTH IN.	MINOR MARK	REMARKS	UNIT WEIGHT	GRADE
	6	VERTICAL BRACE	1414VB	G	102						Galv	17	
	6	L3x3x1/4			102		1	3	5 13/16	1414VB		17	A572-50
		FIELD BOLTS											
	2	3/4 Dia A325N						0	1 3/4		+1HD WASH GALV		
	22	3/4 Dia A325N						0	1 1/2		+1HD WASH		

Total weight : 102

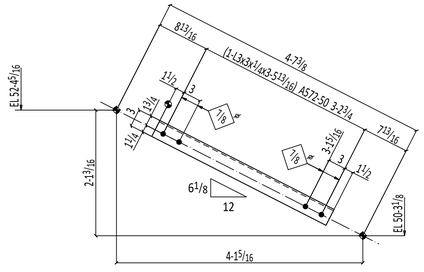

6 VERTICAL BRACES 1414VB -G

SHOP NOTE:
TOE DIRECTION FAR SIDE

REFERENCE :----

PAGE TOTALS

REVISION NO.

SPECIAL NOTES:-

MATERIAL:-
ASTM: A36 U.N.O.
S. S.: -----
ALUM.: -----
PIPE: A53 GR.B
TUBES: A500 GR.B
HOLES: 13/16 U.N.O
WELDING: E70XX

MATERIAL PREP.:-
CLEAN: SSPC-SP2
SHOP PAINT: TWO COAT OF STD SHOP PRIMER
GALV: GALVANIZED & PAINTED

GEN. NOTES:-
BUY AMERICAN:
DOMESTIC:
CERT/CONFORMANCE:
CERT/COMPLIANCE:

ALL WIDE FLANGE SHAPES TO BE PER A992-G50

FIELD CONNECTIONS :
HOLES : 13/16" U.N.O
PAINT :

morrow steel Fabricators, Inc.

3620 COPELAND DRIVE
ZEPHYRHILLS, FL. 33542

	PRINTS FOR	DATE	MK	REVISIONS	DATE
			0	RELEASED FOR APPROVAL	Nov 18 2025
			1	RELEASED FOR RE-APPROVAL	Jul 13 2026
			2	RELEASED FOR RE-APPROVAL	Aug 26 2026

STRUCTURE:- PINELLAS SUNCOAST TRANSIT AUTHORITY
LOCATION:- CLEARWATER STATION,CLEARWATER,FL.
DETAILER:- VECTORSHADES LLC
CUSTOMER:- KOKOLAKIS
ARCH./ENG.:- CDM SMITH
DESCRIPTION:- WAVE CANOPY VERTICAL BRACE DETAIL
DRAWN:- PBI DATE:- 10-27-2025 CHK.D:- RAG DATE:- 10-27-2025

SHOP BILL	WORK ORDER NO.	DRWG. NO.
	2553	1414

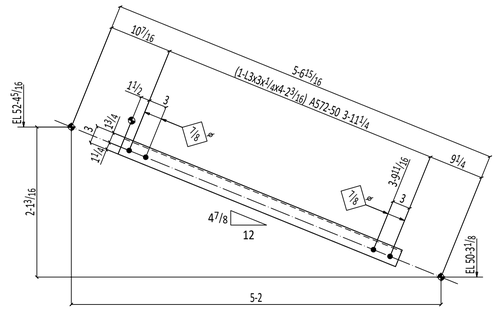

ONE VERTICAL BRACE 1415VB -G

SHOP NOTE:
TOE DIRECTION FAR SIDE

AESS CATEGORY-3

SHIPPING LIST

MATERIAL BILL

ITEM NO	TOTAL QTY	DESCRIPTION	MAJOR MARK	PAINT CODE	TOTAL WEIGHT	ABM NO	UNIT QTY	LENGTH FT.	LENGTH IN.	MINOR MARK	REMARKS	UNIT WEIGHT	GRADE
	ONE	VERTICAL BRACE	1415VB	G	21						Galv	21	
	1	L3x3x1/4			21		1	4	2 3/16	1415VB		21	A572-50
		FIELD BOLTS											
	4	3/4 Dia A325N						0	1 1/2		+1HD WASH		

Total weight : 21

REFERENCE :----

PAGE TOTALS

REVISION NO.

SPECIAL NOTES:-

MATERIAL:-

ASTM: A36 U.N.O.
S.S.: -----
ALUM.: -----
PIPE: A53 GR.B
TUBES: A500 GR.B
HOLES: 13/16 U.N.O
WELDING: E70XX

MATERIAL PREP.:-

CLEAN: SSPC-SP2
SHOP PAINT: TWO COAT OF STD SHOP PRIMER
GALV: GALVANIZED & PAINTED

GEN. NOTES:-

BUY AMERICAN:
DOMESTIC:
CERT/CONFORMANCE:
CERT/COMPLIANCE:

ALL WIDE FLANGE SHAPES TO BE PER A992-G50

FIELD CONNECTIONS :
HOLES : 13/16" U.N.O
PAINT :

morrow steel Fabricators, Inc.

3620 COPELAND DRIVE
ZEPHYRHILLS, FL. 33542

	PRINTS FOR	DATE	MK	REVISIONS	DATE
			0	RELEASED FOR APPROVAL	Nov 18 2025
			1	RELEASED FOR RE-APPROVAL	Jul 13 2026
			2	RELEASED FOR RE-APPROVAL	Aug 26 2026

STRUCTURE:- PINELLAS SUNCOAST TRANSIT AUTHORITY
LOCATION:- CLEARWATER STATION,CLEARWATER,FL.
DETAILER:- VECTORSHADES LLC
CUSTOMER:- KOKOLAKIS
ARCH./ENG.:- CDM SMITH
DESCRIPTION:- WAVE CANOPY VERTICAL BRACE DETAIL
DRAWN:- PBI DATE:- 10-27-2025 CHK.D:- RAG DATE:- 10-27-2025

SHOP BILL	WORK ORDER NO.	DRWG. NO.
	2553	1415

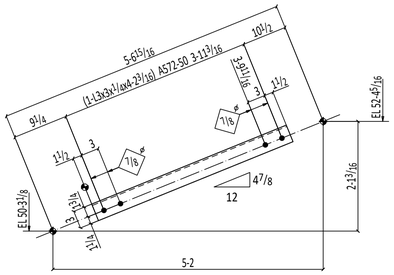

ONE VERTICAL BRACE 1416VB -G

SHOP NOTE:
TOE DIRECTION FAR SIDE

AESS CATEGORY-3

SHIPPING LIST

MATERIAL BILL

ITEM NO	TOTAL QTY	DESCRIPTION	MAJOR MARK	PAINT CODE	TOTAL WEIGHT	ABM NO	UNIT QTY	LENGTH FT.	LENGTH IN.	MINOR MARK	REMARKS	UNIT WEIGHT	GRADE
	ONE	VERTICAL BRACE	1416VB	G	21						Galv	21	
	1	L3x3x1/4			21		1	4	2 3/16	1416VB		21	A572-50
		FIELD BOLTS											
	4	3/4 Dia A325N						0	1 1/2		+1HD WASH		

Total weight : 21

REFERENCE :----

PAGE TOTALS

REVISION NO.

SPECIAL NOTES:-

MATERIAL:-

ASTM: A36 U.N.O.
S. S.: -----
ALUM.: -----
PIPE: A53 GR.B
TUBES: A500 GR.B
HOLES: 13/16 U.N.O
WELDING: E70XX

MATERIAL PREP.:-

CLEAN: SSPC-SP2
SHOP PAINT: TWO COAT OF STD SHOP PRIMER
GALV: GALVANIZED & PAINTED

GEN. NOTES:-

BUY AMERICAN:
DOMESTIC:
CERT/CONFORMANCE:
CERT/COMPLIANCE:

ALL WIDE FLANGE SHAPES TO BE PER A992-G50

FIELD CONNECTIONS :
HOLES : 13/16" U.N.O
PAINT :

morrow steel Fabricators, Inc.

3620 COPELAND DRIVE
ZEPHYRHILLS, FL. 33542

	PRINTS FOR	DATE	MK	REVISIONS	DATE
			0	RELEASED FOR APPROVAL	Nov 18 2025
			1	RELEASED FOR RE-APPROVAL	Jul 13 2026
			2	RELEASED FOR RE-APPROVAL	Aug 26 2026

STRUCTURE:- PINELLAS SUNCOAST TRANSIT AUTHORITY
LOCATION:- CLEARWATER STATION,CLEARWATER,FL.
DETAILER:- VECTORSHADES LLC.
CUSTOMER:- KOKOLAKIS
ARCH./ENG.:- CDM SMITH
DESCRIPTION:- WAVE CANOPY VERTICAL BRACE DETAIL
DRAWN:- PBI DATE:-10-27-2025 CHK.D:-RAG DATE:- 10-27-2025

SHOP BILL	WORK ORDER NO.	DRWG. NO.
	2553	1416

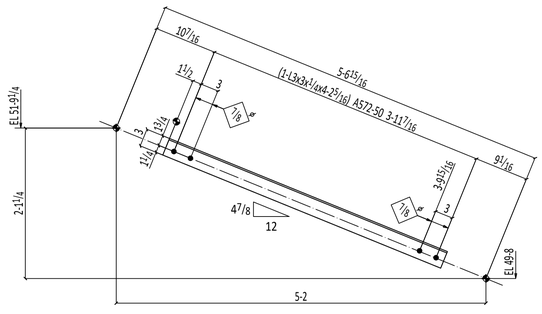

ONE VERTICAL BRACE 1417VB -G

SHOP NOTE:
TOE DIRECTION NEAR SIDE

AESS CATEGORY-3

SHIPPING LIST / MATERIAL BILL

ITEM NO	TOTAL QTY	DESCRIPTION	MAJOR MARK	PAINT CODE	TOTAL WEIGHT	ABM NO	UNIT QTY	LENGTH FT.	LENGTH IN.	MINOR MARK	REMARKS	UNIT WEIGHT	GRADE
	ONE	VERTICAL BRACE	1417VB	G	21						Galv	21	
	1	L3x3x1/4			21		1	4	25/16	1417VB		21	A572-50
		FIELD BOLTS											
	4	3/4 Dia A325N						0	13/4		+1HD WASH		

Total weight : 21

REFERENCE :----

PAGE TOTALS

REVISION NO.

SPECIAL NOTES:-

MATERIAL:-
ASTM: A36 U.N.O.
S. S.: -----
ALUM.: -----
PIPE: A53 GR.B
TUBES: A500 GR.B
HOLES: 13/16 U.N.O
WELDING: E70XX

MATERIAL PREP.:-
CLEAN: SSPC-SP2
SHOP PAINT: TWO COAT OF STD SHOP PRIMER
GALV: GALVANIZED & PAINTED

GEN. NOTES:-
BUY AMERICAN:
DOMESTIC:
CERT/CONFORMANCE:
CERT/COMPLIANCE:

ALL WIDE FLANGE SHAPES TO BE PER A992-G50

FIELD CONNECTIONS :
HOLES : 13/16" U.N.O
PAINT :

morrow steel Fabricators, Inc.

3620 COPELAND DRIVE
ZEPHYRHILLS, FL. 33542

	PRINTS FOR	DATE	MK	REVISIONS	DATE
			0	RELEASED FOR APPROVAL	Nov 18 2025
			1	RELEASED FOR RE-APPROVAL	Jul 13 2026
			2	RELEASED FOR RE-APPROVAL	Aug 26 2026

STRUCTURE:-PINELLAS SUNCOAST TRANSIT AUTHORITY
LOCATION:- CLEARWATER STATION,CLEARWATER,FL.
DETAILER:- VECTORSHADES LLC
CUSTOMER:- KOKOLAKIS
ARCH./ENG.:- CDM SMITH
DESCRIPTION:- WAVE CANOPY VERTICAL BRACE DETAIL
DRAWN:- PBI DATE:-10-27-2025 CHK.D:-RAG DATE:- 10-27-2025

SHOP BILL	WORK ORDER NO.	DRWG. NO.
	2553	1417 ⚠1

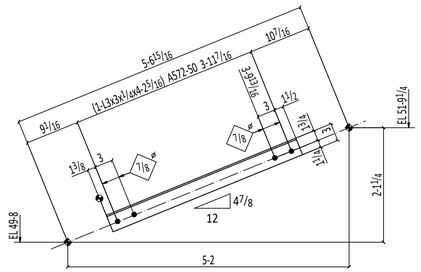

ONE VERTICAL BRACE 1418VB -G

SHOP NOTE:
TOE DIRECTION NEAR SIDE

AESS CATEGORY-3

SHIPPING LIST

MATERIAL BILL

ITEM NO	TOTAL QTY	DESCRIPTION	MAJOR MARK	PAINT CODE	TOTAL WEIGHT	ABM NO	UNIT QTY	LENGTH FT.	LENGTH IN.	MINOR MARK	REMARKS	UNIT WEIGHT	GRADE
	ONE	VERTICAL BRACE	1418VB	G	21						Galv	21	
	1	L3x3x1/4			21		1	4	25/16	1418VB		21	A572-50
		FIELD BOLTS											
	4	3/4 Dia A325N						0	1 3/4		+1HD WASH		

Total weight : 21

REFERENCE :----

PAGE TOTALS

REVISION NO.

SPECIAL NOTES:-

MATERIAL:-

ASTM: A36 U.N.O.
S.S.: -----
ALUM.: -----
PIPE: A53 GR.B
TUBES: A500 GR.B
HOLES: 13/16 U.N.O
WELDING: E70XX

MATERIAL PREP.:-

CLEAN: SSPC-SP2
SHOP PAINT: TWO COAT OF STD SHOP PRIMER
GALV: GALVANIZED & PAINTED

GEN. NOTES:-

BUY AMERICAN:
DOMESTIC:
CERT/CONFORMANCE:
CERT/COMPLIANCE:

ALL WIDE FLANGE SHAPES TO BE PER A992-G50

FIELD CONNECTIONS :
HOLES : 13/16" U.N.O
PAINT :

morrow steel Fabricators, Inc.

3620 COPELAND DRIVE
ZEPHYRHILLS, FL. 33542

	PRINTS FOR	DATE	MK	REVISIONS	DATE
			0	RELEASED FOR APPROVAL	Nov 18 2025
			1	RELEASED FOR RE-APPROVAL	Jul 13 2026
			2	RELEASED FOR RE-APPROVAL	Aug 26 2026

STRUCTURE:- PINELLAS SUNCOAST TRANSIT AUTHORITY
LOCATION:- CLEARWATER STATION,CLEARWATER,FL.
DETAILER:- VECTORSHADES LLC
CUSTOMER:- KOKOLAKIS
ARCH./ENG.:- CDM SMITH
DESCRIPTION:- WAVE CANOPY VERTICAL BRACE DETAIL
DRAWN:- PBI DATE:- 10-27-2025 CHK.D:- RAG DATE:- 10-27-2025

SHOP BILL	WORK ORDER NO.	DRWG. NO.
	2553	1418

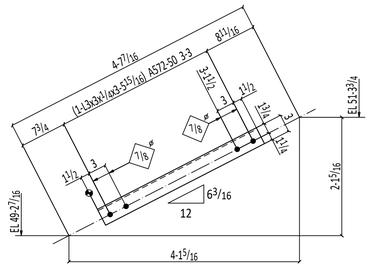

3 VERTICAL BRACES 1419VB -G

SHOP NOTE:
TOE DIRECTION FAR SIDE

SHIPPING LIST

MATERIAL BILL

ITEM NO	TOTAL QTY	DESCRIPTION	MAJOR MARK	PAINT CODE	TOTAL WEIGHT	ABM NO	UNIT QTY	LENGTH FT.	LENGTH IN.	MINOR MARK	REMARKS	UNIT WEIGHT	GRADE
	3	VERTICAL BRACE	1419VB	G	51						Galv	17	
	3	L3x3x1/4			51		1	3	5 15/16	1419VB		17	A572-50
		FIELD BOLTS											
	12	3/4 Dia A325N						0	1 3/4		+1HD WASH		

Total weight : 51

REFERENCE :----

PAGE TOTALS

REVISION NO.

SPECIAL NOTES:-

MATERIAL:-

ASTM: A36 U.N.O.
S. S.: -----
ALUM.: -----
PIPE: A53 GR.B
TUBES: A500 GR.B
HOLES: 13/16 U.N.O
WELDING: E70XX

MATERIAL PREP.:-

CLEAN: SSPC-SP2
SHOP PAINT: TWO COAT OF STD SHOP PRIMER
GALV: GALVANIZED & PAINTED

GEN. NOTES:-

BUY AMERICAN:
DOMESTIC:
CERT/CONFORMANCE:
CERT/COMPLIANCE:

ALL WIDE FLANGE SHAPES TO BE PER A992-G50

FIELD CONNECTIONS :
HOLES : 13/16" U.N.O
PAINT :

morrow steel Fabricators, Inc.

3620 COPELAND DRIVE
ZEPHYRHILLS, FL. 33542

	PRINTS FOR	DATE	MK	REVISIONS	DATE
			0	RELEASED FOR APPROVAL	Nov 18 2025
			1	RELEASED FOR RE-APPROVAL	Jul 13 2026
			2	RELEASED FOR RE-APPROVAL	Aug 26 2026

STRUCTURE:- PINELLAS SUNCOAST TRANSIT AUTHORITY
LOCATION:- CLEARWATER STATION,CLEARWATER,FL.
DETAILER:- VECTORSHADES LLC
CUSTOMER:- KOKOLAKIS
ARCH./ENG.:- CDM SMITH
DESCRIPTION:- WAVE CANOPY VERTICAL BRACE DETAIL
DRAWN:- PBI DATE:- 10-27-2025 CHK.D:- RAG DATE:- 10-27-2025

SHOP BILL	WORK ORDER NO.	DRWG. NO.
	2553	1419

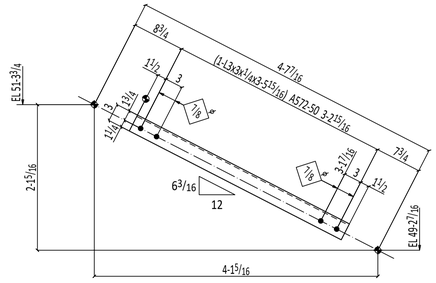

6 VERTICAL BRACES 1420VB -G

SHOP NOTE:
TOE DIRECTION FAR SIDE

SHIPPING LIST / MATERIAL BILL

ITEM NO	TOTAL QTY	DESCRIPTION	MAJOR MARK	PAINT CODE	TOTAL WEIGHT	ABM NO	UNIT QTY	LENGTH FT.	LENGTH IN.	MINOR MARK	REMARKS	UNIT WEIGHT	GRADE
	6	VERTICAL BRACE	1420VB	G	103						Galv	17	
	6	L3x3x1/4			103		1	3	5 15/16	1420VB		17	A572-50
		FIELD BOLTS											
	24	3/4 Dia A325N						0	1 3/4		+1HD WASH		

Total weight : 103

REFERENCE :----

PAGE TOTALS

REVISION NO.

SPECIAL NOTES:-

MATERIAL:-
ASTM: A36 U.N.O.
S. S.: -----
ALUM.: -----
PIPE: A53 GR.B
TUBES: A500 GR.B
HOLES: 13/16 U.N.O
WELDING: E70XX

MATERIAL PREP.:-
CLEAN: SSPC-SP2
SHOP PAINT: TWO COAT OF STD SHOP PRIMER
GALV: GALVANIZED & PAINTED

GEN. NOTES:-
BUY AMERICAN:
DOMESTIC:
CERT/CONFORMANCE:
CERT/COMPLIANCE:

ALL WIDE FLANGE SHAPES TO BE PER A992-G50

FIELD CONNECTIONS :
HOLES : 13/16" U.N.O
PAINT :

morrow steel Fabricators, Inc.

3620 COPELAND DRIVE
ZEPHYRHILLS, FL. 33542

	PRINTS FOR	DATE	MK	REVISIONS	DATE
			0	RELEASED FOR APPROVAL	Nov 18 2025
			1	RELEASED FOR RE-APPROVAL	Jul 13 2026
			2	RELEASED FOR RE-APPROVAL	Aug 26 2026

STRUCTURE:-PINELLAS SUNCOAST TRANSIT AUTHORITY
LOCATION:- CLEARWATER STATION,CLEARWATER,FL.
DETAILER:- VECTORSHADES LLC
CUSTOMER:- KOKOLAKIS
ARCH./ENG.:- CDM SMITH
DESCRIPTION:- WAVE CANOPY VERTICAL BRACE DETAIL
DRAWN:- PBI DATE:- 10-27-2025 CHK.D:- RAG DATE:- 10-27-2025

SHOP BILL	WORK ORDER NO.	DRWG. NO.
	2553	1420

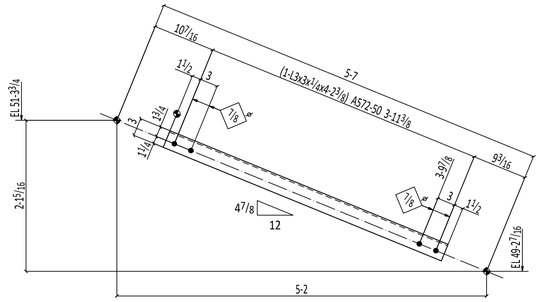

ONE VERTICAL BRACE 1421VB -G

SHOP NOTE:
TOE DIRECTION FAR SIDE

AESS CATEGORY-3

SHIPPING LIST / MATERIAL BILL

ITEM NO	TOTAL QTY	DESCRIPTION	MAJOR MARK	PAINT CODE	TOTAL WEIGHT	ABM NO	UNIT QTY	LENGTH FT.	LENGTH IN.	MINOR MARK	REMARKS	UNIT WEIGHT	GRADE
	ONE	VERTICAL BRACE	1421VB	G	21						Galv	21	
	1	L3x3x1/4			21		1	4	2 3/8	1421VB		21	A572-50
		FIELD BOLTS											
	4	3/4 Dia A325N						0	1 3/4		+1HD WASH		

Total weight : 21

REFERENCE :----

PAGE TOTALS

REVISION NO.

SPECIAL NOTES:-

MATERIAL:-

ASTM: A36 U.N.O.
S. S.: -----
ALUM.: -----
PIPE: A53 GR.B
TUBES: A500 GR.B
HOLES: 13/16 U.N.O
WELDING: E70XX

MATERIAL PREP.:-

CLEAN: SSPC-SP2
SHOP PAINT: TWO COAT OF STD SHOP PRIMER
GALV: GALVANIZED & PAINTED

GEN. NOTES:-

BUY AMERICAN:
DOMESTIC:
CERT/CONFORMANCE:
CERT/COMPLIANCE:

ALL WIDE FLANGE SHAPES TO BE PER A992-G50

FIELD CONNECTIONS :
HOLES : 13/16" U.N.O
PAINT :

morrow steel Fabricators, Inc.

3620 COPELAND DRIVE
ZEPHYRHILLS, FL. 33542

	PRINTS FOR	DATE	MK	REVISIONS	DATE
			0	RELEASED FOR APPROVAL	Nov 18 2025
			1	RELEASED FOR RE-APPROVAL	Jul 13 2026
			2	RELEASED FOR RE-APPROVAL	Aug 26 2026

STRUCTURE:- PINELLAS SUNCOAST TRANSIT AUTHORITY
LOCATION:- CLEARWATER STATION,CLEARWATER,FL.
DETAILER:- VECTORSHADES LLC
CUSTOMER:- KOKOLAKIS
ARCH./ENG.:- CDM SMITH
DESCRIPTION:- WAVE CANOPY VERTICAL BRACE DETAIL
DRAWN:- PBI DATE:-10-27-2025 CHK.D.-RAG DATE:- 10-27-2025

SHOP BILL	WORK ORDER NO.	DRWG. NO.
	2553	1421

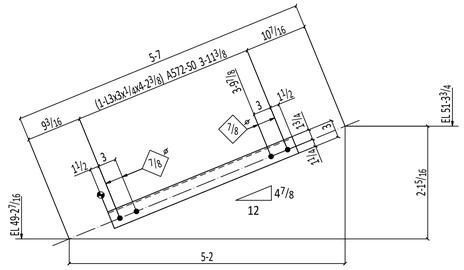

ONE VERTICAL BRACE 1422VB-G

SHOP NOTE:
TOE DIRECTION FAR SIDE

AESS CATEGORY-3

SHIPPING LIST

MATERIAL BILL

ITEM NO	TOTAL QTY	DESCRIPTION	MAJOR MARK	PAINT CODE	TOTAL WEIGHT	ABM NO	UNIT QTY	LENGTH FT.	LENGTH IN.	MINOR MARK	REMARKS	UNIT WEIGHT	GRADE
	ONE	VERTICAL BRACE	1422VB	G	21						Galv	21	
	1	L3x3x1/4			21		1	4	2 3/8	1422VB		21	A572-50
		FIELD BOLTS											
	4	3/4 Dia A325N						0	1 3/4		+1HD WASH		

Total weight : 21

REFERENCE :----

PAGE TOTALS

REVISION NO.

SPECIAL NOTES:-

MATERIAL:-

ASTM: A36 U.N.O.
S. S.: -----
ALUM.: -----
PIPE: A53 GR.B
TUBES: A500 GR.B
HOLES: 13/16 U.N.O
WELDING: E70XX

MATERIAL PREP.:-

CLEAN: SSPC-SP2
SHOP PAINT: TWO COAT OF STD SHOP PRIMER
GALV: GALVANIZED & PAINTED

GEN. NOTES:-

BUY AMERICAN:
DOMESTIC:
CERT/CONFORMANCE:
CERT/COMPLIANCE:

ALL WIDE FLANGE SHAPES TO BE PER A992-G50

FIELD CONNECTIONS :
HOLES : 13/16" U.N.O
PAINT :

morrow steel Fabricators, Inc.

3620 COPELAND DRIVE
ZEPHYRHILLS, FL. 33542

	PRINTS FOR	DATE	MK	REVISIONS	DATE
			0	RELEASED FOR APPROVAL	Nov 18 2025
			1	RELEASED FOR RE-APPROVAL	Jul 13 2026
			2	RELEASED FOR RE-APPROVAL	Aug 26 2026

STRUCTURE:- PINELLAS SUNCOAST TRANSIT AUTHORITY
LOCATION:- CLEARWATER STATION,CLEARWATER,FL.
DETAILER:- VECTORSHADES LLC
CUSTOMER:- KOKOLAKIS
ARCH./ENG.:- CDM SMITH
DESCRIPTION:- WAVE CANOPY VERTICAL BRACE DETAIL
DRAWN:- PBI DATE:-10-27-2025 CHK.D.-RAG DATE:- 10-27-2025

SHOP BILL	WORK ORDER NO.	DRWG. NO.
	2553	1422

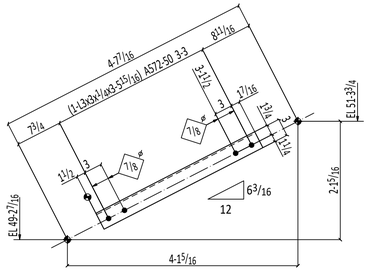

3 VERTICAL BRACES 1423VB -G

SHOP NOTE:
TOE DIRECTION FAR SIDE

SHIPPING LIST

MATERIAL BILL

ITEM NO	TOTAL QTY	DESCRIPTION	MAJOR MARK	PAINT CODE	TOTAL WEIGHT	ABM NO	UNIT QTY	LENGTH FT.	LENGTH IN.	MINOR MARK	REMARKS	UNIT WEIGHT	GRADE
	3	VERTICAL BRACE	1423VB	G	51						Galv	17	
	3	L3x3x1/4			51		1	3	5 15/16	1423VB		17	A572-50
		FIELD BOLTS											
	12	3/4 Dia A325N						0	1 3/4		+1HD WASH		

Total weight : 51

REFERENCE :----

PAGE TOTALS

REVISION NO.

SPECIAL NOTES:-

MATERIAL:-

ASTM: A36 U.N.O.
S. S.: -----
ALUM.: -----
PIPE: A53 GR.B
TUBES: A500 GR.B
HOLES: 13/16 U.N.O
WELDING: E70XX

MATERIAL PREP.:-

CLEAN: SSPC-SP2
SHOP PAINT: TWO COAT OF STD SHOP PRIMER
GALV: GALVANIZED & PAINTED

GEN. NOTES:-

BUY AMERICAN:
DOMESTIC:
CERT/CONFORMANCE:
CERT/COMPLIANCE:

ALL WIDE FLANGE SHAPES TO BE PER A992-G50

FIELD CONNECTIONS :
HOLES : 13/16" U.N.O
PAINT :

morrow steel Fabricators, Inc.

3620 COPELAND DRIVE
ZEPHYRHILLS, FL. 33542

	PRINTS FOR	DATE	MK	REVISIONS	DATE
			0	RELEASED FOR APPROVAL	Nov 18 2025
			1	RELEASED FOR RE-APPROVAL	Jul 13 2026
			2	RELEASED FOR RE-APPROVAL	Aug 26 2026

STRUCTURE:-PINELLAS SUNCOAST TRANSIT AUTHORITY
LOCATION:- CLEARWATER STATION,CLEARWATER,FL.
DETAILER:- VECTORSHADES LLC
CUSTOMER:- KOKOLAKIS
ARCH./ENG.:- CDM SMITH
DESCRIPTION:- WAVE CANOPY VERTICAL BRACE DETAIL
DRAWN:- PBI DATE:- 10-27-2025 CHK.D:- RAG DATE:- 10-27-2025

SHOP BILL	WORK ORDER NO.	DRWG. NO.
	2553	1423

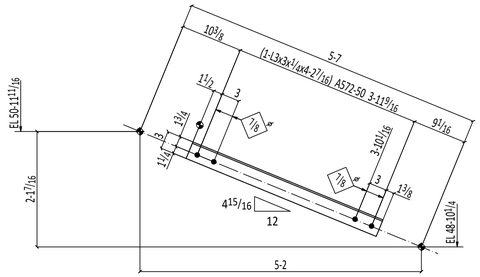

ONE VERTICAL BRACE 1424VB -G

SHOP NOTE:
TOE DIRECTION NEAR SIDE

AESS CATEGORY-3

SHIPPING LIST

MATERIAL BILL

ITEM NO	TOTAL QTY	DESCRIPTION	MAJOR MARK	PAINT CODE	TOTAL WEIGHT	ABM NO	UNIT QTY	LENGTH FT.	LENGTH IN.	MINOR MARK	REMARKS	UNIT WEIGHT	GRADE
	ONE	VERTICAL BRACE	1424VB	G	21						Galv	21	
	1	L3x3x1/4			21		1	4	27/16	1424VB		21	A572-50
		FIELD BOLTS											
	4	3/4 Dia A325N						0	13/4		+1HD WASH		

Total weight : 21

REFERENCE :----

PAGE TOTALS

REVISION NO.

SPECIAL NOTES:-

MATERIAL:-
ASTM: A36 U.N.O.
S. S.: -----
ALUM.: -----
PIPE: A53 GR.B
TUBES: A500 GR.B
HOLES: 13/16 U.N.O
WELDING: E70XX

MATERIAL PREP.:-
CLEAN: SSPC-SP2
SHOP PAINT: TWO COAT OF STD SHOP PRIMER
GALV: GALVANIZED & PAINTED

GEN. NOTES:-
BUY AMERICAN:
DOMESTIC:
CERT/CONFORMANCE:
CERT/COMPLIANCE:

ALL WIDE FLANGE SHAPES TO BE PER A992-G50

FIELD CONNECTIONS :
HOLES : 13/16" U.N.O
PAINT :

morrow steel Fabricators, Inc.

3620 COPELAND DRIVE
ZEPHYRHILLS, FL. 33542

	PRINTS FOR	DATE	MK	REVISIONS	DATE
			0	RELEASED FOR APPROVAL	Nov 18 2025
			1	RELEASED FOR RE-APPROVAL	Jul 13 2026
			2	RELEASED FOR RE-APPROVAL	Aug 26 2026

STRUCTURE:- PINELLAS SUNCOAST TRANSIT AUTHORITY
LOCATION:- CLEARWATER STATION,CLEARWATER,FL.
DETAILER:- VECTORSHADES LLC
CUSTOMER:- KOKOLAKIS
ARCH./ENG.:- CDM SMITH
DESCRIPTION:- WAVE CANOPY VERTICAL BRACE DETAIL
DRAWN:- PBI DATE:- 10-27-2025 CHK.D:- RAG DATE:- 10-27-2025

SHOP BILL	WORK ORDER NO.	DRWG. NO.
	2553	1424 ⚠1

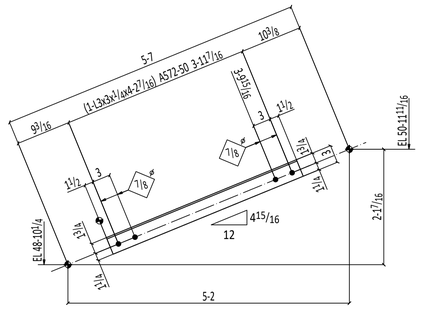

ONE VERTICAL BRACE 1425VB -G

SHOP NOTE:
TOE DIRECTION NEAR SIDE

AESS CATEGORY-3

SHIPPING LIST

MATERIAL BILL

ITEM NO	TOTAL QTY	DESCRIPTION	MAJOR MARK	PAINT CODE	TOTAL WEIGHT	ABM NO	UNIT QTY	LENGTH FT.	LENGTH IN.	MINOR MARK	REMARKS	UNIT WEIGHT	GRADE
	ONE	VERTICAL BRACE	1425VB	G	21						Galv	21	
	1	L3x3x1/4			21		1	4	27/16	1425VB		21	A572-50
		FIELD BOLTS											
	4	3/4 Dia A325N						0	13/4		+1HD WASH		

Total weight : 21

REFERENCE :----

PAGE TOTALS

REVISION NO.

SPECIAL NOTES:-

MATERIAL:-
ASTM: A36 U.N.O.
S. S.: -----
ALUM.: -----
PIPE: A53 GR.B
TUBES: A500 GR.B
HOLES: 13/16 U.N.O
WELDING: E70XX

MATERIAL PREP.:-
CLEAN: SSPC-SP2
SHOP PAINT: TWO COAT OF STD SHOP PRIMER
GALV: GALVANIZED & PAINTED

GEN. NOTES:-
BUY AMERICAN:
DOMESTIC:
CERT/CONFORMANCE:
CERT/COMPLIANCE:

ALL WIDE FLANGE SHAPES TO BE PER A992-G50

FIELD CONNECTIONS :
HOLES : 13/16" U.N.O
PAINT :

morrow steel Fabricators, Inc.

3620 COPELAND DRIVE
ZEPHYRHILLS, FL. 33542

	PRINTS FOR	DATE	MK	REVISIONS	DATE
			0	RELEASED FOR APPROVAL	Nov 18 2025
			1	RELEASED FOR RE-APPROVAL	Jul 13 2026
			2	RELEASED FOR RE-APPROVAL	Aug 26 2026

STRUCTURE:-PINELLAS SUNCOAST TRANSIT AUTHORITY
LOCATION:- CLEARWATER STATION,CLEARWATER,FL.
DETAILER:- VECTORSHADES LLC
CUSTOMER:- KOKOLAKIS
ARCH./ENG.:- CDM SMITH
DESCRIPTION:- WAVE CANOPY VERTICAL BRACE DETAIL
DRAWN:- PBI DATE:- 10-27-2025 CHK.D:- RAG DATE:- 10-27-2025

SHOP BILL	WORK ORDER NO.	DRWG. NO.
	2553	1425

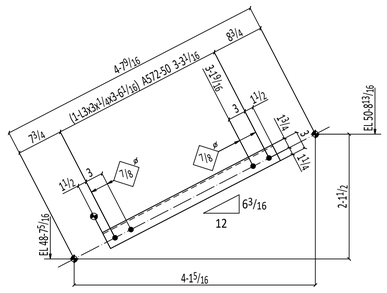

6 VERTICAL BRACES 1426VB -G

SHOP NOTE:
TOE DIRECTION FAR SIDE

SHIPPING LIST

MATERIAL BILL

ITEM NO	TOTAL QTY	DESCRIPTION	MAJOR MARK	PAINT CODE	TOTAL WEIGHT	ABM NO	UNIT QTY	LENGTH FT.	LENGTH IN.	MINOR MARK	REMARKS	UNIT WEIGHT	GRADE
	6	VERTICAL BRACE	1426VB	G	103						Galv	17	
	6	L3x3x1/4			103		1	3	6 1/16	1426VB		17	A572-50
		FIELD BOLTS											
	24	3/4 Dia A325N						0	1 3/4		+1HD WASH		

Total weight : 103

REFERENCE :----

PAGE TOTALS

REVISION NO.

SPECIAL NOTES:-

MATERIAL:-

ASTM: A36 U.N.O.
S. S.: -----
ALUM.: -----
PIPE: A53 GR.B
TUBES: A500 GR.B
HOLES: 13/16 U.N.O
WELDING: E70XX

MATERIAL PREP.:-

CLEAN: SSPC-SP2
SHOP PAINT: TWO COAT OF STD SHOP PRIMER
GALV: GALVANIZED & PAINTED

GEN. NOTES:-

BUY AMERICAN:
DOMESTIC:
CERT/CONFORMANCE:
CERT/COMPLIANCE:

ALL WIDE FLANGE SHAPES TO BE PER A992-G50

FIELD CONNECTIONS :
HOLES : 13/16" U.N.O
PAINT :

morrow steel Fabricators, Inc.

3620 COPELAND DRIVE
ZEPHYRHILLS, FL. 33542

	PRINTS FOR	DATE	MK	REVISIONS	DATE
			0	RELEASED FOR APPROVAL	Nov 18 2025
			1	RELEASED FOR RE-APPROVAL	Jul 13 2026
			2	RELEASED FOR RE-APPROVAL	Aug 26 2026

STRUCTURE:- PINELLAS SUNCOAST TRANSIT AUTHORITY
LOCATION:- CLEARWATER STATION,CLEARWATER,FL.
DETAILER:- VECTORSHADES LLC
CUSTOMER:- KOKOLAKIS
ARCH./ENG.:- CDM SMITH
DESCRIPTION:- WAVE CANOPY VERTICAL BRACE DETAIL
DRAWN:- PBI DATE:- 10-27-2025 CHK.D:- RAG DATE:- 10-27-2025

SHOP BILL	WORK ORDER NO.	DRWG. NO.
	2553	1426

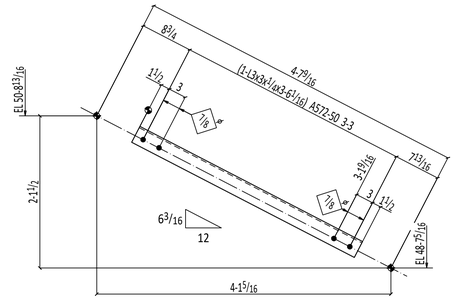

6 VERTICAL BRACES 1427VB -G

SHOP NOTE:
TOE DIRECTION FAR SIDE

SHIPPING LIST / MATERIAL BILL

ITEM NO	TOTAL QTY	DESCRIPTION	MAJOR MARK	PAINT CODE	TOTAL WEIGHT	ABM NO	UNIT QTY	LENGTH FT.	LENGTH IN.	MINOR MARK	REMARKS	UNIT WEIGHT	GRADE
	6	VERTICAL BRACE	1427VB	G	103						Galv	17	
	6	L3x3x1/4			103		1	3	6 1/16	1427VB		17	A572-50
		FIELD BOLTS											
	22	3/4 Dia A325N						0	1 3/4		+1HD WASH		

Total weight : 103

REFERENCE :----

PAGE TOTALS

REVISION NO.

SPECIAL NOTES:-

MATERIAL:-

ASTM:	A36 U.N.O.
S. S.:	-----
ALUM.:	-----
PIPE:	A53 GR.B
TUBES:	A500 GR.B
HOLES:	13/16 U.N.O
WELDING:	E70XX

MATERIAL PREP.:-

CLEAN:	SSPC-SP2
SHOP PAINT:	TWO COAT OF STD SHOP PRIMER
GALV:	GALVANIZED & PAINTED

GEN. NOTES:-

BUY AMERICAN:
DOMESTIC:
CERT/CONFORMANCE:
CERT/COMPLIANCE:

ALL WIDE FLANGE SHAPES TO BE PER A992-G50

FIELD CONNECTIONS :
HOLES : 13/16" U.N.O
PAINT :

morrow steel Fabricators, Inc.

3620 COPELAND DRIVE
ZEPHYRHILLS, FL. 33542

	PRINTS FOR	DATE	MK	REVISIONS	DATE
			0	RELEASED FOR APPROVAL	Nov 18 2025
			1	RELEASED FOR RE-APPROVAL	Jul 13 2026
			2	RELEASED FOR RE-APPROVAL	Aug 26 2026

STRUCTURE:- PINELLAS SUNCOAST TRANSIT AUTHORITY
LOCATION:- CLEARWATER STATION,CLEARWATER,FL.
DETAILER:- VECTORSHADES LLC
CUSTOMER:- KOKOLAKIS
ARCH./ENG.:- CDM SMITH
DESCRIPTION:- WAVE CANOPY VERTICAL BRACE DETAIL
DRAWN:- PBI DATE:- 10-27-2025 CHK.D.- RAG DATE:- 10-27-2025

SHOP BILL	WORK ORDER NO.	DRWG. NO.
	2553	1427

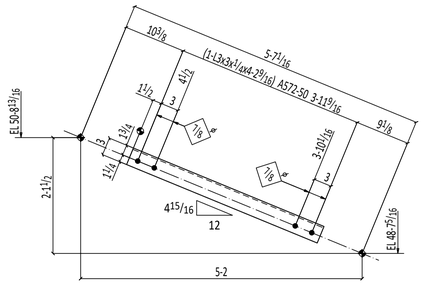

ONE VERTICAL BRACE 1428VB-G

SHOP NOTE:
TOE DIRECTION FAR SIDE

AESS CATEGORY-3

SHIPPING LIST / MATERIAL BILL

ITEM NO	TOTAL QTY	DESCRIPTION	MAJOR MARK	PAINT CODE	TOTAL WEIGHT	ABM NO	UNIT QTY	LENGTH FT.	LENGTH IN.	MINOR MARK	REMARKS	UNIT WEIGHT	GRADE
	ONE	VERTICAL BRACE	1428VB	G	21						Galv	21	
	1	L3x3x1/4			21		1	4	29/16	1428VB		21	A572-50
		FIELD BOLTS											
	2	3/4 Dia A325N						0	2		+1HD WASH		
	2	3/4 Dia A325N						0	13/4		+1HD WASH		

Total weight : 21

REFERENCE :----

PAGE TOTALS

REVISION NO.

SPECIAL NOTES:-

MATERIAL:-
ASTM: A36 U.N.O.
S. S.: -----
ALUM.: -----
PIPE: A53 GR.B
TUBES: A500 GR.B
HOLES: 13/16 U.N.O
WELDING: E70XX

MATERIAL PREP.:-
CLEAN: SSPC-SP2
SHOP PAINT: TWO COAT OF STD SHOP PRIMER
GALV: GALVANIZED & PAINTED

GEN. NOTES:-
BUY AMERICAN:
DOMESTIC:
CERT/CONFORMANCE:
CERT/COMPLIANCE:

ALL WIDE FLANGE SHAPES TO BE PER A992-G50

FIELD CONNECTIONS :
HOLES : 13/16" U.N.O
PAINT :

morrow steel Fabricators, Inc.

3620 COPELAND DRIVE
ZEPHYRHILLS, FL. 33542

PRINTS FOR	DATE	MK	REVISIONS	DATE
		0	RELEASED FOR APPROVAL	Nov 18 2025
		1	RELEASED FOR RE-APPROVAL	Jul 13 2026
		2	RELEASED FOR RE-APPROVAL	Aug 26 2026

STRUCTURE:- PINELLAS SUNCOAST TRANSIT AUTHORITY
LOCATION:- CLEARWATER STATION,CLEARWATER,FL.
DETAILER:- VECTORSHADES LLC
CUSTOMER:- KOKOLAKIS
ARCH./ENG.:- CDM SMITH
DESCRIPTION:- WAVE CANOPY VERTICAL BRACE DETAIL
DRAWN:- PBI DATE:- 10-27-2025 CHK.D:- RAG DATE:- 10-27-2025

SHOP BILL	WORK ORDER NO.	DRWG. NO.
	2553	1428

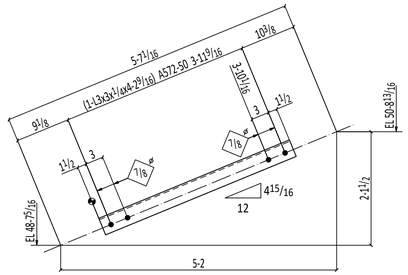

ONE VERTICAL BRACE 1429VB -G

SHOP NOTE:
TOE DIRECTION FAR SIDE

AESS CATEGORY-3

SHIPPING LIST / MATERIAL BILL

ITEM NO	TOTAL QTY	DESCRIPTION	MAJOR MARK	PAINT CODE	TOTAL WEIGHT	ABM NO	UNIT QTY	LENGTH FT.	LENGTH IN.	MINOR MARK	REMARKS	UNIT WEIGHT	GRADE
	ONE	VERTICAL BRACE	1429VB	G	21						Galv	21	
	1	L3x3x1/4			21		1	4	29/16	1429VB		21	A572-50
		FIELD BOLTS											
	4	3/4 Dia A325N						0	1 3/4		+1HD WASH		

Total weight : 21

REFERENCE :----

PAGE TOTALS

REVISION NO.

SPECIAL NOTES:-

MATERIAL:-
ASTM: A36 U.N.O.
S. S.: -----
ALUM.: -----
PIPE: A53 GR.B
TUBES: A500 GR.B
HOLES: 13/16 U.N.O
WELDING: E70XX

MATERIAL PREP.:-
CLEAN: SSPC-SP2
SHOP PAINT: TWO COAT OF STD SHOP PRIMER
GALV: GALVANIZED & PAINTED

GEN. NOTES:-
BUY AMERICAN:
DOMESTIC:
CERT/CONFORMANCE:
CERT/COMPLIANCE:

ALL WIDE FLANGE SHAPES TO BE PER A992-G50

FIELD CONNECTIONS :
HOLES : 13/16" U.N.O
PAINT :

morrow steel Fabricators, Inc.

3620 COPELAND DRIVE
ZEPHYRHILLS, FL. 33542

	PRINTS FOR	DATE	MK	REVISIONS	DATE
			0	RELEASED FOR APPROVAL	Nov 18 2025
			1	RELEASED FOR RE-APPROVAL	Jul 13 2026
			2	RELEASED FOR RE-APPROVAL	Aug 26 2026

STRUCTURE:- PINELLAS SUNCOAST TRANSIT AUTHORITY
LOCATION:- CLEARWATER STATION,CLEARWATER,FL.
DETAILER:- VECTORSHADES LLC
CUSTOMER:- KOKOLAKIS
ARCH./ENG.:- CDM SMITH
DESCRIPTION:- WAVE CANOPY VERTICAL BRACE DETAIL
DRAWN:- PBI DATE:-10-27-2025 CHK.D.-RAG DATE:- 10-27-2025

SHOP BILL	WORK ORDER NO.	DRWG. NO.
	2553	1429

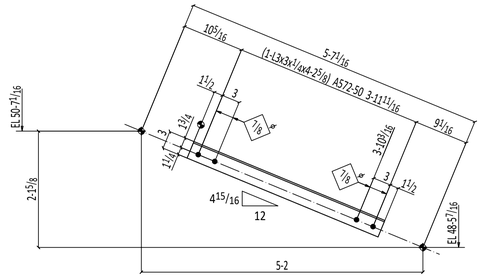

ONE VERTICAL BRACE 1430VB -G

SHOP NOTE:
TOE DIRECTION NEAR SIDE

AESS CATEGORY-3

SHIPPING LIST / MATERIAL BILL

ITEM NO	TOTAL QTY	DESCRIPTION	MAJOR MARK	PAINT CODE	TOTAL WEIGHT	ABM NO	UNIT QTY	LENGTH FT.	LENGTH IN.	MINOR MARK	REMARKS	UNIT WEIGHT	GRADE
	ONE	VERTICAL BRACE	1430VB	G	21						Galv	21	
	1	L3x3x1/4			21		1	4	2 5/8	1430VB		21	A572-50
		FIELD BOLTS											
	4	3/4 Dia A325N						0	1 3/4		+1HD WASH		

Total weight : 21

REFERENCE :----

PAGE TOTALS

REVISION NO.

SPECIAL NOTES:-

MATERIAL:-
ASTM: A36 U.N.O.
S. S.: -----
ALUM.: -----
PIPE: A53 GR.B
TUBES: A500 GR.B
HOLES: 13/16 U.N.O
WELDING: E70XX

MATERIAL PREP.:-
CLEAN: SSPC-SP2
SHOP PAINT: TWO COAT OF STD SHOP PRIMER
GALV: GALVANIZED & PAINTED

GEN. NOTES:-
BUY AMERICAN:
DOMESTIC:
CERT/CONFORMANCE:
CERT/COMPLIANCE:

ALL WIDE FLANGE SHAPES TO BE PER A992-G50

FIELD CONNECTIONS :
HOLES : 13/16" U.N.O
PAINT :

morrow steel Fabricators, Inc.

3620 COPELAND DRIVE
ZEPHYRHILLS, FL. 33542

	PRINTS FOR	DATE	MK	REVISIONS	DATE
			0	RELEASED FOR APPROVAL	Nov 18 2025
			1	RELEASED FOR RE-APPROVAL	Jul 13 2026
			2	RELEASED FOR RE-APPROVAL	Aug 26 2026

STRUCTURE:- PINELLAS SUNCOAST TRANSIT AUTHORITY
LOCATION:- CLEARWATER STATION,CLEARWATER,FL.
DETAILER:- VECTORSHADES LLC
CUSTOMER:- KOKOLAKIS
ARCH./ENG.:- CDM SMITH
DESCRIPTION:- WAVE CANOPY VERTICAL BRACE DETAIL
DRAWN:- PBI DATE:-10-27-2025 CHK.D.-RAG DATE:- 10-27-2025

SHOP BILL	WORK ORDER NO.	DRWG. NO.
	2553	1430

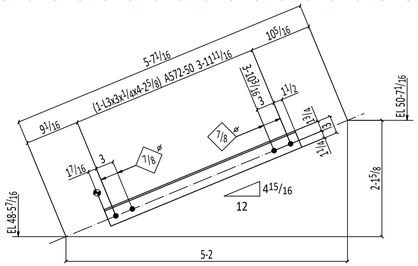

ONE VERTICAL BRACE 1431VB-G

SHOP NOTE:
TOE DIRECTION NEAR SIDE

AESS CATEGORY-3

SHIPPING LIST

MATERIAL BILL

ITEM NO	TOTAL QTY	DESCRIPTION	MAJOR MARK	PAINT CODE	TOTAL WEIGHT	ABM NO	UNIT QTY	LENGTH FT.	LENGTH IN.	MINOR MARK	REMARKS	UNIT WEIGHT	GRADE
	ONE	VERTICAL BRACE	1431VB	G	21						Galv	21	
	1	L3x3x1/4			21		1	4	2 5/8	1431VB		21	A572-50
		FIELD BOLTS											
	4	3/4 Dia A325N						0	1 3/4		+1HD WASH		

Total weight : 21

REFERENCE :----

PAGE TOTALS

REVISION NO.

SPECIAL NOTES:-

MATERIAL:-

ASTM: A36 U.N.O.
S.S.: -----
ALUM.: -----
PIPE: A53 GR.B
TUBES: A500 GR.B
HOLES: 13/16 U.N.O
WELDING: E70XX

MATERIAL PREP.:-

CLEAN: SSPC-SP2
SHOP PAINT: TWO COAT OF STD SHOP PRIMER
GALV: GALVANIZED & PAINTED

GEN. NOTES:-

BUY AMERICAN:
DOMESTIC:
CERT/CONFORMANCE:
CERT/COMPLIANCE:

ALL WIDE FLANGE SHAPES TO BE PER A992-G50

FIELD CONNECTIONS :
HOLES : 13/16" U.N.O
PAINT :

morrow steel Fabricators, Inc.

3620 COPELAND DRIVE
ZEPHYRHILLS, FL. 33542

	PRINTS FOR	DATE	MK	REVISIONS	DATE
			0	RELEASED FOR APPROVAL	Nov 18 2025
			1	RELEASED FOR RE-APPROVAL	Jul 13 2026
			2	RELEASED FOR RE-APPROVAL	Aug 26 2026

STRUCTURE:- PINELLAS SUNCOAST TRANSIT AUTHORITY
LOCATION:- CLEARWATER STATION,CLEARWATER,FL.
DETAILER:- VECTORSHADES LLC
CUSTOMER:- KOKOLAKIS
ARCH./ENG.:- CDM SMITH
DESCRIPTION:- WAVE CANOPY VERTICAL BRACE DETAIL
DRAWN:- PBI DATE:- 10-27-2025 CHK.D:- RAG DATE:- 10-27-2025

SHOP BILL	WORK ORDER NO.	DRWG. NO.
	2553	1431

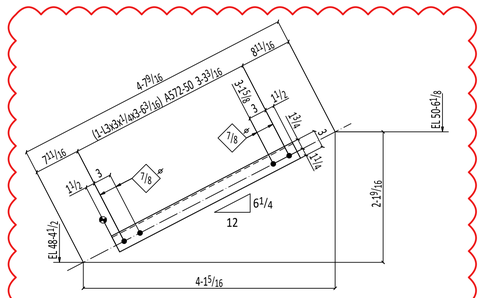

5 VERTICAL BRACES 1432VB -G

SHOP NOTE:
TOE DIRECTION FAR SIDE

SHIPPING LIST / MATERIAL BILL

ITEM NO	TOTAL QTY	DESCRIPTION	MAJOR MARK	PAINT CODE	TOTAL WEIGHT	ABM NO	UNIT QTY	LENGTH FT.	LENGTH IN.	MINOR MARK	REMARKS	UNIT WEIGHT	GRADE
	5	VERTICAL BRACE	1432VB	G	86						Galv	17	
	5	L3x3x1/4			86		1	3	6 3/16	1432VB		17	A572-50
		FIELD BOLTS											
	20	3/4 Dia A325N						0	1 3/4		+1HD WASH		

Total weight : 86

REFERENCE :----

PAGE TOTALS

REVISION NO.

SPECIAL NOTES:-

MATERIAL:-
ASTM: A36 U.N.O.
S. S.: -----
ALUM.: -----
PIPE: A53 GR.B
TUBES: A500 GR.B
HOLES: 13/16 U.N.O
WELDING: E70XX

MATERIAL PREP.:-
CLEAN: SSPC-SP2
SHOP PAINT: TWO COAT OF STD SHOP PRIMER
GALV: GALVANIZED & PAINTED

GEN. NOTES:-
BUY AMERICAN:
DOMESTIC:
CERT/CONFORMANCE:
CERT/COMPLIANCE:

ALL WIDE FLANGE SHAPES TO BE PER A992-G50

FIELD CONNECTIONS :
HOLES : 13/16" U.N.O
PAINT :

morrow steel Fabricators, Inc.

3620 COPELAND DRIVE
ZEPHYRHILLS, FL. 33542

	PRINTS FOR	DATE	MK	REVISIONS	DATE
			0	RELEASED FOR APPROVAL	Nov 18 2025
			1	RELEASED FOR RE-APPROVAL	Jul 13 2026
			2	RELEASED FOR RE-APPROVAL	Aug 26 2026

STRUCTURE:-PINELLAS SUNCOAST TRANSIT AUTHORITY
LOCATION:- CLEARWATER STATION,CLEARWATER,FL.
DETAILER:- VECTORSHADES LLC
CUSTOMER:- KOKOLAKIS
ARCH./ENG.:- CDM SMITH
DESCRIPTION:-WAVE CANOPY VERTICAL BRACE DETAIL
DRAWN:- PBI DATE:-10-27-2025 CHK.D:-RAG DATE:- 10-27-2025

SHOP BILL	WORK ORDER NO.	DRWG. NO.
	2553	1432

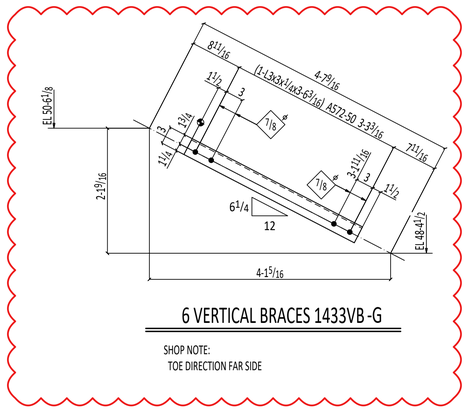

6 VERTICAL BRACES 1433VB -G

SHOP NOTE:
TOE DIRECTION FAR SIDE

SHIPPING LIST

MATERIAL BILL

ITEM NO	TOTAL QTY	DESCRIPTION	MAJOR MARK	PAINT CODE	TOTAL WEIGHT	ABM NO	UNIT QTY	LENGTH FT.	LENGTH IN.	MINOR MARK	REMARKS	UNIT WEIGHT	GRADE
	6	VERTICAL BRACE	1433VB	G	103						Galv	17	
	6	L3x3x1/4			103		1	3	6 3/16	1433VB		17	A572-50
		FIELD BOLTS											
	24	3/4 Dia A325N						0	1 3/4		+1HD WASH		

Total weight : 103

REFERENCE :----

PAGE TOTALS

REVISION NO.

SPECIAL NOTES:-

MATERIAL:-

ASTM: A36 U.N.O.
S. S.: -----
ALUM.: -----
PIPE: A53 GR.B
TUBES: A500 GR.B
HOLES: 13/16 U.N.O
WELDING: E70XX

MATERIAL PREP.:-

CLEAN: SSPC-SP2
SHOP PAINT: TWO COAT OF STD SHOP PRIMER
GALV: GALVANIZED & PAINTED

GEN. NOTES:-

BUY AMERICAN:
DOMESTIC:
CERT/CONFORMANCE:
CERT/COMPLIANCE:

ALL WIDE FLANGE SHAPES TO BE PER A992-G50

FIELD CONNECTIONS :
HOLES : 13/16" U.N.O
PAINT :

morrow steel Fabricators, Inc.

3620 COPELAND DRIVE
ZEPHYRHILLS, FL. 33542

PRINTS FOR	DATE	MK	REVISIONS	DATE
		0	RELEASED FOR APPROVAL	Nov 18 2025
		1	RELEASED FOR RE-APPROVAL	Jul 13 2026
		2	RELEASED FOR RE-APPROVAL	Aug 26 2026

STRUCTURE:- PINELLAS SUNCOAST TRANSIT AUTHORITY
LOCATION:- CLEARWATER STATION,CLEARWATER,FL.
DETAILER:- VECTORSHADES LLC.
CUSTOMER:- KOKOLAKIS
ARCH./ENG.:- CDM SMITH
DESCRIPTION:- WAVE CANOPY VERTICAL BRACE DETAIL
DRAWN:- PBI DATE:-10-27-2025 CHK.D:-RAG DATE:- 10-27-2025

SHOP BILL	WORK ORDER NO.	DRWG. NO.
	2553	1433

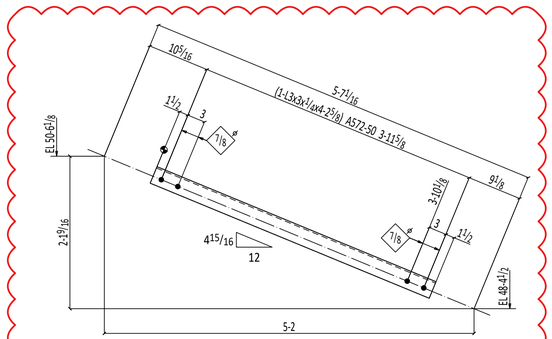

ONE VERTICAL BRACE 1434VB -G

SHOP NOTE:
TOE DIRECTION FAR SIDE

AESS CATEGORY-3

SHIPPING LIST

MATERIAL BILL

ITEM NO	TOTAL QTY	DESCRIPTION	MAJOR MARK	PAINT CODE	TOTAL WEIGHT	ABM NO	UNIT QTY	LENGTH FT.	LENGTH IN.	MINOR MARK	REMARKS	UNIT WEIGHT	GRADE
	ONE	VERTICAL BRACE	1434VB	G	21						Galv	21	
	1	L3x3x1/4			21		1	4	2 5/8	1434VB		21	A572-50
		FIELD BOLTS											
	4	3/4 Dia A325N						0	1 3/4		+1HD WASH		

Total weight : 21

REFERENCE :----

PAGE TOTALS

REVISION NO.

SPECIAL NOTES:-

MATERIAL:-

ASTM:	A36 U.N.O.
S. S.:	-----
ALUM.:	-----
PIPE:	A53 GR.B
TUBES:	A500 GR.B
HOLES:	13/16 U.N.O
WELDING:	E70XX

MATERIAL PREP.:-

CLEAN:	SSPC-SP2
SHOP PAINT:	TWO COAT OF STD SHOP PRIMER
GALV:	GALVANIZED & PAINTED

GEN. NOTES:-

BUY AMERICAN:	
DOMESTIC:	
CERT/CONFORMANCE:	
CERT/COMPLIANCE:	

ALL WIDE FLANGE SHAPES TO BE PER A992-G50

FIELD CONNECTIONS :

HOLES : 13/16" U.N.O

PAINT :

morrow steel Fabricators, Inc.

3620 COPELAND DRIVE
ZEPHYRHILLS, FL. 33542

	PRINTS FOR	DATE	MK	REVISIONS	DATE
			0	RELEASED FOR APPROVAL	Nov 18 2025
			1	RELEASED FOR RE-APPROVAL	Jul 13 2026
			2	RELEASED FOR RE-APPROVAL	Aug 26 2026

STRUCTURE:-PINELLAS SUNCOAST TRANSIT AUTHORITY
LOCATION:- CLEARWATER STATION,CLEARWATER,FL.
DETAILER:- VECTORSHADES LLC
CUSTOMER:- KOKOLAKIS
ARCH./ENG.:- CDM SMITH
DESCRIPTION:- WAVE CANOPY VERTICAL BRACE DETAIL
DRAWN:- PBI DATE:-10-27-2025 CHK.D:-RAG DATE:- 10-27-2025

SHOP BILL	WORK ORDER NO.	DRWG. NO.
	2553	1434

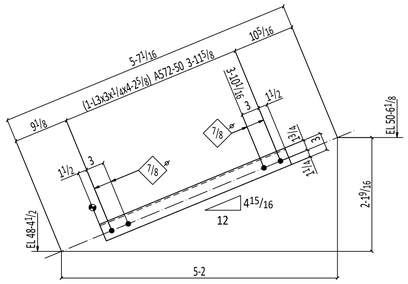

ONE VERTICAL BRACE 1435VB -G

SHOP NOTE:
TOE DIRECTION FAR SIDE

AESS CATEGORY-3

SHIPPING LIST / MATERIAL BILL

ITEM NO	TOTAL QTY	DESCRIPTION	MAJOR MARK	PAINT CODE	TOTAL WEIGHT	ABM NO	UNIT QTY	LENGTH FT.	LENGTH IN.	MINOR MARK	REMARKS	UNIT WEIGHT	GRADE
	ONE	VERTICAL BRACE	1435VB	G	21						Galv	21	
	1	L3x3x1/4			21		1	4	2 5/8	1435VB		21	A572-50
		FIELD BOLTS											
	4	3/4 Dia A325N						0	1 3/4		+1HD WASH		

Total weight : 21

REFERENCE :----

PAGE TOTALS

REVISION NO.

SPECIAL NOTES:-

MATERIAL:-

ASTM:	A36 U.N.O.
S. S.:	-----
ALUM.:	-----
PIPE:	A53 GR.B
TUBES:	A500 GR.B
HOLES:	13/16 U.N.O
WELDING:	E70XX

MATERIAL PREP.:-

CLEAN:	SSPC-SP2
SHOP PAINT:	TWO COAT OF STD SHOP PRIMER
GALV:	GALVANIZED & PAINTED

GEN. NOTES:-

BUY AMERICAN:
DOMESTIC:
CERT/CONFORMANCE:
CERT/COMPLIANCE:

ALL WIDE FLANGE SHAPES TO BE PER A992-G50

FIELD CONNECTIONS :
HOLES : 13/16" U.N.O
PAINT :

morrow steel Fabricators, Inc.

3620 COPELAND DRIVE
ZEPHYRHILLS, FL. 33542

	PRINTS FOR	DATE	MK	REVISIONS	DATE
			0	RELEASED FOR APPROVAL	Nov 18 2025
			1	RELEASED FOR RE-APPROVAL	Jul 13 2026
			2	RELEASED FOR RE-APPROVAL	Aug 26 2026

STRUCTURE:- PINELLAS SUNCOAST TRANSIT AUTHORITY
LOCATION:- CLEARWATER STATION,CLEARWATER,FL.
DETAILER:- VECTORSHADES LLC
CUSTOMER:- KOKOLAKIS
ARCH./ENG.:- CDM SMITH
DESCRIPTION:- WAVE CANOPY VERTICAL BRACE DETAIL
DRAWN:- PBI DATE:-10-27-2025 CHK.D.-RAG DATE:- 10-27-2025

SHOP BILL	WORK ORDER NO.	DRWG. NO.
	2553	1435

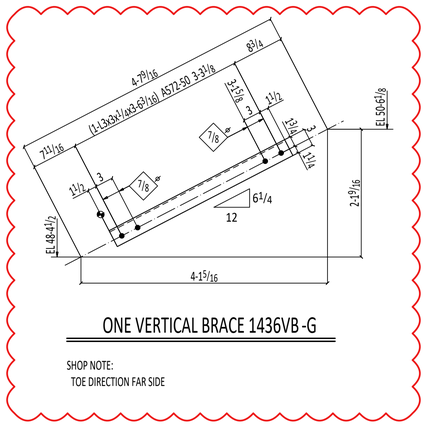

ONE VERTICAL BRACE 1436VB -G

SHOP NOTE:
TOE DIRECTION FAR SIDE

SHIPPING LIST

MATERIAL BILL

ITEM NO	TOTAL QTY	DESCRIPTION	MAJOR MARK	PAINT CODE	TOTAL WEIGHT	ABM NO	UNIT QTY	LENGTH FT.	LENGTH IN.	MINOR MARK	REMARKS	UNIT WEIGHT	GRADE
	ONE	VERTICAL BRACE	1436VB	G	17						Galv	17	
	1	L3x3x¼			17		1	3	6³/₁₆	1436VB		17	A572-50
		FIELD BOLTS											
	4	¾ Dia A325N						0	1¾		+1HD WASH		

Total weight : 17

REFERENCE :----

PAGE TOTALS

REVISION NO.

SPECIAL NOTES:-

MATERIAL:-
ASTM: A36 U.N.O.
S. S.: -----
ALUM.: -----
PIPE: A53 GR.B
TUBES: A500 GR.B
HOLES: 13/16 U.N.O
WELDING: E70XX

MATERIAL PREP.:-
CLEAN: SSPC-SP2
SHOP PAINT: TWO COAT OF STD SHOP PRIMER
GALV: GALVANIZED & PAINTED

GEN. NOTES:-
BUY AMERICAN:
DOMESTIC:
CERT/CONFORMANCE:
CERT/COMPLIANCE:

ALL WIDE FLANGE SHAPES TO BE PER A992-G50

FIELD CONNECTIONS :
HOLES : 13/16" U.N.O
PAINT :

morrow steel Fabricators, Inc.

3620 COPELAND DRIVE
ZEPHYRHILLS, FL. 33542

	PRINTS FOR	DATE	MK	REVISIONS	DATE
			0	RELEASED FOR APPROVAL	Nov 18 2025
			1	RELEASED FOR RE-APPROVAL	Jul 13 2026
			2	RELEASED FOR RE-APPROVAL	Aug 26 2026

STRUCTURE:-PINELLAS SUNCOAST TRANSIT AUTHORITY
LOCATION:- CLEARWATER STATION,CLEARWATER,FL.
DETAILER:- VECTORSHADES LLC
CUSTOMER:- KOKOLAKIS
ARCH./ENG.:- CDM SMITH
DESCRIPTION:-WAVE CANOPY VERTICAL BRACE DETAIL
DRAWN:- PBI DATE:-10-27-2025 CHK.D:-RAG DATE:- 10-27-2025

SHOP BILL	WORK ORDER NO.	DRWG. NO.
	2553	1436 ⚠1

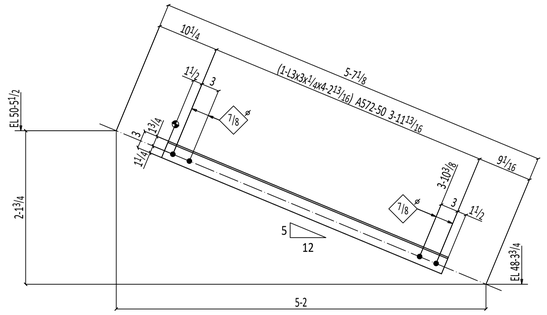

3 VERTICAL BRACES 1437VB -G

SHOP NOTE:
TOE DIRECTION NEAR SIDE

AESS CATEGORY-3

SHIPPING LIST / MATERIAL BILL

ITEM NO	TOTAL QTY	DESCRIPTION	MAJOR MARK	PAINT CODE	TOTAL WEIGHT	ABM NO	UNIT QTY	LENGTH FT.	LENGTH IN.	MINOR MARK	REMARKS	UNIT WEIGHT	GRADE
	3	VERTICAL BRACE	1437VB	G	62						Galv	21	
	3	L3x3x1/4			62		1	4	2 13/16	1437VB		21	A572-50
		FIELD BOLTS											
	12	3/4 Dia A325N						0	1 3/4		+1HD WASH		

Total weight : 62

REFERENCE :----

PAGE TOTALS

REVISION NO.

SPECIAL NOTES:-

MATERIAL:-

ASTM: A36 U.N.O.
S. S.: -----
ALUM.: -----
PIPE: A53 GR.B
TUBES: A500 GR.B
HOLES: 13/16 U.N.O
WELDING: E70XX

MATERIAL PREP.:-

CLEAN: SSPC-SP2
SHOP PAINT: TWO COAT OF STD SHOP PRIMER
GALV: GALVANIZED & PAINTED

GEN. NOTES:-

BUY AMERICAN:
DOMESTIC:
CERT/CONFORMANCE:
CERT/COMPLIANCE:

ALL WIDE FLANGE SHAPES TO BE PER A992-G50

FIELD CONNECTIONS :
HOLES : 13/16" U.N.O
PAINT :

morrow steel Fabricators, Inc.

3620 COPELAND DRIVE
ZEPHYRHILLS, FL. 33542

	PRINTS FOR	DATE	MK	REVISIONS	DATE
			0	RELEASED FOR APPROVAL	Nov 18 2025
			1	RELEASED FOR RE-APPROVAL	Jul 13 2026
			2	RELEASED FOR RE-APPROVAL	Aug 26 2026

STRUCTURE:- PINELLAS SUNCOAST TRANSIT AUTHORITY
LOCATION:- CLEARWATER STATION,CLEARWATER,FL.
DETAILER:- VECTORSHADES LLC
CUSTOMER:- KOKOLAKIS
ARCH./ENG.:- CDM SMITH
DESCRIPTION:- WAVE CANOPY VERTICAL BRACE DETAIL
DRAWN:- PBI DATE:-10-27-2025 CHK.D.-RAG DATE:- 10-27-2025

SHOP BILL	WORK ORDER NO.	DRWG. NO.
	2553	1437

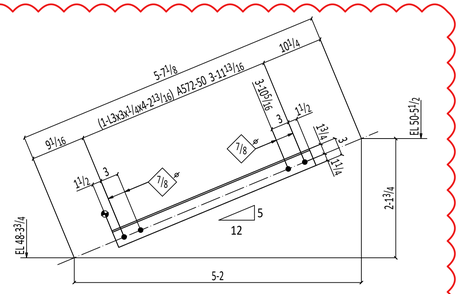

4 VERTICAL BRACES 1438VB -G

SHOP NOTE:
TOE DIRECTION NEAR SIDE

AESS CATEGORY-3

SHIPPING LIST / MATERIAL BILL

ITEM NO	TOTAL QTY	DESCRIPTION	MAJOR MARK	PAINT CODE	TOTAL WEIGHT	ABM NO	UNIT QTY	LENGTH FT.	LENGTH IN.	MINOR MARK	REMARKS	UNIT WEIGHT	GRADE
	4	VERTICAL BRACE	1438VB	G	83						Galv	21	
	4	L3x3x1/4			83		1	4	2 13/16	1438VB		21	A572-50
		FIELD BOLTS											
	16	3/4 Dia A325N						0	1 3/4		+1HD WASH		

Total weight : 83

REFERENCE :----

PAGE TOTALS

REVISION NO.

SPECIAL NOTES:-

MATERIAL:-

ASTM:	A36 U.N.O.
S. S.:	-----
ALUM.:	-----
PIPE:	A53 GR.B
TUBES:	A500 GR.B
HOLES:	13/16 U.N.O
WELDING:	E70XX

MATERIAL PREP.:-

CLEAN:	SSPC-SP2
SHOP PAINT:	TWO COAT OF STD SHOP PRIMER
GALV:	GALVANIZED & PAINTED

GEN. NOTES:-

BUY AMERICAN:
DOMESTIC:
CERT/CONFORMANCE:
CERT/COMPLIANCE:

ALL WIDE FLANGE SHAPES TO BE PER A992-G50

FIELD CONNECTIONS :
HOLES : 13/16" U.N.O
PAINT :

morrow steel Fabricators, Inc.

3620 COPELAND DRIVE
ZEPHYRHILLS, FL. 33542

	PRINTS FOR	DATE	MK	REVISIONS	DATE
			0	RELEASED FOR APPROVAL	Nov 18 2025
			1	RELEASED FOR RE-APPROVAL	Jul 13 2026
			2	RELEASED FOR RE-APPROVAL	Aug 26 2026

STRUCTURE:- PINELLAS SUNCOAST TRANSIT AUTHORITY
LOCATION:- CLEARWATER STATION,CLEARWATER,FL.
DETAILER:- VECTORSHADES LLC
CUSTOMER:- KOKOLAKIS
ARCH./ENG.:- CDM SMITH
DESCRIPTION:- WAVE CANOPY VERTICAL BRACE DETAIL
DRAWN:- PBI DATE:-10-27-2025 CHK.D:-RAG DATE:- 10-27-2025

SHOP BILL	WORK ORDER NO.	DRWG. NO.
	2553	1438

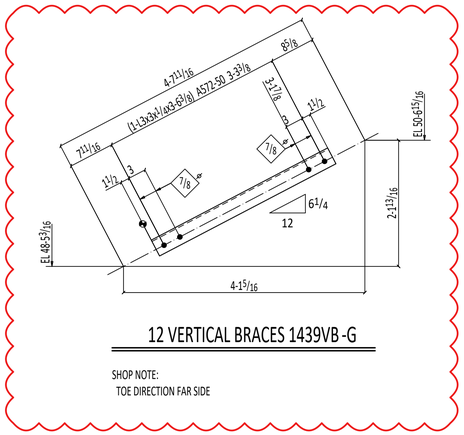

12 VERTICAL BRACES 1439VB -G

SHOP NOTE:
TOE DIRECTION FAR SIDE

SHIPPING LIST

MATERIAL BILL

ITEM NO	TOTAL QTY	DESCRIPTION	MAJOR MARK	PAINT CODE	TOTAL WEIGHT	ABM NO	UNIT QTY	LENGTH FT.	LENGTH IN.	MINOR MARK	REMARKS	UNIT WEIGHT	GRADE
	12	VERTICAL BRACE	1439VB	G	208						Galv	17	
	12	L3x3x1/4			208		1	3	6 3/8	1439VB		17	A572-50
		FIELD BOLTS											
	48	3/4 Dia A325N						0	1 3/4		+1HD WASH		

Total weight : 208

REFERENCE :----

PAGE TOTALS

REVISION NO.

SPECIAL NOTES:-

MATERIAL:-

ASTM: A36 U.N.O.
S. S.: -----
ALUM.: -----
PIPE: A53 GR.B
TUBES: A500 GR.B
HOLES: 13/16 U.N.O
WELDING: E70XX

MATERIAL PREP.:-

CLEAN: SSPC-SP2
SHOP PAINT: TWO COAT OF STD SHOP PRIMER
GALV: GALVANIZED & PAINTED

GEN. NOTES:-

BUY AMERICAN:
DOMESTIC:
CERT/CONFORMANCE:
CERT/COMPLIANCE:

ALL WIDE FLANGE SHAPES TO BE PER A992-G50

FIELD CONNECTIONS :
HOLES : 13/16" U.N.O
PAINT :

morrow steel Fabricators, Inc.

3620 COPELAND DRIVE
ZEPHYRHILLS, FL. 33542

PRINTS FOR	DATE	MK	REVISIONS	DATE
		0	RELEASED FOR APPROVAL	Nov 18 2025
		1	RELEASED FOR RE-APPROVAL	Jul 13 2026
		2	RELEASED FOR RE-APPROVAL	Aug 26 2026

STRUCTURE:- PINELLAS SUNCOAST TRANSIT AUTHORITY
LOCATION:- CLEARWATER STATION,CLEARWATER,FL.
DETAILER:- VECTORSHADES LLC.
CUSTOMER:- KOKOLAKIS
ARCH./ENG.:- CDM SMITH
DESCRIPTION:- WAVE CANOPY VERTICAL BRACE DETAIL
DRAWN:- PBI DATE:- 10-27-2025 CHK.D:- RAG DATE:- 10-27-2025

SHOP BILL	WORK ORDER NO.	DRWG. NO.
	2553	1439

SHIPPING LIST

MATERIAL BILL

ITEM NO	TOTAL QTY	DESCRIPTION	MAJOR MARK	PAINT CODE	TOTAL WEIGHT	ABM NO	UNIT QTY	LENGTH FT.	LENGTH IN.	MINOR MARK	REMARKS	UNIT WEIGHT	GRADE
	6	VERTICAL BRACE	1440VB	G	104						Galv	17	
	6	L3x3x1/4			104		1	3	6 3/8	1440VB		17	A572-50
		FIELD BOLTS											
	24	3/4 Dia A325N						0	1 3/4		+1HD WASH		

Total weight : 104

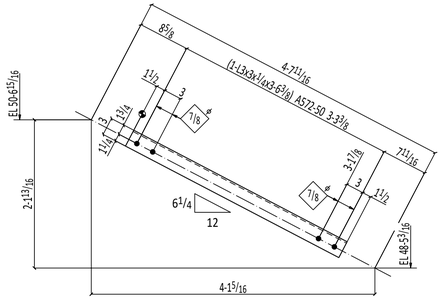

6 VERTICAL BRACES 1440VB -G

SHOP NOTE:
TOE DIRECTION FAR SIDE

REFERENCE :----

PAGE TOTALS

REVISION NO.

SPECIAL NOTES:-

MATERIAL:-
ASTM: A36 U.N.O.
S. S.: -----
ALUM.: -----
PIPE: A53 GR.B
TUBES: A500 GR.B
HOLES: 13/16 U.N.O
WELDING: E70XX

MATERIAL PREP.:-
CLEAN: SSPC-SP2
SHOP PAINT: TWO COAT OF STD SHOP PRIMER
GALV: GALVANIZED & PAINTED

GEN. NOTES:-
BUY AMERICAN:
DOMESTIC:
CERT/CONFORMANCE:
CERT/COMPLIANCE:

ALL WIDE FLANGE SHAPES TO BE PER A992-G50

FIELD CONNECTIONS :
HOLES : 13/16" U.N.O
PAINT :

morrow steel Fabricators, Inc.

3620 COPELAND DRIVE
ZEPHYRHILLS, FL. 33542

	PRINTS FOR	DATE	MK	REVISIONS	DATE
			0	RELEASED FOR APPROVAL	Nov 18 2025
			1	RELEASED FOR RE-APPROVAL	Jul 13 2026
			2	RELEASED FOR RE-APPROVAL	Aug 26 2026

STRUCTURE:- PINELLAS SUNCOAST TRANSIT AUTHORITY
LOCATION:- CLEARWATER STATION,CLEARWATER,FL.
DETAILER:- VECTORSHADES LLC
CUSTOMER:- KOKOLAKIS
ARCH./ENG.:- CDM SMITH
DESCRIPTION:- WAVE CANOPY VERTICAL BRACE DETAIL
DRAWN:- PBI DATE:- 10-27-2025 CHK.D:- RAG DATE:- 10-27-2025

SHOP BILL	WORK ORDER NO.	DRWG. NO.
	2553	1440

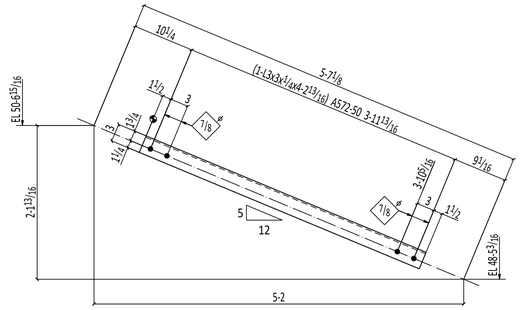

ONE VERTICAL BRACE 1441VB -G

SHOP NOTE:
TOE DIRECTION FAR SIDE

AESS CATEGORY-3

SHIPPING LIST / MATERIAL BILL

ITEM NO	TOTAL QTY	DESCRIPTION	MAJOR MARK	PAINT CODE	TOTAL WEIGHT	ABM NO	UNIT QTY	LENGTH FT.	LENGTH IN.	MINOR MARK	REMARKS	UNIT WEIGHT	GRADE
	ONE	VERTICAL BRACE	1441VB	G	21						Galv	21	
	1	L3x3x1/4			21		1	4	2 13/16	1441VB		21	A572-50
		FIELD BOLTS											
	4	3/4 Dia A325N						0	1 3/4		+1HD WASH		

Total weight : 21

REFERENCE :----

PAGE TOTALS

REVISION NO.

SPECIAL NOTES:-

MATERIAL:-

ASTM: A36 U.N.O.
S. S.: -----
ALUM.: -----
PIPE: A53 GR.B
TUBES: A500 GR.B
HOLES: 13/16 U.N.O
WELDING: E70XX

MATERIAL PREP.:-

CLEAN: SSPC-SP2
SHOP PAINT: TWO COAT OF STD SHOP PRIMER
GALV: GALVANIZED & PAINTED

GEN. NOTES:-

BUY AMERICAN:
DOMESTIC:
CERT/CONFORMANCE:
CERT/COMPLIANCE:

ALL WIDE FLANGE SHAPES TO BE PER A992-G50

FIELD CONNECTIONS :
HOLES : 13/16" U.N.O
PAINT :

morrow steel Fabricators, Inc.

3620 COPELAND DRIVE
ZEPHYRHILLS, FL. 33542

	PRINTS FOR	DATE	MK	REVISIONS	DATE
			0	RELEASED FOR APPROVAL	Nov 18 2025
			1	RELEASED FOR RE-APPROVAL	Jul 13 2026
			2	RELEASED FOR RE-APPROVAL	Aug 26 2026

STRUCTURE:- PINELLAS SUNCOAST TRANSIT AUTHORITY
LOCATION:- CLEARWATER STATION,CLEARWATER,FL.
DETAILER:- VECTORSHADES LLC
CUSTOMER:- KOKOLAKIS
ARCH./ENG.:- CDM SMITH
DESCRIPTION:- WAVE CANOPY VERTICAL BRACE DETAIL
DRAWN:- PBI DATE:-10-27-2025 CHK.D.-RAG DATE:- 10-27-2025

SHOP BILL	WORK ORDER NO.	DRWG. NO.
	2553	1441 ⚠1

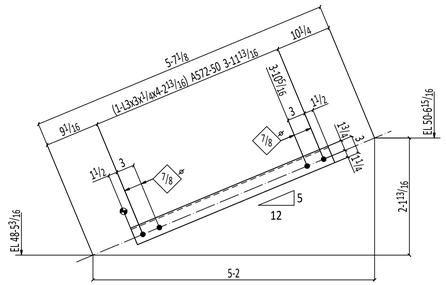

2 VERTICAL BRACES 1442VB -G

SHOP NOTE:
TOE DIRECTION FAR SIDE

AESS CATEGORY-3

SHIPPING LIST / MATERIAL BILL

ITEM NO	TOTAL QTY	DESCRIPTION	MAJOR MARK	PAINT CODE	TOTAL WEIGHT	ABM NO	UNIT QTY	LENGTH FT.	LENGTH IN.	MINOR MARK	REMARKS	UNIT WEIGHT	GRADE
	2	VERTICAL BRACE	1442VB	G	42						Galv	21	
	2	L3x3x1/4			42		1	4	2 13/16	1442VB		21	A572-50
		FIELD BOLTS											
	8	3/4 Dia A325N						0	1 3/4		+1HD WASH		

Total weight : 42

REFERENCE :----

PAGE TOTALS

REVISION NO.

SPECIAL NOTES:-

MATERIAL:-

ASTM:	A36 U.N.O.
S. S.:	-----
ALUM.:	-----
PIPE:	A53 GR.B
TUBES:	A500 GR.B
HOLES:	13/16 U.N.O
WELDING:	E70XX

MATERIAL PREP.:-

CLEAN:	SSPC-SP2
SHOP PAINT:	TWO COAT OF STD SHOP PRIMER
GALV:	GALVANIZED & PAINTED

GEN. NOTES:-

BUY AMERICAN: _____
DOMESTIC: _____
CERT/CONFORMANCE: _____
CERT/COMPLIANCE: _____

ALL WIDE FLANGE SHAPES TO BE PER A992-G50

FIELD CONNECTIONS : _____
HOLES : 13/16" U.N.O
PAINT : _____

morrow steel Fabricators, Inc.

3620 COPELAND DRIVE
ZEPHYRHILLS, FL. 33542

	PRINTS FOR	DATE	MK	REVISIONS	DATE
			0	RELEASED FOR APPROVAL	Nov 18 2025
			1	RELEASED FOR RE-APPROVAL	Jul 13 2026
			2	RELEASED FOR RE-APPROVAL	Aug 26 2026

STRUCTURE:- PINELLAS SUNCOAST TRANSIT AUTHORITY
LOCATION:- CLEARWATER STATION,CLEARWATER,FL.
DETAILER:- VECTORSHADES LLC
CUSTOMER:- KOKOLAKIS
ARCH./ENG.:- CDM SMITH
DESCRIPTION:- WAVE CANOPY VERTICAL BRACE DETAIL
DRAWN:- PBI DATE:-10-27-2025 CHK.D.-RAG DATE:- 10-27-2025

SHOP BILL	WORK ORDER NO.	DRWG. NO.
	2553	1442

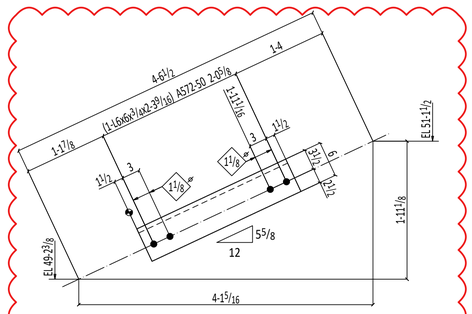

6 VERTICAL BRACES 1443VB -G

SHOP NOTE:
TOE DIRECTION FAR SIDE

SHIPPING LIST

MATERIAL BILL

ITEM NO	TOTAL QTY	DESCRIPTION	MAJOR MARK	PAINT CODE	TOTAL WEIGHT	ABM NO	UNIT QTY	LENGTH FT.	LENGTH IN.	MINOR MARK	REMARKS	UNIT WEIGHT	GRADE
	6	VERTICAL BRACE	1443VB	G	396						Galv	66	
	6	L6x6x3/4			396		1	2	39/16	1443VB		66	A572-50
		FIELD BOLTS											
	24	1 Dia A325N						0	2 3/4		+1HD WASH		

Total weight : 396

REFERENCE :----

PAGE TOTALS

REVISION NO.

SPECIAL NOTES:-

MATERIAL:-
ASTM: A36 U.N.O.
S. S.: -----
ALUM.: -----
PIPE: A53 GR.B
TUBES: A500 GR.B
HOLES: 13/16 U.N.O
WELDING: E70XX

MATERIAL PREP.:-
CLEAN: SSPC-SP2
SHOP PAINT: TWO COAT OF STD SHOP PRIMER
GALV: GALVANIZED & PAINTED

GEN. NOTES:-
BUY AMERICAN:
DOMESTIC:
CERT/CONFORMANCE:
CERT/COMPLIANCE:

ALL WIDE FLANGE SHAPES TO BE PER A992-G50

FIELD CONNECTIONS :
HOLES : 13/16" U.N.O
PAINT :

morrow steel Fabricators, Inc.

3620 COPELAND DRIVE
ZEPHYRHILLS, FL. 33542

	PRINTS FOR	DATE	MK	REVISIONS	DATE
			0	RELEASED FOR APPROVAL	Nov 18 2025
			1	RELEASED FOR RE-APPROVAL	Jul 13 2026
			2	RELEASED FOR RE-APPROVAL	Aug 26 2026

STRUCTURE:- PINELLAS SUNCOAST TRANSIT AUTHORITY
LOCATION:- CLEARWATER STATION,CLEARWATER,FL.
DETAILER:- VECTORSHADES LLC
CUSTOMER:- KOKOLAKIS
ARCH./ENG.:- CDM SMITH
DESCRIPTION:- WAVE CANOPY VERTICAL BRACE DETAIL
DRAWN:- PBI DATE:- 10-27-2025 CHK.D:- RAG DATE:- 10-27-2025

SHOP BILL	WORK ORDER NO.	DRWG. NO.
	2553	1443 ⚠1

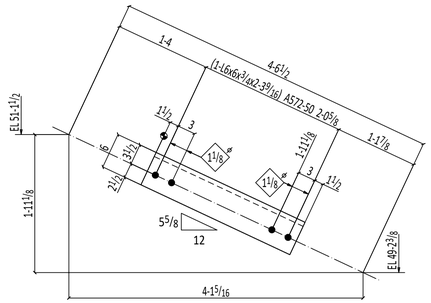

6 VERTICAL BRACES 1444VB -G

SHOP NOTE:
TOE DIRECTION FAR SIDE

SHIPPING LIST

MATERIAL BILL

ITEM NO	TOTAL QTY	DESCRIPTION	MAJOR MARK	PAINT CODE	TOTAL WEIGHT	ABM NO	UNIT QTY	LENGTH FT.	LENGTH IN.	MINOR MARK	REMARKS	UNIT WEIGHT	GRADE
	6	VERTICAL BRACE	1444VB	G	396						Galv	66	
	6	L6x6x3/4			396		1	2	39/16	1444VB		66	A572-50
		FIELD BOLTS											
	24	1 Dia A325N						0	2 3/4		+1HD WASH		

Total weight : 396

REFERENCE :----

PAGE TOTALS

REVISION NO.

SPECIAL NOTES:-

MATERIAL:-
ASTM: A36 U.N.O.
S. S.: -----
ALUM.: -----
PIPE: A53 GR.B
TUBES: A500 GR.B
HOLES: 13/16 U.N.O
WELDING: E70XX

MATERIAL PREP.:-
CLEAN: SSPC-SP2
SHOP PAINT: TWO COAT OF STD SHOP PRIMER
GALV: GALVANIZED & PAINTED

GEN. NOTES:-
BUY AMERICAN:
DOMESTIC:
CERT/CONFORMANCE:
CERT/COMPLIANCE:

ALL WIDE FLANGE SHAPES TO BE PER A992-G50

FIELD CONNECTIONS :
HOLES : 13/16" U.N.O
PAINT :

morrow steel Fabricators, Inc.

3620 COPELAND DRIVE
ZEPHYRHILLS, FL. 33542

PRINTS FOR	DATE	MK	REVISIONS	DATE
		0	RELEASED FOR APPROVAL	Nov 18 2025
		1	RELEASED FOR RE-APPROVAL	Jul 13 2026
		2	RELEASED FOR RE-APPROVAL	Aug 26 2026

STRUCTURE:- PINELLAS SUNCOAST TRANSIT AUTHORITY
LOCATION:- CLEARWATER STATION,CLEARWATER,FL.
DETAILER:- VECTORSHADES LLC
CUSTOMER:- KOKOLAKIS
ARCH./ENG.:- CDM SMITH
DESCRIPTION:- WAVE CANOPY VERTICAL BRACE DETAIL
DRAWN:- PBI DATE:- 10-27-2025 CHK.D:- RAG DATE:- 10-27-2025

SHOP BILL	WORK ORDER NO.	DRWG. NO.
	2553	1444 1

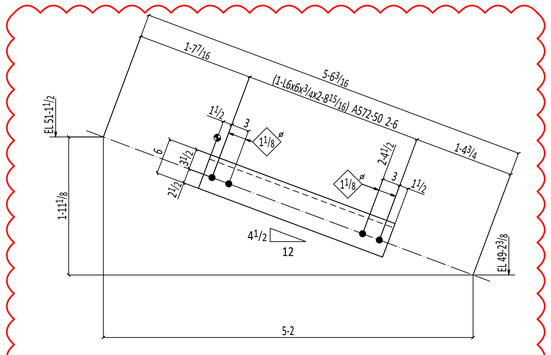

ONE VERTICAL BRACE 1445VB-G

SHOP NOTE:
TOE DIRECTION FAR SIDE

AESS CATEGORY-3

SHIPPING LIST / MATERIAL BILL

ITEM NO	TOTAL QTY	DESCRIPTION	MAJOR MARK	PAINT CODE	TOTAL WEIGHT	ABM NO	UNIT QTY	LENGTH FT.	LENGTH IN.	MINOR MARK	REMARKS	UNIT WEIGHT	GRADE
	ONE	VERTICAL BRACE	1445VB	G	79						Galv	79	
	1	L6x6x3/4			79		1	2	8 15/16	1445VB		79	A572-50
		FIELD BOLTS											
	4	1 Dia A325N						0	2 3/4		+1HD WASH		

Total weight : 79

REFERENCE :----

PAGE TOTALS

REVISION NO.

SPECIAL NOTES:-

MATERIAL:-
ASTM: A36 U.N.O.
S. S.: -----
ALUM.: -----
PIPE: A53 GR.B
TUBES: A500 GR.B
HOLES: 13/16 U.N.O
WELDING: E70XX

MATERIAL PREP.:-
CLEAN: SSPC-SP2
SHOP PAINT: TWO COAT OF STD SHOP PRIMER
GALV: GALVANIZED & PAINTED

GEN. NOTES:-
BUY AMERICAN:
DOMESTIC:
CERT/CONFORMANCE:
CERT/COMPLIANCE:

ALL WIDE FLANGE SHAPES TO BE PER A992-G50

FIELD CONNECTIONS :
HOLES : 13/16" U.N.O
PAINT :

morrow steel Fabricators, Inc.

3620 COPELAND DRIVE
ZEPHYRHILLS, FL. 33542

	PRINTS FOR	DATE	MK	REVISIONS	DATE
			0	RELEASED FOR APPROVAL	Nov 18 2025
			1	RELEASED FOR RE-APPROVAL	Jul 13 2026
			2	RELEASED FOR RE-APPROVAL	Aug 26 2026

STRUCTURE:-PINELLAS SUNCOAST TRANSIT AUTHORITY
LOCATION:- CLEARWATER STATION,CLEARWATER,FL.
DETAILER:- VECTORSHADES LLC
CUSTOMER:- KOKOLAKIS
ARCH./ENG.:- CDM SMITH
DESCRIPTION:-WAVE CANOPY VERTICAL BRACE DETAIL
DRAWN:- PBI DATE:-10-27-2025 CHK.D:-RAG DATE:- 10-27-2025

SHOP BILL	WORK ORDER NO.	DRWG. NO.
	2553	1445

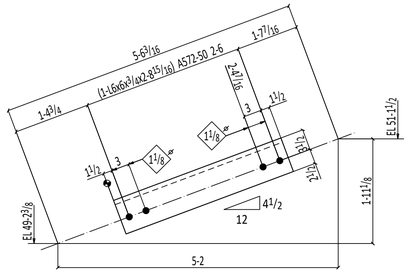

ONE VERTICAL BRACE 1446VB -G

SHOP NOTE:
TOE DIRECTION FAR SIDE

AESS CATEGORY-3

SHIPPING LIST / MATERIAL BILL

ITEM NO	TOTAL QTY	DESCRIPTION	MAJOR MARK	PAINT CODE	TOTAL WEIGHT	ABM NO	UNIT QTY	LENGTH FT.	LENGTH IN.	MINOR MARK	REMARKS	UNIT WEIGHT	GRADE
	ONE	VERTICAL BRACE	1446VB	G	79						Galv	79	
	1	L6x6x3/4			79		1	2	8 15/16	1446VB		79	A572-50
		FIELD BOLTS											
	4	1 Dia A325N						0	2 3/4		+1HD WASH		

Total weight : 79

REFERENCE :----

PAGE TOTALS

REVISION NO.

SPECIAL NOTES:-

MATERIAL:-
ASTM: A36 U.N.O.
S. S.: -----
ALUM.: -----
PIPE: A53 GR.B
TUBES: A500 GR.B
HOLES: 13/16 U.N.O
WELDING: E70XX

MATERIAL PREP.:-
CLEAN: SSPC-SP2
SHOP PAINT: TWO COAT OF STD SHOP PRIMER
GALV: GALVANIZED & PAINTED

GEN. NOTES:-
BUY AMERICAN:
DOMESTIC:
CERT/CONFORMANCE:
CERT/COMPLIANCE:

ALL WIDE FLANGE SHAPES TO BE PER A992-G50

FIELD CONNECTIONS :
HOLES : 13/16" U.N.O
PAINT :

morrow steel Fabricators, Inc.

3620 COPELAND DRIVE
ZEPHYRHILLS, FL. 33542

	PRINTS FOR	DATE	MK	REVISIONS	DATE
			0	RELEASED FOR APPROVAL	Nov 18 2025
			1	RELEASED FOR RE-APPROVAL	Jul 13 2026
			2	RELEASED FOR RE-APPROVAL	Aug 26 2026

STRUCTURE:- PINELLAS SUNCOAST TRANSIT AUTHORITY
LOCATION:- CLEARWATER STATION,CLEARWATER,FL.
DETAILER:- VECTORSHADES LLC
CUSTOMER:- KOKOLAKIS
ARCH./ENG.:- CDM SMITH
DESCRIPTION:- WAVE CANOPY VERTICAL BRACE DETAIL
DRAWN:- PBI DATE:- 10-27-2025 CHK.D:- RAG DATE:- 10-27-2025

SHOP BILL	WORK ORDER NO.	DRWG. NO.
	2553	1446 ⚠1

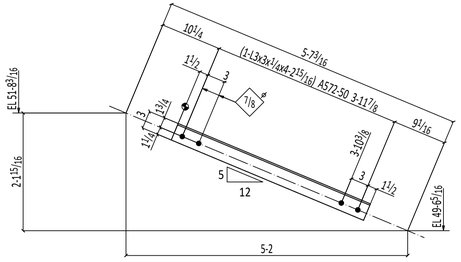

ONE VERTICAL BRACE 1447VB -G

SHOP NOTE:
TOE DIRECTION NEAR SIDE

AESS CATEGORY-3

SHIPPING LIST

MATERIAL BILL

ITEM NO	TOTAL QTY	DESCRIPTION	MAJOR MARK	PAINT CODE	TOTAL WEIGHT	ABM NO	UNIT QTY	LENGTH FT.	LENGTH IN.	MINOR MARK	REMARKS	UNIT WEIGHT	GRADE
	ONE	VERTICAL BRACE	1447VB	G	21						Galv	21	
	1	L3x3x¼			21		1	4	2 15/16	1447VB		21	A572-50
		FIELD BOLTS											
	4	¾ Dia A325N						0	1¾		+1HD WASH		

Total weight : 21

REFERENCE :----

PAGE TOTALS

REVISION NO.

SPECIAL NOTES:-

MATERIAL:-

ASTM: A36 U.N.O.
S. S.: -----
ALUM.: -----
PIPE: A53 GR.B
TUBES: A500 GR.B
HOLES: 13/16 U.N.O
WELDING: E70XX

MATERIAL PREP.:-

CLEAN: SSPC-SP2
SHOP PAINT: TWO COAT OF STD SHOP PRIMER
GALV: GALVANIZED & PAINTED

GEN. NOTES:-

BUY AMERICAN:
DOMESTIC:
CERT/CONFORMANCE:
CERT/COMPLIANCE:

ALL WIDE FLANGE SHAPES TO BE PER A992-G50

FIELD CONNECTIONS :
HOLES : 13/16" U.N.O
PAINT :

morrow steel Fabricators, Inc.

3620 COPELAND DRIVE
ZEPHYRHILLS, FL. 33542

	PRINTS FOR	DATE	MK	REVISIONS	DATE
			0	RELEASED FOR APPROVAL	Nov 18 2025
			1	RELEASED FOR RE-APPROVAL	Jul 13 2026
			2	RELEASED FOR RE-APPROVAL	Aug 26 2026

STRUCTURE:- PINELLAS SUNCOAST TRANSIT AUTHORITY
LOCATION:- CLEARWATER STATION,CLEARWATER,FL.
DETAILER:- VECTORSHADES LLC
CUSTOMER:- KOKOLAKIS
ARCH./ENG.:- CDM SMITH
DESCRIPTION:- WAVE CANOPY VERTICAL BRACE DETAIL
DRAWN:- PBI DATE:-10-27-2025 CHK.D.-RAG DATE:- 10-27-2025

SHOP BILL	WORK ORDER NO.	DRWG. NO.
	2553	1447

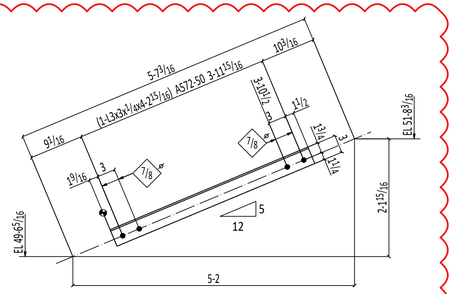

ONE VERTICAL BRACE 1448VB -G

SHOP NOTE:
TOE DIRECTION NEAR SIDE

AESS CATEGORY-3

SHIPPING LIST

MATERIAL BILL

ITEM NO	TOTAL QTY	DESCRIPTION	MAJOR MARK	PAINT CODE	TOTAL WEIGHT	ABM NO	UNIT QTY	LENGTH FT.	LENGTH IN.	MINOR MARK	REMARKS	UNIT WEIGHT	GRADE
	ONE	VERTICAL BRACE	1448VB	G	21						Galv	21	
	1	L3x3x1/4			21		1	4	2 15/16	1448VB		21	A572-50
		FIELD BOLTS											
	4	3/4 Dia A325N						0	1 3/4		+1HD WASH		

Total weight : 21

REFERENCE :----

PAGE TOTALS

REVISION NO.

SPECIAL NOTES:-

MATERIAL:-
ASTM: A36 U.N.O.
S. S.: -----
ALUM.: -----
PIPE: A53 GR.B
TUBES: A500 GR.B
HOLES: 13/16 U.N.O
WELDING: E70XX

MATERIAL PREP.:-
CLEAN: SSPC-SP2
SHOP PAINT: TWO COAT OF STD SHOP PRIMER
GALV: GALVANIZED & PAINTED

GEN. NOTES:-
BUY AMERICAN:
DOMESTIC:
CERT/CONFORMANCE:
CERT/COMPLIANCE:

ALL WIDE FLANGE SHAPES TO BE PER A992-G50

FIELD CONNECTIONS :
HOLES : 13/16" U.N.O
PAINT :

morrow steel Fabricators, Inc.

3620 COPELAND DRIVE
ZEPHYRHILLS, FL. 33542

	PRINTS FOR	DATE	MK	REVISIONS	DATE
			0	RELEASED FOR APPROVAL	Nov 18 2025
			1	RELEASED FOR RE-APPROVAL	Jul 13 2026
			2	RELEASED FOR RE-APPROVAL	Aug 26 2026

STRUCTURE:-PINELLAS SUNCOAST TRANSIT AUTHORITY
LOCATION:- CLEARWATER STATION,CLEARWATER,FL.
DETAILER:- VECTORSHADES LLC
CUSTOMER:- KOKOLAKIS
ARCH./ENG.:- CDM SMITH
DESCRIPTION:-WAVE CANOPY VERTICAL BRACE DETAIL
DRAWN:- PBI DATE:-10-27-2025 CHK.D:-RAG DATE:- 10-27-2025

SHOP BILL	WORK ORDER NO.	DRWG. NO.
	2553	1448

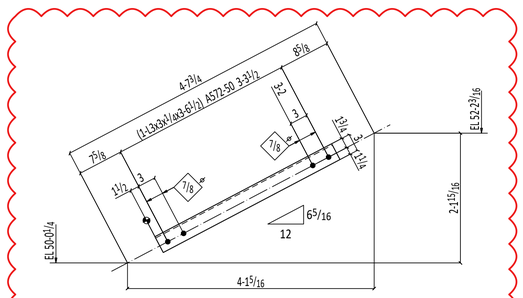

12 VERTICAL BRACES 1449VB -G

SHOP NOTE:
TOE DIRECTION FAR SIDE

SHIPPING LIST / MATERIAL BILL

ITEM NO	TOTAL QTY	DESCRIPTION	MAJOR MARK	PAINT CODE	TOTAL WEIGHT	ABM NO	UNIT QTY	LENGTH FT.	LENGTH IN.	MINOR MARK	REMARKS	UNIT WEIGHT	GRADE
	12	VERTICAL BRACE	1449VB	G	208						Galv	17	
	12	L3x3x¼			208		1	3	6½	1449VB		17	A572-50
		FIELD BOLTS											
	48	¾ Dia A325N						0	1¾		+1HD WASH		

Total weight : 208

REFERENCE :----

PAGE TOTALS

REVISION NO.

SPECIAL NOTES:-

MATERIAL:-
ASTM: A36 U.N.O.
S. S.: -----
ALUM.: -----
PIPE: A53 GR.B
TUBES: A500 GR.B
HOLES: 13/16 U.N.O
WELDING: E70XX

MATERIAL PREP.:-
CLEAN: SSPC-SP2
SHOP PAINT: TWO COAT OF STD SHOP PRIMER
GALV: GALVANIZED & PAINTED

GEN. NOTES:-
BUY AMERICAN:
DOMESTIC:
CERT/CONFORMANCE:
CERT/COMPLIANCE:

ALL WIDE FLANGE SHAPES TO BE PER A992-G50

FIELD CONNECTIONS :
HOLES : 13/16" U.N.O
PAINT :

morrow steel Fabricators, Inc.

3620 COPELAND DRIVE
ZEPHYRHILLS, FL. 33542

	PRINTS FOR	DATE	MK	REVISIONS	DATE
			0	RELEASED FOR APPROVAL	Nov 18 2025
			1	RELEASED FOR RE-APPROVAL	Jul 13 2026
			2	RELEASED FOR RE-APPROVAL	Aug 26 2026

STRUCTURE:- PINELLAS SUNCOAST TRANSIT AUTHORITY
LOCATION:- CLEARWATER STATION,CLEARWATER,FL.
DETAILER:- VECTORSHADES LLC
CUSTOMER:- KOKOLAKIS
ARCH./ENG.:- CDM SMITH
DESCRIPTION:- WAVE CANOPY VERTICAL BRACE DETAIL
DRAWN:- PBI DATE:- 10-27-2025 CHK.D:- RAG DATE:- 10-27-2025

SHOP BILL	WORK ORDER NO.	DRWG. NO.
	2553	1449

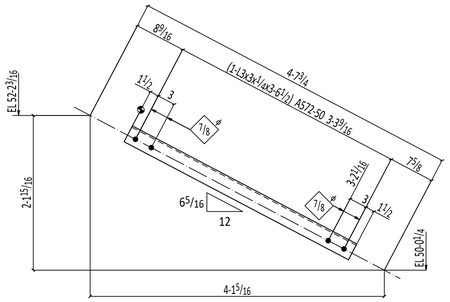

12 VERTICAL BRACES 1450VB -G

SHOP NOTE:
TOE DIRECTION FAR SIDE

SHIPPING LIST

MATERIAL BILL

ITEM NO	TOTAL QTY	DESCRIPTION	MAJOR MARK	PAINT CODE	TOTAL WEIGHT	ABM NO	UNIT QTY	LENGTH FT.	LENGTH IN.	MINOR MARK	REMARKS	UNIT WEIGHT	GRADE
	12	VERTICAL BRACE	1450VB	G	208						Galv	17	
	12	L3x3x1/4			208		1	3	6 1/2	1450VB		17	A572-50
		FIELD BOLTS											
	48	3/4 Dia A325N						0	1 3/4		+1HD WASH		

Total weight : 208

REFERENCE :----

PAGE TOTALS

REVISION NO.

SPECIAL NOTES:-

MATERIAL:-
ASTM: A36 U.N.O.
S. S.: -----
ALUM.: -----
PIPE: A53 GR.B
TUBES: A500 GR.B
HOLES: 13/16 U.N.O
WELDING: E70XX

MATERIAL PREP.:-
CLEAN: SSPC-SP2
SHOP PAINT: TWO COAT OF STD SHOP PRIMER
GALV: GALVANIZED & PAINTED

GEN. NOTES:-
BUY AMERICAN:
DOMESTIC:
CERT/CONFORMANCE:
CERT/COMPLIANCE:

ALL WIDE FLANGE SHAPES TO BE PER A992-G50

FIELD CONNECTIONS :
HOLES : 13/16" U.N.O
PAINT :

morrow steel Fabricators, Inc.

3620 COPELAND DRIVE
ZEPHYRHILLS, FL. 33542

	PRINTS FOR	DATE	MK	REVISIONS	DATE
			0	RELEASED FOR APPROVAL	Nov 18 2025
			1	RELEASED FOR RE-APPROVAL	Jul 13 2026
			2	RELEASED FOR RE-APPROVAL	Aug 26 2026

STRUCTURE:-PINELLAS SUNCOAST TRANSIT AUTHORITY
LOCATION:- CLEARWATER STATION,CLEARWATER,FL.
DETAILER:- VECTORSHADES LLC
CUSTOMER:- KOKOLAKIS
ARCH./ENG.:- CDM SMITH
DESCRIPTION:-WAVE CANOPY VERTICAL BRACE DETAIL
DRAWN:- PBI DATE:-10-27-2025 CHK.D:-RAG DATE:- 10-27-2025

SHOP BILL	WORK ORDER NO.	DRWG. NO.
	2553	1450

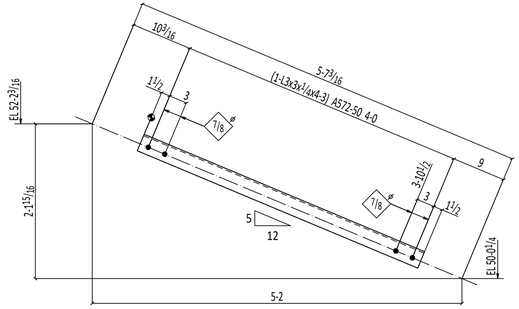

ONE VERTICAL BRACE 1451VB-G

SHOP NOTE:
TOE DIRECTION FAR SIDE

AESS CATEGORY-3

SHIPPING LIST / MATERIAL BILL

ITEM NO	TOTAL QTY	DESCRIPTION	MAJOR MARK	PAINT CODE	TOTAL WEIGHT	ABM NO	UNIT QTY	LENGTH FT.	LENGTH IN.	MINOR MARK	REMARKS	UNIT WEIGHT	GRADE
	ONE	VERTICAL BRACE	1451VB	G	21						Galv	21	
	1	L3x3x1/4			21		1	4	3	1451VB		21	A572-50
		FIELD BOLTS											
	4	3/4 Dia A325N						0	13/4		+1HD WASH		

Total weight : 21

REFERENCE :----

PAGE TOTALS

REVISION NO.

SPECIAL NOTES:-

MATERIAL:-
ASTM: A36 U.N.O.
S. S.: -----
ALUM.: -----
PIPE: A53 GR.B
TUBES: A500 GR.B
HOLES: 13/16 U.N.O
WELDING: E70XX

MATERIAL PREP.:-
CLEAN: SSPC-SP2
SHOP PAINT: TWO COAT OF STD SHOP PRIMER
GALV: GALVANIZED & PAINTED

GEN. NOTES:-
BUY AMERICAN:
DOMESTIC:
CERT/CONFORMANCE:
CERT/COMPLIANCE:

ALL WIDE FLANGE SHAPES TO BE PER A992-G50

FIELD CONNECTIONS :
HOLES : 13/16" U.N.O
PAINT :

morrow steel Fabricators, Inc.

3620 COPELAND DRIVE
ZEPHYRHILLS, FL. 33542

	PRINTS FOR	DATE	MK	REVISIONS	DATE
			0	RELEASED FOR APPROVAL	Nov 18 2025
			1	RELEASED FOR RE-APPROVAL	Jul 13 2026
			2	RELEASED FOR RE-APPROVAL	Aug 26 2026

STRUCTURE:-PINELLAS SUNCOAST TRANSIT AUTHORITY
LOCATION:- CLEARWATER STATION,CLEARWATER,FL.
DETAILER:- VECTORSHADES LLC
CUSTOMER:- KOKOLAKIS
ARCH./ENG.:- CDM SMITH
DESCRIPTION:- WAVE CANOPY VERTICAL BRACE DETAIL
DRAWN:- PBI DATE:- 10-27-2025 CHK.D:- RAG DATE:- 10-27-2025

SHOP BILL	WORK ORDER NO.	DRWG. NO.
	2553	1451

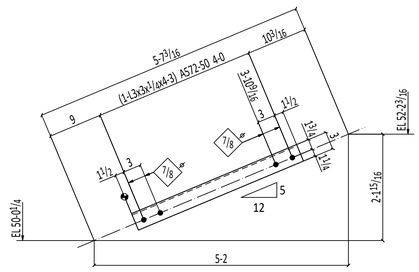

3 VERTICAL BRACES 1452VB -G

SHOP NOTE:
TOE DIRECTION FAR SIDE

AESS CATEGORY-3

SHIPPING LIST

MATERIAL BILL

ITEM NO	TOTAL QTY	DESCRIPTION	MAJOR MARK	PAINT CODE	TOTAL WEIGHT	ABM NO	UNIT QTY	LENGTH FT.	LENGTH IN.	MINOR MARK	REMARKS	UNIT WEIGHT	GRADE
	3	VERTICAL BRACE	1452VB	G	62						Galv	21	
	3	L3x3x1/4			62		1	4	3	1452VB		21	A572-50
		FIELD BOLTS											
	12	3/4 Dia A325N						0	1 3/4		+1HD WASH		

Total weight : 62

REFERENCE :----

PAGE TOTALS

REVISION NO.

SPECIAL NOTES:-

MATERIAL:-

ASTM: A36 U.N.O.
S. S.: -----
ALUM.: -----
PIPE: A53 GR.B
TUBES: A500 GR.B
HOLES: 13/16 U.N.O
WELDING: E70XX

MATERIAL PREP.:-

CLEAN: SSPC-SP2
SHOP PAINT: TWO COAT OF STD SHOP PRIMER
GALV: GALVANIZED & PAINTED

GEN. NOTES:-

BUY AMERICAN:
DOMESTIC:
CERT/CONFORMANCE:
CERT/COMPLIANCE:

ALL WIDE FLANGE SHAPES TO BE PER A992-G50

FIELD CONNECTIONS :
HOLES : 13/16" U.N.O
PAINT :

morrow steel Fabricators, Inc.

3620 COPELAND DRIVE
ZEPHYRHILLS, FL. 33542

	PRINTS FOR	DATE	MK	REVISIONS	DATE
			0	RELEASED FOR APPROVAL	Nov 18 2025
			1	RELEASED FOR RE-APPROVAL	Jul 13 2026
			2	RELEASED FOR RE-APPROVAL	Aug 26 2026

STRUCTURE:- PINELLAS SUNCOAST TRANSIT AUTHORITY
LOCATION:- CLEARWATER STATION,CLEARWATER,FL.
DETAILER:- VECTORSHADES LLC
CUSTOMER:- KOKOLAKIS
ARCH./ENG.:- CDM SMITH
DESCRIPTION:- WAVE CANOPY VERTICAL BRACE DETAIL
DRAWN:- PBI DATE:-10-27-2025 CHK.D.-RAG DATE:- 10-27-2025

SHOP BILL	WORK ORDER NO.	DRWG. NO.
	2553	1452

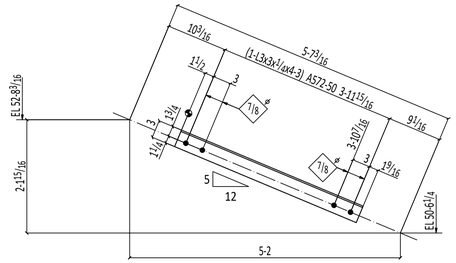

ONE VERTICAL BRACE 1453VB -G

SHOP NOTE:
TOE DIRECTION NEAR SIDE

AESS CATEGORY-3

SHIPPING LIST

MATERIAL BILL

ITEM NO	TOTAL QTY	DESCRIPTION	MAJOR MARK	PAINT CODE	TOTAL WEIGHT	ABM NO	UNIT QTY	LENGTH FT.	LENGTH IN.	MINOR MARK	REMARKS	UNIT WEIGHT	GRADE
	ONE	VERTICAL BRACE	1453VB	G	21						Galv	21	
	1	L3x3x1/4			21		1	4	3	1453VB		21	A572-50
		FIELD BOLTS											
	4	3/4 Dia A325N						0	1 3/4		+1HD WASH		

Total weight : 21

REFERENCE :----

PAGE TOTALS

REVISION NO.

SPECIAL NOTES:-

MATERIAL:-

ASTM: A36 U.N.O.
S. S.: -----
ALUM.: -----
PIPE: A53 GR.B
TUBES: A500 GR.B
HOLES: 13/16 U.N.O
WELDING: E70XX

MATERIAL PREP.:-

CLEAN: SSPC-SP2
SHOP PAINT: TWO COAT OF STD SHOP PRIMER
GALV: GALVANIZED & PAINTED

GEN. NOTES:-

BUY AMERICAN:
DOMESTIC:
CERT/CONFORMANCE:
CERT/COMPLIANCE:

ALL WIDE FLANGE SHAPES TO BE PER A992-G50

FIELD CONNECTIONS :
HOLES : 13/16" U.N.O
PAINT :

morrow steel Fabricators, Inc.

3620 COPELAND DRIVE
ZEPHYRHILLS, FL. 33542

	PRINTS FOR	DATE	MK	REVISIONS	DATE
			0	RELEASED FOR APPROVAL	Nov 18 2025
			1	RELEASED FOR RE-APPROVAL	Jul 13 2026
			2	RELEASED FOR RE-APPROVAL	Aug 26 2026

STRUCTURE:- PINELLAS SUNCOAST TRANSIT AUTHORITY
LOCATION:- CLEARWATER STATION,CLEARWATER,FL.
DETAILER:- VECTORSHADES LLC
CUSTOMER:- KOKOLAKIS
ARCH./ENG.:- CDM SMITH
DESCRIPTION:- WAVE CANOPY VERTICAL BRACE DETAIL
DRAWN:- PBI DATE:- 10-27-2025 CHK.D:- RAG DATE:- 10-27-2025

SHOP BILL	WORK ORDER NO.	DRWG. NO.
	2553	1453

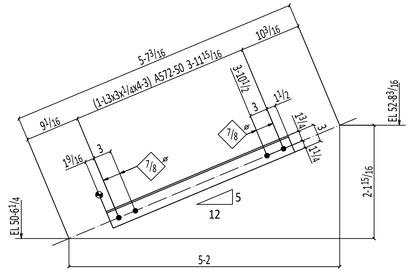

ONE VERTICAL BRACE 1454VB -G

SHOP NOTE:
TOE DIRECTION NEAR SIDE

AESS CATEGORY-3

SHIPPING LIST

MATERIAL BILL

ITEM NO	TOTAL QTY	DESCRIPTION	MAJOR MARK	PAINT CODE	TOTAL WEIGHT	ABM NO	UNIT QTY	LENGTH FT.	LENGTH IN.	MINOR MARK	REMARKS	UNIT WEIGHT	GRADE
	ONE	VERTICAL BRACE	1454VB	G	21						Galv	21	
	1	L3x3x1/4			21		1	4	3	1454VB		21	A572-50
		FIELD BOLTS											
	4	3/4 Dia A325N						0	1 3/4		+1HD WASH		

Total weight : 21

REFERENCE :----

PAGE TOTALS

REVISION NO.

SPECIAL NOTES:-

MATERIAL:-

ASTM:	A36 U.N.O.
S. S.:	-----
ALUM.:	-----
PIPE:	A53 GR.B
TUBES:	A500 GR.B
HOLES:	13/16 U.N.O
WELDING:	E70XX

MATERIAL PREP.:-

CLEAN:	SSPC-SP2
SHOP PAINT:	TWO COAT OF STD SHOP PRIMER
GALV:	GALVANIZED & PAINTED

GEN. NOTES:-

BUY AMERICAN:
DOMESTIC:
CERT/CONFORMANCE:
CERT/COMPLIANCE:

ALL WIDE FLANGE SHAPES TO BE PER A992-G50

FIELD CONNECTIONS :
HOLES : 13/16" U.N.O
PAINT :

morrow steel Fabricators, Inc.

3620 COPELAND DRIVE
ZEPHYRHILLS, FL. 33542

	PRINTS FOR	DATE	MK	REVISIONS	DATE
			0	RELEASED FOR APPROVAL	Nov 18 2025
			1	RELEASED FOR RE-APPROVAL	Jul 13 2026
			2	RELEASED FOR RE-APPROVAL	Aug 26 2026

STRUCTURE:-PINELLAS SUNCOAST TRANSIT AUTHORITY
LOCATION:- CLEARWATER STATION,CLEARWATER,FL.
DETAILER:- VECTORSHADES LLC
CUSTOMER:- KOKOLAKIS
ARCH./ENG.:- CDM SMITH
DESCRIPTION:- WAVE CANOPY VERTICAL BRACE DETAIL
DRAWN:- PBI DATE:-10-27-2025 CHK.D:-RAG DATE:- 10-27-2025

SHOP BILL	WORK ORDER NO.	DRWG. NO.
	2553	1454

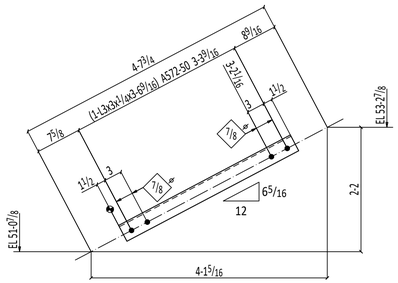

6 VERTICAL BRACES 1455VB -G

SHOP NOTE:
TOE DIRECTION FAR SIDE

SHIPPING LIST

MATERIAL BILL

ITEM NO	TOTAL QTY	DESCRIPTION	MAJOR MARK	PAINT CODE	TOTAL WEIGHT	ABM NO	UNIT QTY	LENGTH FT.	LENGTH IN.	MINOR MARK	REMARKS	UNIT WEIGHT	GRADE
	6	VERTICAL BRACE	1455VB	G	104						Galv	17	
	6	L3x3x$^{1}/_{4}$			104		1	3	6$^{9}/_{16}$	1455VB		17	A572-50
		FIELD BOLTS											
	24	$^{3}/_{4}$ Dia A325N						0	1$^{3}/_{4}$		+1HD WASH		

Total weight : 104

REFERENCE :----

PAGE TOTALS

REVISION NO.

SPECIAL NOTES:-

MATERIAL:-

ASTM: A36 U.N.O.
S. S.: -----
ALUM.: -----
PIPE: A53 GR.B
TUBES: A500 GR.B
HOLES: $^{13}/_{16}$ U.N.O
WELDING: E70XX

MATERIAL PREP.:-

CLEAN: SSPC-SP2
SHOP PAINT: TWO COAT OF STD SHOP PRIMER
GALV: GALVANIZED & PAINTED

GEN. NOTES:-

BUY AMERICAN:
DOMESTIC:
CERT/CONFORMANCE:
CERT/COMPLIANCE:

ALL WIDE FLANGE SHAPES TO BE PER A992-G50

FIELD CONNECTIONS :
HOLES : $^{13}/_{16}$" U.N.O
PAINT :

morrow steel Fabricators, Inc.

3620 COPELAND DRIVE
ZEPHYRHILLS, FL. 33542

	PRINTS FOR	DATE	MK	REVISIONS	DATE
			0	RELEASED FOR APPROVAL	Nov 18 2025
			1	RELEASED FOR RE-APPROVAL	Jul 13 2026
			2	RELEASED FOR RE-APPROVAL	Aug 26 2026

STRUCTURE:- PINELLAS SUNCOAST TRANSIT AUTHORITY
LOCATION:- CLEARWATER STATION,CLEARWATER,FL.
DETAILER:- VECTORSHADES LLC
CUSTOMER:- KOKOLAKIS
ARCH./ENG.:- CDM SMITH
DESCRIPTION:- WAVE CANOPY VERTICAL BRACE DETAIL
DRAWN:- PBI DATE:- 10-27-2025 CHK.D:- RAG DATE:- 10-27-2025

SHOP BILL	WORK ORDER NO.	DRWG. NO.
	2553	1455 ⚠1

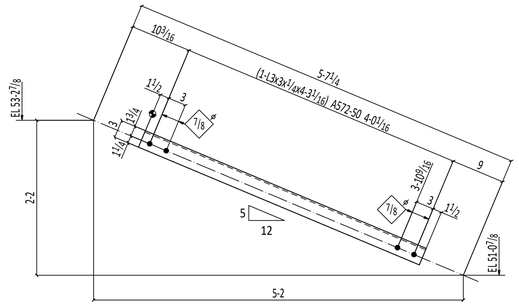

ONE VERTICAL BRACE 1456VB -G

SHOP NOTE:
TOE DIRECTION FAR SIDE

AESS CATEGORY-3

SHIPPING LIST / MATERIAL BILL

ITEM NO	TOTAL QTY	DESCRIPTION	MAJOR MARK	PAINT CODE	TOTAL WEIGHT	ABM NO	UNIT QTY	LENGTH FT.	LENGTH IN.	MINOR MARK	REMARKS	UNIT WEIGHT	GRADE
	ONE	VERTICAL BRACE	1456VB	G	21						Galv	21	
	1	L3x3x¼			21		1	4	3 1/16	1456VB		21	A572-50
		FIELD BOLTS											
	4	¾ Dia A325N						0	1¾		+1HD WASH		

Total weight : 21

REFERENCE :----

PAGE TOTALS

REVISION NO.

SPECIAL NOTES:-

MATERIAL:-

ASTM:	A36 U.N.O.
S. S.:	-----
ALUM.:	-----
PIPE:	A53 GR.B
TUBES:	A500 GR.B
HOLES:	13/16 U.N.O
WELDING:	E70XX

MATERIAL PREP.:-

CLEAN:	SSPC-SP2
SHOP PAINT:	TWO COAT OF STD SHOP PRIMER
GALV:	GALVANIZED & PAINTED

GEN. NOTES:-

BUY AMERICAN:
DOMESTIC:
CERT/CONFORMANCE:
CERT/COMPLIANCE:

ALL WIDE FLANGE SHAPES TO BE PER A992-G50

FIELD CONNECTIONS :
HOLES : 13/16" U.N.O
PAINT :

morrow steel Fabricators, Inc.

3620 COPELAND DRIVE
ZEPHYRHILLS, FL. 33542

	PRINTS FOR	DATE	MK	REVISIONS	DATE
			0	RELEASED FOR APPROVAL	Nov 18 2025
			1	RELEASED FOR RE-APPROVAL	Jul 13 2026
			2	RELEASED FOR RE-APPROVAL	Aug 26 2026

STRUCTURE:- PINELLAS SUNCOAST TRANSIT AUTHORITY
LOCATION:- CLEARWATER STATION,CLEARWATER,FL.
DETAILER:- VECTORSHADES LLC
CUSTOMER:- KOKOLAKIS
ARCH./ENG.:- CDM SMITH
DESCRIPTION:- WAVE CANOPY VERTICAL BRACE DETAIL
DRAWN:- PBI DATE:-10-27-2025 CHK.D.-RAG DATE:- 10-27-2025

SHOP BILL	WORK ORDER NO.	DRWG. NO.
	2553	1456

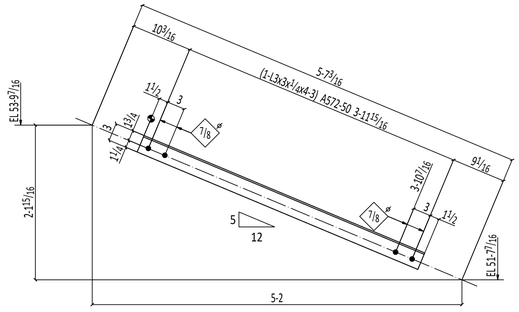

ONE VERTICAL BRACE 1457VB -G

SHOP NOTE:
TOE DIRECTION NEAR SIDE

AESS CATEGORY-3

SHIPPING LIST

MATERIAL BILL

ITEM NO	TOTAL QTY	DESCRIPTION	MAJOR MARK	PAINT CODE	TOTAL WEIGHT	ABM NO	UNIT QTY	LENGTH FT.	LENGTH IN.	MINOR MARK	REMARKS	UNIT WEIGHT	GRADE
	ONE	VERTICAL BRACE	1457VB	G	21						Galv	21	
	1	L3x3x1/4			21		1	4	3	1457VB		21	A572-50
		FIELD BOLTS											
	4	3/4 Dia A325N						0	13/4		+1HD WASH		

Total weight : 21

REFERENCE :----

PAGE TOTALS

REVISION NO.

SPECIAL NOTES:-

MATERIAL:-
ASTM: A36 U.N.O.
S. S.: -----
ALUM.: -----
PIPE: A53 GR.B
TUBES: A500 GR.B
HOLES: 13/16 U.N.O
WELDING: E70XX

MATERIAL PREP.:-
CLEAN: SSPC-SP2
SHOP PAINT: TWO COAT OF STD SHOP PRIMER
GALV: GALVANIZED & PAINTED

GEN. NOTES:-
BUY AMERICAN:
DOMESTIC:
CERT/CONFORMANCE:
CERT/COMPLIANCE:

ALL WIDE FLANGE SHAPES TO BE PER A992-G50

FIELD CONNECTIONS :
HOLES : 13/16" U.N.O
PAINT :

morrow steel Fabricators, Inc.

3620 COPELAND DRIVE
ZEPHYRHILLS, FL. 33542

PRINTS FOR	DATE	MK	REVISIONS	DATE
		0	RELEASED FOR APPROVAL	Nov 18 2025
		1	RELEASED FOR RE-APPROVAL	Jul 13 2026
		2	RELEASED FOR RE-APPROVAL	Aug 26 2026

STRUCTURE:- PINELLAS SUNCOAST TRANSIT AUTHORITY
LOCATION:- CLEARWATER STATION,CLEARWATER,FL.
DETAILER:- VECTORSHADES LLC.
CUSTOMER:- KOKOLAKIS
ARCH./ENG.:- CDM SMITH
DESCRIPTION:- WAVE CANOPY VERTICAL BRACE DETAIL
DRAWN:- PBJ DATE:- 10-27-2025 CHK.D:- RAG DATE:- 10-27-2025

SHOP BILL	WORK ORDER NO.	DRWG. NO.
	2553	1457

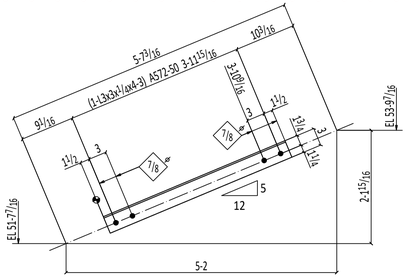

ONE VERTICAL BRACE 1458VB -G

SHOP NOTE:
TOE DIRECTION NEAR SIDE

AESS CATEGORY-3

SHIPPING LIST

MATERIAL BILL

ITEM NO	TOTAL QTY	DESCRIPTION	MAJOR MARK	PAINT CODE	TOTAL WEIGHT	ABM NO	UNIT QTY	LENGTH FT.	LENGTH IN.	MINOR MARK	REMARKS	UNIT WEIGHT	GRADE
	ONE	VERTICAL BRACE	1458VB	G	21						Galv	21	
	1	L3x3x1/4			21		1	4	3	1458VB		21	A572-50
		FIELD BOLTS											
	4	3/4 Dia A325N						0	1 3/4		+1HD WASH		

Total weight : 21

REFERENCE :----

PAGE TOTALS

REVISION NO.

SPECIAL NOTES:-

MATERIAL:-

ASTM:	A36 U.N.O.
S. S.:	-----
ALUM.:	-----
PIPE:	A53 GR.B
TUBES:	A500 GR.B
HOLES:	13/16 U.N.O
WELDING:	E70XX

MATERIAL PREP.:-

CLEAN: SSPC-SP2

SHOP PAINT: TWO COAT OF STD SHOP PRIMER

GALV: GALVANIZED & PAINTED

GEN. NOTES:-

BUY AMERICAN:

DOMESTIC:

CERT/CONFORMANCE:

CERT/COMPLIANCE:

ALL WIDE FLANGE SHAPES TO BE PER A992-G50

FIELD CONNECTIONS :

HOLES : 13/16" U.N.O

PAINT :

morrow steel Fabricators, Inc.

3620 COPELAND DRIVE
ZEPHYRHILLS, FL. 33542

	PRINTS FOR	DATE	MK	REVISIONS	DATE
			0	RELEASED FOR APPROVAL	Nov 18 2025
			1	RELEASED FOR RE-APPROVAL	Jul 13 2026
			2	RELEASED FOR RE-APPROVAL	Aug 26 2026

STRUCTURE:- PINELLAS SUNCOAST TRANSIT AUTHORITY
LOCATION:- CLEARWATER STATION,CLEARWATER,FL.
DETAILER:- VECTORSHADES LLC
CUSTOMER:- KOKOLAKIS
ARCH./ENG.:- CDM SMITH
DESCRIPTION:- WAVE CANOPY VERTICAL BRACE DETAIL
DRAWN:- PBI DATE:- 10-27-2025 CHK.D.- RAG DATE:- 10-27-2025

SHOP BILL	WORK ORDER NO.	DRWG. NO.
	2553	1458

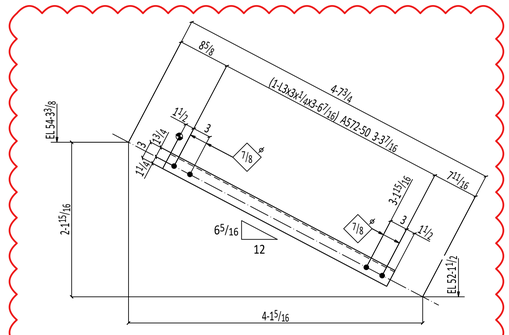

12 VERTICAL BRACES 1459VB-G

SHOP NOTE:
TOE DIRECTION FAR SIDE

SHIPPING LIST / MATERIAL BILL

ITEM NO	TOTAL QTY	DESCRIPTION	MAJOR MARK	PAINT CODE	TOTAL WEIGHT	ABM NO	UNIT QTY	LENGTH FT.	LENGTH IN.	MINOR MARK	REMARKS	UNIT WEIGHT	GRADE
	12	VERTICAL BRACE	1459VB	G	208						Galv	17	
	12	L3x3x1/4			208		1	3	6 7/16	1459VB		17	A572-50
		FIELD BOLTS											
	48	3/4 Dia A325N						0	1 3/4		+1HD WASH		

Total weight : 208

REFERENCE :----

PAGE TOTALS

REVISION NO.

SPECIAL NOTES:-

MATERIAL:-

ASTM:	A36 U.N.O.
S. S.:	-----
ALUM.:	-----
PIPE:	A53 GR.B
TUBES:	A500 GR.B
HOLES:	13/16 U.N.O
WELDING:	E70XX

MATERIAL PREP.:-

CLEAN:	SSPC-SP2
SHOP PAINT:	TWO COAT OF STD SHOP PRIMER
GALV:	GALVANIZED & PAINTED

GEN. NOTES:-

BUY AMERICAN:
DOMESTIC:
CERT/CONFORMANCE:
CERT/COMPLIANCE:

ALL WIDE FLANGE SHAPES TO BE PER A992-G50

FIELD CONNECTIONS :
HOLES : 13/16" U.N.O
PAINT :

morrow steel Fabricators, Inc.

3620 COPELAND DRIVE
ZEPHYRHILLS, FL. 33542

	PRINTS FOR	DATE	MK	REVISIONS	DATE
			0	RELEASED FOR APPROVAL	Nov 18 2025
			1	RELEASED FOR RE-APPROVAL	Jul 13 2026
			2	RELEASED FOR RE-APPROVAL	Aug 26 2026

STRUCTURE:- PINELLAS SUNCOAST TRANSIT AUTHORITY
LOCATION:- CLEARWATER STATION,CLEARWATER,FL.
DETAILER:- VECTORSHADES LLC
CUSTOMER:- KOKOLAKIS
ARCH./ENG.:- CDM SMITH
DESCRIPTION:- WAVE CANOPY VERTICAL BRACE DETAIL
DRAWN:- PBI DATE:-10-27-2025 CHK.D.-RAG DATE:- 10-27-2025

SHOP BILL	WORK ORDER NO.	DRWG. NO.
	2553	1459

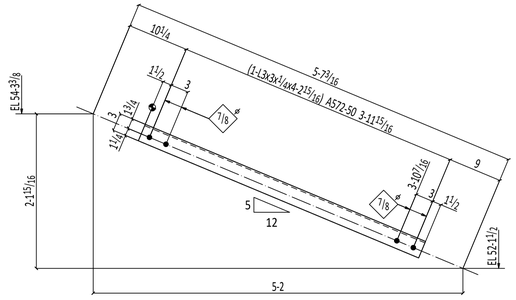

ONE VERTICAL BRACE 1460VB -G

SHOP NOTE:
TOE DIRECTION FAR SIDE

AESS CATEGORY-3

SHIPPING LIST

MATERIAL BILL

ITEM NO	TOTAL QTY	DESCRIPTION	MAJOR MARK	PAINT CODE	TOTAL WEIGHT	ABM NO	UNIT QTY	LENGTH FT.	LENGTH IN.	MINOR MARK	REMARKS	UNIT WEIGHT	GRADE
	ONE	VERTICAL BRACE	1460VB	G	21						Galv	21	
	1	L3x3x¼			21		1	4	2 15/16	1460VB		21	A572-50
		FIELD BOLTS											
	4	¾ Dia A325N						0	1¾		+1HD WASH		

Total weight : 21

REFERENCE :----

PAGE TOTALS

REVISION NO.

SPECIAL NOTES:-

MATERIAL:-
ASTM: A36 U.N.O.
S. S.: -----
ALUM.: -----
PIPE: A53 GR.B
TUBES: A500 GR.B
HOLES: 13/16 U.N.O
WELDING: E70XX

MATERIAL PREP.:-
CLEAN: SSPC-SP2
SHOP PAINT: TWO COAT OF STD SHOP PRIMER
GALV: GALVANIZED & PAINTED

GEN. NOTES:-
BUY AMERICAN:
DOMESTIC:
CERT/CONFORMANCE:
CERT/COMPLIANCE:

ALL WIDE FLANGE SHAPES TO BE PER A992-G50

FIELD CONNECTIONS :
HOLES : 13/16" U.N.O
PAINT :

morrow steel Fabricators, Inc.

3620 COPELAND DRIVE
ZEPHYRHILLS, FL. 33542

	PRINTS FOR	DATE	MK	REVISIONS	DATE
			0	RELEASED FOR APPROVAL	Nov 18 2025
			1	RELEASED FOR RE-APPROVAL	Jul 13 2026
			2	RELEASED FOR RE-APPROVAL	Aug 26 2026

STRUCTURE:- PINELLAS SUNCOAST TRANSIT AUTHORITY
LOCATION:- CLEARWATER STATION,CLEARWATER,FL.
DETAILER:- VECTORSHADES LLC
CUSTOMER:- KOKOLAKIS
ARCH./ENG.:- CDM SMITH
DESCRIPTION:- WAVE CANOPY VERTICAL BRACE DETAIL
DRAWN:- PBI DATE:-10-27-2025 CHK.D:-RAG DATE:- 10-27-2025

SHOP BILL	WORK ORDER NO.	DRWG. NO.
	2553	1460

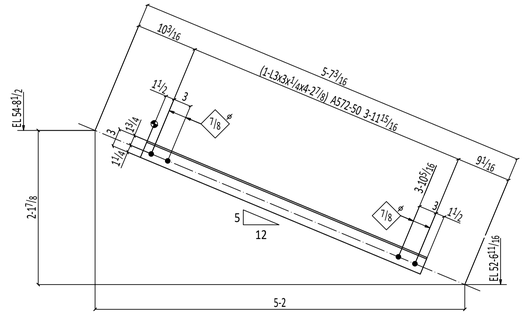

ONE VERTICAL BRACE 1461VB-G

SHOP NOTE:
TOE DIRECTION NEAR SIDE

AESS CATEGORY-3

SHIPPING LIST

MATERIAL BILL

ITEM NO	TOTAL QTY	DESCRIPTION	MAJOR MARK	PAINT CODE	TOTAL WEIGHT	ABM NO	UNIT QTY	LENGTH FT.	LENGTH IN.	MINOR MARK	REMARKS	UNIT WEIGHT	GRADE
	ONE	VERTICAL BRACE	1461VB	G	21						Galv	21	
	1	L3x3x1/4			21		1	4	2 7/8	1461VB		21	A572-50
		FIELD BOLTS											
	4	3/4 Dia A325N						0	1 3/4		+1HD WASH		

Total weight : 21

REFERENCE :----

PAGE TOTALS

REVISION NO.

SPECIAL NOTES:-

MATERIAL:-

ASTM: A36 U.N.O.
S. S.: -----
ALUM.: -----
PIPE: A53 GR.B
TUBES: A500 GR.B
HOLES: 13/16 U.N.O
WELDING: E70XX

MATERIAL PREP.:-

CLEAN: SSPC-SP2
SHOP PAINT: TWO COAT OF STD SHOP PRIMER
GALV: GALVANIZED & PAINTED

GEN. NOTES:-

BUY AMERICAN:
DOMESTIC:
CERT/CONFORMANCE:
CERT/COMPLIANCE:

ALL WIDE FLANGE SHAPES TO BE PER A992-G50

FIELD CONNECTIONS :
HOLES : 13/16" U.N.O
PAINT :

morrow steel Fabricators, Inc.

3620 COPELAND DRIVE
ZEPHYRHILLS, FL. 33542

	PRINTS FOR	DATE	MK	REVISIONS	DATE
			0	RELEASED FOR APPROVAL	Nov 18 2025
			1	RELEASED FOR RE-APPROVAL	Jul 13 2026
			2	RELEASED FOR RE-APPROVAL	Aug 26 2026

STRUCTURE:-PINELLAS SUNCOAST TRANSIT AUTHORITY
LOCATION:- CLEARWATER STATION,CLEARWATER,FL.
DETAILER:- VECTORSHADES LLC
CUSTOMER:- KOKOLAKIS
ARCH./ENG.:- CDM SMITH
DESCRIPTION:- WAVE CANOPY VERTICAL BRACE DETAIL
DRAWN:- PBI DATE:- 10-27-2025 CHK.D:- RAG DATE:- 10-27-2025

SHOP BILL	WORK ORDER NO.	DRWG. NO.
	2553	1461

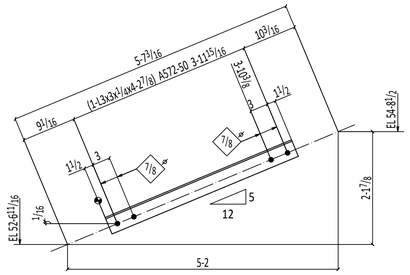

ONE VERTICAL BRACE 1462VB -G

SHOP NOTE:
TOE DIRECTION NEAR SIDE

AESS CATEGORY-3

SHIPPING LIST / MATERIAL BILL

ITEM NO	TOTAL QTY	DESCRIPTION	MAJOR MARK	PAINT CODE	TOTAL WEIGHT	ABM NO	UNIT QTY	LENGTH FT.	LENGTH IN.	MINOR MARK	REMARKS	UNIT WEIGHT	GRADE
	ONE	VERTICAL BRACE	1462VB	G	21						Galv	21	
	1	L3x3x1/4			21		1	4	2 7/8	1462VB		21	A572-50
		FIELD BOLTS											
	4	3/4 Dia A325N						0	1 3/4		+1HD WASH		

Total weight : 21

REFERENCE :----

PAGE TOTALS

REVISION NO.

SPECIAL NOTES:-

MATERIAL:-

ASTM: A36 U.N.O.
S. S.: -----
ALUM.: -----
PIPE: A53 GR.B
TUBES: A500 GR.B
HOLES: 13/16 U.N.O
WELDING: E70XX

MATERIAL PREP.:-

CLEAN: SSPC-SP2
SHOP PAINT: TWO COAT OF STD SHOP PRIMER
GALV: GALVANIZED & PAINTED

GEN. NOTES:-

BUY AMERICAN:
DOMESTIC:
CERT/CONFORMANCE:
CERT/COMPLIANCE:

ALL WIDE FLANGE SHAPES TO BE PER A992-G50

FIELD CONNECTIONS :
HOLES : 13/16" U.N.O
PAINT :

morrow steel Fabricators, Inc.

3620 COPELAND DRIVE
ZEPHYRHILLS, FL. 33542

	PRINTS FOR	DATE	MK	REVISIONS	DATE
			0	RELEASED FOR APPROVAL	Nov 18 2025
			1	RELEASED FOR RE-APPROVAL	Jul 13 2026
			2	RELEASED FOR RE-APPROVAL	Aug 26 2026

STRUCTURE:- PINELLAS SUNCOAST TRANSIT AUTHORITY
LOCATION:- CLEARWATER STATION,CLEARWATER,FL.
DETAILER:- VECTORSHADES LLC
CUSTOMER:- KOKOLAKIS
ARCH./ENG.:- CDM SMITH
DESCRIPTION:- WAVE CANOPY VERTICAL BRACE DETAIL
DRAWN:- PBI DATE:-10-27-2025 CHK.D.-RAG DATE:- 10-27-2025

SHOP BILL	WORK ORDER NO.	DRWG. NO.
	2553	1462

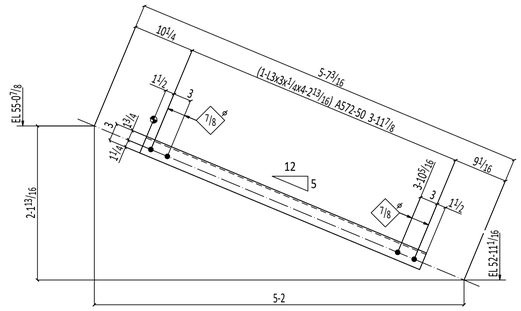

ONE VERTICAL BRACE 1463VB-G

SHOP NOTE:
TOE DIRECTION FAR SIDE

AESS CATEGORY-3

SHIPPING LIST / MATERIAL BILL

ITEM NO	TOTAL QTY	DESCRIPTION	MAJOR MARK	PAINT CODE	TOTAL WEIGHT	ABM NO	UNIT QTY	LENGTH FT.	LENGTH IN.	MINOR MARK	REMARKS	UNIT WEIGHT	GRADE
	ONE	VERTICAL BRACE	1463VB	G	21						Galv	21	
	1	L3x3x1/4			21		1	4	2 13/16	1463VB		21	A572-50
		FIELD BOLTS											
	4	3/4 Dia A325N						0	1 3/4		+1HD WASH		

Total weight : 21

REFERENCE :----

PAGE TOTALS

REVISION NO.

SPECIAL NOTES:-

MATERIAL:-

ASTM:	A36 U.N.O.
S. S.:	-----
ALUM.:	-----
PIPE:	A53 GR.B
TUBES:	A500 GR.B
HOLES:	13/16 U.N.O
WELDING:	E70XX

MATERIAL PREP.:-

CLEAN:	SSPC-SP2
SHOP PAINT:	TWO COAT OF STD SHOP PRIMER
GALV:	GALVANIZED & PAINTED

GEN. NOTES:-

BUY AMERICAN:
DOMESTIC:
CERT/CONFORMANCE:
CERT/COMPLIANCE:

ALL WIDE FLANGE SHAPES TO BE PER A992-G50

FIELD CONNECTIONS :
HOLES : 13/16" U.N.O
PAINT :

morrow steel Fabricators, Inc.

3620 COPELAND DRIVE
ZEPHYRHILLS, FL. 33542

	PRINTS FOR	DATE	MK	REVISIONS	DATE
			0	RELEASED FOR APPROVAL	Nov 18 2025
			1	RELEASED FOR RE-APPROVAL	Jul 13 2026
			2	RELEASED FOR RE-APPROVAL	Aug 26 2026

STRUCTURE:- PINELLAS SUNCOAST TRANSIT AUTHORITY
LOCATION:- CLEARWATER STATION,CLEARWATER,FL.
DETAILER:- VECTORSHADES LLC
CUSTOMER:- KOKOLAKIS
ARCH./ENG.:- CDM SMITH
DESCRIPTION:- WAVE CANOPY VERTICAL BRACE DETAIL
DRAWN:- PBI DATE:-10-27-2025 CHK.D:-RAG DATE:- 10-27-2025

SHOP BILL	WORK ORDER NO.	DRWG. NO.
	2553	1463

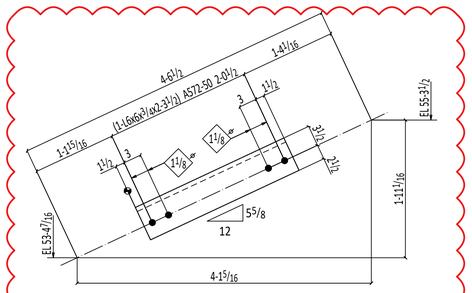

6 VERTICAL BRACES 1464VB -G

SHOP NOTE:
TOE DIRECTION FAR SIDE

SHIPPING LIST

MATERIAL BILL

ITEM NO	TOTAL QTY	DESCRIPTION	MAJOR MARK	PAINT CODE	TOTAL WEIGHT	ABM NO	UNIT QTY	LENGTH FT.	LENGTH IN.	MINOR MARK	REMARKS	UNIT WEIGHT	GRADE
	6	VERTICAL BRACE	1464VB	G	395						Galv	66	
	6	L6x6x3/4			395		1	2	3 1/2	1464VB		66	A572-50
		FIELD BOLTS											
	24	1 Dia A325N						0	2 3/4		+1HD WASH		

Total weight : 395

REFERENCE :----

PAGE TOTALS

REVISION NO.

SPECIAL NOTES:-

MATERIAL:-

ASTM: A36 U.N.O.
S. S.: -----
ALUM.: -----
PIPE: A53 GR.B
TUBES: A500 GR.B
HOLES: 13/16 U.N.O
WELDING: E70XX

MATERIAL PREP.:-

CLEAN: SSPC-SP2
SHOP PAINT: TWO COAT OF STD SHOP PRIMER
GALV: GALVANIZED & PAINTED

GEN. NOTES:-

BUY AMERICAN:
DOMESTIC:
CERT/CONFORMANCE:
CERT/COMPLIANCE:

ALL WIDE FLANGE SHAPES TO BE PER A992-G50

FIELD CONNECTIONS :
HOLES : 13/16" U.N.O
PAINT :

morrow steel Fabricators, Inc.

3620 COPELAND DRIVE
ZEPHYRHILLS, FL. 33542

	PRINTS FOR	DATE	MK	REVISIONS	DATE
			0	RELEASED FOR APPROVAL	Nov 18 2025
			1	RELEASED FOR RE-APPROVAL	Jul 13 2026
			2	RELEASED FOR RE-APPROVAL	Aug 26 2026

STRUCTURE:- PINELLAS SUNCOAST TRANSIT AUTHORITY
LOCATION:- CLEARWATER STATION,CLEARWATER,FL.
DETAILER:- VECTORSHADES LLC
CUSTOMER:- KOKOLAKIS
ARCH./ENG.:- CDM SMITH
DESCRIPTION:- WAVE CANOPY VERTICAL BRACE DETAIL
DRAWN:- PBI DATE:-10-27-2025 CHK.D.-RAG DATE:- 10-27-2025

SHOP BILL	WORK ORDER NO.	DRWG. NO.
	2553	1464

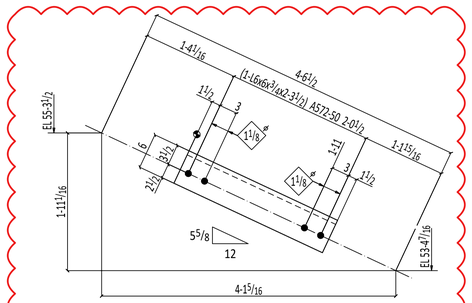

6 VERTICAL BRACES 1465VB-G

SHOP NOTE:
TOE DIRECTION FAR SIDE

SHIPPING LIST

MATERIAL BILL

ITEM NO	TOTAL QTY	DESCRIPTION	MAJOR MARK	PAINT CODE	TOTAL WEIGHT	ABM NO	UNIT QTY	LENGTH FT.	LENGTH IN.	MINOR MARK	REMARKS	UNIT WEIGHT	GRADE
	6	VERTICAL BRACE	1465VB	G	395						Galv	66	
	6	L6x6x3/4			395		1	2	3 1/2	1465VB		66	A572-50
		FIELD BOLTS											
	24	1 Dia A325N						0	2 3/4		+1HD WASH		

Total weight : 395

REFERENCE :----

PAGE TOTALS

REVISION NO.

SPECIAL NOTES:-

MATERIAL:-
ASTM: A36 U.N.O.
S. S.: -----
ALUM.: -----
PIPE: A53 GR.B
TUBES: A500 GR.B
HOLES: 13/16 U.N.O
WELDING: E70XX

MATERIAL PREP.:-
CLEAN: SSPC-SP2
SHOP PAINT: TWO COAT OF STD SHOP PRIMER
GALV: GALVANIZED & PAINTED

GEN. NOTES:-
BUY AMERICAN:
DOMESTIC:
CERT/CONFORMANCE:
CERT/COMPLIANCE:

ALL WIDE FLANGE SHAPES TO BE PER A992-G50

FIELD CONNECTIONS :
HOLES : 13/16" U.N.O
PAINT :

morrow steel Fabricators, Inc.

3620 COPELAND DRIVE
ZEPHYRHILLS, FL. 33542

	PRINTS FOR	DATE	MK	REVISIONS	DATE
			0	RELEASED FOR APPROVAL	Nov 18 2025
			1	RELEASED FOR RE-APPROVAL	Jul 13 2026
			2	RELEASED FOR RE-APPROVAL	Aug 26 2026

STRUCTURE:-PINELLAS SUNCOAST TRANSIT AUTHORITY
LOCATION:- CLEARWATER STATION,CLEARWATER,FL.
DETAILER:- VECTORSHADES LLC
CUSTOMER:- KOKOLAKIS
ARCH./ENG.:- CDM SMITH
DESCRIPTION:-WAVE CANOPY VERTICAL BRACE DETAIL
DRAWN:- PBI DATE:-10-27-2025 CHK.D:-RAG DATE:- 10-27-2025

SHOP BILL	WORK ORDER NO.	DRWG. NO.
	2553	1465

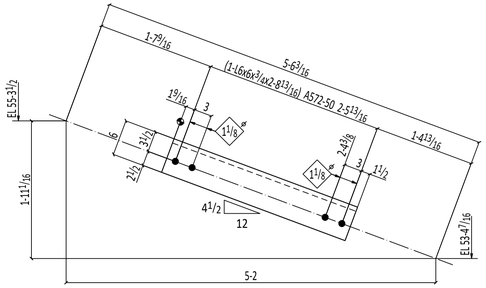

ONE VERTICAL BRACE 1466VB-G

SHOP NOTE:
TOE DIRECTION FAR SIDE

AESS CATEGORY-3

SHIPPING LIST / MATERIAL BILL

ITEM NO	TOTAL QTY	DESCRIPTION	MAJOR MARK	PAINT CODE	TOTAL WEIGHT	ABM NO	UNIT QTY	LENGTH FT.	LENGTH IN.	MINOR MARK	REMARKS	UNIT WEIGHT	GRADE
	ONE	VERTICAL BRACE	1466VB	G	79						Galv	79	
	1	L6x6x3/4			79		1	2	8 13/16	1466VB		79	A572-50
		FIELD BOLTS											
	4	1 Dia A325N						0	2 3/4		+1HD WASH		

Total weight : 79

REFERENCE :----

PAGE TOTALS

REVISION NO.

SPECIAL NOTES:-

MATERIAL:-
ASTM: A36 U.N.O.
S.S.: -----
ALUM.: -----
PIPE: A53 GR.B
TUBES: A500 GR.B
HOLES: 13/16 U.N.O
WELDING: E70XX

MATERIAL PREP.:-
CLEAN: SSPC-SP2
SHOP PAINT: TWO COAT OF STD SHOP PRIMER
GALV: GALVANIZED & PAINTED

GEN. NOTES:-
BUY AMERICAN:
DOMESTIC:
CERT/CONFORMANCE:
CERT/COMPLIANCE:

ALL WIDE FLANGE SHAPES TO BE PER A992-G50

FIELD CONNECTIONS :
HOLES : 13/16" U.N.O
PAINT :

morrow steel Fabricators, Inc.

3620 COPELAND DRIVE
ZEPHYRHILLS, FL. 33542

	PRINTS FOR	DATE	MK	REVISIONS	DATE
			0	RELEASED FOR APPROVAL	Nov 18 2025
			1	RELEASED FOR RE-APPROVAL	Jul 13 2026
			2	RELEASED FOR RE-APPROVAL	Aug 26 2026

STRUCTURE:- PINELLAS SUNCOAST TRANSIT AUTHORITY
LOCATION:- CLEARWATER STATION,CLEARWATER,FL.
DETAILER:- VECTORSHADES LLC
CUSTOMER:- KOKOLAKIS
ARCH./ENG.:- CDM SMITH
DESCRIPTION:- WAVE CANOPY VERTICAL BRACE DETAIL
DRAWN:- PBI DATE:- 10-27-2025 CHK.D:- RAG DATE:- 10-27-2025

SHOP BILL	WORK ORDER NO.	DRWG. NO.
	2553	1466 ⚠1

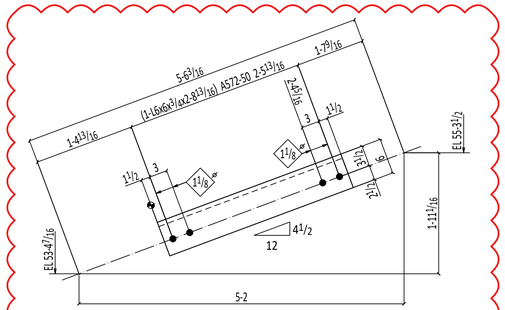

ONE VERTICAL BRACE 1467VB -G

SHOP NOTE:
TOE DIRECTION FAR SIDE

AESS CATEGORY-3

SHIPPING LIST / MATERIAL BILL

ITEM NO	TOTAL QTY	DESCRIPTION	MAJOR MARK	PAINT CODE	TOTAL WEIGHT	ABM NO	UNIT QTY	LENGTH FT.	LENGTH IN.	MINOR MARK	REMARKS	UNIT WEIGHT	GRADE
	ONE	VERTICAL BRACE	1467VB	G	79						Galv	79	
	1	L6x6x3/4			79		1	2	8 13/16	1467VB		79	A572-50
		FIELD BOLTS											
	4	1 Dia A325N						0	2 3/4		+1HD WASH		

Total weight : 79

REFERENCE :----

PAGE TOTALS

REVISION NO.

SPECIAL NOTES:-

MATERIAL:-
ASTM: A36 U.N.O.
S. S.: -----
ALUM.: -----
PIPE: A53 GR.B
TUBES: A500 GR.B
HOLES: 13/16 U.N.O
WELDING: E70XX

MATERIAL PREP.:-
CLEAN: SSPC-SP2
SHOP PAINT: TWO COAT OF STD SHOP PRIMER
GALV: GALVANIZED & PAINTED

GEN. NOTES:-
BUY AMERICAN:
DOMESTIC:
CERT/CONFORMANCE:
CERT/COMPLIANCE:

ALL WIDE FLANGE SHAPES TO BE PER A992-G50

FIELD CONNECTIONS :
HOLES : 13/16" U.N.O
PAINT :

morrow steel Fabricators, Inc.

3620 COPELAND DRIVE
ZEPHYRHILLS, FL. 33542

	PRINTS FOR	DATE	MK	REVISIONS	DATE
			0	RELEASED FOR APPROVAL	Nov 18 2025
			1	RELEASED FOR RE-APPROVAL	Jul 13 2026
			2	RELEASED FOR RE-APPROVAL	Aug 26 2026

STRUCTURE:- PINELLAS SUNCOAST TRANSIT AUTHORITY
LOCATION:- CLEARWATER STATION,CLEARWATER,FL.
DETAILER:- VECTORSHADES LLC
CUSTOMER:- KOKOLAKIS
ARCH./ENG.:- CDM SMITH
DESCRIPTION:- WAVE CANOPY VERTICAL BRACE DETAIL
DRAWN:- PBI DATE:- 10-27-2025 CHK.D:- RAG DATE:- 10-27-2025

SHOP BILL	WORK ORDER NO.	DRWG. NO.
	2553	1467

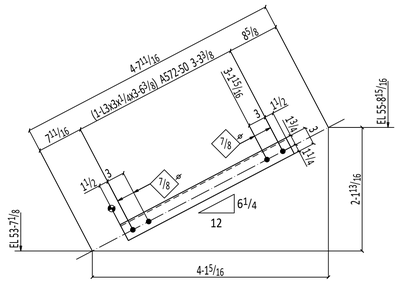

6 VERTICAL BRACES 1468VB -G

SHOP NOTE:
TOE DIRECTION FAR SIDE

SHIPPING LIST

MATERIAL BILL

ITEM NO	TOTAL QTY	DESCRIPTION	MAJOR MARK	PAINT CODE	TOTAL WEIGHT	ABM NO	UNIT QTY	LENGTH FT.	LENGTH IN.	MINOR MARK	REMARKS	UNIT WEIGHT	GRADE
	6	VERTICAL BRACE	1468VB	G	104						Galv	17	
	6	L3x3x1/4			104		1	3	6 3/8	1468VB		17	A572-50
		FIELD BOLTS											
	24	3/4 Dia A325N						0	1 3/4		+1HD WASH		

Total weight : 104

REFERENCE :----

PAGE TOTALS

REVISION NO.

SPECIAL NOTES:-

MATERIAL:-
ASTM: A36 U.N.O.
S. S.: -----
ALUM.: -----
PIPE: A53 GR.B
TUBES: A500 GR.B
HOLES: 13/16 U.N.O
WELDING: E70XX

MATERIAL PREP.:-
CLEAN: SSPC-SP2
SHOP PAINT: TWO COAT OF STD SHOP PRIMER
GALV: GALVANIZED & PAINTED

GEN. NOTES:-
BUY AMERICAN:
DOMESTIC:
CERT/CONFORMANCE:
CERT/COMPLIANCE:

ALL WIDE FLANGE SHAPES TO BE PER A992-G50

FIELD CONNECTIONS :
HOLES : 13/16" U.N.O
PAINT :

morrow steel Fabricators, Inc.

3620 COPELAND DRIVE
ZEPHYRHILLS, FL. 33542

	PRINTS FOR	DATE	MK	REVISIONS	DATE
			0	RELEASED FOR APPROVAL	Nov 18 2025
			1	RELEASED FOR RE-APPROVAL	Jul 13 2026
			2	RELEASED FOR RE-APPROVAL	Aug 26 2026

STRUCTURE:-PINELLAS SUNCOAST TRANSIT AUTHORITY
LOCATION:- CLEARWATER STATION,CLEARWATER,FL.
DETAILER:- VECTORSHADES LLC
CUSTOMER:- KOKOLAKIS
ARCH./ENG.:- CDM SMITH
DESCRIPTION:-WAVE CANOPY VERTICAL BRACE DETAIL
DRAWN:- PBI DATE:-10-27-2025 CHK.D:-RAG DATE:- 10-27-2025

SHOP BILL	WORK ORDER NO.	DRWG. NO.
	2553	1468

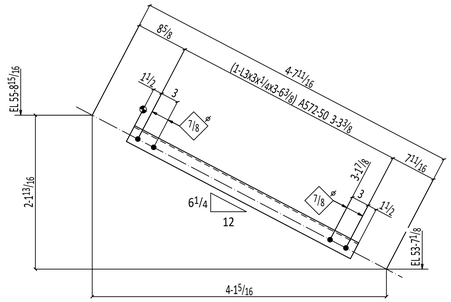

15 VERTICAL BRACES 1469VB -G

SHOP NOTE:
TOE DIRECTION FAR SIDE

SHIPPING LIST

MATERIAL BILL

ITEM NO	TOTAL QTY	DESCRIPTION	MAJOR MARK	PAINT CODE	TOTAL WEIGHT	ABM NO	UNIT QTY	LENGTH FT.	LENGTH IN.	MINOR MARK	REMARKS	UNIT WEIGHT	GRADE
	15	VERTICAL BRACE	1469VB	G	260						Galv	17	
	15	L3x3x1/4			260		1	3	6 3/8	1469VB		17	A572-50
		FIELD BOLTS											
	60	3/4 Dia A325N						0	1 3/4		+1HD WASH		

Total weight : 260

REFERENCE :----

PAGE TOTALS

REVISION NO.

SPECIAL NOTES:-

MATERIAL:-

ASTM:	A36 U.N.O.
S. S.:	-----
ALUM.:	-----
PIPE:	A53 GR.B
TUBES:	A500 GR.B
HOLES:	13/16 U.N.O
WELDING:	E70XX

MATERIAL PREP.:-

CLEAN:	SSPC-SP2
SHOP PAINT:	TWO COAT OF STD SHOP PRIMER
GALV:	GALVANIZED & PAINTED

GEN. NOTES:-

BUY AMERICAN:	
DOMESTIC:	
CERT/CONFORMANCE:	
CERT/COMPLIANCE:	

ALL WIDE FLANGE SHAPES TO BE PER A992-G50

FIELD CONNECTIONS :
HOLES : 13/16" U.N.O
PAINT :

morrow steel Fabricators, Inc.

3620 COPELAND DRIVE
ZEPHYRHILLS, FL. 33542

	PRINTS FOR	DATE	MK	REVISIONS	DATE
			0	RELEASED FOR APPROVAL	Nov 18 2025
			1	RELEASED FOR RE-APPROVAL	Jul 13 2026
			2	RELEASED FOR RE-APPROVAL	Aug 26 2026

STRUCTURE:- PINELLAS SUNCOAST TRANSIT AUTHORITY
LOCATION:- CLEARWATER STATION,CLEARWATER,FL.
DETAILER:- VECTORSHADES LLC
CUSTOMER:- KOKOLAKIS
ARCH./ENG.:- CDM SMITH
DESCRIPTION:- WAVE CANOPY VERTICAL BRACE DETAIL
DRAWN:- PBI DATE:- 10-27-2025 CHK.D:- RAG DATE:- 10-27-2025

SHOP BILL	WORK ORDER NO.	DRWG. NO.
	2553	1469

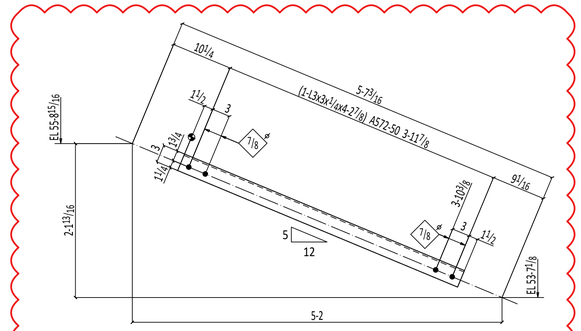

ONE VERTICAL BRACE 1470VB -G

SHOP NOTE:
TOE DIRECTION FAR SIDE

AESS CATEGORY-3

SHIPPING LIST

MATERIAL BILL

ITEM NO	TOTAL QTY	DESCRIPTION	MAJOR MARK	PAINT CODE	TOTAL WEIGHT	ABM NO	UNIT QTY	LENGTH FT.	LENGTH IN.	MINOR MARK	REMARKS	UNIT WEIGHT	GRADE
	ONE	VERTICAL BRACE	1470VB	G	21						Galv	21	
	1	L3x3x1/4			21		1	4	2 7/8	1470VB		21	A572-50
		FIELD BOLTS											
	4	3/4 Dia A325N						0	1 3/4		+1HD WASH		

Total weight : 21

REFERENCE :----

PAGE TOTALS

REVISION NO.

SPECIAL NOTES:-

MATERIAL:-

ASTM:	A36 U.N.O.
S. S.:	-----
ALUM.:	-----
PIPE:	A53 GR.B
TUBES:	A500 GR.B
HOLES:	13/16 U.N.O
WELDING:	E70XX

MATERIAL PREP.:-

CLEAN:	SSPC-SP2
SHOP PAINT:	TWO COAT OF STD SHOP PRIMER
GALV:	GALVANIZED & PAINTED

GEN. NOTES:-

BUY AMERICAN:
DOMESTIC:
CERT/CONFORMANCE:
CERT/COMPLIANCE:

ALL WIDE FLANGE SHAPES TO BE PER A992-G50

FIELD CONNECTIONS :
HOLES : 13/16" U.N.O
PAINT :

morrow steel Fabricators, Inc.

3620 COPELAND DRIVE
ZEPHYRHILLS, FL. 33542

	PRINTS FOR	DATE	MK	REVISIONS	DATE
			0	RELEASED FOR APPROVAL	Nov 18 2025
			1	RELEASED FOR RE-APPROVAL	Jul 13 2026
			2	RELEASED FOR RE-APPROVAL	Aug 26 2026

STRUCTURE:- PINELLAS SUNCOAST TRANSIT AUTHORITY
LOCATION:- CLEARWATER STATION,CLEARWATER,FL.
DETAILER:- VECTORSHADES LLC
CUSTOMER:- KOKOLAKIS
ARCH./ENG.:- CDM SMITH
DESCRIPTION:- WAVE CANOPY VERTICAL BRACE DETAIL
DRAWN:- PBI DATE:- 10-27-2025 CHK.D:- RAG DATE:- 10-27-2025

SHOP BILL	WORK ORDER NO.	DRWG. NO.
	2553	1470

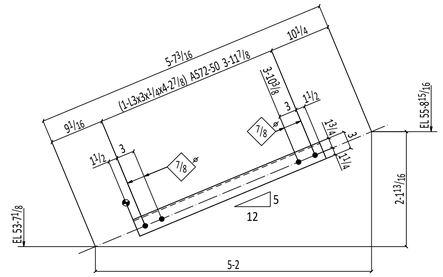

ONE VERTICAL BRACE 1471VB -G

SHOP NOTE:
TOE DIRECTION FAR SIDE

AESS CATEGORY-3

SHIPPING LIST

MATERIAL BILL

ITEM NO	TOTAL QTY	DESCRIPTION	MAJOR MARK	PAINT CODE	TOTAL WEIGHT	ABM NO	UNIT QTY	LENGTH FT.	LENGTH IN.	MINOR MARK	REMARKS	UNIT WEIGHT	GRADE
	ONE	VERTICAL BRACE	1471VB	G	21						Galv	21	
	1	L3x3x1/4			21		1	4	27/8	1471VB		21	A572-50
		FIELD BOLTS											
	4	3/4 Dia A325N						0	13/4		+1HD WASH		

Total weight : 21

REFERENCE :----

PAGE TOTALS

REVISION NO.

SPECIAL NOTES:-

MATERIAL:-
ASTM: A36 U.N.O.
S. S.: -----
ALUM.: -----
PIPE: A53 GR.B
TUBES: A500 GR.B
HOLES: 13/16 U.N.O
WELDING: E70XX

MATERIAL PREP.:-
CLEAN: SSPC-SP2
SHOP PAINT: TWO COAT OF STD SHOP PRIMER
GALV: GALVANIZED & PAINTED

GEN. NOTES:-
BUY AMERICAN:
DOMESTIC:
CERT/CONFORMANCE:
CERT/COMPLIANCE:

ALL WIDE FLANGE SHAPES TO BE PER A992-G50

FIELD CONNECTIONS :
HOLES : 13/16" U.N.O
PAINT :

morrow steel Fabricators, Inc.

3620 COPELAND DRIVE
ZEPHYRHILLS, FL. 33542

	PRINTS FOR	DATE	MK	REVISIONS	DATE
			0	RELEASED FOR APPROVAL	Nov 18 2025
			1	RELEASED FOR RE-APPROVAL	Jul 13 2026
			2	RELEASED FOR RE-APPROVAL	Aug 26 2026

STRUCTURE:-PINELLAS SUNCOAST TRANSIT AUTHORITY
LOCATION:- CLEARWATER STATION,CLEARWATER,FL.
DETAILER:- VECTORSHADES LLC
CUSTOMER:- KOKOLAKIS
ARCH./ENG.:- CDM SMITH
DESCRIPTION:- WAVE CANOPY VERTICAL BRACE DETAIL
DRAWN:- PBI DATE:- 10-27-2025 CHK.D:- RAG DATE:- 10-27-2025

SHOP BILL	WORK ORDER NO.	DRWG. NO.
	2553	1471

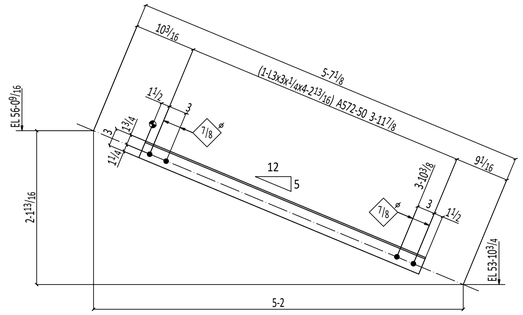

ONE VERTICAL BRACE 1472VB -G

SHOP NOTE:
TOE DIRECTION NEAR SIDE

AESS CATEGORY-3

SHIPPING LIST / MATERIAL BILL

ITEM NO	TOTAL QTY	DESCRIPTION	MAJOR MARK	PAINT CODE	TOTAL WEIGHT	ABM NO	UNIT QTY	LENGTH FT.	LENGTH IN.	MINOR MARK	REMARKS	UNIT WEIGHT	GRADE
	ONE	VERTICAL BRACE	1472VB	G	21						Galv	21	
	1	L3x3x1/4			21		1	4	2 13/16	1472VB		21	A572-50
		FIELD BOLTS											
	4	3/4 Dia A325N						0	1 3/4		+1HD WASH		

Total weight : 21

REFERENCE :----

PAGE TOTALS | REVISION NO.

SPECIAL NOTES:-

MATERIAL:-
ASTM: A36 U.N.O.
S. S.: -----
ALUM.: -----
PIPE: A53 GR.B
TUBES: A500 GR.B
HOLES: 13/16 U.N.O
WELDING: E70XX

MATERIAL PREP.:-
CLEAN: SSPC-SP2
SHOP PAINT: TWO COAT OF STD SHOP PRIMER
GALV: GALVANIZED & PAINTED

GEN. NOTES:-
BUY AMERICAN:
DOMESTIC:
CERT/CONFORMANCE:
CERT/COMPLIANCE:

ALL WIDE FLANGE SHAPES TO BE PER A992-G50

FIELD CONNECTIONS :
HOLES : 13/16" U.N.O
PAINT :

morrow steel Fabricators, Inc.

3620 COPELAND DRIVE
ZEPHYRHILLS, FL. 33542

	PRINTS FOR	DATE	MK	REVISIONS	DATE
			0	RELEASED FOR APPROVAL	Nov 18 2025
			1	RELEASED FOR RE-APPROVAL	Jul 13 2026
			2	RELEASED FOR RE-APPROVAL	Aug 26 2026

STRUCTURE:-PINELLAS SUNCOAST TRANSIT AUTHORITY
LOCATION:- CLEARWATER STATION,CLEARWATER,FL.
DETAILER:- VECTORSHADES LLC
CUSTOMER:- KOKOLAKIS
ARCH./ENG.:- CDM SMITH
DESCRIPTION:- WAVE CANOPY VERTICAL BRACE DETAIL
DRAWN:- PBI DATE:- 10-27-2025 CHK.D:- RAG DATE:- 10-27-2025

SHOP BILL	WORK ORDER NO.	DRWG. NO.
	2553	1472

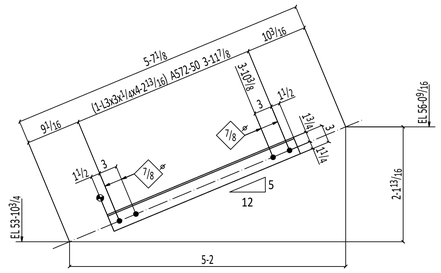

ONE VERTICAL BRACE 1473VB -G

SHOP NOTE:
TOE DIRECTION NEAR SIDE

AESS CATEGORY-3

SHIPPING LIST

MATERIAL BILL

ITEM NO	TOTAL QTY	DESCRIPTION	MAJOR MARK	PAINT CODE	TOTAL WEIGHT	ABM NO	UNIT QTY	LENGTH FT.	LENGTH IN.	MINOR MARK	REMARKS	UNIT WEIGHT	GRADE
	ONE	VERTICAL BRACE	1473VB	G	21						Galv	21	
	1	L3x3x1/4			21		1	4	2 13/16	1473VB		21	A572-50
		FIELD BOLTS											
	4	3/4 Dia A325N						0	1 3/4		+1HD WASH		

Total weight : 21

REFERENCE :----

PAGE TOTALS

REVISION NO.

SPECIAL NOTES:-

MATERIAL:-

ASTM: A36 U.N.O.
S. S.: -----
ALUM.: -----
PIPE: A53 GR.B
TUBES: A500 GR.B
HOLES: 13/16 U.N.O
WELDING: E70XX

MATERIAL PREP.:-

CLEAN: SSPC-SP2
SHOP PAINT: TWO COAT OF STD SHOP PRIMER
GALV: GALVANIZED & PAINTED

GEN. NOTES:-

BUY AMERICAN:
DOMESTIC:
CERT/CONFORMANCE:
CERT/COMPLIANCE:

ALL WIDE FLANGE SHAPES TO BE PER A992-G50

FIELD CONNECTIONS :
HOLES : 13/16" U.N.O
PAINT :

morrow steel Fabricators, Inc.

3620 COPELAND DRIVE
ZEPHYRHILLS, FL. 33542

	PRINTS FOR	DATE	MK	REVISIONS	DATE
			0	RELEASED FOR APPROVAL	Nov 18 2025
			1	RELEASED FOR RE-APPROVAL	Jul 13 2026
			2	RELEASED FOR RE-APPROVAL	Aug 26 2026

STRUCTURE:- PINELLAS SUNCOAST TRANSIT AUTHORITY
LOCATION:- CLEARWATER STATION,CLEARWATER,FL.
DETAILER:- VECTORSHADES LLC
CUSTOMER:- KOKOLAKIS
ARCH./ENG.:- CDM SMITH
DESCRIPTION:- WAVE CANOPY VERTICAL BRACE DETAIL
DRAWN:- PBI DATE:-10-27-2025 CHK.D:-RAG DATE:- 10-27-2025

SHOP BILL	WORK ORDER NO.	DRWG. NO.
	2553	1473

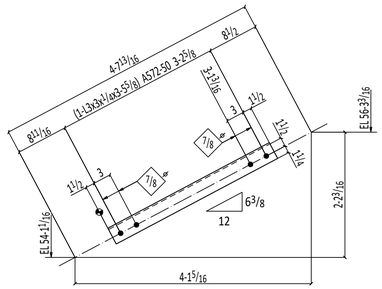

6 VERTICAL BRACES 1474VB -G

SHOP NOTE:
TOE DIRECTION FAR SIDE

SHIPPING LIST / MATERIAL BILL

ITEM NO	TOTAL QTY	DESCRIPTION	MAJOR MARK	PAINT CODE	TOTAL WEIGHT	ABM NO	UNIT QTY	LENGTH FT.	LENGTH IN.	MINOR MARK	REMARKS	UNIT WEIGHT	GRADE
	6	VERTICAL BRACE	1474VB	G	102						Galv	17	
	6	L3x3x1/4			102		1	3	5 5/8	1474VB		17	A572-50
		FIELD BOLTS											
	24	3/4 Dia A325N						0	1 3/4		+1HD WASH		

Total weight : 102

REFERENCE :----

PAGE TOTALS

REVISION NO.

SPECIAL NOTES:-

MATERIAL:-
ASTM: A36 U.N.O.
S. S.: -----
ALUM.: -----
PIPE: A53 GR.B
TUBES: A500 GR.B
HOLES: 13/16 U.N.O
WELDING: E70XX

MATERIAL PREP.:-
CLEAN: SSPC-SP2
SHOP PAINT: TWO COAT OF STD SHOP PRIMER
GALV: GALVANIZED & PAINTED

GEN. NOTES:-
BUY AMERICAN:
DOMESTIC:
CERT/CONFORMANCE:
CERT/COMPLIANCE:

ALL WIDE FLANGE SHAPES TO BE PER A992-G50

FIELD CONNECTIONS :
HOLES : 13/16" U.N.O
PAINT :

morrow steel Fabricators, Inc.

3620 COPELAND DRIVE
ZEPHYRHILLS, FL. 33542

	PRINTS FOR	DATE	MK	REVISIONS	DATE
			0	RELEASED FOR APPROVAL	Nov 18 2025
			1	RELEASED FOR RE-APPROVAL	Jul 13 2026
			2	RELEASED FOR RE-APPROVAL	Aug 26 2026

STRUCTURE:- PINELLAS SUNCOAST TRANSIT AUTHORITY
LOCATION:- CLEARWATER STATION,CLEARWATER,FL.
DETAILER:- VECTORSHADES LLC
CUSTOMER:- KOKOLAKIS
ARCH./ENG.:- CDM SMITH
DESCRIPTION:- WAVE CANOPY VERTICAL BRACE DETAIL
DRAWN:- PBI DATE:- 10-27-2025 CHK.D:- RAG DATE:- 10-27-2025

SHOP BILL	WORK ORDER NO.	DRWG. NO.
	2553	1474

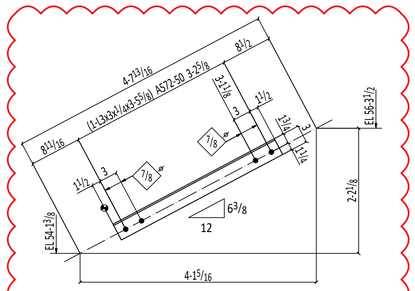

6 VERTICAL BRACES 1475VB -G

SHOP NOTE:
TOE DIRECTION NEAR SIDE

SHIPPING LIST / MATERIAL BILL

ITEM NO	TOTAL QTY	DESCRIPTION	MAJOR MARK	PAINT CODE	TOTAL WEIGHT	ABM NO	UNIT QTY	LENGTH FT.	LENGTH IN.	MINOR MARK	REMARKS	UNIT WEIGHT	GRADE
	6	VERTICAL BRACE	1475VB	G	102						Galv	17	
	6	L3x3x1/4			102		1	3	5 5/8	1475VB		17	A572-50
		FIELD BOLTS											
	24	3/4 Dia A325N						0	1 3/4		+1HD WASH		

Total weight : 102

REFERENCE :----

PAGE TOTALS

REVISION NO.

SPECIAL NOTES:-

MATERIAL:-

ASTM:	A36 U.N.O.
S. S.:	-----
ALUM.:	-----
PIPE:	A53 GR.B
TUBES:	A500 GR.B
HOLES:	13/16 U.N.O
WELDING:	E70XX

MATERIAL PREP.:-

CLEAN:	SSPC-SP2
SHOP PAINT:	TWO COAT OF STD SHOP PRIMER
GALV:	GALVANIZED & PAINTED

GEN. NOTES:-

BUY AMERICAN:
DOMESTIC:
CERT/CONFORMANCE:
CERT/COMPLIANCE:

ALL WIDE FLANGE SHAPES TO BE PER A992-G50

FIELD CONNECTIONS :
HOLES : 13/16" U.N.O
PAINT :

morrow steel Fabricators, Inc.

3620 COPELAND DRIVE
ZEPHYRHILLS, FL. 33542

	PRINTS FOR	DATE	MK	REVISIONS	DATE
			0	RELEASED FOR APPROVAL	Nov 18 2025
			1	RELEASED FOR RE-APPROVAL	Jul 13 2026
			2	RELEASED FOR RE-APPROVAL	Aug 26 2026

STRUCTURE:- PINELLAS SUNCOAST TRANSIT AUTHORITY
LOCATION:- CLEARWATER STATION,CLEARWATER,FL.
DETAILER:- VECTORSHADES LLC
CUSTOMER:- KOKOLAKIS
ARCH./ENG.:- CDM SMITH
DESCRIPTION:- WAVE CANOPY VERTICAL BRACE DETAIL
DRAWN:- PBI DATE:-10-27-2025 CHK.D.-RAG DATE:- 10-27-2025

SHOP BILL	WORK ORDER NO.	DRWG. NO.
	2553	1475

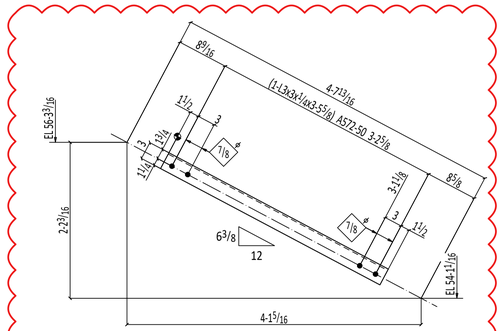

6 VERTICAL BRACES 1476VB -G

SHOP NOTE:
TOE DIRECTION FAR SIDE

SHIPPING LIST / MATERIAL BILL

ITEM NO	TOTAL QTY	DESCRIPTION	MAJOR MARK	PAINT CODE	TOTAL WEIGHT	ABM NO	UNIT QTY	LENGTH FT.	LENGTH IN.	MINOR MARK	REMARKS	UNIT WEIGHT	GRADE
	6	VERTICAL BRACE	1476VB	G	102						Galv	17	
	6	L3x3x1/4			102		1	3	5 5/8	1476VB		17	A572-50
		FIELD BOLTS											
	22	3/4 Dia A325N						0	1 3/4		+1HD WASH		

Total weight : 102

REFERENCE :----

PAGE TOTALS

REVISION NO.

SPECIAL NOTES:-

MATERIAL:-
ASTM: A36 U.N.O.
S. S.: -----
ALUM.: -----
PIPE: A53 GR.B
TUBES: A500 GR.B
HOLES: 13/16 U.N.O
WELDING: E70XX

MATERIAL PREP.:-
CLEAN: SSPC-SP2
SHOP PAINT: TWO COAT OF STD SHOP PRIMER
GALV: GALVANIZED & PAINTED

GEN. NOTES:-
BUY AMERICAN:
DOMESTIC:
CERT/CONFORMANCE:
CERT/COMPLIANCE:

ALL WIDE FLANGE SHAPES TO BE PER A992-G50

FIELD CONNECTIONS :
HOLES : 13/16" U.N.O
PAINT :

morrow steel Fabricators, Inc.

3620 COPELAND DRIVE
ZEPHYRHILLS, FL. 33542

	PRINTS FOR	DATE	MK	REVISIONS	DATE
			0	RELEASED FOR APPROVAL	Nov 18 2025
			1	RELEASED FOR RE-APPROVAL	Jul 13 2026
			2	RELEASED FOR RE-APPROVAL	Aug 26 2026

STRUCTURE:- PINELLAS SUNCOAST TRANSIT AUTHORITY
LOCATION:- CLEARWATER STATION,CLEARWATER,FL.
DETAILER:- VECTORSHADES LLC.
CUSTOMER:- KOKOLAKIS
ARCH./ENG.:- CDM SMITH
DESCRIPTION:- WAVE CANOPY VERTICAL BRACE DETAIL
DRAWN:- PBI DATE:- 10-27-2025 CHK.D:- RAG DATE:- 10-27-2025

SHOP BILL	WORK ORDER NO.	DRWG. NO.
	2553	1476

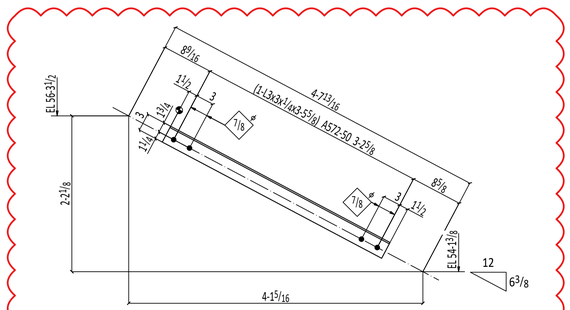

6 VERTICAL BRACES 1477VB-G

SHOP NOTE:
TOE DIRECTION NEAR SIDE

SHIPPING LIST

MATERIAL BILL

ITEM NO	TOTAL QTY	DESCRIPTION	MAJOR MARK	PAINT CODE	TOTAL WEIGHT	ABM NO	UNIT QTY	LENGTH FT.	LENGTH IN.	MINOR MARK	REMARKS	UNIT WEIGHT	GRADE
	6	VERTICAL BRACE	1477VB	G	102						Galv	17	
	6	L3x3x1/4			102		1	3	5 5/8	1477VB		17	A572-50
		FIELD BOLTS											
	24	3/4 Dia A325N						0	1 3/4		+1HD WASH		

Total weight : 102

REFERENCE :----

PAGE TOTALS

REVISION NO.

SPECIAL NOTES:-

MATERIAL:-
ASTM: A36 U.N.O.
S. S.: -----
ALUM.: -----
PIPE: A53 GR.B
TUBES: A500 GR.B
HOLES: 13/16 U.N.O
WELDING: E70XX

MATERIAL PREP.:-
CLEAN: SSPC-SP2
SHOP PAINT: TWO COAT OF STD SHOP PRIMER
GALV: GALVANIZED & PAINTED

GEN. NOTES:-
BUY AMERICAN:
DOMESTIC:
CERT/CONFORMANCE:
CERT/COMPLIANCE:

ALL WIDE FLANGE SHAPES TO BE PER A992-G50

FIELD CONNECTIONS :
HOLES : 13/16" U.N.O
PAINT :

morrow steel Fabricators, Inc.

3620 COPELAND DRIVE
ZEPHYRHILLS, FL. 33542

	PRINTS FOR	DATE	MK	REVISIONS	DATE
			0	RELEASED FOR APPROVAL	Nov 18 2025
			1	RELEASED FOR RE-APPROVAL	Jul 13 2026
			2	RELEASED FOR RE-APPROVAL	Aug 26 2026

STRUCTURE:- PINELLAS SUNCOAST TRANSIT AUTHORITY
LOCATION:- CLEARWATER STATION,CLEARWATER,FL.
DETAILER:- VECTORSHADES LLC
CUSTOMER:- KOKOLAKIS
ARCH./ENG.:- CDM SMITH
DESCRIPTION:- WAVE CANOPY VERTICAL BRACE DETAIL
DRAWN:- PBI DATE:- 10-27-2025 CHK.D:- RAG DATE:- 10-27-2025

SHOP BILL	WORK ORDER NO.	DRWG. NO.
	2553	1477

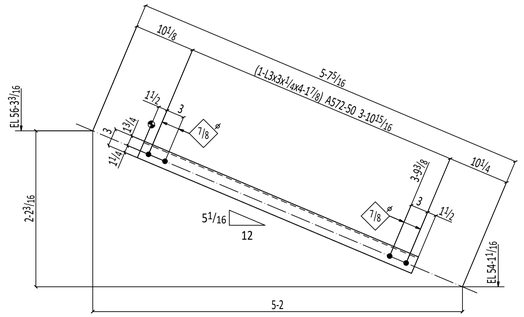

ONE VERTICAL BRACE 1478VB -G

SHOP NOTE:
TOE DIRECTION FAR SIDE

AESS CATEGORY-3

SHIPPING LIST / MATERIAL BILL

ITEM NO	TOTAL QTY	DESCRIPTION	MAJOR MARK	PAINT CODE	TOTAL WEIGHT	ABM NO	UNIT QTY	LENGTH FT.	LENGTH IN.	MINOR MARK	REMARKS	UNIT WEIGHT	GRADE
	ONE	VERTICAL BRACE	1478VB	G	20						Galv	20	
	1	L3x3x1/4			20		1	4	1 7/8	1478VB		20	A572-50
		FIELD BOLTS											
	4	3/4 Dia A325N						0	1 3/4		+1HD WASH		

Total weight : 20

REFERENCE :----

PAGE TOTALS

REVISION NO.

SPECIAL NOTES:-

MATERIAL:-
ASTM: A36 U.N.O.
S. S.: -----
ALUM.: -----
PIPE: A53 GR.B
TUBES: A500 GR.B
HOLES: 13/16 U.N.O
WELDING: E70XX

MATERIAL PREP.:-
CLEAN: SSPC-SP2
SHOP PAINT: TWO COAT OF STD SHOP PRIMER
GALV: GALVANIZED & PAINTED

GEN. NOTES:-
BUY AMERICAN:
DOMESTIC:
CERT/CONFORMANCE:
CERT/COMPLIANCE:

ALL WIDE FLANGE SHAPES TO BE PER A992-G50

FIELD CONNECTIONS :
HOLES : 13/16" U.N.O
PAINT :

morrow steel Fabricators, Inc.

3620 COPELAND DRIVE
ZEPHYRHILLS, FL. 33542

	PRINTS FOR	DATE	MK	REVISIONS	DATE
			0	RELEASED FOR APPROVAL	Nov 18 2025
			1	RELEASED FOR RE-APPROVAL	Jul 13 2026
			2	RELEASED FOR RE-APPROVAL	Aug 26 2026

STRUCTURE:-PINELLAS SUNCOAST TRANSIT AUTHORITY
LOCATION:- CLEARWATER STATION,CLEARWATER,FL.
DETAILER:- VECTORSHADES LLC
CUSTOMER:- KOKOLAKIS
ARCH./ENG.:- CDM SMITH
DESCRIPTION:- WAVE CANOPY VERTICAL BRACE DETAIL
DRAWN:- PBI DATE:-10-27-2025 CHK.D:-RAG DATE:- 10-27-2025

SHOP BILL	WORK ORDER NO.	DRWG. NO.
	2553	1478

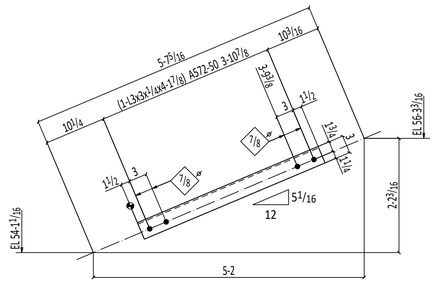

ONE VERTICAL BRACE 1479VB -G

SHOP NOTE:
TOE DIRECTION FAR SIDE

AESS CATEGORY-3

SHIPPING LIST

MATERIAL BILL

ITEM NO	TOTAL QTY	DESCRIPTION	MAJOR MARK	PAINT CODE	TOTAL WEIGHT	ABM NO	UNIT QTY	LENGTH FT.	LENGTH IN.	MINOR MARK	REMARKS	UNIT WEIGHT	GRADE
	ONE	VERTICAL BRACE	1479VB	G	20						Galv	20	
	1	L3x3x¼			20		1	4	17/8	1479VB		20	A572-50
		FIELD BOLTS											
	4	¾ Dia A325N						0	1¾		+1HD WASH		

Total weight : 20

REFERENCE :----

PAGE TOTALS

REVISION NO.

SPECIAL NOTES:-

MATERIAL:-
ASTM: A36 U.N.O.
S. S.: -----
ALUM.: -----
PIPE: A53 GR.B
TUBES: A500 GR.B
HOLES: 13/16 U.N.O
WELDING: E70XX

MATERIAL PREP.:-
CLEAN: SSPC-SP2
SHOP PAINT: TWO COAT OF STD SHOP PRIMER
GALV: GALVANIZED & PAINTED

GEN. NOTES:-
BUY AMERICAN:
DOMESTIC:
CERT/CONFORMANCE:
CERT/COMPLIANCE:

ALL WIDE FLANGE SHAPES TO BE PER A992-G50

FIELD CONNECTIONS :
HOLES : 13/16" U.N.O
PAINT :

morrow steel Fabricators, Inc.

3620 COPELAND DRIVE
ZEPHYRHILLS, FL. 33542

	PRINTS FOR	DATE	MK	REVISIONS	DATE
			0	RELEASED FOR APPROVAL	Nov 18 2025
			1	RELEASED FOR RE-APPROVAL	Jul 13 2026
			2	RELEASED FOR RE-APPROVAL	Aug 26 2026

STRUCTURE:- PINELLAS SUNCOAST TRANSIT AUTHORITY
LOCATION:- CLEARWATER STATION,CLEARWATER,FL.
DETAILER:- VECTORSHADES LLC
CUSTOMER:- KOKOLAKIS
ARCH./ENG.:- CDM SMITH
DESCRIPTION:- WAVE CANOPY VERTICAL BRACE DETAIL
DRAWN:- PBI DATE:-10-27-2025 CHK.D.-RAG DATE:- 10-27-2025

SHOP BILL	WORK ORDER NO.	DRWG. NO.
	2553	1479

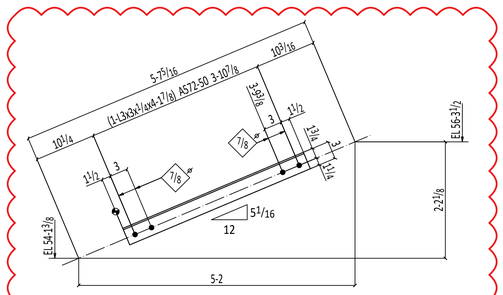

ONE VERTICAL BRACE 1480VB -G

SHOP NOTE:
TOE DIRECTION NEAR SIDE

AESS CATEGORY-3

SHIPPING LIST / MATERIAL BILL

ITEM NO	TOTAL QTY	DESCRIPTION	MAJOR MARK	PAINT CODE	TOTAL WEIGHT	ABM NO	UNIT QTY	LENGTH FT.	LENGTH IN.	MINOR MARK	REMARKS	UNIT WEIGHT	GRADE
	ONE	VERTICAL BRACE	1480VB	G	20						Galv	20	
	1	L3x3x1/4			20		1	4	17/8	1480VB		20	A572-50
		FIELD BOLTS											
	4	3/4 Dia A325N						0	13/4		+1HD WASH		

Total weight : 20

REFERENCE :----

PAGE TOTALS

REVISION NO.

SPECIAL NOTES:-

MATERIAL:-
ASTM: A36 U.N.O.
S. S.: -----
ALUM.: -----
PIPE: A53 GR.B
TUBES: A500 GR.B
HOLES: 13/16 U.N.O
WELDING: E70XX

MATERIAL PREP.:-
CLEAN: SSPC-SP2
SHOP PAINT: TWO COAT OF STD SHOP PRIMER
GALV: GALVANIZED & PAINTED

GEN. NOTES:-
BUY AMERICAN:
DOMESTIC:
CERT/CONFORMANCE:
CERT/COMPLIANCE:

ALL WIDE FLANGE SHAPES TO BE PER A992-G50

FIELD CONNECTIONS :
HOLES : 13/16" U.N.O
PAINT :

morrow steel Fabricators, Inc.

3620 COPELAND DRIVE
ZEPHYRHILLS, FL. 33542

	PRINTS FOR	DATE	MK	REVISIONS	DATE
			0	RELEASED FOR APPROVAL	Nov 18 2025
			1	RELEASED FOR RE-APPROVAL	Jul 13 2026
			2	RELEASED FOR RE-APPROVAL	Aug 26 2026

STRUCTURE:- PINELLAS SUNCOAST TRANSIT AUTHORITY
LOCATION:- CLEARWATER STATION,CLEARWATER,FL.
DETAILER:- VECTORSHADES LLC
CUSTOMER:- KOKOLAKIS
ARCH./ENG.:- CDM SMITH
DESCRIPTION:- WAVE CANOPY VERTICAL BRACE DETAIL
DRAWN:- PBI DATE:- 10-27-2025 CHK.D:- RAG DATE:- 10-27-2025

SHOP BILL	WORK ORDER NO.	DRWG. NO.
	2553	1480

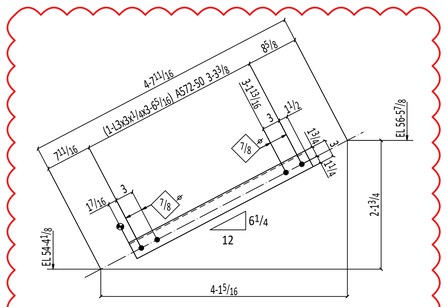

6 VERTICAL BRACES 1481VB -G

SHOP NOTE:
TOE DIRECTION FAR SIDE

SHIPPING LIST

MATERIAL BILL

ITEM NO	TOTAL QTY	DESCRIPTION	MAJOR MARK	PAINT CODE	TOTAL WEIGHT	ABM NO	UNIT QTY	LENGTH FT.	LENGTH IN.	MINOR MARK	REMARKS	UNIT WEIGHT	GRADE
	6	VERTICAL BRACE	1481VB	G	104						Galv	17	
	6	L3x3x1/4			104		1	3	6 5/16	1481VB		17	A572-50
		FIELD BOLTS											
	24	3/4 Dia A325N						0	1 3/4		+1HD WASH		

Total weight : 104

REFERENCE :----

PAGE TOTALS

REVISION NO.

SPECIAL NOTES:-

MATERIAL:-

ASTM: A36 U.N.O.
S. S.: -----
ALUM.: -----
PIPE: A53 GR.B
TUBES: A500 GR.B
HOLES: 13/16 U.N.O
WELDING: E70XX

MATERIAL PREP.:-

CLEAN: SSPC-SP2
SHOP PAINT: TWO COAT OF STD SHOP PRIMER
GALV: GALVANIZED & PAINTED

GEN. NOTES:-

BUY AMERICAN:
DOMESTIC:
CERT/CONFORMANCE:
CERT/COMPLIANCE:

ALL WIDE FLANGE SHAPES TO BE PER A992-G50

FIELD CONNECTIONS :
HOLES : 13/16" U.N.O
PAINT :

morrow steel Fabricators, Inc.

3620 COPELAND DRIVE
ZEPHYRHILLS, FL. 33542

	PRINTS FOR	DATE	MK	REVISIONS	DATE
			0	RELEASED FOR APPROVAL	Nov 18 2025
			1	RELEASED FOR RE-APPROVAL	Jul 13 2026
			2	RELEASED FOR RE-APPROVAL	Aug 26 2026

STRUCTURE:-PINELLAS SUNCOAST TRANSIT AUTHORITY
LOCATION:- CLEARWATER STATION,CLEARWATER,FL.
DETAILER:- VECTORSHADES LLC
CUSTOMER:- KOKOLAKIS
ARCH./ENG.:- CDM SMITH
DESCRIPTION:-WAVE CANOPY VERTICAL BRACE DETAIL
DRAWN:- PBI DATE:-10-27-2025 CHK.D:-RAG DATE:- 10-27-2025

SHOP BILL	WORK ORDER NO.	DRWG. NO.
	2553	1481

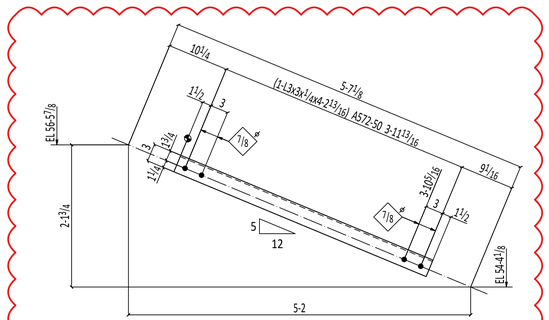

ONE VERTICAL BRACE 1482VB -G

SHOP NOTE:
TOE DIRECTION FAR SIDE

AESS CATEGORY-3

SHIPPING LIST / MATERIAL BILL

ITEM NO	TOTAL QTY	DESCRIPTION	MAJOR MARK	PAINT CODE	TOTAL WEIGHT	ABM NO	UNIT QTY	LENGTH FT.	LENGTH IN.	MINOR MARK	REMARKS	UNIT WEIGHT	GRADE
	ONE	VERTICAL BRACE	1482VB	G	21						Galv	21	
	1	L3x3x1/4			21		1	4	2 13/16	1482VB		21	A572-50
		FIELD BOLTS											
	4	3/4 Dia A325N						0	1 3/4		+1HD WASH		

Total weight : 21

REFERENCE :----

PAGE TOTALS

REVISION NO.

SPECIAL NOTES:-

MATERIAL:-
ASTM: A36 U.N.O.
S. S.: -----
ALUM.: -----
PIPE: A53 GR.B
TUBES: A500 GR.B
HOLES: 13/16 U.N.O
WELDING: E70XX

MATERIAL PREP.:-
CLEAN: SSPC-SP2
SHOP PAINT: TWO COAT OF STD SHOP PRIMER
GALV: GALVANIZED & PAINTED

GEN. NOTES:-
BUY AMERICAN:
DOMESTIC:
CERT/CONFORMANCE:
CERT/COMPLIANCE:

ALL WIDE FLANGE SHAPES TO BE PER A992-G50

FIELD CONNECTIONS :
HOLES : 13/16" U.N.O
PAINT :

morrow steel Fabricators, Inc.

3620 COPELAND DRIVE
ZEPHYRHILLS, FL. 33542

	PRINTS FOR	DATE	MK	REVISIONS	DATE
			0	RELEASED FOR APPROVAL	Nov 18 2025
			1	RELEASED FOR RE-APPROVAL	Jul 13 2026
			2	RELEASED FOR RE-APPROVAL	Aug 26 2026

STRUCTURE:- PINELLAS SUNCOAST TRANSIT AUTHORITY
LOCATION:- CLEARWATER STATION,CLEARWATER,FL.
DETAILER:- VECTORSHADES LLC
CUSTOMER:- KOKOLAKIS
ARCH./ENG.:- CDM SMITH
DESCRIPTION:- WAVE CANOPY VERTICAL BRACE DETAIL
DRAWN:- PBI DATE:- 10-27-2025 CHK.D:- RAG DATE:- 10-27-2025

SHOP BILL	WORK ORDER NO.	DRWG. NO.
	2553	1482 1

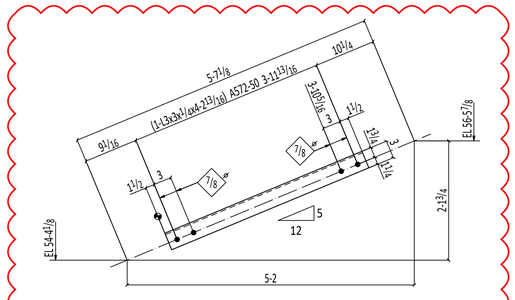

2 VERTICAL BRACES 1483VB -G

SHOP NOTE:
TOE DIRECTION FAR SIDE

AESS CATEGORY-3

SHIPPING LIST

MATERIAL BILL

ITEM NO	TOTAL QTY	DESCRIPTION	MAJOR MARK	PAINT CODE	TOTAL WEIGHT	ABM NO	UNIT QTY	LENGTH FT.	LENGTH IN.	MINOR MARK	REMARKS	UNIT WEIGHT	GRADE
	2	VERTICAL BRACE	1483VB	G	41						Galv	21	
	2	L3x3x1/4			41		1	4	2 13/16	1483VB		21	A572-50
		FIELD BOLTS											
	8	3/4 Dia A325N						0	1 3/4		+1HD WASH		

Total weight : 41

REFERENCE :----

PAGE TOTALS

REVISION NO.

SPECIAL NOTES:-

MATERIAL:-
ASTM: A36 U.N.O.
S. S.: -----
ALUM.: -----
PIPE: A53 GR.B
TUBES: A500 GR.B
HOLES: 13/16 U.N.O
WELDING: E70XX

MATERIAL PREP.:-
CLEAN: SSPC-SP2
SHOP PAINT: TWO COAT OF STD SHOP PRIMER
GALV: GALVANIZED & PAINTED

GEN. NOTES:-
BUY AMERICAN:
DOMESTIC:
CERT/CONFORMANCE:
CERT/COMPLIANCE:

ALL WIDE FLANGE SHAPES TO BE PER A992-G50

FIELD CONNECTIONS :
HOLES : 13/16" U.N.O
PAINT :

morrow steel Fabricators, Inc.

3620 COPELAND DRIVE
ZEPHYRHILLS, FL. 33542

	PRINTS FOR	DATE	MK	REVISIONS	DATE
			0	RELEASED FOR APPROVAL	Nov 18 2025
			1	RELEASED FOR RE-APPROVAL	Jul 13 2026
			2	RELEASED FOR RE-APPROVAL	Aug 26 2026

STRUCTURE:-PINELLAS SUNCOAST TRANSIT AUTHORITY
LOCATION:- CLEARWATER STATION,CLEARWATER,FL.
DETAILER:- VECTORSHADES LLC
CUSTOMER:- KOKOLAKIS
ARCH./ENG.:- CDM SMITH
DESCRIPTION:-WAVE CANOPY VERTICAL BRACE DETAIL
DRAWN:- PBI DATE:-10-27-2025 CHK.D:-RAG DATE:- 10-27-2025

SHOP BILL	WORK ORDER NO.	DRWG. NO.
	2553	1483

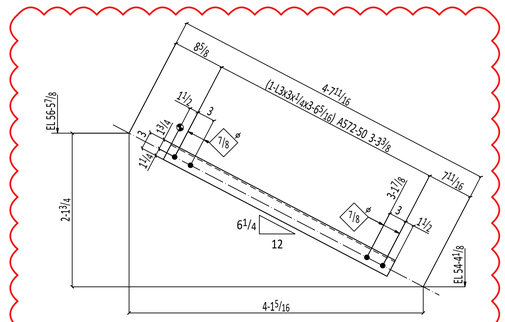

3 VERTICAL BRACES 1484VB -G

SHOP NOTE:
TOE DIRECTION FAR SIDE

SHIPPING LIST

MATERIAL BILL

ITEM NO	TOTAL QTY	DESCRIPTION	MAJOR MARK	PAINT CODE	TOTAL WEIGHT	ABM NO	UNIT QTY	LENGTH FT.	LENGTH IN.	MINOR MARK	REMARKS	UNIT WEIGHT	GRADE
	3	VERTICAL BRACE	1484VB	G	52						Galv	17	
	3	L3x3x1/4			52		1	3	6 5/16	1484VB		17	A572-50
		FIELD BOLTS											
	12	3/4 Dia A325N						0	1 3/4		+1HD WASH		

Total weight : 52

REFERENCE :----

PAGE TOTALS

REVISION NO.

SPECIAL NOTES:-

MATERIAL:-

ASTM: A36 U.N.O.
S. S.: -----
ALUM.: -----
PIPE: A53 GR.B
TUBES: A500 GR.B
HOLES: 13/16 U.N.O
WELDING: E70XX

MATERIAL PREP.:-

CLEAN: SSPC-SP2
SHOP PAINT: TWO COAT OF STD SHOP PRIMER
GALV: GALVANIZED & PAINTED

GEN. NOTES:-

BUY AMERICAN:
DOMESTIC:
CERT/CONFORMANCE:
CERT/COMPLIANCE:

ALL WIDE FLANGE SHAPES TO BE PER A992-G50

FIELD CONNECTIONS :
HOLES : 13/16" U.N.O
PAINT :

morrow steel Fabricators, Inc.

3620 COPELAND DRIVE
ZEPHYRHILLS, FL. 33542

	PRINTS FOR	DATE	MK	REVISIONS	DATE
			0	RELEASED FOR APPROVAL	Nov 18 2025
			1	RELEASED FOR RE-APPROVAL	Jul 13 2026
			2	RELEASED FOR RE-APPROVAL	Aug 26 2026

STRUCTURE:-PINELLAS SUNCOAST TRANSIT AUTHORITY
LOCATION:- CLEARWATER STATION,CLEARWATER,FL.
DETAILER:- VECTORSHADES LLC
CUSTOMER:- KOKOLAKIS
ARCH./ENG.:- CDM SMITH
DESCRIPTION:-WAVE CANOPY VERTICAL BRACE DETAIL
DRAWN:- PBI DATE:- 10-27-2025 CHK.D:-RAG DATE:- 10-27-2025

SHOP BILL	WORK ORDER NO.	DRWG. NO.
	2553	1484

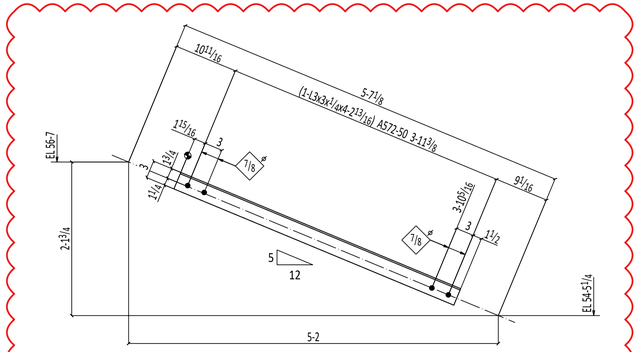

ONE VERTICAL BRACE 1485VB-G

SHOP NOTE:
TOE DIRECTION NEAR SIDE

AESS CATEGORY-3

SHIPPING LIST / MATERIAL BILL

ITEM NO	TOTAL QTY	DESCRIPTION	MAJOR MARK	PAINT CODE	TOTAL WEIGHT	ABM NO	UNIT QTY	LENGTH FT.	LENGTH IN.	MINOR MARK	REMARKS	UNIT WEIGHT	GRADE
	ONE	VERTICAL BRACE	1485VB	G	21						Galv	21	
	1	L3x3x1/4			21		1	4	2 13/16	1485VB		21	A572-50
		FIELD BOLTS											
	4	3/4 Dia A325N						0	1 3/4		+1HD WASH		

Total weight : 21

REFERENCE :----

PAGE TOTALS

REVISION NO.

SPECIAL NOTES:-

MATERIAL:-
ASTM: A36 U.N.O.
S. S.: -----
ALUM.: -----
PIPE: A53 GR.B
TUBES: A500 GR.B
HOLES: 13/16 U.N.O
WELDING: E70XX

MATERIAL PREP.:-
CLEAN: SSPC-SP2
SHOP PAINT: TWO COAT OF STD SHOP PRIMER
GALV: GALVANIZED & PAINTED

GEN. NOTES:-
BUY AMERICAN:
DOMESTIC:
CERT/CONFORMANCE:
CERT/COMPLIANCE:

ALL WIDE FLANGE SHAPES TO BE PER A992-G50

FIELD CONNECTIONS :
HOLES : 13/16" U.N.O
PAINT :

morrow steel Fabricators, Inc.

3620 COPELAND DRIVE
ZEPHYRHILLS, FL. 33542

	PRINTS FOR	DATE	MK	REVISIONS	DATE
			0	RELEASED FOR APPROVAL	Nov 18 2025
			1	RELEASED FOR RE-APPROVAL	Jul 13 2026
			2	RELEASED FOR RE-APPROVAL	Aug 26 2026

STRUCTURE:-PINELLAS SUNCOAST TRANSIT AUTHORITY
LOCATION:- CLEARWATER STATION,CLEARWATER,FL.
DETAILER:- VECTORSHADES LLC
CUSTOMER:- KOKOLAKIS
ARCH./ENG.:- CDM SMITH
DESCRIPTION:- WAVE CANOPY VERTICAL BRACE DETAIL
DRAWN:- PBI DATE:- 10-27-2025 CHK.D:- RAG DATE:- 10-27-2025

SHOP BILL	WORK ORDER NO.	DRWG. NO.
	2553	1485

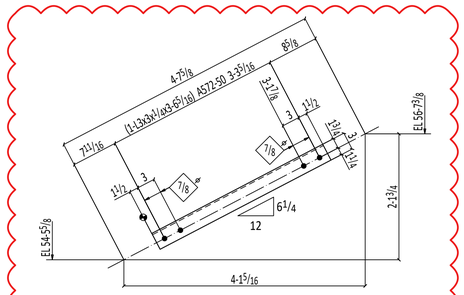

12 VERTICAL BRACES 1486VB -G

SHOP NOTE:
TOE DIRECTION FAR SIDE

SHIPPING LIST

MATERIAL BILL

ITEM NO	TOTAL QTY	DESCRIPTION	MAJOR MARK	PAINT CODE	TOTAL WEIGHT	ABM NO	UNIT QTY	LENGTH FT.	LENGTH IN.	MINOR MARK	REMARKS	UNIT WEIGHT	GRADE
	12	VERTICAL BRACE	1486VB	G	207						Galv	17	
	12	L3x3x¼			207		1	3	6⁵/₁₆	1486VB		17	A572-50
		FIELD BOLTS											
	48	¾ Dia A325N						0	1¾		+1HD WASH		

Total weight : 207

REFERENCE :----

PAGE TOTALS

REVISION NO.

SPECIAL NOTES:-

MATERIAL:-
ASTM: A36 U.N.O.
S. S.: -----
ALUM.: -----
PIPE: A53 GR.B
TUBES: A500 GR.B
HOLES: 13/16 U.N.O
WELDING: E70XX

MATERIAL PREP.:-
CLEAN: SSPC-SP2
SHOP PAINT: TWO COAT OF STD SHOP PRIMER
GALV: GALVANIZED & PAINTED

GEN. NOTES:-
BUY AMERICAN:
DOMESTIC:
CERT/CONFORMANCE:
CERT/COMPLIANCE:

ALL WIDE FLANGE SHAPES TO BE PER A992-G50

FIELD CONNECTIONS :
HOLES : 13/16" U.N.O
PAINT :

morrow steel Fabricators, Inc.

3620 COPELAND DRIVE
ZEPHYRHILLS, FL. 33542

	PRINTS FOR	DATE	MK	REVISIONS	DATE
			0	RELEASED FOR APPROVAL	Nov 18 2025
			1	RELEASED FOR RE-APPROVAL	Jul 13 2026
			2	RELEASED FOR RE-APPROVAL	Aug 26 2026

STRUCTURE:-PINELLAS SUNCOAST TRANSIT AUTHORITY
LOCATION:- CLEARWATER STATION,CLEARWATER,FL.
DETAILER:- VECTORSHADES LLC
CUSTOMER:- KOKOLAKIS
ARCH./ENG.:- CDM SMITH
DESCRIPTION:-WAVE CANOPY VERTICAL BRACE DETAIL
DRAWN:- PBI DATE:-10-27-2025 CHK.D:-RAG DATE:- 10-27-2025

SHOP BILL	WORK ORDER NO.	DRWG. NO.
	2553	1486 ⚠

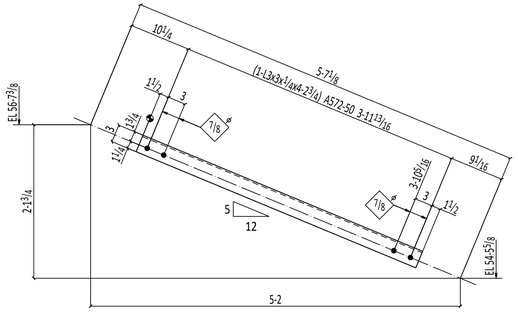

ONE VERTICAL BRACE 1487VB -G

SHOP NOTE:
TOE DIRECTION FAR SIDE

AESS CATEGORY-3

SHIPPING LIST

MATERIAL BILL

ITEM NO	TOTAL QTY	DESCRIPTION	MAJOR MARK	PAINT CODE	TOTAL WEIGHT	ABM NO	UNIT QTY	LENGTH FT.	LENGTH IN.	MINOR MARK	REMARKS	UNIT WEIGHT	GRADE
	ONE	VERTICAL BRACE	1487VB	G	21						Galv	21	
	1	L3x3x1/4			21		1	4	2 3/4	1487VB		21	A572-50
		FIELD BOLTS											
	4	3/4 Dia A325N						0	1 3/4		+1HD WASH		

Total weight : 21

REFERENCE :----

PAGE TOTALS

REVISION NO.

SPECIAL NOTES:-

MATERIAL:-

ASTM: A36 U.N.O.
S. S.: -----
ALUM.: -----
PIPE: A53 GR.B
TUBES: A500 GR.B
HOLES: 13/16 U.N.O
WELDING: E70XX

MATERIAL PREP.:-

CLEAN: SSPC-SP2
SHOP PAINT: TWO COAT OF STD SHOP PRIMER
GALV: GALVANIZED & PAINTED

GEN. NOTES:-

BUY AMERICAN:
DOMESTIC:
CERT/CONFORMANCE:
CERT/COMPLIANCE:

ALL WIDE FLANGE SHAPES TO BE PER A992-G50

FIELD CONNECTIONS :
HOLES : 13/16" U.N.O
PAINT :

morrow steel Fabricators, Inc.

3620 COPELAND DRIVE
ZEPHYRHILLS, FL. 33542

	PRINTS FOR	DATE	MK	REVISIONS	DATE
			0	RELEASED FOR APPROVAL	Nov 18 2025
			1	RELEASED FOR RE-APPROVAL	Jul 13 2026
			2	RELEASED FOR RE-APPROVAL	Aug 26 2026

STRUCTURE:- PINELLAS SUNCOAST TRANSIT AUTHORITY
LOCATION:- CLEARWATER STATION,CLEARWATER,FL.
DETAILER:- VECTORSHADES LLC
CUSTOMER:- KOKOLAKIS
ARCH./ENG.:- CDM SMITH
DESCRIPTION:- WAVE CANOPY VERTICAL BRACE DETAIL
DRAWN:- PBI DATE:- 10-27-2025 CHK.D:- RAG DATE:- 10-27-2025

SHOP BILL	WORK ORDER NO.	DRWG. NO.
	2553	1487

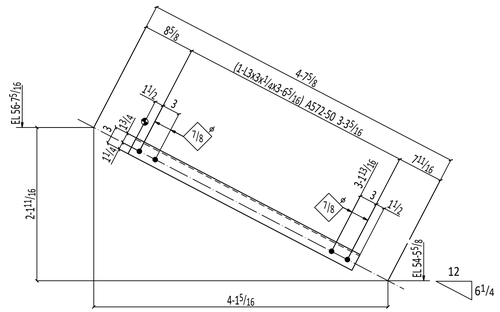

6 VERTICAL BRACES 1488VB -G

SHOP NOTE:
TOE DIRECTION FAR SIDE

SHIPPING LIST

MATERIAL BILL

ITEM NO	TOTAL QTY	DESCRIPTION	MAJOR MARK	PAINT CODE	TOTAL WEIGHT	ABM NO	UNIT QTY	LENGTH FT.	LENGTH IN.	MINOR MARK	REMARKS	UNIT WEIGHT	GRADE
	6	VERTICAL BRACE	1488VB	G	104						Galv	17	
	6	L3x3x1/4			104		1	3	6 5/16	1488VB		17	A572-50
		FIELD BOLTS											
	24	3/4 Dia A325N						0	1 3/4		+1HD WASH		

Total weight : 104

REFERENCE :----

PAGE TOTALS

REVISION NO.

SPECIAL NOTES:-

MATERIAL:-

ASTM: A36 U.N.O.
S. S.: -----
ALUM.: -----
PIPE: A53 GR.B
TUBES: A500 GR.B
HOLES: 13/16 U.N.O
WELDING: E70XX

MATERIAL PREP.:-

CLEAN: SSPC-SP2
SHOP PAINT: TWO COAT OF STD SHOP PRIMER
GALV: GALVANIZED & PAINTED

GEN. NOTES:-

BUY AMERICAN:
DOMESTIC:
CERT/CONFORMANCE:
CERT/COMPLIANCE:

ALL WIDE FLANGE SHAPES TO BE PER A992-G50

FIELD CONNECTIONS :
HOLES : 13/16" U.N.O
PAINT :

morrow steel Fabricators, Inc.

3620 COPELAND DRIVE
ZEPHYRHILLS, FL. 33542

	PRINTS FOR	DATE	MK	REVISIONS	DATE
			0	RELEASED FOR APPROVAL	Nov 18 2025
			1	RELEASED FOR RE-APPROVAL	Jul 13 2026
			2	RELEASED FOR RE-APPROVAL	Aug 26 2026

STRUCTURE:-PINELLAS SUNCOAST TRANSIT AUTHORITY
LOCATION:- CLEARWATER STATION,CLEARWATER,FL.
DETAILER:- VECTORSHADES LLC
CUSTOMER:- KOKOLAKIS
ARCH./ENG.:- CDM SMITH
DESCRIPTION:-WAVE CANOPY VERTICAL BRACE DETAIL
DRAWN:- PBI DATE:-10-27-2025 CHK.D:-RAG DATE:- 10-27-2025

SHOP BILL	WORK ORDER NO.	DRWG. NO.
	2553	1488

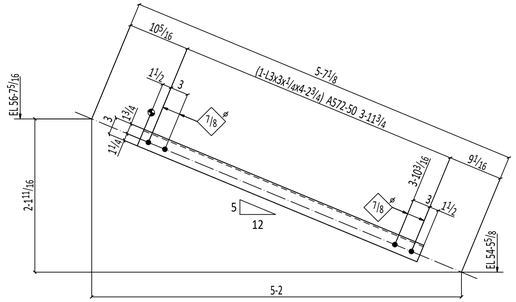

ONE VERTICAL BRACE 1489VB -G

SHOP NOTE:
TOE DIRECTION FAR SIDE

AESS CATEGORY-3

SHIPPING LIST / MATERIAL BILL

ITEM NO	TOTAL QTY	DESCRIPTION	MAJOR MARK	PAINT CODE	TOTAL WEIGHT	ABM NO	UNIT QTY	LENGTH FT.	LENGTH IN.	MINOR MARK	REMARKS	UNIT WEIGHT	GRADE
	ONE	VERTICAL BRACE	1489VB	G	21						Galv	21	
	1	L3x3x¼			21		1	4	2³/₄	1489VB		21	A572-50
		FIELD BOLTS											
	4	¾ Dia A325N						0	1³/₄		+1HD WASH		
Total weight :					21								

REFERENCE :----

PAGE TOTALS

REVISION NO.

SPECIAL NOTES:-

MATERIAL:-
ASTM: A36 U.N.O.
S. S.: -----
ALUM.: -----
PIPE: A53 GR.B
TUBES: A500 GR.B
HOLES: 13/16 U.N.O
WELDING: E70XX

MATERIAL PREP.:-
CLEAN: SSPC-SP2
SHOP PAINT: TWO COAT OF STD SHOP PRIMER
GALV: GALVANIZED & PAINTED

GEN. NOTES:-
BUY AMERICAN:
DOMESTIC:
CERT/CONFORMANCE:
CERT/COMPLIANCE:

ALL WIDE FLANGE SHAPES TO BE PER A992-G50

FIELD CONNECTIONS :
HOLES : 13/16" U.N.O
PAINT :

morrow steel Fabricators, Inc.

3620 COPELAND DRIVE
ZEPHYRHILLS, FL. 33542

	PRINTS FOR	DATE	MK	REVISIONS	DATE
			0	RELEASED FOR APPROVAL	Nov 18 2025
			1	RELEASED FOR RE-APPROVAL	Jul 13 2026
			2	RELEASED FOR RE-APPROVAL	Aug 26 2026

STRUCTURE:-PINELLAS SUNCOAST TRANSIT AUTHORITY
LOCATION:- CLEARWATER STATION,CLEARWATER,FL.
DETAILER:- VECTORSHADES LLC
CUSTOMER:- KOKOLAKIS
ARCH./ENG.:- CDM SMITH
DESCRIPTION:- WAVE CANOPY VERTICAL BRACE DETAIL
DRAWN:- PBI DATE:- 10-27-2025 CHK.D:- RAG DATE:- 10-27-2025

SHOP BILL	WORK ORDER NO.	DRWG. NO.
	2553	1489 ⚠1

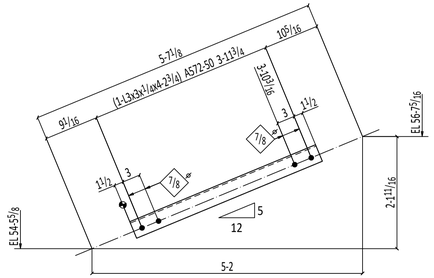

ONE VERTICAL BRACE 1490VB -G

SHOP NOTE:
TOE DIRECTION FAR SIDE

AESS CATEGORY-3

SHIPPING LIST

MATERIAL BILL

ITEM NO	TOTAL QTY	DESCRIPTION	MAJOR MARK	PAINT CODE	TOTAL WEIGHT	ABM NO	UNIT QTY	LENGTH FT.	LENGTH IN.	MINOR MARK	REMARKS	UNIT WEIGHT	GRADE
	ONE	VERTICAL BRACE	1490VB	G	21						Galv	21	
	1	L3x3x1/4			21		1	4	2 3/4	1490VB		21	A572-50
		FIELD BOLTS											
	4	3/4 Dia A325N						0	1 3/4		+1HD WASH		

Total weight : 21

REFERENCE :----

PAGE TOTALS

REVISION NO.

SPECIAL NOTES:-

MATERIAL:-

ASTM: A36 U.N.O.
S. S.: -----
ALUM.: -----
PIPE: A53 GR.B
TUBES: A500 GR.B
HOLES: 13/16 U.N.O
WELDING: E70XX

MATERIAL PREP.:-

CLEAN: SSPC-SP2
SHOP PAINT: TWO COAT OF STD SHOP PRIMER
GALV: GALVANIZED & PAINTED

GEN. NOTES:-

BUY AMERICAN:
DOMESTIC:
CERT/CONFORMANCE:
CERT/COMPLIANCE:

ALL WIDE FLANGE SHAPES TO BE PER A992-G50

FIELD CONNECTIONS :
HOLES : 13/16" U.N.O
PAINT :

morrow steel Fabricators, Inc.

3620 COPELAND DRIVE
ZEPHYRHILLS, FL. 33542

	PRINTS FOR	DATE	MK	REVISIONS	DATE
			0	RELEASED FOR APPROVAL	Nov 18 2025
			1	RELEASED FOR RE-APPROVAL	Jul 13 2026
			2	RELEASED FOR RE-APPROVAL	Aug 26 2026

STRUCTURE:-PINELLAS SUNCOAST TRANSIT AUTHORITY
LOCATION:- CLEARWATER STATION,CLEARWATER,FL.
DETAILER:- VECTORSHADES LLC
CUSTOMER:- KOKOLAKIS
ARCH./ENG.:- CDM SMITH
DESCRIPTION:- WAVE CANOPY VERTICAL BRACE DETAIL
DRAWN:- PBI DATE:-10-27-2025 CHK.D:-RAG DATE:- 10-27-2025

SHOP BILL	WORK ORDER NO.	DRWG. NO.
	2553	1490

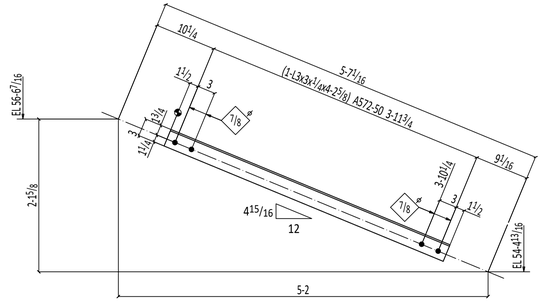

3 VERTICAL BRACES 1491VB -G

SHOP NOTE:
TOE DIRECTION NEAR SIDE

AESS CATEGORY-3

SHIPPING LIST

MATERIAL BILL

ITEM NO	TOTAL QTY	DESCRIPTION	MAJOR MARK	PAINT CODE	TOTAL WEIGHT	ABM NO	UNIT QTY	LENGTH FT.	LENGTH IN.	MINOR MARK	REMARKS	UNIT WEIGHT	GRADE
	3	VERTICAL BRACE	1491VB	G	62						Galv	21	
	3	L3x3x1/4			62		1	4	2 5/8	1491VB		21	A572-50
		FIELD BOLTS											
	12	3/4 Dia A325N						0	1 3/4		+1HD WASH		

Total weight : 62

REFERENCE :----

PAGE TOTALS

REVISION NO.

SPECIAL NOTES:-

MATERIAL:-

ASTM:	A36 U.N.O.
S. S.:	-----
ALUM.:	-----
PIPE:	A53 GR.B
TUBES:	A500 GR.B
HOLES:	13/16 U.N.O
WELDING:	E70XX

MATERIAL PREP.:-

CLEAN:	SSPC-SP2
SHOP PAINT:	TWO COAT OF STD SHOP PRIMER
GALV:	GALVANIZED & PAINTED

GEN. NOTES:-

BUY AMERICAN:
DOMESTIC:
CERT/CONFORMANCE:
CERT/COMPLIANCE:

ALL WIDE FLANGE SHAPES TO BE PER A992-G50

FIELD CONNECTIONS :
HOLES : 13/16" U.N.O
PAINT :

morrow steel Fabricators, Inc.

3620 COPELAND DRIVE
ZEPHYRHILLS, FL. 33542

	PRINTS FOR	DATE	MK	REVISIONS	DATE
			0	RELEASED FOR APPROVAL	Nov 18 2025
			1	RELEASED FOR RE-APPROVAL	Jul 13 2026
			2	RELEASED FOR RE-APPROVAL	Aug 26 2026

STRUCTURE:- PINELLAS SUNCOAST TRANSIT AUTHORITY
LOCATION:- CLEARWATER STATION,CLEARWATER,FL.
DETAILER:- VECTORSHADES LLC
CUSTOMER:- KOKOLAKIS
ARCH./ENG.:- CDM SMITH
DESCRIPTION:- WAVE CANOPY VERTICAL BRACE DETAIL
DRAWN:- PBI DATE:-10-27-2025 CHK.D.-RAG DATE:- 10-27-2025

SHOP BILL	WORK ORDER NO.	DRWG. NO.
	2553	1491

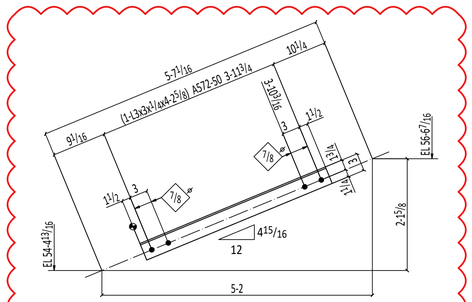

3 VERTICAL BRACES 1492VB -G

SHOP NOTE:
TOE DIRECTION NEAR SIDE

AESS CATEGORY-3

SHIPPING LIST

MATERIAL BILL

ITEM NO	TOTAL QTY	DESCRIPTION	MAJOR MARK	PAINT CODE	TOTAL WEIGHT	ABM NO	UNIT QTY	LENGTH FT.	LENGTH IN.	MINOR MARK	REMARKS	UNIT WEIGHT	GRADE
	3	VERTICAL BRACE	1492VB	G	62						Galv	21	
	3	L3x3x1/4			62		1	4	2 5/8	1492VB		21	A572-50
		FIELD BOLTS											
	12	3/4 Dia A325N						0	1 3/4		+1HD WASH		

Total weight : 62

REFERENCE :----

PAGE TOTALS

REVISION NO.

SPECIAL NOTES:-

MATERIAL:-

ASTM: A36 U.N.O.
S. S.: -----
ALUM.: -----
PIPE: A53 GR.B
TUBES: A500 GR.B
HOLES: 13/16 U.N.O
WELDING: E70XX

MATERIAL PREP.:-

CLEAN: SSPC-SP2
SHOP PAINT: TWO COAT OF STD SHOP PRIMER
GALV: GALVANIZED & PAINTED

GEN. NOTES:-

BUY AMERICAN:
DOMESTIC:
CERT/CONFORMANCE:
CERT/COMPLIANCE:

ALL WIDE FLANGE SHAPES TO BE PER A992-G50

FIELD CONNECTIONS :
HOLES : 13/16" U.N.O
PAINT :

morrow steel Fabricators, Inc.

3620 COPELAND DRIVE
ZEPHYRHILLS, FL. 33542

	PRINTS FOR	DATE	MK	REVISIONS	DATE
			0	RELEASED FOR APPROVAL	Nov 18 2025
			1	RELEASED FOR RE-APPROVAL	Jul 13 2026
			2	RELEASED FOR RE-APPROVAL	Aug 26 2026

STRUCTURE:-PINELLAS SUNCOAST TRANSIT AUTHORITY
LOCATION:- CLEARWATER STATION,CLEARWATER,FL.
DETAILER:- VECTORSHADES LLC
CUSTOMER:- KOKOLAKIS
ARCH./ENG.:- CDM SMITH
DESCRIPTION:- WAVE CANOPY VERTICAL BRACE DETAIL
DRAWN:- PBI DATE:- 10-27-2025 CHK.D:- RAG DATE:- 10-27-2025

SHOP BILL	WORK ORDER NO.	DRWG. NO.
	2553	1492 ⚠1

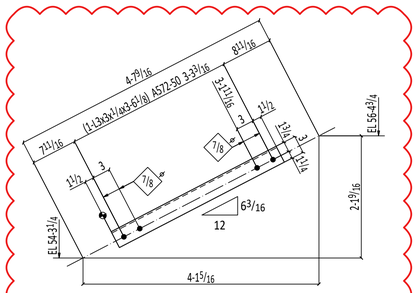

12 VERTICAL BRACES 1493VB -G

SHOP NOTE:
TOE DIRECTION FAR SIDE

SHIPPING LIST

MATERIAL BILL

ITEM NO	TOTAL QTY	DESCRIPTION	MAJOR MARK	PAINT CODE	TOTAL WEIGHT	ABM NO	UNIT QTY	LENGTH FT.	LENGTH IN.	MINOR MARK	REMARKS	UNIT WEIGHT	GRADE
	12	VERTICAL BRACE	1493VB	G	207						Galv	17	
	12	L3x3x¼			207		1	3	6⅛	1493VB		17	A572-50
		FIELD BOLTS											
	48	¾ Dia A325N						0	1¾		+1HD WASH		

Total weight : 207

REFERENCE :----

PAGE TOTALS

REVISION NO.

SPECIAL NOTES:-

MATERIAL:-

ASTM: A36 U.N.O.
S. S.: -----
ALUM.: -----
PIPE: A53 GR.B
TUBES: A500 GR.B
HOLES: 13/16 U.N.O
WELDING: E70XX

MATERIAL PREP.:-

CLEAN: SSPC-SP2
SHOP PAINT: TWO COAT OF STD SHOP PRIMER
GALV: GALVANIZED & PAINTED

GEN. NOTES:-

BUY AMERICAN:
DOMESTIC:
CERT/CONFORMANCE:
CERT/COMPLIANCE:

ALL WIDE FLANGE SHAPES TO BE PER A992-G50

FIELD CONNECTIONS :
HOLES : 13/16" U.N.O
PAINT :

morrow steel Fabricators, Inc.

3620 COPELAND DRIVE
ZEPHYRHILLS, FL. 33542

	PRINTS FOR	DATE	MK	REVISIONS	DATE
			0	RELEASED FOR APPROVAL	Nov 18 2025
			1	RELEASED FOR RE-APPROVAL	Jul 13 2026
			2	RELEASED FOR RE-APPROVAL	Aug 26 2026

STRUCTURE:- PINELLAS SUNCOAST TRANSIT AUTHORITY
LOCATION:- CLEARWATER STATION,CLEARWATER,FL.
DETAILER:- VECTORSHADES LLC
CUSTOMER:- KOKOLAKIS
ARCH./ENG.:- CDM SMITH
DESCRIPTION:- WAVE CANOPY VERTICAL BRACE DETAIL
DRAWN:- PBI DATE:-10-27-2025 CHK.D.-RAG DATE:- 10-27-2025

SHOP BILL	WORK ORDER NO.	DRWG. NO.
	2553	1493 ⚠1

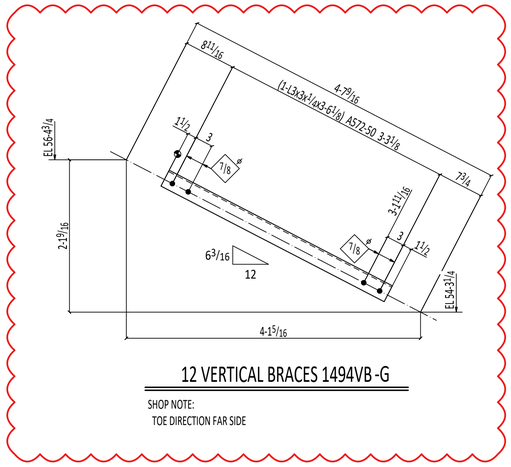

12 VERTICAL BRACES 1494VB -G

SHOP NOTE:
TOE DIRECTION FAR SIDE

SHIPPING LIST / MATERIAL BILL

ITEM NO	TOTAL QTY	DESCRIPTION	MAJOR MARK	PAINT CODE	TOTAL WEIGHT	ABM NO	UNIT QTY	LENGTH FT.	LENGTH IN.	MINOR MARK	REMARKS	UNIT WEIGHT	GRADE
	12	VERTICAL BRACE	1494VB	G	207						Galv	17	
	12	L3x3x1/4			207		1	3	6 1/8	1494VB		17	A572-50
		FIELD BOLTS											
	48	3/4 Dia A325N						0	1 3/4		+1HD WASH		

Total weight : 207

REFERENCE :----

PAGE TOTALS

REVISION NO.

SPECIAL NOTES:-

MATERIAL:-
ASTM: A36 U.N.O.
S.S.: -----
ALUM.: -----
PIPE: A53 GR.B
TUBES: A500 GR.B
HOLES: 13/16 U.N.O
WELDING: E70XX

MATERIAL PREP.:-
CLEAN: SSPC-SP2
SHOP PAINT: TWO COAT OF STD SHOP PRIMER
GALV: GALVANIZED & PAINTED

GEN. NOTES:-
BUY AMERICAN:
DOMESTIC:
CERT/CONFORMANCE:
CERT/COMPLIANCE:

ALL WIDE FLANGE SHAPES TO BE PER A992-G50

FIELD CONNECTIONS :
HOLES : 13/16" U.N.O
PAINT :

morrow steel Fabricators, Inc.

3620 COPELAND DRIVE
ZEPHYRHILLS, FL. 33542

	PRINTS FOR	DATE	MK	REVISIONS	DATE
			0	RELEASED FOR APPROVAL	Nov 18 2025
			1	RELEASED FOR RE-APPROVAL	Jul 13 2026
			2	RELEASED FOR RE-APPROVAL	Aug 26 2026

STRUCTURE:- PINELLAS SUNCOAST TRANSIT AUTHORITY
LOCATION:- CLEARWATER STATION,CLEARWATER,FL.
DETAILER:- VECTORSHADES LLC
CUSTOMER:- KOKOLAKIS
ARCH./ENG.:- CDM SMITH
DESCRIPTION:- WAVE CANOPY VERTICAL BRACE DETAIL
DRAWN:- PBI DATE:- 10-27-2025 CHK.D:- RAG DATE:- 10-27-2025

SHOP BILL	WORK ORDER NO.	DRWG. NO.
	2553	1494 1

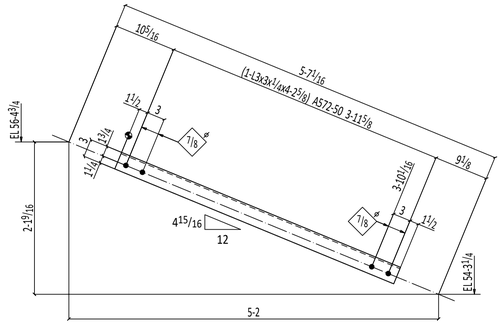

2 VERTICAL BRACES 1495VB -G

SHOP NOTE:
TOE DIRECTION FAR SIDE

AESS CATEGORY-3

SHIPPING LIST

MATERIAL BILL

ITEM NO	TOTAL QTY	DESCRIPTION	MAJOR MARK	PAINT CODE	TOTAL WEIGHT	ABM NO	UNIT QTY	LENGTH FT.	LENGTH IN.	MINOR MARK	REMARKS	UNIT WEIGHT	GRADE
	2	VERTICAL BRACE	1495VB	G	41						Galv	21	
	2	L3x3x1/4			41		1	4	2 5/8	1495VB		21	A572-50
		FIELD BOLTS											
	8	3/4 Dia A325N						0	1 3/4		+1HD WASH		

Total weight : 41

REFERENCE :----

PAGE TOTALS

REVISION NO.

SPECIAL NOTES:-

MATERIAL:-

ASTM: A36 U.N.O.
S. S.: -----
ALUM.: -----
PIPE: A53 GR.B
TUBES: A500 GR.B
HOLES: 13/16 U.N.O
WELDING: E70XX

MATERIAL PREP.:-

CLEAN: SSPC-SP2
SHOP PAINT: TWO COAT OF STD SHOP PRIMER
GALV: GALVANIZED & PAINTED

GEN. NOTES:-

BUY AMERICAN:
DOMESTIC:
CERT/CONFORMANCE:
CERT/COMPLIANCE:

ALL WIDE FLANGE SHAPES TO BE PER A992-G50

FIELD CONNECTIONS :
HOLES : 13/16" U.N.O
PAINT :

morrow steel Fabricators, Inc.

3620 COPELAND DRIVE
ZEPHYRHILLS, FL. 33542

	PRINTS FOR	DATE	MK	REVISIONS	DATE
			0	RELEASED FOR APPROVAL	Nov 18 2025
			1	RELEASED FOR RE-APPROVAL	Jul 13 2026
			2	RELEASED FOR RE-APPROVAL	Aug 26 2026

STRUCTURE:- PINELLAS SUNCOAST TRANSIT AUTHORITY
LOCATION:- CLEARWATER STATION,CLEARWATER,FL.
DETAILER:- VECTORSHADES LLC
CUSTOMER:- KOKOLAKIS
ARCH./ENG.:- CDM SMITH
DESCRIPTION:- WAVE CANOPY VERTICAL BRACE DETAIL
DRAWN:- PBI DATE:-10-27-2025 CHK.D.-RAG DATE:- 10-27-2025

SHOP BILL	WORK ORDER NO.	DRWG. NO.
	2553	1495

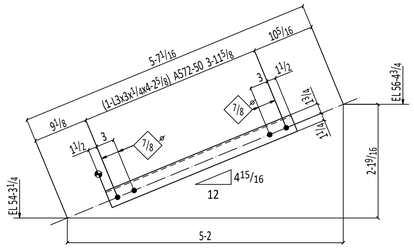

2 VERTICAL BRACES 1496VB-G

SHOP NOTE:
TOE DIRECTION FAR SIDE

AESS CATEGORY-3

SHIPPING LIST / MATERIAL BILL

ITEM NO	TOTAL QTY	DESCRIPTION	MAJOR MARK	PAINT CODE	TOTAL WEIGHT	ABM NO	UNIT QTY	LENGTH FT.	LENGTH IN.	MINOR MARK	REMARKS	UNIT WEIGHT	GRADE
	2	VERTICAL BRACE	1496VB	G	41						Galv	21	
	2	L3x3x1/4			41		1	4	2 5/8	1496VB		21	A572-50
		FIELD BOLTS											
	8	3/4 Dia A325N						0	1 3/4		+1HD WASH		

Total weight : 41

REFERENCE :----

PAGE TOTALS | REVISION NO.

SPECIAL NOTES:-

MATERIAL:-
ASTM: A36 U.N.O.
S. S.: -----
ALUM.: -----
PIPE: A53 GR.B
TUBES: A500 GR.B
HOLES: 13/16 U.N.O
WELDING: E70XX

MATERIAL PREP.:-
CLEAN: SSPC-SP2
SHOP PAINT: TWO COAT OF STD SHOP PRIMER
GALV: GALVANIZED & PAINTED

GEN. NOTES:-
BUY AMERICAN:
DOMESTIC:
CERT/CONFORMANCE:
CERT/COMPLIANCE:

ALL WIDE FLANGE SHAPES TO BE PER A992-G50

FIELD CONNECTIONS :
HOLES : 13/16" U.N.O
PAINT :

morrow steel Fabricators, Inc.

3620 COPELAND DRIVE
ZEPHYRHILLS, FL. 33542

	PRINTS FOR	DATE	MK	REVISIONS	DATE
			0	RELEASED FOR APPROVAL	Nov 18 2025
			1	RELEASED FOR RE-APPROVAL	Jul 13 2026
			2	RELEASED FOR RE-APPROVAL	Aug 26 2026

STRUCTURE:- PINELLAS SUNCOAST TRANSIT AUTHORITY
LOCATION:- CLEARWATER STATION,CLEARWATER,FL.
DETAILER:- VECTORSHADES LLC
CUSTOMER:- KOKOLAKIS
ARCH./ENG.:- CDM SMITH
DESCRIPTION:- WAVE CANOPY VERTICAL BRACE DETAIL
DRAWN:- PBI DATE:- 10-27-2025 CHK.D.- RAG DATE:- 10-27-2025

SHOP BILL	WORK ORDER NO.	DRWG. NO.
	2553	1496

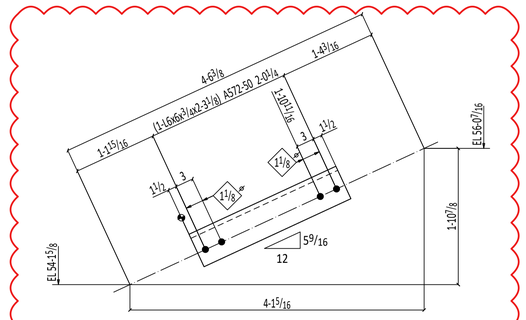

6 VERTICAL BRACES 1497VB -G

SHOP NOTE:
TOE DIRECTION FAR SIDE

SHIPPING LIST / MATERIAL BILL

ITEM NO	TOTAL QTY	DESCRIPTION	MAJOR MARK	PAINT CODE	TOTAL WEIGHT	ABM NO	UNIT QTY	LENGTH FT.	LENGTH IN.	MINOR MARK	REMARKS	UNIT WEIGHT	GRADE
	6	VERTICAL BRACE	1497VB	G	390						Galv	65	
	6	L6x6x3/4			390		1	2	3 1/8	1497VB		65	A572-50
		FIELD BOLTS											
	24	1 Dia A325N						0	2 3/4		+1HD WASH		

Total weight : 390

REFERENCE :----

PAGE TOTALS

REVISION NO.

SPECIAL NOTES:-

MATERIAL:-

ASTM:	A36 U.N.O.
S. S.:	-----
ALUM.:	-----
PIPE:	A53 GR.B
TUBES:	A500 GR.B
HOLES:	13/16 U.N.O
WELDING:	E70XX

MATERIAL PREP.:-

CLEAN:	SSPC-SP2
SHOP PAINT:	TWO COAT OF STD SHOP PRIMER
GALV:	GALVANIZED & PAINTED

GEN. NOTES:-

BUY AMERICAN:
DOMESTIC:
CERT/CONFORMANCE:
CERT/COMPLIANCE:

ALL WIDE FLANGE SHAPES TO BE PER A992-G50

FIELD CONNECTIONS :
HOLES : 13/16" U.N.O
PAINT :

morrow steel Fabricators, Inc.

3620 COPELAND DRIVE
ZEPHYRHILLS, FL. 33542

	PRINTS FOR	DATE	MK	REVISIONS	DATE
			0	RELEASED FOR APPROVAL	Nov 18 2025
			1	RELEASED FOR RE-APPROVAL	Jul 13 2026
			2	RELEASED FOR RE-APPROVAL	Aug 26 2026

STRUCTURE:- PINELLAS SUNCOAST TRANSIT AUTHORITY
LOCATION:- CLEARWATER STATION,CLEARWATER,FL.
DETAILER:- VECTORSHADES LLC
CUSTOMER:- KOKOLAKIS
ARCH./ENG.:- CDM SMITH
DESCRIPTION:- WAVE CANOPY VERTICAL BRACE DETAIL
DRAWN:- PBI DATE:- 10-27-2025 CHK.D.- RAG DATE:- 10-27-2025

SHOP BILL	WORK ORDER NO.	DRWG. NO.
	2553	1497

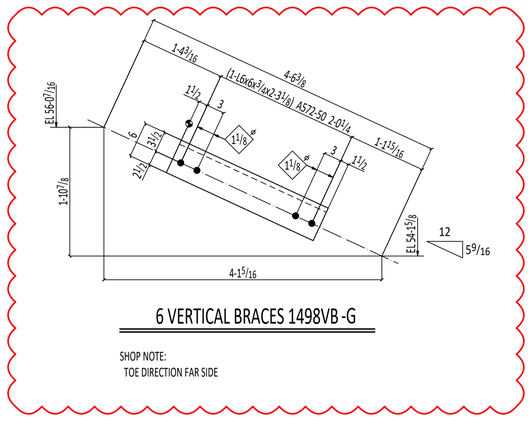

6 VERTICAL BRACES 1498VB -G

SHOP NOTE:
TOE DIRECTION FAR SIDE

SHIPPING LIST

MATERIAL BILL

ITEM NO	TOTAL QTY	DESCRIPTION	MAJOR MARK	PAINT CODE	TOTAL WEIGHT	ABM NO	UNIT QTY	LENGTH FT.	LENGTH IN.	MINOR MARK	REMARKS	UNIT WEIGHT	GRADE
	6	VERTICAL BRACE	1498VB	G	390						Galv	65	
	6	L6x6x3/4			390		1	2	3 1/8	1498VB		65	A572-50
		FIELD BOLTS											
	24	1 Dia A325N						0	2 3/4		+1HD WASH		

Total weight : 390

REFERENCE :----

PAGE TOTALS

REVISION NO.

SPECIAL NOTES:-

MATERIAL:-

ASTM: A36 U.N.O.
S. S.: -----
ALUM.: -----
PIPE: A53 GR.B
TUBES: A500 GR.B
HOLES: 13/16 U.N.O
WELDING: E70XX

MATERIAL PREP.:-

CLEAN: SSPC-SP2
SHOP PAINT: TWO COAT OF STD SHOP PRIMER
GALV: GALVANIZED & PAINTED

GEN. NOTES:-

BUY AMERICAN:
DOMESTIC:
CERT/CONFORMANCE:
CERT/COMPLIANCE:

ALL WIDE FLANGE SHAPES TO BE PER A992-G50

FIELD CONNECTIONS :
HOLES : 13/16" U.N.O
PAINT :

morrow steel Fabricators, Inc.

3620 COPELAND DRIVE
ZEPHYRHILLS, FL. 33542

	PRINTS FOR	DATE	MK	REVISIONS	DATE
			0	RELEASED FOR APPROVAL	Nov 18 2025
			1	RELEASED FOR RE-APPROVAL	Jul 13 2026
			2	RELEASED FOR RE-APPROVAL	Aug 26 2026

STRUCTURE:-PINELLAS SUNCOAST TRANSIT AUTHORITY
LOCATION:- CLEARWATER STATION,CLEARWATER,FL.
DETAILER:- VECTORSHADES LLC
CUSTOMER:- KOKOLAKIS
ARCH./ENG.:- CDM SMITH
DESCRIPTION:- WAVE CANOPY VERTICAL BRACE DETAIL
DRAWN:- PBI DATE:- 10-27-2025 CHK.D:- RAG DATE:- 10-27-2025

SHOP BILL	WORK ORDER NO.	DRWG. NO.
	2553	1498 ⚠1

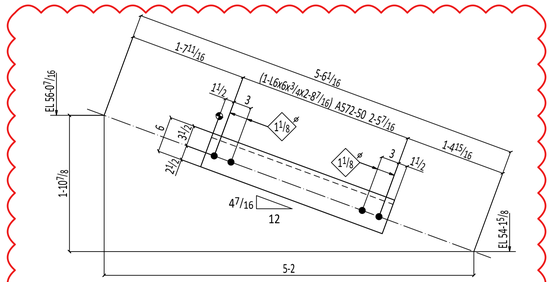

ONE VERTICAL BRACE 1499VB -G

SHOP NOTE:
TOE DIRECTION FAR SIDE

AESS CATEGORY-3

SHIPPING LIST

MATERIAL BILL

ITEM NO	TOTAL QTY	DESCRIPTION	MAJOR MARK	PAINT CODE	TOTAL WEIGHT	ABM NO	UNIT QTY	LENGTH FT.	LENGTH IN.	MINOR MARK	REMARKS	UNIT WEIGHT	GRADE
	ONE	VERTICAL BRACE	1499VB	G	78						Galv	78	
	1	L6x6x3/4			78		1	2	8 7/16	1499VB		78	A572-50
		FIELD BOLTS											
	4	1 Dia A325N						0	2 3/4		+1HD WASH		

Total weight : 78

REFERENCE :----

PAGE TOTALS

REVISION NO.

SPECIAL NOTES:-

MATERIAL:-

ASTM: A36 U.N.O.
S. S.: -----
ALUM.: -----
PIPE: A53 GR.B
TUBES: A500 GR.B
HOLES: 13/16 U.N.O
WELDING: E70XX

MATERIAL PREP.:-

CLEAN: SSPC-SP2
SHOP PAINT: TWO COAT OF STD SHOP PRIMER
GALV: GALVANIZED & PAINTED

GEN. NOTES:-

BUY AMERICAN:
DOMESTIC:
CERT/CONFORMANCE:
CERT/COMPLIANCE:

ALL WIDE FLANGE SHAPES TO BE PER A992-G50

FIELD CONNECTIONS :
HOLES : 13/16" U.N.O
PAINT :

morrow steel Fabricators, Inc.

3620 COPELAND DRIVE
ZEPHYRHILLS, FL. 33542

	PRINTS FOR	DATE	MK	REVISIONS	DATE
			0	RELEASED FOR APPROVAL	Nov 18 2025
			1	RELEASED FOR RE-APPROVAL	Jul 13 2026
			2	RELEASED FOR RE-APPROVAL	Aug 26 2026

STRUCTURE:- PINELLAS SUNCOAST TRANSIT AUTHORITY
LOCATION:- CLEARWATER STATION,CLEARWATER,FL.
DETAILER:- VECTORSHADES LLC
CUSTOMER:- KOKOLAKIS
ARCH./ENG.:- CDM SMITH
DESCRIPTION:- WAVE CANOPY VERTICAL BRACE DETAIL
DRAWN:- PBI DATE:- 10-27-2025 CHK.D:- RAG DATE:- 10-27-2025

SHOP BILL	WORK ORDER NO.	DRWG. NO.
	2553	1499

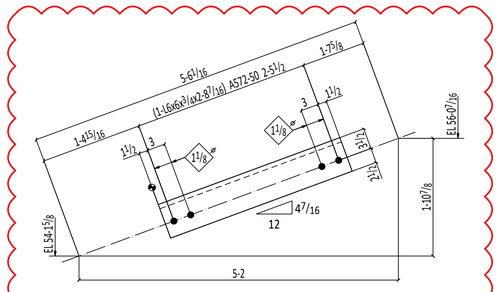

ONE VERTICAL BRACE 1500VB-G

SHOP NOTE:
TOE DIRECTION FAR SIDE

AESS CATEGORY-3

SHIPPING LIST

MATERIAL BILL

ITEM NO	TOTAL QTY	DESCRIPTION	MAJOR MARK	PAINT CODE	TOTAL WEIGHT	ABM NO	UNIT QTY	LENGTH FT.	LENGTH IN.	MINOR MARK	REMARKS	UNIT WEIGHT	GRADE
	ONE	VERTICAL BRACE	1500VB	G	78						Galv	78	
	1	L6x6x3/4			78		1	2	8 7/16	1500VB		78	A572-50
		FIELD BOLTS											
	4	1 Dia A325N						0	2 3/4		+1HD WASH		

Total weight : 78

REFERENCE :----

PAGE TOTALS

REVISION NO.

SPECIAL NOTES:-

MATERIAL:-

ASTM: A36 U.N.O.
S. S.: -----
ALUM.: -----
PIPE: A53 GR.B
TUBES: A500 GR.B
HOLES: 13/16 U.N.O
WELDING: E70XX

MATERIAL PREP.:-

CLEAN: SSPC-SP2
SHOP PAINT: TWO COAT OF STD SHOP PRIMER
GALV: GALVANIZED & PAINTED

GEN. NOTES:-

BUY AMERICAN:
DOMESTIC:
CERT/CONFORMANCE:
CERT/COMPLIANCE:

ALL WIDE FLANGE SHAPES TO BE PER A992-G50

FIELD CONNECTIONS :
HOLES : 13/16" U.N.O
PAINT :

morrow steel Fabricators, Inc.

3620 COPELAND DRIVE
ZEPHYRHILLS, FL. 33542

	PRINTS FOR	DATE	MK	REVISIONS	DATE
			0	RELEASED FOR APPROVAL	Nov 18 2025
			1	RELEASED FOR RE-APPROVAL	Jul 13 2026
			2	RELEASED FOR RE-APPROVAL	Aug 26 2026

STRUCTURE:- PINELLAS SUNCOAST TRANSIT AUTHORITY
LOCATION:- CLEARWATER STATION,CLEARWATER,FL.
DETAILER:- VECTORSHADES LLC
CUSTOMER:- KOKOLAKIS
ARCH./ENG.:- CDM SMITH
DESCRIPTION:- WAVE CANOPY VERTICAL BRACE DETAIL
DRAWN:- PBI DATE:-10-27-2025 CHK.D.-RAG DATE:- 10-27-2025

SHOP BILL	WORK ORDER NO.	DRWG. NO.
	2553	1500

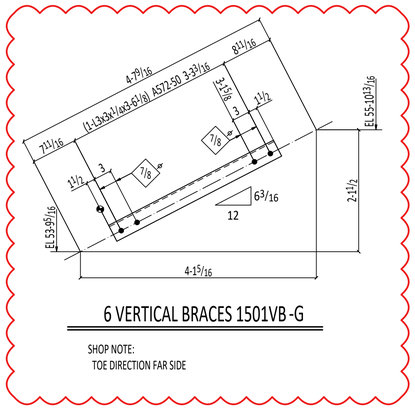

6 VERTICAL BRACES 1501VB -G

SHOP NOTE:
TOE DIRECTION FAR SIDE

SHIPPING LIST

MATERIAL BILL

ITEM NO	TOTAL QTY	DESCRIPTION	MAJOR MARK	PAINT CODE	TOTAL WEIGHT	ABM NO	UNIT QTY	LENGTH FT.	LENGTH IN.	MINOR MARK	REMARKS	UNIT WEIGHT	GRADE
	6	VERTICAL BRACE	1501VB	G	103						Galv	17	
	6	L3x3x¼			103		1	3	6⅛	1501VB		17	A572-50
		FIELD BOLTS											
	24	¾ Dia A325N						0	1¾		+1HD WASH		

Total weight : 103

REFERENCE :----

PAGE TOTALS

REVISION NO.

SPECIAL NOTES:-

MATERIAL:-
ASTM: A36 U.N.O.
S. S.: -----
ALUM.: -----
PIPE: A53 GR.B
TUBES: A500 GR.B
HOLES: 13/16 U.N.O
WELDING: E70XX

MATERIAL PREP.:-
CLEAN: SSPC-SP2
SHOP PAINT: TWO COAT OF STD SHOP PRIMER
GALV: GALVANIZED & PAINTED

GEN. NOTES:-
BUY AMERICAN:
DOMESTIC:
CERT/CONFORMANCE:
CERT/COMPLIANCE:

ALL WIDE FLANGE SHAPES TO BE PER A992-G50

FIELD CONNECTIONS :
HOLES : 13/16" U.N.O
PAINT :

morrow steel Fabricators, Inc.

3620 COPELAND DRIVE
ZEPHYRHILLS, FL. 33542

	PRINTS FOR	DATE	MK	REVISIONS	DATE
			0	RELEASED FOR APPROVAL	Nov 18 2025
			1	RELEASED FOR RE-APPROVAL	Jul 13 2026
			2	RELEASED FOR RE-APPROVAL	Aug 26 2026

STRUCTURE:-PINELLAS SUNCOAST TRANSIT AUTHORITY
LOCATION:- CLEARWATER STATION,CLEARWATER,FL.
DETAILER:- VECTORSHADES LLC
CUSTOMER:- KOKOLAKIS
ARCH./ENG.:- CDM SMITH
DESCRIPTION:-WAVE CANOPY VERTICAL BRACE DETAIL
DRAWN:- PBI DATE:-10-27-2025 CHK.D:-RAG DATE:- 10-27-2025

SHOP BILL	WORK ORDER NO.	DRWG. NO.
	2553	1501

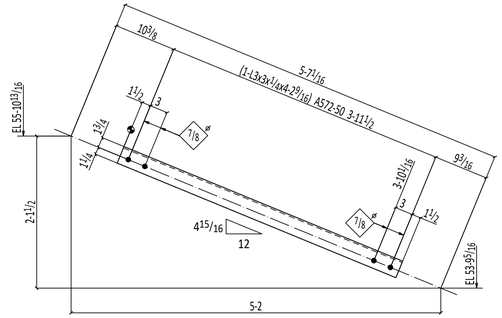

ONE VERTICAL BRACE 1502VB -G

SHOP NOTE:
TOE DIRECTION FAR SIDE

AESS CATEGORY-3

SHIPPING LIST / MATERIAL BILL

ITEM NO	TOTAL QTY	DESCRIPTION	MAJOR MARK	PAINT CODE	TOTAL WEIGHT	ABM NO	UNIT QTY	LENGTH FT.	LENGTH IN.	MINOR MARK	REMARKS	UNIT WEIGHT	GRADE
	ONE	VERTICAL BRACE	1502VB	G	21						Galv	21	
	1	L3x3x1/4			21		1	4	29/16	1502VB		21	A572-50
		FIELD BOLTS											
	4	3/4 Dia A325N						0	13/4		+1HD WASH		

Total weight : 21

REFERENCE :----

PAGE TOTALS

REVISION NO.

SPECIAL NOTES:-

MATERIAL:-
ASTM: A36 U.N.O.
S. S.: -----
ALUM.: -----
PIPE: A53 GR.B
TUBES: A500 GR.B
HOLES: 13/16 U.N.O
WELDING: E70XX

MATERIAL PREP.:-
CLEAN: SSPC-SP2
SHOP PAINT: TWO COAT OF STD SHOP PRIMER
GALV: GALVANIZED & PAINTED

GEN. NOTES:-
BUY AMERICAN:
DOMESTIC:
CERT/CONFORMANCE:
CERT/COMPLIANCE:

ALL WIDE FLANGE SHAPES TO BE PER A992-G50

FIELD CONNECTIONS :
HOLES : 13/16" U.N.O
PAINT :

morrow steel Fabricators, Inc.

3620 COPELAND DRIVE
ZEPHYRHILLS, FL. 33542

	PRINTS FOR	DATE	MK	REVISIONS	DATE
			0	RELEASED FOR APPROVAL	Nov 18 2025
			1	RELEASED FOR RE-APPROVAL	Jul 13 2026
			2	RELEASED FOR RE-APPROVAL	Aug 26 2026

STRUCTURE:- PINELLAS SUNCOAST TRANSIT AUTHORITY
LOCATION:- CLEARWATER STATION,CLEARWATER,FL.
DETAILER:- VECTORSHADES LLC
CUSTOMER:- KOKOLAKIS
ARCH./ENG.:- CDM SMITH
DESCRIPTION:- WAVE CANOPY VERTICAL BRACE DETAIL
DRAWN:- PBI DATE:- 10-27-2025 CHK.D:- RAG DATE:- 10-27-2025

SHOP BILL	WORK ORDER NO.	DRWG. NO.
	2553	1502

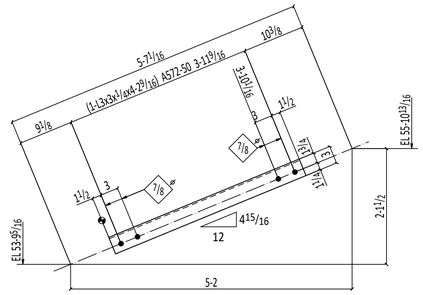

ONE VERTICAL BRACE 1503VB -G

SHOP NOTE:
TOE DIRECTION FAR SIDE

AESS CATEGORY-3

SHIPPING LIST / MATERIAL BILL

ITEM NO	TOTAL QTY	DESCRIPTION	MAJOR MARK	PAINT CODE	TOTAL WEIGHT	ABM NO	UNIT QTY	LENGTH FT.	LENGTH IN.	MINOR MARK	REMARKS	UNIT WEIGHT	GRADE
	ONE	VERTICAL BRACE	1503VB	G	21						Galv	21	
	1	L3x3x1/4			21		1	4	29/16	1503VB		21	A572-50
		FIELD BOLTS											
	4	3/4 Dia A325N						0	13/4		+1HD WASH		

Total weight : 21

REFERENCE :----

PAGE TOTALS

REVISION NO.

SPECIAL NOTES:-

MATERIAL:-
ASTM: A36 U.N.O.
S. S.: -----
ALUM.: -----
PIPE: A53 GR.B
TUBES: A500 GR.B
HOLES: 13/16 U.N.O
WELDING: E70XX

MATERIAL PREP.:-
CLEAN: SSPC-SP2
SHOP PAINT: TWO COAT OF STD SHOP PRIMER
GALV: GALVANIZED & PAINTED

GEN. NOTES:-
BUY AMERICAN:
DOMESTIC:
CERT/CONFORMANCE:
CERT/COMPLIANCE:

ALL WIDE FLANGE SHAPES TO BE PER A992-G50

FIELD CONNECTIONS :
HOLES : 13/16" U.N.O
PAINT :

morrow steel Fabricators, Inc.

3620 COPELAND DRIVE
ZEPHYRHILLS, FL. 33542

	PRINTS FOR	DATE	MK	REVISIONS	DATE
			0	RELEASED FOR APPROVAL	Nov 18 2025
			1	RELEASED FOR RE-APPROVAL	Jul 13 2026
			2	RELEASED FOR RE-APPROVAL	Aug 26 2026

STRUCTURE:-PINELLAS SUNCOAST TRANSIT AUTHORITY
LOCATION:- CLEARWATER STATION,CLEARWATER,FL.
DETAILER:- VECTORSHADES LLC
CUSTOMER:- KOKOLAKIS
ARCH./ENG.:- CDM SMITH
DESCRIPTION:- WAVE CANOPY VERTICAL BRACE DETAIL
DRAWN:- PBI DATE:- 10-27-2025 CHK.D:- RAG DATE:- 10-27-2025

SHOP BILL	WORK ORDER NO.	DRWG. NO.
	2553	1503

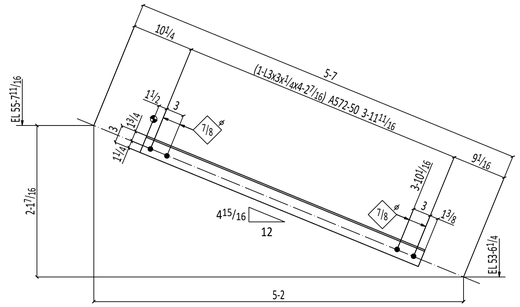

ONE VERTICAL BRACE 1504VR -G

SHOP NOTE:
TOE DIRECTION NEAR SIDE

AESS CATEGORY-3

SHIPPING LIST

MATERIAL BILL

ITEM NO	TOTAL QTY	DESCRIPTION	MAJOR MARK	PAINT CODE	TOTAL WEIGHT	ABM NO	UNIT QTY	LENGTH FT.	LENGTH IN.	MINOR MARK	REMARKS	UNIT WEIGHT	GRADE
	ONE	VERTICAL BRACE	1504VR	G	21						Galv	21	
	1	L3x3x1/4			21		1	4	27/16	1504VR		21	A572-50
		FIELD BOLTS											
	4	3/4 Dia A325N						0	1 3/4		+1HD WASH		

Total weight : 21

REFERENCE :----

PAGE TOTALS

REVISION NO.

SPECIAL NOTES:-

MATERIAL:-

ASTM:	A36 U.N.O.
S. S.:	-----
ALUM.:	-----
PIPE:	A53 GR.B
TUBES:	A500 GR.B
HOLES:	13/16 U.N.O
WELDING:	E70XX

MATERIAL PREP.:-

CLEAN:	SSPC-SP2
SHOP PAINT:	TWO COAT OF STD SHOP PRIMER
GALV:	GALVANIZED & PAINTED

GEN. NOTES:-

BUY AMERICAN:
DOMESTIC:
CERT/CONFORMANCE:
CERT/COMPLIANCE:

ALL WIDE FLANGE SHAPES TO BE PER A992-G50

FIELD CONNECTIONS :
HOLES : 13/16" U.N.O
PAINT :

morrow steel Fabricators, Inc.

3620 COPELAND DRIVE
ZEPHYRHILLS, FL. 33542

	PRINTS FOR	DATE	MK	REVISIONS	DATE
			0	RELEASED FOR APPROVAL	Nov 18 2025
			1	RELEASED FOR RE-APPROVAL	Jul 13 2026
			2	RELEASED FOR RE-APPROVAL	Aug 26 2026

STRUCTURE:- PINELLAS SUNCOAST TRANSIT AUTHORITY
LOCATION:- CLEARWATER STATION,CLEARWATER,FL.
DETAILER:- VECTORSHADES LLC
CUSTOMER:- KOKOLAKIS
ARCH./ENG.:- CDM SMITH
DESCRIPTION:- WAVE CANOPY VERTICAL BRACE DETAIL
DRAWN:- PBI DATE:- 10-27-2025 CHK.D:- RAG DATE:- 10-27-2025

SHOP BILL	WORK ORDER NO.	DRWG. NO.
	2553	1504

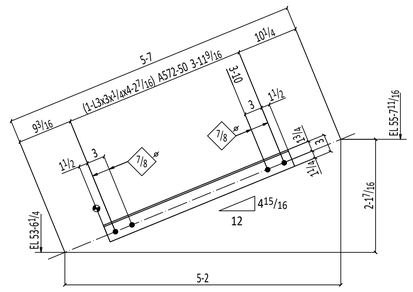

ONE VERTICAL BRACE 1505VB -G

SHOP NOTE:
TOE DIRECTION NEAR SIDE

AESS CATEGORY-3

SHIPPING LIST

MATERIAL BILL

ITEM NO	TOTAL QTY	DESCRIPTION	MAJOR MARK	PAINT CODE	TOTAL WEIGHT	ABM NO	UNIT QTY	LENGTH FT.	LENGTH IN.	MINOR MARK	REMARKS	UNIT WEIGHT	GRADE
	ONE	VERTICAL BRACE	1505VB	G	21						Galv	21	
	1	L3x3x¼			21		1	4	27/16	1505VB		21	A572-50
		FIELD BOLTS											
	4	¾ Dia A325N						0	1¾		+1HD WASH		

Total weight : 21

REFERENCE :----

PAGE TOTALS

REVISION NO.

SPECIAL NOTES:-

MATERIAL:-

ASTM: A36 U.N.O.
S. S.: -----
ALUM.: -----
PIPE: A53 GR.B
TUBES: A500 GR.B
HOLES: 13/16 U.N.O
WELDING: E70XX

MATERIAL PREP.:-

CLEAN: SSPC-SP2
SHOP PAINT: TWO COAT OF STD SHOP PRIMER
GALV: GALVANIZED & PAINTED

GEN. NOTES:-

BUY AMERICAN:
DOMESTIC:
CERT/CONFORMANCE:
CERT/COMPLIANCE:

ALL WIDE FLANGE SHAPES TO BE PER A992-G50

FIELD CONNECTIONS :
HOLES : 13/16" U.N.O
PAINT :

morrow steel Fabricators, Inc.

3620 COPELAND DRIVE
ZEPHYRHILLS, FL. 33542

	PRINTS FOR	DATE	MK	REVISIONS	DATE
			0	RELEASED FOR APPROVAL	Nov 18 2025
			1	RELEASED FOR RE-APPROVAL	Jul 13 2026
			2	RELEASED FOR RE-APPROVAL	Aug 26 2026

STRUCTURE:- PINELLAS SUNCOAST TRANSIT AUTHORITY
LOCATION:- CLEARWATER STATION,CLEARWATER,FL.
DETAILER:- VECTORSHADES LLC
CUSTOMER:- KOKOLAKIS
ARCH./ENG.:- CDM SMITH
DESCRIPTION:- WAVE CANOPY VERTICAL BRACE DETAIL
DRAWN:- PBI DATE:-10-27-2025 CHK.D:-RAG DATE:- 10-27-2025

SHOP BILL	WORK ORDER NO.	DRWG. NO.
	2553	1505

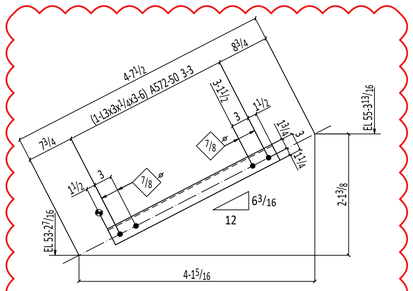

12 VERTICAL BRACES 1506VB -G

SHOP NOTE:
TOE DIRECTION FAR SIDE

SHIPPING LIST

MATERIAL BILL

ITEM NO	TOTAL QTY	DESCRIPTION	MAJOR MARK	PAINT CODE	TOTAL WEIGHT	ABM NO	UNIT QTY	LENGTH FT.	LENGTH IN.	MINOR MARK	REMARKS	UNIT WEIGHT	GRADE
	12	VERTICAL BRACE	1506VB	G	206						Galv	17	
	12	L3x3x¼			206		1	3	6	1506VB		17	A572-50
		FIELD BOLTS											
	48	¾ Dia A325N						0	1¾		+1HD WASH		

Total weight : 206

REFERENCE :----

PAGE TOTALS

REVISION NO.

SPECIAL NOTES:-

MATERIAL:-

ASTM: A36 U.N.O.
S. S.: -----
ALUM.: -----
PIPE: A53 GR.B
TUBES: A500 GR.B
HOLES: 13/16 U.N.O
WELDING: E70XX

MATERIAL PREP.:-

CLEAN: SSPC-SP2
SHOP PAINT: TWO COAT OF STD SHOP PRIMER
GALV: GALVANIZED & PAINTED

GEN. NOTES:-

BUY AMERICAN:
DOMESTIC:
CERT/CONFORMANCE:
CERT/COMPLIANCE:

ALL WIDE FLANGE SHAPES TO BE PER A992-G50

FIELD CONNECTIONS :
HOLES : 13/16" U.N.O
PAINT :

morrow steel Fabricators, Inc.

3620 COPELAND DRIVE
ZEPHYRHILLS, FL. 33542

	PRINTS FOR	DATE	MK	REVISIONS	DATE
			0	RELEASED FOR APPROVAL	Nov 18 2025
			1	RELEASED FOR RE-APPROVAL	Jul 13 2026
			2	RELEASED FOR RE-APPROVAL	Aug 26 2026

STRUCTURE:- PINELLAS SUNCOAST TRANSIT AUTHORITY
LOCATION:- CLEARWATER STATION,CLEARWATER,FL.
DETAILER:- VECTORSHADES LLC
CUSTOMER:- KOKOLAKIS
ARCH./ENG.:- CDM SMITH
DESCRIPTION:- WAVE CANOPY VERTICAL BRACE DETAIL
DRAWN:- PBI DATE:-10-27-2025 CHK.D:- RAG DATE:- 10-27-2025

SHOP BILL	WORK ORDER NO.	DRWG. NO.
	2553	1506

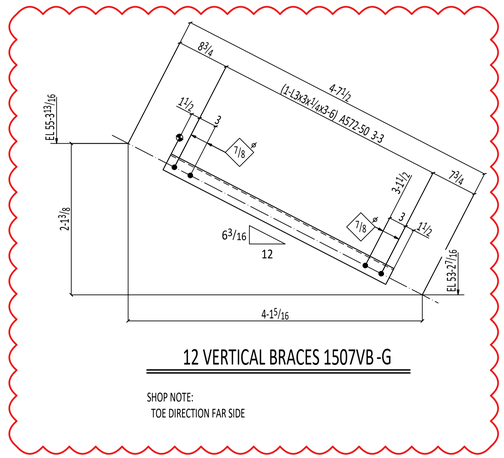

12 VERTICAL BRACES 1507VB -G

SHOP NOTE:
TOE DIRECTION FAR SIDE

SHIPPING LIST

MATERIAL BILL

ITEM NO	TOTAL QTY	DESCRIPTION	MAJOR MARK	PAINT CODE	TOTAL WEIGHT	ABM NO	UNIT QTY	LENGTH FT.	LENGTH IN.	MINOR MARK	REMARKS	UNIT WEIGHT	GRADE
	12	VERTICAL BRACE	1507VB	G	206						Galv	17	
	12	L3x3x1/4			206		1	3	6	1507VB		17	A572-50
		FIELD BOLTS											
	48	3/4 Dia A325N						0	1 3/4		+1HD WASH		

Total weight : 206

REFERENCE :----

PAGE TOTALS

REVISION NO.

SPECIAL NOTES:-

MATERIAL:-

ASTM:	A36 U.N.O.
S. S.:	-----
ALUM.:	-----
PIPE:	A53 GR.B
TUBES:	A500 GR.B
HOLES:	13/16 U.N.O
WELDING:	E70XX

MATERIAL PREP.:-

CLEAN:	SSPC-SP2
SHOP PAINT:	TWO COAT OF STD SHOP PRIMER
GALV:	GALVANIZED & PAINTED

GEN. NOTES:-

BUY AMERICAN:	
DOMESTIC:	
CERT/CONFORMANCE:	
CERT/COMPLIANCE:	

ALL WIDE FLANGE SHAPES TO BE PER A992-G50

FIELD CONNECTIONS :

HOLES : 13/16" U.N.O

PAINT :

morrow steel Fabricators, Inc.

3620 COPELAND DRIVE
ZEPHYRHILLS, FL. 33542

	PRINTS FOR	DATE	MK	REVISIONS	DATE
			0	RELEASED FOR APPROVAL	Nov 18 2025
			1	RELEASED FOR RE-APPROVAL	Jul 13 2026
			2	RELEASED FOR RE-APPROVAL	Aug 26 2026

STRUCTURE:- PINELLAS SUNCOAST TRANSIT AUTHORITY
LOCATION:- CLEARWATER STATION,CLEARWATER,FL.
DETAILER:- VECTORSHADES LLC
CUSTOMER:- KOKOLAKIS
ARCH./ENG.:- CDM SMITH
DESCRIPTION:- WAVE CANOPY VERTICAL BRACE DETAIL
DRAWN:- PBI DATE:- 10-27-2025 CHK.D:- RAG DATE:- 10-27-2025

SHOP BILL	WORK ORDER NO.	DRWG. NO.
	2553	1507

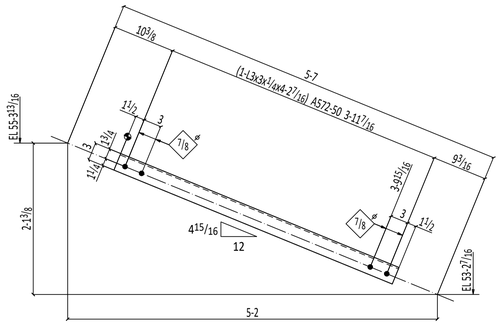

2 VERTICAL BRACES 1508VB -G

SHOP NOTE:
TOE DIRECTION FAR SIDE

AESS CATEGORY-3

SHIPPING LIST / MATERIAL BILL

ITEM NO	TOTAL QTY	DESCRIPTION	MAJOR MARK	PAINT CODE	TOTAL WEIGHT	ABM NO	UNIT QTY	LENGTH FT.	LENGTH IN.	MINOR MARK	REMARKS	UNIT WEIGHT	GRADE
	2	VERTICAL BRACE	1508VB	G	41						Galv	21	
	2	L3x3x1/4			41		1	4	27/16	1508VB		21	A572-50
		FIELD BOLTS											
	8	3/4 Dia A325N						0	13/4		+1HD WASH		

Total weight : 41

REFERENCE :----

PAGE TOTALS

REVISION NO.

SPECIAL NOTES:-

MATERIAL:-

ASTM:	A36 U.N.O.
S. S.:	-----
ALUM.:	-----
PIPE:	A53 GR.B
TUBES:	A500 GR.B
HOLES:	13/16 U.N.O
WELDING:	E70XX

MATERIAL PREP.:-

CLEAN:	SSPC-SP2
SHOP PAINT:	TWO COAT OF STD SHOP PRIMER
GALV:	GALVANIZED & PAINTED

GEN. NOTES:-

BUY AMERICAN:
DOMESTIC:
CERT/CONFORMANCE:
CERT/COMPLIANCE:

ALL WIDE FLANGE SHAPES TO BE PER A992-G50

FIELD CONNECTIONS :
HOLES : 13/16" U.N.O
PAINT :

morrow steel Fabricators, Inc.

3620 COPELAND DRIVE
ZEPHYRHILLS, FL. 33542

	PRINTS FOR	DATE	MK	REVISIONS	DATE
			0	RELEASED FOR APPROVAL	Nov 18 2025
			1	RELEASED FOR RE-APPROVAL	Jul 13 2026
			2	RELEASED FOR RE-APPROVAL	Aug 26 2026

STRUCTURE:- PINELLAS SUNCOAST TRANSIT AUTHORITY
LOCATION:- CLEARWATER STATION,CLEARWATER,FL.
DETAILER:- VECTORSHADES LLC
CUSTOMER:- KOKOLAKIS
ARCH./ENG.:- CDM SMITH
DESCRIPTION:- WAVE CANOPY VERTICAL BRACE DETAIL
DRAWN:- PBI DATE:-10-27-2025 CHK.D.-RAG DATE:- 10-27-2025

SHOP BILL	WORK ORDER NO.	DRWG. NO.
	2553	1508

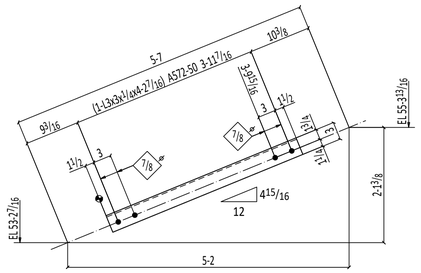

2 VERTICAL BRACES 1509VB -G

SHOP NOTE:
TOE DIRECTION FAR SIDE

AESS CATEGORY-3

SHIPPING LIST

MATERIAL BILL

ITEM NO	TOTAL QTY	DESCRIPTION	MAJOR MARK	PAINT CODE	TOTAL WEIGHT	ABM NO	UNIT QTY	LENGTH FT.	LENGTH IN.	MINOR MARK	REMARKS	UNIT WEIGHT	GRADE
	2	VERTICAL BRACE	1509VB	G	41						Galv	21	
	2	L3x3x1/4			41		1	4	27/16	1509VB		21	A572-50
		FIELD BOLTS											
	8	3/4 Dia A325N						0	13/4		+1HD WASH		

Total weight : 41

REFERENCE :----

PAGE TOTALS

REVISION NO.

SPECIAL NOTES:-

MATERIAL:-

ASTM: A36 U.N.O.
S. S.: -----
ALUM.: -----
PIPE: A53 GR.B
TUBES: A500 GR.B
HOLES: 13/16 U.N.O
WELDING: E70XX

MATERIAL PREP.:-

CLEAN: SSPC-SP2
SHOP PAINT: TWO COAT OF STD SHOP PRIMER
GALV: GALVANIZED & PAINTED

GEN. NOTES:-

BUY AMERICAN:
DOMESTIC:
CERT/CONFORMANCE:
CERT/COMPLIANCE:

ALL WIDE FLANGE SHAPES TO BE PER A992-G50

FIELD CONNECTIONS :
HOLES : 13/16" U.N.O
PAINT :

morrow steel Fabricators, Inc.

3620 COPELAND DRIVE
ZEPHYRHILLS, FL. 33542

	PRINTS FOR	DATE	MK	REVISIONS	DATE
			0	RELEASED FOR APPROVAL	Nov 18 2025
			1	RELEASED FOR RE-APPROVAL	Jul 13 2026
			2	RELEASED FOR RE-APPROVAL	Aug 26 2026

STRUCTURE:- PINELLAS SUNCOAST TRANSIT AUTHORITY
LOCATION:- CLEARWATER STATION,CLEARWATER,FL.
DETAILER:- VECTORSHADES LLC
CUSTOMER:- KOKOLAKIS
ARCH./ENG.:- CDM SMITH
DESCRIPTION:- WAVE CANOPY VERTICAL BRACE DETAIL
DRAWN:- PBI DATE:-10-27-2025 CHK.D.-RAG DATE:- 10-27-2025

SHOP BILL	WORK ORDER NO.	DRWG. NO.
	2553	1509

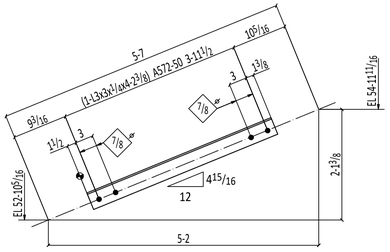

ONE VERTICAL BRACE 1510VB -G

SHOP NOTE:
TOE DIRECTION NEAR SIDE

AESS CATEGORY-3

SHIPPING LIST / MATERIAL BILL

ITEM NO	TOTAL QTY	DESCRIPTION	MAJOR MARK	PAINT CODE	TOTAL WEIGHT	ABM NO	UNIT QTY	LENGTH FT.	LENGTH IN.	MINOR MARK	REMARKS	UNIT WEIGHT	GRADE
	ONE	VERTICAL BRACE	1510VB	G	21						Galv	21	
	1	L3x3x1/4			21		1	4	2 3/8	1510VB		21	A572-50
		FIELD BOLTS											
	4	3/4 Dia A325N						0	1 3/4		+1HD WASH		

Total weight : 21

REFERENCE :----

PAGE TOTALS

REVISION NO.

SPECIAL NOTES:-

MATERIAL:-

ASTM:	A36 U.N.O.
S. S.:	-----
ALUM.:	-----
PIPE:	A53 GR.B
TUBES:	A500 GR.B
HOLES:	13/16 U.N.O
WELDING:	E70XX

MATERIAL PREP.:-

CLEAN: SSPC-SP2
SHOP PAINT: TWO COAT OF STD SHOP PRIMER
GALV: GALVANIZED & PAINTED

GEN. NOTES:-

BUY AMERICAN:
DOMESTIC:
CERT/CONFORMANCE:
CERT/COMPLIANCE:

ALL WIDE FLANGE SHAPES TO BE PER A992-G50

FIELD CONNECTIONS :
HOLES : 13/16" U.N.O
PAINT :

morrow steel Fabricators, Inc.

3620 COPELAND DRIVE
ZEPHYRHILLS, FL. 33542

	PRINTS FOR	DATE	MK	REVISIONS	DATE
			0	RELEASED FOR APPROVAL	Nov 18 2025
			1	RELEASED FOR RE-APPROVAL	Jul 13 2026
			2	RELEASED FOR RE-APPROVAL	Aug 26 2026

STRUCTURE:- PINELLAS SUNCOAST TRANSIT AUTHORITY
LOCATION:- CLEARWATER STATION,CLEARWATER,FL.
DETAILER:- VECTORSHADES LLC
CUSTOMER:- KOKOLAKIS
ARCH./ENG.:- CDM SMITH
DESCRIPTION:- WAVE CANOPY VERTICAL BRACE DETAIL
DRAWN:- PBI DATE:-10-27-2025 CHK.D.-RAG DATE:- 10-27-2025

SHOP BILL	WORK ORDER NO.	DRWG. NO.
	2553	1510 ⚠1

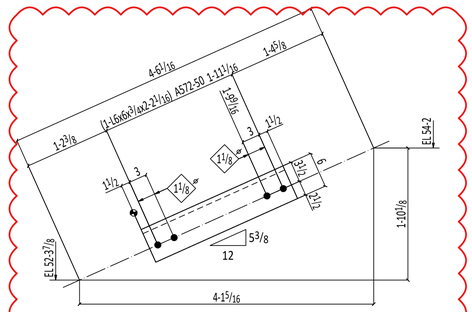

6 VERTICAL BRACES 1511VB -G

SHOP NOTE:
TOE DIRECTION FAR SIDE

SHIPPING LIST

MATERIAL BILL

ITEM NO	TOTAL QTY	DESCRIPTION	MAJOR MARK	PAINT CODE	TOTAL WEIGHT	ABM NO	UNIT QTY	LENGTH FT.	LENGTH IN.	MINOR MARK	REMARKS	UNIT WEIGHT	GRADE
	6	VERTICAL BRACE	1511VB	G	374						Galv	62	
	6	L6x6x3/4			374		1	2	21/16	1511VB		62	A572-50
		FIELD BOLTS											
	24	1 Dia A325N						0	23/4		+1HD WASH		

Total weight : 374

REFERENCE :----

PAGE TOTALS | REVISION NO.

SPECIAL NOTES:-

MATERIAL:-
ASTM: A36 U.N.O.
S. S.: -----
ALUM.: -----
PIPE: A53 GR.B
TUBES: A500 GR.B
HOLES: 13/16 U.N.O
WELDING: E70XX

MATERIAL PREP.:-
CLEAN: SSPC-SP2
SHOP PAINT: TWO COAT OF STD SHOP PRIMER
GALV: GALVANIZED & PAINTED

GEN. NOTES:-
BUY AMERICAN:
DOMESTIC:
CERT/CONFORMANCE:
CERT/COMPLIANCE:

ALL WIDE FLANGE SHAPES TO BE PER A992-G50

FIELD CONNECTIONS :
HOLES : 13/16" U.N.O
PAINT :

morrow steel Fabricators, Inc.

3620 COPELAND DRIVE
ZEPHYRHILLS, FL. 33542

	PRINTS FOR	DATE	MK	REVISIONS	DATE
			0	RELEASED FOR APPROVAL	Nov 18 2025
			1	RELEASED FOR RE-APPROVAL	Jul 13 2026
			2	RELEASED FOR RE-APPROVAL	Aug 26 2026

STRUCTURE:- PINELLAS SUNCOAST TRANSIT AUTHORITY
LOCATION:- CLEARWATER STATION,CLEARWATER,FL.
DETAILER:- VECTORSHADES LLC
CUSTOMER:- KOKOLAKIS
ARCH./ENG.:- CDM SMITH
DESCRIPTION:- WAVE CANOPY VERTICAL BRACE DETAIL
DRAWN:- PBI DATE:- 10-27-2025 CHK.D:- RAG DATE:- 10-27-2025

SHOP BILL	WORK ORDER NO.	DRWG. NO.
	2553	1511

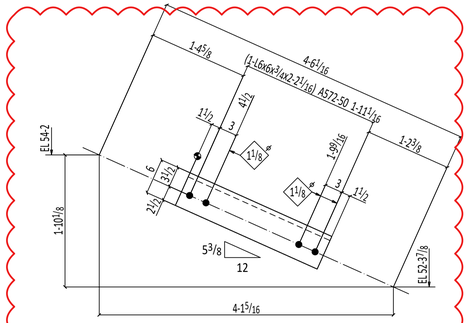

6 VERTICAL BRACES 1512VB -G

SHOP NOTE:
TOE DIRECTION FAR SIDE

SHIPPING LIST

MATERIAL BILL

ITEM NO	TOTAL QTY	DESCRIPTION	MAJOR MARK	PAINT CODE	TOTAL WEIGHT	ABM NO	UNIT QTY	LENGTH FT.	LENGTH IN.	MINOR MARK	REMARKS	UNIT WEIGHT	GRADE
	6	VERTICAL BRACE	1512VB	G	374						Galv	62	
	6	L6x6x³/₄			374		1	2	2¹/₁₆	1512VB		62	A572-50
		FIELD BOLTS											
	24	1 Dia A325N						0	2³/₄		+1HD WASH		

Total weight : 374

REFERENCE :----

PAGE TOTALS

REVISION NO.

SPECIAL NOTES:-

MATERIAL:-
ASTM: A36 U.N.O.
S. S.: -----
ALUM.: -----
PIPE: A53 GR.B
TUBES: A500 GR.B
HOLES: 13/16 U.N.O
WELDING: E70XX

MATERIAL PREP.:-
CLEAN: SSPC-SP2
SHOP PAINT: TWO COAT OF STD SHOP PRIMER
GALV: GALVANIZED & PAINTED

GEN. NOTES:-
BUY AMERICAN:
DOMESTIC:
CERT/CONFORMANCE:
CERT/COMPLIANCE:

ALL WIDE FLANGE SHAPES TO BE PER A992-G50

FIELD CONNECTIONS :
HOLES : 13/16" U.N.O
PAINT :

morrow steel Fabricators, Inc.

3620 COPELAND DRIVE
ZEPHYRHILLS, FL. 33542

	PRINTS FOR	DATE	MK	REVISIONS	DATE
			0	RELEASED FOR APPROVAL	Nov 18 2025
			1	RELEASED FOR RE-APPROVAL	Jul 13 2026
			2	RELEASED FOR RE-APPROVAL	Aug 26 2026

STRUCTURE:-PINELLAS SUNCOAST TRANSIT AUTHORITY
LOCATION:- CLEARWATER STATION,CLEARWATER,FL.
DETAILER:- VECTORSHADES LLC
CUSTOMER:- KOKOLAKIS
ARCH./ENG.:- CDM SMITH
DESCRIPTION:- WAVE CANOPY VERTICAL BRACE DETAIL
DRAWN:- PBI DATE:- 10-27-2025 CHK.D:- RAG DATE:- 10-27-2025

SHOP BILL	WORK ORDER NO.	DRWG. NO.
	2553	1512 ⚠1

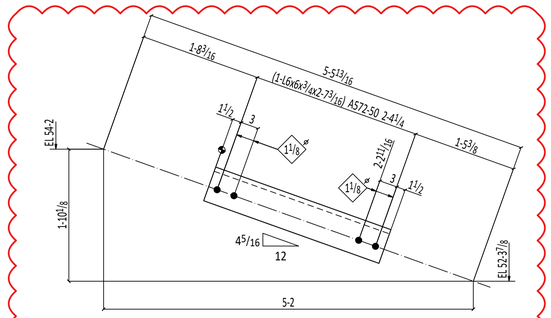

ONE VERTICAL BRACE 1513VB-G

SHOP NOTE:
TOE DIRECTION FAR SIDE

AESS CATEGORY-3

SHIPPING LIST

MATERIAL BILL

ITEM NO	TOTAL QTY	DESCRIPTION	MAJOR MARK	PAINT CODE	TOTAL WEIGHT	ABM NO	UNIT QTY	LENGTH FT.	LENGTH IN.	MINOR MARK	REMARKS	UNIT WEIGHT	GRADE
	ONE	VERTICAL BRACE	1513VB	G	75						Galv	75	
	1	L6x6x3/4			75		1	2	7 3/16	1513VB		75	A572-50
		FIELD BOLTS											
	4	1 Dia A325N						0	2 3/4		+1HD WASH		

Total weight : 75

REFERENCE :----

PAGE TOTALS

REVISION NO.

SPECIAL NOTES:-

MATERIAL:-
ASTM: A36 U.N.O.
S. S.: -----
ALUM.: -----
PIPE: A53 GR.B
TUBES: A500 GR.B
HOLES: 13/16 U.N.O
WELDING: E70XX

MATERIAL PREP.:-
CLEAN: SSPC-SP2
SHOP PAINT: TWO COAT OF STD SHOP PRIMER
GALV: GALVANIZED & PAINTED

GEN. NOTES:-
BUY AMERICAN:
DOMESTIC:
CERT/CONFORMANCE:
CERT/COMPLIANCE:

ALL WIDE FLANGE SHAPES TO BE PER A992-G50

FIELD CONNECTIONS :
HOLES : 13/16" U.N.O
PAINT :

morrow steel Fabricators, Inc.

3620 COPELAND DRIVE
ZEPHYRHILLS, FL. 33542

PRINTS FOR	DATE	MK	REVISIONS	DATE
		0	RELEASED FOR APPROVAL	Nov 18 2025
		1	RELEASED FOR RE-APPROVAL	Jul 13 2026
		2	RELEASED FOR RE-APPROVAL	Aug 26 2026

STRUCTURE:- PINELLAS SUNCOAST TRANSIT AUTHORITY
LOCATION:- CLEARWATER STATION,CLEARWATER,FL.
DETAILER:- VECTORSHADES LLC.
CUSTOMER:- KOKOLAKIS
ARCH./ENG.:- CDM SMITH
DESCRIPTION:- WAVE CANOPY VERTICAL BRACE DETAIL
DRAWN:- PBI DATE:-10-27-2025 CHK.D:-RAG DATE:- 10-27-2025

SHOP BILL	WORK ORDER NO.	DRWG. NO.
	2553	1513

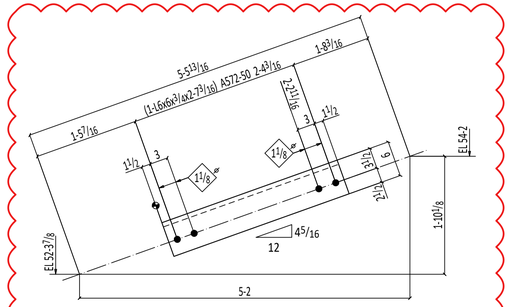

ONE VERTICAL BRACE 1514VB -G

SHOP NOTE:
TOE DIRECTION FAR SIDE

AESS CATEGORY-3

SHIPPING LIST

MATERIAL BILL

ITEM NO	TOTAL QTY	DESCRIPTION	MAJOR MARK	PAINT CODE	TOTAL WEIGHT	ABM NO	UNIT QTY	LENGTH FT.	LENGTH IN.	MINOR MARK	REMARKS	UNIT WEIGHT	GRADE
	ONE	VERTICAL BRACE	1514VB	G	75						Galv	75	
	1	L6x6x3/4			75		1	2	7 3/16	1514VB		75	A572-50
		FIELD BOLTS											
	4	1 Dia A325N						0	2 3/4		+1HD WASH		

Total weight : 75

REFERENCE :----

PAGE TOTALS

REVISION NO.

SPECIAL NOTES:-

MATERIAL:-
ASTM: A36 U.N.O.
S. S.: -----
ALUM.: -----
PIPE: A53 GR.B
TUBES: A500 GR.B
HOLES: 13/16 U.N.O
WELDING: E70XX

MATERIAL PREP.:-
CLEAN: SSPC-SP2
SHOP PAINT: TWO COAT OF STD SHOP PRIMER
GALV: GALVANIZED & PAINTED

GEN. NOTES:-
BUY AMERICAN:
DOMESTIC:
CERT/CONFORMANCE:
CERT/COMPLIANCE:

ALL WIDE FLANGE SHAPES TO BE PER A992-G50

FIELD CONNECTIONS :
HOLES : 13/16" U.N.O
PAINT :

morrow steel Fabricators, Inc.

3620 COPELAND DRIVE
ZEPHYRHILLS, FL. 33542

	PRINTS FOR	DATE	MK	REVISIONS	DATE
			0	RELEASED FOR APPROVAL	Nov 18 2025
			1	RELEASED FOR RE-APPROVAL	Jul 13 2026
			2	RELEASED FOR RE-APPROVAL	Aug 26 2026

STRUCTURE:- PINELLAS SUNCOAST TRANSIT AUTHORITY
LOCATION:- CLEARWATER STATION,CLEARWATER,FL.
DETAILER:- VECTORSHADES LLC
CUSTOMER:- KOKOLAKIS
ARCH./ENG.:- CDM SMITH
DESCRIPTION:- WAVE CANOPY VERTICAL BRACE DETAIL
DRAWN:- PBI DATE:- 10-27-2025 CHK.D:- RAG DATE:- 10-27-2025

SHOP BILL	WORK ORDER NO.	DRWG. NO.
	2553	1514 1

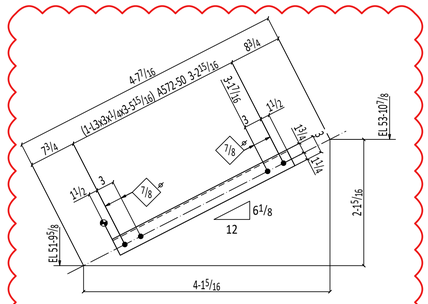

12 VERTICAL BRACES 1515VB -G

SHOP NOTE:
TOE DIRECTION FAR SIDE

SHIPPING LIST

MATERIAL BILL

ITEM NO	TOTAL QTY	DESCRIPTION	MAJOR MARK	PAINT CODE	TOTAL WEIGHT	ABM NO	UNIT QTY	LENGTH FT.	LENGTH IN.	MINOR MARK	REMARKS	UNIT WEIGHT	GRADE
	12	VERTICAL BRACE	1515VB	G	205						Galv	17	
	12	L3x3x1/4			205		1	3	5 15/16	1515VB		17	A572-50
		FIELD BOLTS											
	46	3/4 Dia A325N						0	1 3/4		+1HD WASH		
	2	3/4 Dia A325N						0	1 3/4		+1HD WASH GALV		

Total weight : 205

REFERENCE :----

PAGE TOTALS

REVISION NO.

SPECIAL NOTES:-

MATERIAL:-
ASTM: A36 U.N.O.
S. S.: -----
ALUM.: -----
PIPE: A53 GR.B
TUBES: A500 GR.B
HOLES: 13/16 U.N.O
WELDING: E70XX

MATERIAL PREP.:-
CLEAN: SSPC-SP2
SHOP PAINT: TWO COAT OF STD SHOP PRIMER
GALV: GALVANIZED & PAINTED

GEN. NOTES:-
BUY AMERICAN:
DOMESTIC:
CERT/CONFORMANCE:
CERT/COMPLIANCE:

ALL WIDE FLANGE SHAPES TO BE PER A992-G50

FIELD CONNECTIONS :
HOLES : 13/16" U.N.O
PAINT :

morrow steel Fabricators, Inc.

3620 COPELAND DRIVE
ZEPHYRHILLS, FL. 33542

PRINTS FOR	DATE	MK	REVISIONS	DATE
		0	RELEASED FOR APPROVAL	Nov 18 2025
		1	RELEASED FOR RE-APPROVAL	Jul 13 2026
		2	RELEASED FOR RE-APPROVAL	Aug 26 2026

STRUCTURE:-PINELLAS SUNCOAST TRANSIT AUTHORITY
LOCATION:- CLEARWATER STATION,CLEARWATER,FL.
DETAILER:- VECTORSHADES LLC
CUSTOMER:- KOKOLAKIS
ARCH./ENG.:- CDM SMITH
DESCRIPTION:-WAVE CANOPY VERTICAL BRACE DETAIL
DRAWN:- PBI DATE:-10-27-2025 CHK.D:-RAG DATE:- 10-27-2025

SHOP BILL	WORK ORDER NO.	DRWG. NO.
	2553	1515

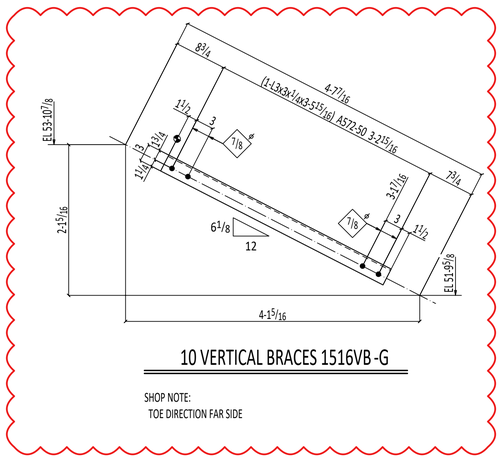

10 VERTICAL BRACES 1516VB -G

SHOP NOTE:
TOE DIRECTION FAR SIDE

SHIPPING LIST

MATERIAL BILL

ITEM NO	TOTAL QTY	DESCRIPTION	MAJOR MARK	PAINT CODE	TOTAL WEIGHT	ABM NO	UNIT QTY	LENGTH FT.	LENGTH IN.	MINOR MARK	REMARKS	UNIT WEIGHT	GRADE
	10	VERTICAL BRACE	1516VB	G	171						Galv	17	
	10	L3x3x1/4			171		1	3	5 15/16	1516VB		17	A572-50
		FIELD BOLTS											
	34	3/4 Dia A325N						0	1 3/4		+1HD WASH		
	6	3/4 Dia A325N						0	1 3/4		+1HD WASH GALV		

Total weight : 171

REFERENCE :----

PAGE TOTALS

REVISION NO.

SPECIAL NOTES:-

MATERIAL:-
ASTM: A36 U.N.O.
S. S.: -----
ALUM.: -----
PIPE: A53 GR.B
TUBES: A500 GR.B
HOLES: 13/16 U.N.O
WELDING: E70XX

MATERIAL PREP.:-
CLEAN: SSPC-SP2
SHOP PAINT: TWO COAT OF STD SHOP PRIMER
GALV: GALVANIZED & PAINTED

GEN. NOTES:-
BUY AMERICAN:
DOMESTIC:
CERT/CONFORMANCE:
CERT/COMPLIANCE:

ALL WIDE FLANGE SHAPES TO BE PER A992-G50

FIELD CONNECTIONS :
HOLES : 13/16" U.N.O
PAINT :

morrow steel Fabricators, Inc.

3620 COPELAND DRIVE
ZEPHYRHILLS, FL. 33542

	PRINTS FOR	DATE	MK	REVISIONS	DATE
			0	RELEASED FOR APPROVAL	Nov 18 2025
			1	RELEASED FOR RE-APPROVAL	Jul 13 2026
			2	RELEASED FOR RE-APPROVAL	Aug 26 2026

STRUCTURE:- PINELLAS SUNCOAST TRANSIT AUTHORITY
LOCATION:- CLEARWATER STATION,CLEARWATER,FL.
DETAILER:- VECTORSHADES LLC
CUSTOMER:- KOKOLAKIS
ARCH./ENG.:- CDM SMITH
DESCRIPTION:- WAVE CANOPY VERTICAL BRACE DETAIL
DRAWN:- PBI DATE:- 10-27-2025 CHK.D:- RAG DATE:- 10-27-2025

SHOP BILL	WORK ORDER NO.	DRWG. NO.
	2553	1516

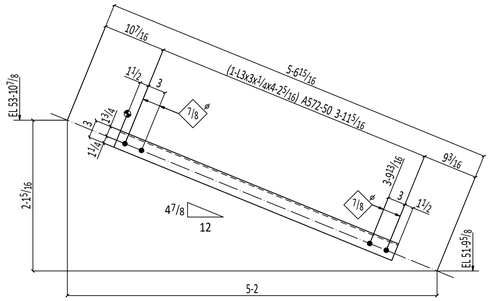

2 VERTICAL BRACES 1517VB -G

SHOP NOTE:
TOE DIRECTION FAR SIDE

AESS CATEGORY-3

SHIPPING LIST

MATERIAL BILL

ITEM NO	TOTAL QTY	DESCRIPTION	MAJOR MARK	PAINT CODE	TOTAL WEIGHT	ABM NO	UNIT QTY	LENGTH FT.	LENGTH IN.	MINOR MARK	REMARKS	UNIT WEIGHT	GRADE
	2	VERTICAL BRACE	1517VB	G	41						Galv	21	
	2	L3x3x1/4			41		1	4	25/16	1517VB		21	A572-50
		FIELD BOLTS											
	8	3/4 Dia A325N						0	13/4		+1HD WASH		

Total weight : 41

REFERENCE :----

PAGE TOTALS

REVISION NO.

SPECIAL NOTES:-

MATERIAL:-

ASTM: A36 U.N.O.
S. S.: -----
ALUM.: -----
PIPE: A53 GR.B
TUBES: A500 GR.B
HOLES: 13/16 U.N.O
WELDING: E70XX

MATERIAL PREP.:-

CLEAN: SSPC-SP2
SHOP PAINT: TWO COAT OF STD SHOP PRIMER
GALV: GALVANIZED & PAINTED

GEN. NOTES:-

BUY AMERICAN:
DOMESTIC:
CERT/CONFORMANCE:
CERT/COMPLIANCE:

ALL WIDE FLANGE SHAPES TO BE PER A992-G50

FIELD CONNECTIONS :
HOLES : 13/16" U.N.O
PAINT :

morrow steel Fabricators, Inc.

3620 COPELAND DRIVE
ZEPHYRHILLS, FL. 33542

	PRINTS FOR	DATE	MK	REVISIONS	DATE
			0	RELEASED FOR APPROVAL	Nov 18 2025
			1	RELEASED FOR RE-APPROVAL	Jul 13 2026
			2	RELEASED FOR RE-APPROVAL	Aug 26 2026

STRUCTURE:- PINELLAS SUNCOAST TRANSIT AUTHORITY
LOCATION:- CLEARWATER STATION,CLEARWATER,FL.
DETAILER:- VECTORSHADES LLC
CUSTOMER:- KOKOLAKIS
ARCH./ENG.:- CDM SMITH
DESCRIPTION:- WAVE CANOPY VERTICAL BRACE DETAIL
DRAWN:- PBI DATE:-10-27-2025 CHK.D.-RAG DATE:- 10-27-2025

SHOP BILL	WORK ORDER NO.	DRWG. NO.
	2553	1517

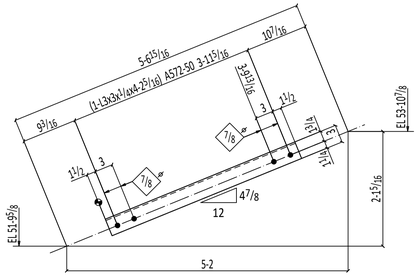

ONE VERTICAL BRACE 1518VB-G

SHOP NOTE:
TOE DIRECTION FAR SIDE

AESS CATEGORY-3

SHIPPING LIST / MATERIAL BILL

ITEM NO	TOTAL QTY	DESCRIPTION	MAJOR MARK	PAINT CODE	TOTAL WEIGHT	ABM NO	UNIT QTY	LENGTH FT.	LENGTH IN.	MINOR MARK	REMARKS	UNIT WEIGHT	GRADE
	ONE	VERTICAL BRACE	1518VB	G	21						Galv	21	
	1	L3x3x1/4			21		1	4	25/16	1518VB		21	A572-50
		FIELD BOLTS											
	4	3/4 Dia A325N						0	13/4		+1HD WASH		

Total weight : 21

REFERENCE :----

PAGE TOTALS | REVISION NO.

SPECIAL NOTES:-

MATERIAL:-
ASTM: A36 U.N.O.
S. S.: -----
ALUM.: -----
PIPE: A53 GR.B
TUBES: A500 GR.B
HOLES: 13/16 U.N.O
WELDING: E70XX

MATERIAL PREP.:-
CLEAN: SSPC-SP2
SHOP PAINT: TWO COAT OF STD SHOP PRIMER
GALV: GALVANIZED & PAINTED

GEN. NOTES:-
BUY AMERICAN:
DOMESTIC:
CERT/CONFORMANCE:
CERT/COMPLIANCE:

ALL WIDE FLANGE SHAPES TO BE PER A992-G50

FIELD CONNECTIONS :
HOLES : 13/16" U.N.O
PAINT :

morrow steel Fabricators, Inc.

3620 COPELAND DRIVE
ZEPHYRHILLS, FL. 33542

	PRINTS FOR	DATE	MK	REVISIONS	DATE
			0	RELEASED FOR APPROVAL	Nov 18 2025
			1	RELEASED FOR RE-APPROVAL	Jul 13 2026
			2	RELEASED FOR RE-APPROVAL	Aug 26 2026

STRUCTURE:-PINELLAS SUNCOAST TRANSIT AUTHORITY
LOCATION:- CLEARWATER STATION,CLEARWATER,FL.
DETAILER:- VECTORSHADES LLC
CUSTOMER:- KOKOLAKIS
ARCH./ENG.:- CDM SMITH
DESCRIPTION:-WAVE CANOPY VERTICAL BRACE DETAIL
DRAWN:- PBI DATE:-10-27-2025 CHK.D:-RAG DATE:- 10-27-2025

SHOP BILL	WORK ORDER NO.	DRWG. NO.
	2553	1518

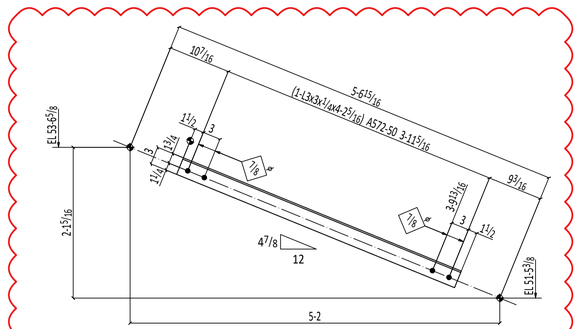

2 VERTICAL BRACES 1519VB -G

SHOP NOTE:
TOE DIRECTION NEAR SIDE

AESS CATEGORY-3

SHIPPING LIST

MATERIAL BILL

ITEM NO	TOTAL QTY	DESCRIPTION	MAJOR MARK	PAINT CODE	TOTAL WEIGHT	ABM NO	UNIT QTY	LENGTH FT.	LENGTH IN.	MINOR MARK	REMARKS	UNIT WEIGHT	GRADE
	2	VERTICAL BRACE	1519VB	G	41						Galv	21	
	2	L3x3x1/4			41		1	4	25/16	1519VB		21	A572-50
		FIELD BOLTS											
	6	3/4 Dia A325N						0	1 3/4		+1HD WASH		
	2	3/4 Dia A325N						0	1 3/4		+1HD WASH GALV		

Total weight : 41

REFERENCE :----

PAGE TOTALS

REVISION NO.

SPECIAL NOTES:-

MATERIAL:-

ASTM:	A36 U.N.O.
S. S.:	-----
ALUM.:	-----
PIPE:	A53 GR.B
TUBES:	A500 GR.B
HOLES:	13/16 U.N.O
WELDING:	E70XX

MATERIAL PREP.:-

CLEAN:	SSPC-SP2
SHOP PAINT:	TWO COAT OF STD SHOP PRIMER
GALV:	GALVANIZED & PAINTED

GEN. NOTES:-

BUY AMERICAN:	
DOMESTIC:	
CERT/CONFORMANCE:	
CERT/COMPLIANCE:	

ALL WIDE FLANGE SHAPES TO BE PER A992-G50

FIELD CONNECTIONS :
HOLES : 13/16" U.N.O
PAINT :

morrow steel Fabricators, Inc.

3620 COPELAND DRIVE
ZEPHYRHILLS, FL. 33542

	PRINTS FOR	DATE	MK	REVISIONS	DATE
			0	RELEASED FOR APPROVAL	Nov 18 2025
			1	RELEASED FOR RE-APPROVAL	Jul 13 2026
			2	RELEASED FOR RE-APPROVAL	Aug 26 2026

STRUCTURE:-PINELLAS SUNCOAST TRANSIT AUTHORITY
LOCATION:- CLEARWATER STATION,CLEARWATER,FL.
DETAILER:- VECTORSHADES LLC
CUSTOMER:- KOKOLAKIS
ARCH./ENG.:- CDM SMITH
DESCRIPTION:-WAVE CANOPY VERTICAL BRACE DETAIL
DRAWN:- PBI DATE:-10-27-2025 CHK.D:-RAG DATE:- 10-27-2025

SHOP BILL	WORK ORDER NO.	DRWG. NO.
	2553	1519 1

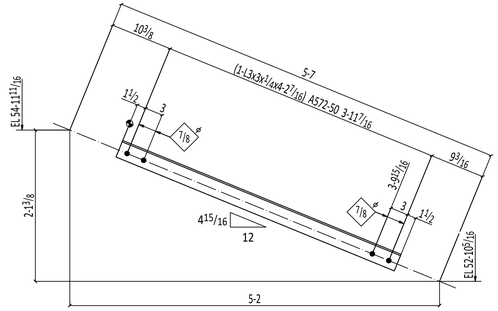

ONE VERTICAL BRACE 1520VB -G

SHOP NOTE:
TOE DIRECTION NEAR SIDE

AESS CATEGORY-3

SHIPPING LIST

MATERIAL BILL

ITEM NO	TOTAL QTY	DESCRIPTION	MAJOR MARK	PAINT CODE	TOTAL WEIGHT	ABM NO	UNIT QTY	LENGTH FT.	LENGTH IN.	MINOR MARK	REMARKS	UNIT WEIGHT	GRADE
	ONE	VERTICAL BRACE	1520VB	G	21						Galv	21	
	1	L3x3x1/4			21		1	4	27/16	1520VB		21	A572-50
		FIELD BOLTS											
	4	3/4 Dia A325N						0	13/4		+1HD WASH		

Total weight : 21

REFERENCE :----

PAGE TOTALS

REVISION NO.

SPECIAL NOTES:-

MATERIAL:-

ASTM: A36 U.N.O.
S. S.: -----
ALUM.: -----
PIPE: A53 GR.B
TUBES: A500 GR.B
HOLES: 13/16 U.N.O
WELDING: E70XX

MATERIAL PREP.:-

CLEAN: SSPC-SP2
SHOP PAINT: TWO COAT OF STD SHOP PRIMER
GALV: GALVANIZED & PAINTED

GEN. NOTES:-

BUY AMERICAN:
DOMESTIC:
CERT/CONFORMANCE:
CERT/COMPLIANCE:

ALL WIDE FLANGE SHAPES TO BE PER A992-G50

FIELD CONNECTIONS :
HOLES : 13/16" U.N.O
PAINT :

morrow steel Fabricators, Inc.

3620 COPELAND DRIVE
ZEPHYRHILLS, FL. 33542

	PRINTS FOR	DATE	MK	REVISIONS	DATE
			0	RELEASED FOR APPROVAL	Nov 18 2025
			1	RELEASED FOR RE-APPROVAL	Jul 13 2026
			2	RELEASED FOR RE-APPROVAL	Aug 26 2026

STRUCTURE:- PINELLAS SUNCOAST TRANSIT AUTHORITY
LOCATION:- CLEARWATER STATION,CLEARWATER,FL.
DETAILER:- VECTORSHADES LLC
CUSTOMER:- KOKOLAKIS
ARCH./ENG.:- CDM SMITH
DESCRIPTION:- WAVE CANOPY VERTICAL BRACE DETAIL
DRAWN:- PBI DATE:-10-27-2025 CHK.D.-RAG DATE:- 10-27-2025

SHOP BILL	WORK ORDER NO.	DRWG. NO.
	2553	1520

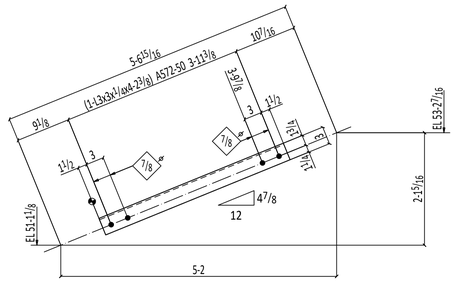

ONE VERTICAL BRACE 1522VB-G

SHOP NOTE:
TOE DIRECTION FAR SIDE

AESS CATEGORY-3

SHIPPING LIST

MATERIAL BILL

ITEM NO	TOTAL QTY	DESCRIPTION	MAJOR MARK	PAINT CODE	TOTAL WEIGHT	ABM NO	UNIT QTY	LENGTH FT.	LENGTH IN.	MINOR MARK	REMARKS	UNIT WEIGHT	GRADE
	ONE	VERTICAL BRACE	1522VB	G	21						Galv	21	
	1	L3x3x1/4			21		1	4	2 3/8	1522VB		21	A572-50
		FIELD BOLTS											
	4	3/4 Dia A325N						0	1 3/4		+1HD WASH		

Total weight : 21

REFERENCE :----

PAGE TOTALS

REVISION NO.

SPECIAL NOTES:-

MATERIAL:-
ASTM: A36 U.N.O.
S. S.: -----
ALUM.: -----
PIPE: A53 GR.B
TUBES: A500 GR.B
HOLES: 13/16 U.N.O
WELDING: E70XX

MATERIAL PREP.:-
CLEAN: SSPC-SP2
SHOP PAINT: TWO COAT OF STD SHOP PRIMER
GALV: GALVANIZED & PAINTED

GEN. NOTES:-
BUY AMERICAN:
DOMESTIC:
CERT/CONFORMANCE:
CERT/COMPLIANCE:

ALL WIDE FLANGE SHAPES TO BE PER A992-G50

FIELD CONNECTIONS :
HOLES : 13/16" U.N.O
PAINT :

morrow steel Fabricators, Inc.

3620 COPELAND DRIVE
ZEPHYRHILLS, FL. 33542

	PRINTS FOR	DATE	MK	REVISIONS	DATE
			0	RELEASED FOR APPROVAL	Nov 18 2025
			1	RELEASED FOR RE-APPROVAL	Jul 13 2026
			2	RELEASED FOR RE-APPROVAL	Aug 26 2026

STRUCTURE:- PINELLAS SUNCOAST TRANSIT AUTHORITY
LOCATION:- CLEARWATER STATION,CLEARWATER,FL.
DETAILER:- VECTORSHADES LLC
CUSTOMER:- KOKOLAKIS
ARCH./ENG.:- CDM SMITH
DESCRIPTION:- WAVE CANOPY VERTICAL BRACE DETAIL
DRAWN:- PBI DATE:- 10-27-2025 CHK.D:- RAG DATE:- 10-27-2025

SHOP BILL	WORK ORDER NO.	DRWG. NO.
	2553	1522 1

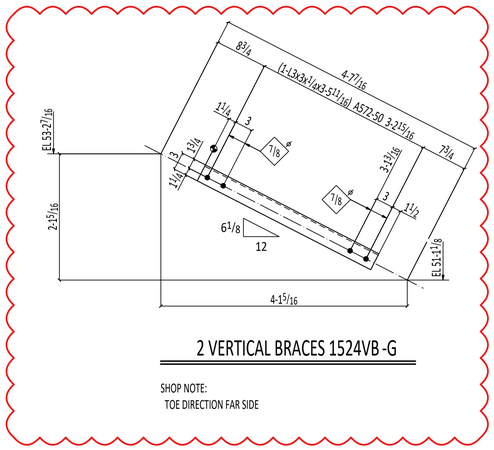

2 VERTICAL BRACES 1524VB -G

SHOP NOTE:
TOE DIRECTION FAR SIDE

SHIPPING LIST

MATERIAL BILL

ITEM NO	TOTAL QTY	DESCRIPTION	MAJOR MARK	PAINT CODE	TOTAL WEIGHT	ABM NO	UNIT QTY	LENGTH FT.	LENGTH IN.	MINOR MARK	REMARKS	UNIT WEIGHT	GRADE
	2	VERTICAL BRACE	1524VB	G	34						Galv	17	
	2	L3x3x1/4			34		1	3	5 11/16	1524VB		17	A572-50
		FIELD BOLTS											
	8	3/4 Dia A325N						0	1 3/4		+1HD WASH		

Total weight : 34

REFERENCE :----

PAGE TOTALS

REVISION NO.

SPECIAL NOTES:-

MATERIAL:-
ASTM: A36 U.N.O.
S. S.: -----
ALUM.: -----
PIPE: A53 GR.B
TUBES: A500 GR.B
HOLES: 13/16 U.N.O
WELDING: E70XX

MATERIAL PREP.:-
CLEAN: SSPC-SP2
SHOP PAINT: TWO COAT OF STD SHOP PRIMER
GALV: GALVANIZED & PAINTED

GEN. NOTES:-
BUY AMERICAN:
DOMESTIC:
CERT/CONFORMANCE:
CERT/COMPLIANCE:

ALL WIDE FLANGE SHAPES TO BE PER A992-G50

FIELD CONNECTIONS :
HOLES : 13/16" U.N.O
PAINT :

morrow steel Fabricators, Inc.

3620 COPELAND DRIVE
ZEPHYRHILLS, FL. 33542

	PRINTS FOR	DATE	MK	REVISIONS	DATE
			0	RELEASED FOR APPROVAL	Nov 18 2025
			1	RELEASED FOR RE-APPROVAL	Jul 13 2026
			2	RELEASED FOR RE-APPROVAL	Aug 26 2026

STRUCTURE:-PINELLAS SUNCOAST TRANSIT AUTHORITY
LOCATION:- CLEARWATER STATION,CLEARWATER,FL.
DETAILER:- VECTORSHADES LLC
CUSTOMER:- KOKOLAKIS
ARCH./ENG.:- CDM SMITH
DESCRIPTION:-WAVE CANOPY VERTICAL BRACE DETAIL
DRAWN:- PBI DATE:-10-27-2025 CHK.D:-RAG DATE:- 10-27-2025

SHOP BILL	WORK ORDER NO.	DRWG. NO.
	2553	1524

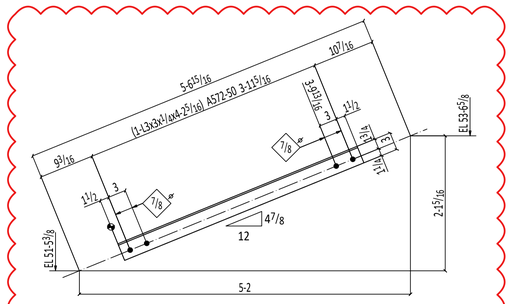

2 VERTICAL BRACES 1525VB -G

SHOP NOTE:
TOE DIRECTION NEAR SIDE

AESS CATEGORY-3

SHIPPING LIST

MATERIAL BILL

ITEM NO	TOTAL QTY	DESCRIPTION	MAJOR MARK	PAINT CODE	TOTAL WEIGHT	ABM NO	UNIT QTY	LENGTH FT.	LENGTH IN.	MINOR MARK	REMARKS	UNIT WEIGHT	GRADE
	2	VERTICAL BRACE	1525VB	G	41						Galv	21	
	2	L3x3x1/4			41		1	4	2 5/16	1525VB		21	A572-50
		FIELD BOLTS											
	6	3/4 Dia A325N						0	1 3/4		+1HD WASH		
	2	3/4 Dia A325N						0	1 3/4		+1HD WASH GALV		

Total weight : 41

REFERENCE :----

PAGE TOTALS

REVISION NO.

SPECIAL NOTES:-

MATERIAL:-

ASTM: A36 U.N.O.
S. S.: -----
ALUM.: -----
PIPE: A53 GR.B
TUBES: A500 GR.B
HOLES: 13/16 U.N.O
WELDING: E70XX

MATERIAL PREP.:-

CLEAN: SSPC-SP2
SHOP PAINT: TWO COAT OF STD SHOP PRIMER
GALV: GALVANIZED & PAINTED

GEN. NOTES:-

BUY AMERICAN:
DOMESTIC:
CERT/CONFORMANCE:
CERT/COMPLIANCE:

ALL WIDE FLANGE SHAPES TO BE PER A992-G50

FIELD CONNECTIONS :
HOLES : 13/16" U.N.O
PAINT :

morrow steel Fabricators, Inc.

3620 COPELAND DRIVE
ZEPHYRHILLS, FL. 33542

	PRINTS FOR	DATE	MK	REVISIONS	DATE
			0	RELEASED FOR APPROVAL	Nov 18 2025
			1	RELEASED FOR RE-APPROVAL	Jul 13 2026
			2	RELEASED FOR RE-APPROVAL	Aug 26 2026

STRUCTURE:- PINELLAS SUNCOAST TRANSIT AUTHORITY
LOCATION:- CLEARWATER STATION,CLEARWATER,FL.
DETAILER:- VECTORSHADES LLC
CUSTOMER:- KOKOLAKIS
ARCH./ENG.:- CDM SMITH
DESCRIPTION:- WAVE CANOPY VERTICAL BRACE DETAIL
DRAWN:- PBI DATE:- 10-27-2025 CHK.D:- RAG DATE:- 10-27-2025

SHOP BILL	WORK ORDER NO.	DRWG. NO.
	2553	1525 1

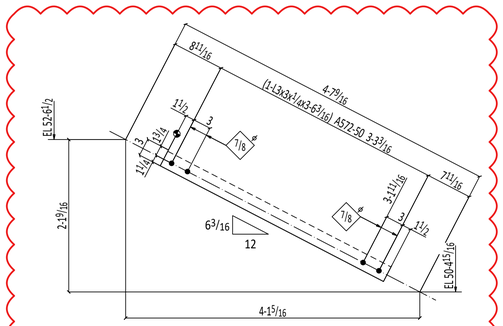

6 VERTICAL BRACES 1526VB -G

SHOP NOTE:
TOE DIRECTION FAR SIDE

SHIPPING LIST

MATERIAL BILL

ITEM NO	TOTAL QTY	DESCRIPTION	MAJOR MARK	PAINT CODE	TOTAL WEIGHT	ABM NO	UNIT QTY	LENGTH FT.	LENGTH IN.	MINOR MARK	REMARKS	UNIT WEIGHT	GRADE
	6	VERTICAL BRACE	1526VB	G	103						Galv	17	
	6	L3x3x1/4			103		1	3	6 3/16	1526VB		17	A572-50
		FIELD BOLTS											
	24	3/4 Dia A325N						0	1 3/4		+1HD WASH		

Total weight : 103

REFERENCE :----

PAGE TOTALS

REVISION NO.

SPECIAL NOTES:-

MATERIAL:-
ASTM: A36 U.N.O.
S. S.: -----
ALUM.: -----
PIPE: A53 GR.B
TUBES: A500 GR.B
HOLES: 13/16 U.N.O
WELDING: E70XX

MATERIAL PREP.:-
CLEAN: SSPC-SP2
SHOP PAINT: TWO COAT OF STD SHOP PRIMER
GALV: GALVANIZED & PAINTED

GEN. NOTES:-
BUY AMERICAN:
DOMESTIC:
CERT/CONFORMANCE:
CERT/COMPLIANCE:

ALL WIDE FLANGE SHAPES TO BE PER A992-G50

FIELD CONNECTIONS :
HOLES : 13/16" U.N.O
PAINT :

morrow steel Fabricators, Inc.

3620 COPELAND DRIVE
ZEPHYRHILLS, FL. 33542

	PRINTS FOR	DATE	MK	REVISIONS	DATE
			0	RELEASED FOR APPROVAL	Nov 18 2025
			1	RELEASED FOR RE-APPROVAL	Jul 13 2026
			2	RELEASED FOR RE-APPROVAL	Aug 26 2026

STRUCTURE:- PINELLAS SUNCOAST TRANSIT AUTHORITY
LOCATION:- CLEARWATER STATION,CLEARWATER,FL.
DETAILER:- VECTORSHADES LLC
CUSTOMER:- KOKOLAKIS
ARCH./ENG.:- CDM SMITH
DESCRIPTION:- WAVE CANOPY VERTICAL BRACE DETAIL
DRAWN:- PBI DATE:- 10-27-2025 CHK.D:- RAG DATE:- 10-27-2025

SHOP BILL	WORK ORDER NO.	DRWG. NO.
	2553	1526

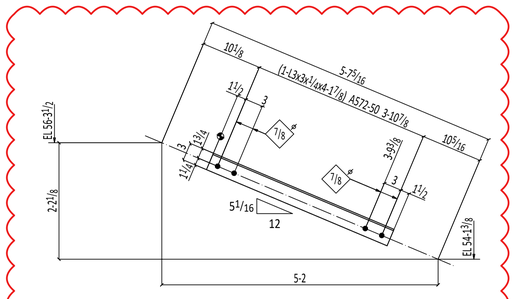

ONE VERTICAL BRACE 1528VB -G

SHOP NOTE:
TOE DIRECTION NEAR SIDE

AESS CATEGORY-3

SHIPPING LIST

MATERIAL BILL

ITEM NO	TOTAL QTY	DESCRIPTION	MAJOR MARK	PAINT CODE	TOTAL WEIGHT	ABM NO	UNIT QTY	LENGTH FT.	LENGTH IN.	MINOR MARK	REMARKS	UNIT WEIGHT	GRADE
	ONE	VERTICAL BRACE	1528VB	G	20						Galv	20	
	1	L3x3x1/4			20		1	4	17/8	1528VB		20	A572-50
		FIELD BOLTS											
	4	3/4 Dia A325N						0	13/4		+1HD WASH		

Total weight : 20

REFERENCE :----

PAGE TOTALS

REVISION NO.

SPECIAL NOTES:-

MATERIAL:-

ASTM: A36 U.N.O.
S. S.: -----
ALUM.: -----
PIPE: A53 GR.B
TUBES: A500 GR.B
HOLES: 13/16 U.N.O
WELDING: E70XX

MATERIAL PREP.:-

CLEAN: SSPC-SP2
SHOP PAINT: TWO COAT OF STD SHOP PRIMER
GALV: GALVANIZED & PAINTED

GEN. NOTES:-

BUY AMERICAN:
DOMESTIC:
CERT/CONFORMANCE:
CERT/COMPLIANCE:

ALL WIDE FLANGE SHAPES TO BE PER A992-G50

FIELD CONNECTIONS :
HOLES : 13/16" U.N.O
PAINT :

morrow steel Fabricators, Inc.

3620 COPELAND DRIVE
ZEPHYRHILLS, FL. 33542

	PRINTS FOR	DATE	MK	REVISIONS	DATE
			0	RELEASED FOR APPROVAL	Nov 18 2025
			1	RELEASED FOR RE-APPROVAL	Jul 13 2026
			2	RELEASED FOR RE-APPROVAL	Aug 26 2026

STRUCTURE:- PINELLAS SUNCOAST TRANSIT AUTHORITY
LOCATION:- CLEARWATER STATION,CLEARWATER,FL.
DETAILER:- VECTORSHADES LLC
CUSTOMER:- KOKOLAKIS
ARCH./ENG.:- CDM SMITH
DESCRIPTION:- WAVE CANOPY VERTICAL BRACE DETAIL
DRAWN:- PBI DATE:- 10-27-2025 CHK.D:- RAG DATE:- 10-27-2025

SHOP BILL	WORK ORDER NO.	DRWG. NO.
	2553	1528

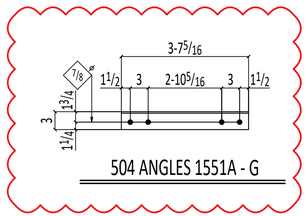

504 ANGLES 1551A - G

SHIPPING LIST

MATERIAL BILL

ITEM NO	TOTAL QTY	DESCRIPTION	MAJOR MARK	PAINT CODE	TOTAL WEIGHT	ABM NO	UNIT QTY	LENGTH FT.	LENGTH IN.	MINOR MARK	REMARKS	UNIT WEIGHT	GRADE
	504	ANGLE	1551A	G	8918						Galv	18	
	504	L3x3x1/4			8918		1	3	7 5/16	1551A		18	A572-50
		FIELD BOLTS											
	2016	3/4 Dia A325N						0	1 3/4		+1HD WASH		

Total weight : 8918

REFERENCE :----

PAGE TOTALS

REVISION NO.

SPECIAL NOTES:-

MATERIAL:-

ASTM: A36 U.N.O.
S. S.: -----
ALUM.: -----
PIPE: A53 GR.B
TUBES: A500 GR.B
HOLES: 13/16 U.N.O
WELDING: E70XX

MATERIAL PREP.:-

CLEAN: SSPC-SP2
SHOP PAINT: TWO COAT OF STD SHOP PRIMER
GALV: GALVANIZED & PAINTED

GEN. NOTES:-

BUY AMERICAN:
DOMESTIC:
CERT/CONFORMANCE:
CERT/COMPLIANCE:

ALL WIDE FLANGE SHAPES TO BE PER A992-G50

FIELD CONNECTIONS :
HOLES : 13/16" U.N.O
PAINT :

morrow steel Fabricators, Inc.

3620 COPELAND DRIVE
ZEPHYRHILLS, FL. 33542

	PRINTS FOR	DATE	MK	REVISIONS	DATE
			0	RELEASED FOR APPROVAL	Nov 18 2025
			1	RELEASED FOR RE-APPROVAL	Jul 13 2026
			2	RELEASED FOR RE-APPROVAL	Aug 26 2026

STRUCTURE:- PINELLAS SUNCOAST TRANSIT AUTHORITY
LOCATION:- CLEARWATER STATION,CLEARWATER,FL.
DETAILER:- VECTORSHADES LLC
CUSTOMER:- KOKOLAKIS
ARCH./ENG.:- CDM SMITH
DESCRIPTION:- WAVE CANOPY ANGLE DETAIL
DRAWN:- PBI DATE:- 10-27-2025 CHK.D:- RAG DATE:- 10-27-2025

SHOP BILL	WORK ORDER NO.	DRWG. NO.
	2553	1551 ⚠1

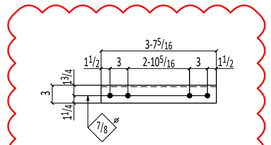

48 ANGLES 1552A-G

SHIPPING LIST

MATERIAL BILL

ITEM NO	TOTAL QTY	DESCRIPTION	MAJOR MARK	PAINT CODE	TOTAL WEIGHT	ABM NO	UNIT QTY	LENGTH FT.	LENGTH IN.	MINOR MARK	REMARKS	UNIT WEIGHT	GRADE
	48	ANGLE	1552A	G	849						Galv	18	
	48	L3x3x1/4			849		1	3	7 5/16	1552A		18	A572-50
		FIELD BOLTS											
	192	3/4 Dia A325N						0	1 3/4		+1HD WASH		

Total weight : 849

REFERENCE :----

PAGE TOTALS

REVISION NO.

SPECIAL NOTES:-

MATERIAL:-

ASTM: A36 U.N.O.
S. S.: -----
ALUM.: -----
PIPE: A53 GR.B
TUBES: A500 GR.B
HOLES: 13/16 U.N.O
WELDING: E70XX

MATERIAL PREP.:-

CLEAN: SSPC-SP2
SHOP PAINT: TWO COAT OF STD SHOP PRIMER
GALV: GALVANIZED & PAINTED

GEN. NOTES:-

BUY AMERICAN:
DOMESTIC:
CERT/CONFORMANCE:
CERT/COMPLIANCE:

ALL WIDE FLANGE SHAPES TO BE PER A992-G50

FIELD CONNECTIONS :
HOLES : 13/16" U.N.O
PAINT :

morrow steel Fabricators, Inc.

3620 COPELAND DRIVE
ZEPHYRHILLS, FL. 33542

	PRINTS FOR	DATE	MK	REVISIONS	DATE
			0	RELEASED FOR APPROVAL	Nov 18 2025
			1	RELEASED FOR RE-APPROVAL	Jul 13 2026
			2	RELEASED FOR RE-APPROVAL	Aug 26 2026

STRUCTURE:- PINELLAS SUNCOAST TRANSIT AUTHORITY
LOCATION:- CLEARWATER STATION,CLEARWATER,FL.
DETAILER:- VECTORSHADES LLC
CUSTOMER:- KOKOLAKIS
ARCH./ENG.:- CDM SMITH
DESCRIPTION:- WAVE CANOPY ANGLE DETAIL
DRAWN:- PBI DATE:- 10-27-2025 CHK.D:- RAG DATE:- 10-27-2025

SHOP BILL	WORK ORDER NO.	DRWG. NO.
	2553	1552

SHIPPING LIST

MATERIAL BILL

ITEM NO	TOTAL QTY	DESCRIPTION	MAJOR MARK	PAINT CODE	TOTAL WEIGHT	ABM NO	UNIT QTY	LENGTH FT.	LENGTH IN.	MINOR MARK	REMARKS	UNIT WEIGHT	GRADE
	128	ANGLE	1553A	G	2927						Galv	23	
	128	L3x3x1/4			2927		1	4	8	1553A		23	A572-50
		FIELD BOLTS											
	512	3/4 Dia A325N						0	1 3/4		+1HD WASH		

Total weight : 2927

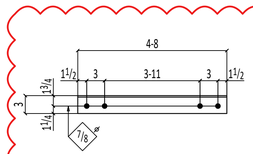

128 ANGLES 1553A-G

REFERENCE :----

PAGE TOTALS

REVISION NO.

SPECIAL NOTES:-

MATERIAL:-

ASTM: A36 U.N.O.
S. S.: -----
ALUM.: -----
PIPE: A53 GR.B
TUBES: A500 GR.B
HOLES: 13/16 U.N.O
WELDING: E70XX

MATERIAL PREP.:-

CLEAN: SSPC-SP2
SHOP PAINT: TWO COAT OF STD SHOP PRIMER
GALV: GALVANIZED & PAINTED

GEN. NOTES:-

BUY AMERICAN:
DOMESTIC:
CERT/CONFORMANCE:
CERT/COMPLIANCE:

ALL WIDE FLANGE SHAPES TO BE PER A992-G50

FIELD CONNECTIONS :
HOLES : 13/16" U.N.O
PAINT :

morrow steel Fabricators, Inc.

3620 COPELAND DRIVE
ZEPHYRHILLS, FL. 33542

	PRINTS FOR	DATE	MK	REVISIONS	DATE
			0	RELEASED FOR APPROVAL	Nov 18 2025
			1	RELEASED FOR RE-APPROVAL	Jul 13 2026
			2	RELEASED FOR RE-APPROVAL	Aug 26 2026

STRUCTURE:- PINELLAS SUNCOAST TRANSIT AUTHORITY
LOCATION:- CLEARWATER STATION,CLEARWATER,FL.
DETAILER:- VECTORSHADES LLC
CUSTOMER:- KOKOLAKIS
ARCH./ENG.:- CDM SMITH
DESCRIPTION:- WAVE CANOPY ANGLE DETAIL
DRAWN:- PBI DATE:- 10-27-2025 CHK.D:- RAG DATE:- 10-27-2025

SHOP BILL	WORK ORDER NO.	DRWG. NO.
	2553	1553

SHIPPING LIST

MATERIAL BILL

ITEM NO	TOTAL QTY	DESCRIPTION	MAJOR MARK	PAINT CODE	TOTAL WEIGHT	ABM NO	UNIT QTY	LENGTH FT.	LENGTH IN.	MINOR MARK	REMARKS	UNIT WEIGHT	GRADE
	45	ANGLE	1554A	G	1029						Galv	23	
	45	L3x3x1/4			1029		1	4	8	1554A		23	A572-50
		FIELD BOLTS											
	180	3/4 Dia A325N						0	13/4		+1HD WASH		

Total weight : 1029

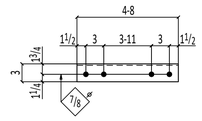

45 ANGLES 1554A-G

REFERENCE :----

PAGE TOTALS

REVISION NO.

SPECIAL NOTES:-

MATERIAL:-

ASTM: A36 U.N.O.
S. S.: -----
ALUM.: -----
PIPE: A53 GR.B
TUBES: A500 GR.B
HOLES: 13/16 U.N.O
WELDING: E70XX

MATERIAL PREP.:-

CLEAN: SSPC-SP2
SHOP PAINT: TWO COAT OF STD SHOP PRIMER
GALV: GALVANIZED & PAINTED

GEN. NOTES:-

BUY AMERICAN:
DOMESTIC:
CERT/CONFORMANCE:
CERT/COMPLIANCE:

ALL WIDE FLANGE SHAPES TO BE PER A992-G50

FIELD CONNECTIONS :
HOLES : 13/16" U.N.O
PAINT :

morrow steel Fabricators, Inc.

3620 COPELAND DRIVE
ZEPHYRHILLS, FL. 33542

	PRINTS FOR	DATE	MK	REVISIONS	DATE
			0	RELEASED FOR APPROVAL	Nov 18 2025
			1	RELEASED FOR RE-APPROVAL	Jul 13 2026
			2	RELEASED FOR RE-APPROVAL	Aug 26 2026

STRUCTURE:- PINELLAS SUNCOAST TRANSIT AUTHORITY
LOCATION:- CLEARWATER STATION,CLEARWATER,FL.
DETAILER:- VECTORSHADES LLC
CUSTOMER:- KOKOLAKIS
ARCH./ENG.:- CDM SMITH
DESCRIPTION:- WAVE CANOPY ANGLE DETAIL
DRAWN:- PBI DATE:-10-27-2025 CHK.D:-RAG DATE:- 10-27-2025

SHOP BILL	WORK ORDER NO.	DRWG. NO.
	2553	1554

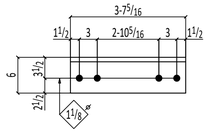

72 ANGLES 1555A -G

SHIPPING LIST

MATERIAL BILL

ITEM NO	TOTAL QTY	DESCRIPTION	MAJOR MARK	PAINT CODE	TOTAL WEIGHT	ABM NO	UNIT QTY	LENGTH FT.	LENGTH IN.	MINOR MARK	REMARKS	UNIT WEIGHT	GRADE
	72	ANGLE	1555A	G	7462						Galv	104	
	72	L6x6x3/4			7462		1	3	7⁵/₁₆	1555A		104	A572-50
		FIELD BOLTS											
	288	1 Dia A325N						0	2³/₄		+1HD WASH		

Total weight : 7462

REFERENCE :----

PAGE TOTALS

REVISION NO.

SPECIAL NOTES:-

MATERIAL:-

ASTM: A36 U.N.O.
S. S.: -----
ALUM.: -----
PIPE: A53 GR.B
TUBES: A500 GR.B
HOLES: 13/16 U.N.O
WELDING: E70XX

MATERIAL PREP.:-

CLEAN: SSPC-SP2
SHOP PAINT: TWO COAT OF STD SHOP PRIMER
GALV: GALVANIZED & PAINTED

GEN. NOTES:-

BUY AMERICAN:
DOMESTIC:
CERT/CONFORMANCE:
CERT/COMPLIANCE:

ALL WIDE FLANGE SHAPES TO BE PER A992-G50

FIELD CONNECTIONS :
HOLES : 13/16" U.N.O
PAINT :

morrow steel Fabricators, Inc.

3620 COPELAND DRIVE
ZEPHYRHILLS, FL. 33542

	PRINTS FOR	DATE	MK	REVISIONS	DATE
			0	RELEASED FOR APPROVAL	Nov 18 2025
			1	RELEASED FOR RE-APPROVAL	Jul 13 2026
			2	RELEASED FOR RE-APPROVAL	Aug 26 2026

STRUCTURE:-PINELLAS SUNCOAST TRANSIT AUTHORITY
LOCATION:- CLEARWATER STATION,CLEARWATER,FL.
DETAILER:- VECTORSHADES LLC
CUSTOMER:- KOKOLAKIS
ARCH./ENG.:- CDM SMITH
DESCRIPTION:- WAVE CANOPY ANGLE DETAIL
DRAWN:- PBI DATE:- 10-27-2025 CHK.D:- RAG DATE:- 10-27-2025

SHOP BILL	WORK ORDER NO.	DRWG. NO.
	2553	1555 ⚠1

SHIPPING LIST

MATERIAL BILL

ITEM NO	TOTAL QTY	DESCRIPTION	MAJOR MARK	PAINT CODE	TOTAL WEIGHT	ABM NO	UNIT QTY	LENGTH FT.	LENGTH IN.	MINOR MARK	REMARKS	UNIT WEIGHT	GRADE
	60	ANGLE	1556A	G	6218						Galv	104	
	60	L6x6x3/4			6218		1	3	7 5/16	1556A		104	A572-50
		FIELD BOLTS											
	240	1 Dia A325N						0	2 3/4		+1HD WASH		

Total weight : 6218

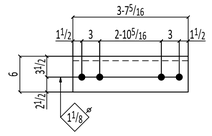

60 ANGLES 1556A-G

REFERENCE :----

PAGE TOTALS

REVISION NO.

SPECIAL NOTES:-

MATERIAL:-

ASTM: A36 U.N.O.
S. S.: -----
ALUM.: -----
PIPE: A53 GR.B
TUBES: A500 GR.B
HOLES: 13/16 U.N.O
WELDING: E70XX

MATERIAL PREP.:-

CLEAN: SSPC-SP2
SHOP PAINT: TWO COAT OF STD SHOP PRIMER
GALV: GALVANIZED & PAINTED

GEN. NOTES:-

BUY AMERICAN:
DOMESTIC:
CERT/CONFORMANCE:
CERT/COMPLIANCE:

ALL WIDE FLANGE SHAPES TO BE PER A992-G50

FIELD CONNECTIONS :
HOLES : 13/16" U.N.O
PAINT :

morrow steel Fabricators, Inc.

3620 COPELAND DRIVE
ZEPHYRHILLS, FL. 33542

	PRINTS FOR	DATE	MK	REVISIONS	DATE
			0	RELEASED FOR APPROVAL	Nov 18 2025
			1	RELEASED FOR RE-APPROVAL	Jul 13 2026
			2	RELEASED FOR RE-APPROVAL	Aug 26 2026

STRUCTURE:- PINELLAS SUNCOAST TRANSIT AUTHORITY
LOCATION:- CLEARWATER STATION,CLEARWATER,FL.
DETAILER:- VECTORSHADES LLC
CUSTOMER:- KOKOLAKIS
ARCH./ENG.:- CDM SMITH
DESCRIPTION:- WAVE CANOPY ANGLE DETAIL
DRAWN:- PBI DATE:-10-27-2025 CHK.D:-RAG DATE:- 10-27-2025

SHOP BILL	WORK ORDER NO.	DRWG. NO.
	2553	1556

SHIPPING LIST

MATERIAL BILL

ITEM NO	TOTAL QTY	DESCRIPTION	MAJOR MARK	PAINT CODE	TOTAL WEIGHT	ABM NO	UNIT QTY	LENGTH FT.	LENGTH IN.	MINOR MARK	REMARKS	UNIT WEIGHT	GRADE
	12	ANGLE	1557A	G	1607						Galv	134	
	12	L6x6x3/4			1607		1	4	8	1557A		134	A572-50
		FIELD BOLTS											
	48	1 Dia A325N						0	2 3/4		+1HD WASH		

Total weight : 1607

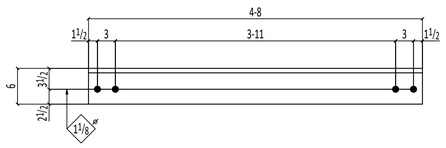

12 ANGLES 1557A-G

REFERENCE :----

PAGE TOTALS

REVISION NO.

SPECIAL NOTES:-

MATERIAL:-

ASTM: A36 U.N.O.
S. S.: -----
ALUM.: -----
PIPE: A53 GR.B
TUBES: A500 GR.B
HOLES: 13/16 U.N.O
WELDING: E70XX

MATERIAL PREP.:-

CLEAN: SSPC-SP2
SHOP PAINT: TWO COAT OF STD SHOP PRIMER
GALV: GALVANIZED & PAINTED

GEN. NOTES:-

BUY AMERICAN:
DOMESTIC:
CERT/CONFORMANCE:
CERT/COMPLIANCE:

ALL WIDE FLANGE SHAPES TO BE PER A992-G50

FIELD CONNECTIONS :
HOLES : 13/16" U.N.O
PAINT :

morrow steel Fabricators, Inc.

3620 COPELAND DRIVE
ZEPHYRHILLS, FL. 33542

	PRINTS FOR	DATE	MK	REVISIONS	DATE
			0	RELEASED FOR APPROVAL	Nov 18 2025
			1	RELEASED FOR RE-APPROVAL	Jul 13 2026
			2	RELEASED FOR RE-APPROVAL	Aug 26 2026

STRUCTURE:- PINELLAS SUNCOAST TRANSIT AUTHORITY
LOCATION:- CLEARWATER STATION,CLEARWATER,FL.
DETAILER:- VECTORSHADES LLC
CUSTOMER:- KOKOLAKIS
ARCH./ENG.:- CDM SMITH
DESCRIPTION:- WAVE CANOPY ANGLE DETAIL
DRAWN:- PBI DATE:-10-27-2025 CHK.D:-RAG DATE:- 10-27-2025

SHOP BILL	WORK ORDER NO.	DRWG. NO.
	2553	1557

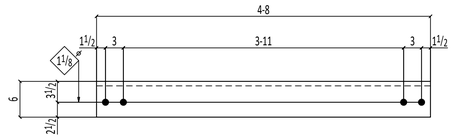

10 ANGLES 1558A-G

SHIPPING LIST

MATERIAL BILL

ITEM NO	TOTAL QTY	DESCRIPTION	MAJOR MARK	PAINT CODE	TOTAL WEIGHT	ABM NO	UNIT QTY	LENGTH FT.	LENGTH IN.	MINOR MARK	REMARKS	UNIT WEIGHT	GRADE
	10	ANGLE	1558A	G	1339						Galv	134	
	10	L6x6x3/4			1339		1	4	8	1558A		134	A572-50
		FIELD BOLTS											
	40	1 Dia A325N						0	2 3/4		+1HD WASH		

Total weight : 1339

REFERENCE :----

PAGE TOTALS

REVISION NO.

SPECIAL NOTES:-

MATERIAL:-

ASTM: A36 U.N.O.
S. S.: -----
ALUM.: -----
PIPE: A53 GR.B
TUBES: A500 GR.B
HOLES: 13/16 U.N.O
WELDING: E70XX

MATERIAL PREP.:-

CLEAN: SSPC-SP2
SHOP PAINT: TWO COAT OF STD SHOP PRIMER
GALV: GALVANIZED & PAINTED

GEN. NOTES:-

BUY AMERICAN:
DOMESTIC:
CERT/CONFORMANCE:
CERT/COMPLIANCE:

ALL WIDE FLANGE SHAPES TO BE PER A992-G50

FIELD CONNECTIONS :
HOLES : 13/16" U.N.O
PAINT :

morrow steel Fabricators, Inc.

3620 COPELAND DRIVE
ZEPHYRHILLS, FL. 33542

	PRINTS FOR	DATE	MK	REVISIONS	DATE
			0	RELEASED FOR APPROVAL	Nov 18 2025
			1	RELEASED FOR RE-APPROVAL	Jul 13 2026
			2	RELEASED FOR RE-APPROVAL	Aug 26 2026

STRUCTURE:-PINELLAS SUNCOAST TRANSIT AUTHORITY
LOCATION:- CLEARWATER STATION,CLEARWATER,FL.
DETAILER:- VECTORSHADES LLC
CUSTOMER:- KOKOLAKIS
ARCH./ENG.:- CDM SMITH
DESCRIPTION:-WAVE CANOPY ANGLE DETAIL
DRAWN:- PBI DATE:-10-27-2025 CHK.D:-RAG DATE:- 10-27-2025

SHOP BILL	WORK ORDER NO.	DRWG. NO.
	2553	1558

SHIPPING LIST

MATERIAL BILL

ITEM NO	TOTAL QTY	DESCRIPTION	MAJOR MARK	PAINT CODE	TOTAL WEIGHT	ABM NO	UNIT QTY	LENGTH FT.	LENGTH IN.	MINOR MARK	REMARKS	UNIT WEIGHT	GRADE
	ONE	ANGLE	1559A	G	23						Galv	23	
	1	L3x3x1/4			23		1	4	8	1559A		23	A572-50
		FIELD BOLTS											
	4	3/4 Dia A325N						0	1 3/4		+1HD WASH		

Total weight : 23

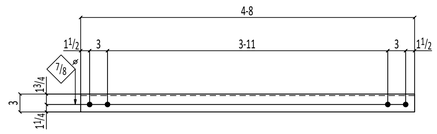

ONE ANGLE 1559A -G

REFERENCE :----

PAGE TOTALS

REVISION NO.

SPECIAL NOTES:-

MATERIAL:-

ASTM: A36 U.N.O.
S.S.: -----
ALUM.: -----
PIPE: A53 GR.B
TUBES: A500 GR.B
HOLES: 13/16 U.N.O
WELDING: E70XX

MATERIAL PREP.:-

CLEAN: SSPC-SP2
SHOP PAINT: TWO COAT OF STD SHOP PRIMER
GALV: GALVANIZED & PAINTED

GEN. NOTES:-

BUY AMERICAN:
DOMESTIC:
CERT/CONFORMANCE:
CERT/COMPLIANCE:

ALL WIDE FLANGE SHAPES TO BE PER A992-G50

FIELD CONNECTIONS :
HOLES : 13/16" U.N.O
PAINT :

morrow steel Fabricators, Inc.

3620 COPELAND DRIVE
ZEPHYRHILLS, FL. 33542

	PRINTS FOR	DATE	MK	REVISIONS	DATE
			0	RELEASED FOR APPROVAL	Nov 18 2025
			1	RELEASED FOR RE-APPROVAL	Jul 13 2026
			2	RELEASED FOR RE-APPROVAL	Aug 26 2026

STRUCTURE:-PINELLAS SUNCOAST TRANSIT AUTHORITY
LOCATION:- CLEARWATER STATION,CLEARWATER,FL.
DETAILER:- VECTORSHADES LLC
CUSTOMER:- KOKOLAKIS
ARCH./ENG.:- CDM SMITH
DESCRIPTION:- WAVE CANOPY ANGLE DETAIL
DRAWN:- PBI DATE:- 10-27-2025 CHK.D:- RAG DATE:- 10-27-2025

SHOP BILL	WORK ORDER NO.	DRWG. NO.
	2553	1559 ⚠1

SHIPPING LIST

MATERIAL BILL

ITEM NO	TOTAL QTY	DESCRIPTION	MAJOR MARK	PAINT CODE	TOTAL WEIGHT	ABM NO	UNIT QTY	LENGTH FT.	LENGTH IN.	MINOR MARK	REMARKS	UNIT WEIGHT	GRADE
	2	ANGLE	1560A	G	46						Galv	23	
	2	L3x3x1/4			46		1	4	8	1560A		23	A572-50
		FIELD BOLTS											
	8	3/4 Dia A325N						0	1 3/4		+1HD WASH		

Total weight : 46

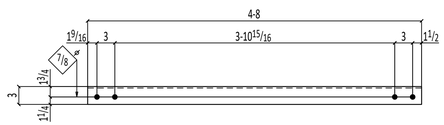

2 ANGLES 1560A-G

REFERENCE :----

PAGE TOTALS

REVISION NO.

SPECIAL NOTES:-

MATERIAL:-

ASTM: A36 U.N.O.
S. S.: -----
ALUM.: -----
PIPE: A53 GR.B
TUBES: A500 GR.B
HOLES: 13/16 U.N.O
WELDING: E70XX

MATERIAL PREP.:-

CLEAN: SSPC-SP2
SHOP PAINT: TWO COAT OF STD SHOP PRIMER
GALV: GALVANIZED & PAINTED

GEN. NOTES:-

BUY AMERICAN:
DOMESTIC:
CERT/CONFORMANCE:
CERT/COMPLIANCE:

ALL WIDE FLANGE SHAPES TO BE PER A992-G50

FIELD CONNECTIONS :
HOLES : 13/16" U.N.O
PAINT :

morrow steel Fabricators, Inc.

3620 COPELAND DRIVE
ZEPHYRHILLS, FL. 33542

	PRINTS FOR	DATE	MK	REVISIONS	DATE
			0	RELEASED FOR APPROVAL	Nov 18 2025
			1	RELEASED FOR RE-APPROVAL	Jul 13 2026
			2	RELEASED FOR RE-APPROVAL	Aug 26 2026

STRUCTURE:-PINELLAS SUNCOAST TRANSIT AUTHORITY
LOCATION:- CLEARWATER STATION,CLEARWATER,FL.
DETAILER:- VECTORSHADES LLC
CUSTOMER:- KOKOLAKIS
ARCH./ENG.:- CDM SMITH
DESCRIPTION:-WAVE CANOPY ANGLE DETAIL
DRAWN:- PBI DATE:-10-27-2025 CHK.D:-RAG DATE:- 10-27-2025

SHOP BILL	WORK ORDER NO.	DRWG. NO.
	2553	1560

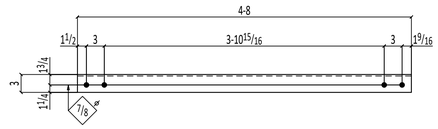

2 ANGLES 1561A -G

SHIPPING LIST

MATERIAL BILL

ITEM NO	TOTAL QTY	DESCRIPTION	MAJOR MARK	PAINT CODE	TOTAL WEIGHT	ABM NO	UNIT QTY	LENGTH FT.	LENGTH IN.	MINOR MARK	REMARKS	UNIT WEIGHT	GRADE
	2	ANGLE	1561A	G	46						Galv	23	
	2	L3x3x1/4			46		1	4	8	1561A		23	A572-50
		FIELD BOLTS											
	8	3/4 Dia A325N						0	1 3/4		+1HD WASH		

Total weight : 46

REFERENCE :----

PAGE TOTALS

REVISION NO.

SPECIAL NOTES:-

MATERIAL:-

ASTM: A36 U.N.O.
S. S.: -----
ALUM.: -----
PIPE: A53 GR.B
TUBES: A500 GR.B
HOLES: 13/16 U.N.O
WELDING: E70XX

MATERIAL PREP.:-

CLEAN: SSPC-SP2
SHOP PAINT: TWO COAT OF STD SHOP PRIMER
GALV: GALVANIZED & PAINTED

GEN. NOTES:-

BUY AMERICAN:
DOMESTIC:
CERT/CONFORMANCE:
CERT/COMPLIANCE:

ALL WIDE FLANGE SHAPES TO BE PER A992-G50

FIELD CONNECTIONS :
HOLES : 13/16" U.N.O
PAINT :

morrow steel Fabricators, Inc.

3620 COPELAND DRIVE
ZEPHYRHILLS, FL. 33542

	PRINTS FOR	DATE	MK	REVISIONS	DATE
			0	RELEASED FOR APPROVAL	Nov 18 2025
			1	RELEASED FOR RE-APPROVAL	Jul 13 2026
			2	RELEASED FOR RE-APPROVAL	Aug 26 2026

STRUCTURE:- PINELLAS SUNCOAST TRANSIT AUTHORITY
LOCATION:- CLEARWATER STATION,CLEARWATER,FL.
DETAILER:- VECTORSHADES LLC
CUSTOMER:- KOKOLAKIS
ARCH./ENG.:- CDM SMITH
DESCRIPTION:- WAVE CANOPY ANGLE DETAIL
DRAWN:- PBI DATE:-10-27-2025 CHK.D:-RAG DATE:- 10-27-2025

SHOP BILL	WORK ORDER NO.	DRWG. NO.
	2553	1561

SHIPPING LIST

MATERIAL BILL

ITEM NO	TOTAL QTY	DESCRIPTION	MAJOR MARK	PAINT CODE	TOTAL WEIGHT	ABM NO	UNIT QTY	LENGTH FT.	LENGTH IN.	MINOR MARK	REMARKS	UNIT WEIGHT	GRADE
	ONE	MISC	1562A	G	23						Galv	23	
	1	L3x3x1/4			23		1	4	8	1562A		23	A572-50
		FIELD BOLTS											
	4	3/4 Dia A325N						0	1 3/4		+1HD WASH		

Total weight : 23

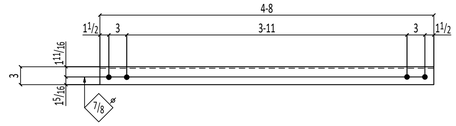

ONE MISC 1562A -G

REFERENCE :----

PAGE TOTALS

REVISION NO.

SPECIAL NOTES:-

MATERIAL:-

ASTM: A36 U.N.O.
S. S.: -----
ALUM.: -----
PIPE: A53 GR.B
TUBES: A500 GR.B
HOLES: 13/16 U.N.O
WELDING: E70XX

MATERIAL PREP.:-

CLEAN: SSPC-SP2
SHOP PAINT: TWO COAT OF STD SHOP PRIMER
GALV: GALVANIZED & PAINTED

GEN. NOTES:-

BUY AMERICAN:
DOMESTIC:
CERT/CONFORMANCE:
CERT/COMPLIANCE:

ALL WIDE FLANGE SHAPES TO BE PER A992-G50

FIELD CONNECTIONS :
HOLES : 13/16" U.N.O
PAINT :

morrow steel Fabricators, Inc.

3620 COPELAND DRIVE
ZEPHYRHILLS, FL. 33542

	PRINTS FOR	DATE	MK	REVISIONS	DATE
			0	RELEASED FOR APPROVAL	Nov 18 2025
			1	RELEASED FOR RE-APPROVAL	Jul 13 2026
			2	RELEASED FOR RE-APPROVAL	Aug 26 2026

STRUCTURE:- PINELLAS SUNCOAST TRANSIT AUTHORITY
LOCATION:- CLEARWATER STATION,CLEARWATER,FL.
DETAILER:- VECTORSHADES LLC
CUSTOMER:- KOKOLAKIS
ARCH./ENG.:- CDM SMITH
DESCRIPTION:- WAVE CANOPY ANGLE DETAIL
DRAWN:- PBI DATE:- 10-27-2025 CHK.D:- RAG DATE:- 10-27-2025

SHOP BILL	WORK ORDER NO.	DRWG. NO.
	2553	1562

SHIPPING LIST

MATERIAL BILL

ITEM NO	TOTAL QTY	DESCRIPTION	MAJOR MARK	PAINT CODE	TOTAL WEIGHT	ABM NO	UNIT QTY	LENGTH FT.	LENGTH IN.	MINOR MARK	REMARKS	UNIT WEIGHT	GRADE
	ONE	ANGLE	1563A	G	23						Galv	23	
	1	L3x3x1/4			23		1	4	8	1563A		23	A572-50
		FIELD BOLTS											
	4	3/4 Dia A325N						0	1 3/4		+1HD WASH		

Total weight : 23

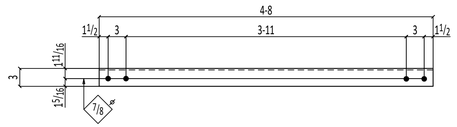

ONE ANGLE 1563A-G

REFERENCE :----

PAGE TOTALS

REVISION NO.

SPECIAL NOTES:-

MATERIAL:-

ASTM: A36 U.N.O.
S. S.: -----
ALUM.: -----
PIPE: A53 GR.B
TUBES: A500 GR.B
HOLES: 13/16 U.N.O
WELDING: E70XX

MATERIAL PREP.:-

CLEAN: SSPC-SP2
SHOP PAINT: TWO COAT OF STD SHOP PRIMER
GALV: GALVANIZED & PAINTED

GEN. NOTES:-

BUY AMERICAN:
DOMESTIC:
CERT/CONFORMANCE:
CERT/COMPLIANCE:

ALL WIDE FLANGE SHAPES TO BE PER A992-G50

FIELD CONNECTIONS :
HOLES : 13/16" U.N.O
PAINT :

morrow steel Fabricators, Inc.

3620 COPELAND DRIVE
ZEPHYRHILLS, FL. 33542

	PRINTS FOR	DATE	MK	REVISIONS	DATE
			0	RELEASED FOR APPROVAL	Nov 18 2025
			1	RELEASED FOR RE-APPROVAL	Jul 13 2026
			2	RELEASED FOR RE-APPROVAL	Aug 26 2026

STRUCTURE:-PINELLAS SUNCOAST TRANSIT AUTHORITY
LOCATION:- CLEARWATER STATION,CLEARWATER,FL.
DETAILER:- VECTORSHADES LLC
CUSTOMER:- KOKOLAKIS
ARCH./ENG.:- CDM SMITH
DESCRIPTION:- WAVE CANOPY ANGLE DETAIL
DRAWN:- PBI DATE:- 10-27-2025 CHK.D:- RAG DATE:- 10-27-2025

SHOP BILL	WORK ORDER NO.	DRWG. NO.
	2553	1563

SHIPPING LIST

MATERIAL BILL

ITEM NO	TOTAL QTY	DESCRIPTION	MAJOR MARK	PAINT CODE	TOTAL WEIGHT	ABM NO	UNIT QTY	LENGTH FT.	LENGTH IN.	MINOR MARK	REMARKS	UNIT WEIGHT	GRADE
	12	MISC	1564A	G	1244						Galv	104	
	12	L6x6x3/4			1244		1	3	7 5/16	1564A		104	A572-50
		FIELD BOLTS											
	48	1 Dia A325N						0	2 3/4		+1HD WASH		

Total weight : 1244

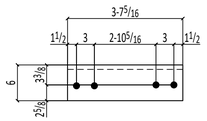

12 MISCS 1564A-G

REFERENCE :----

PAGE TOTALS

REVISION NO.

SPECIAL NOTES:-

MATERIAL:-

ASTM: A36 U.N.O.
S. S.: -----
ALUM.: -----
PIPE: A53 GR.B
TUBES: A500 GR.B
HOLES: 13/16 U.N.O
WELDING: E70XX

MATERIAL PREP.:-

CLEAN: SSPC-SP2
SHOP PAINT: TWO COAT OF STD SHOP PRIMER
GALV: GALVANIZED & PAINTED

GEN. NOTES:-

BUY AMERICAN:
DOMESTIC:
CERT/CONFORMANCE:
CERT/COMPLIANCE:

ALL WIDE FLANGE SHAPES TO BE PER A992-G50

FIELD CONNECTIONS :
HOLES : 13/16" U.N.O
PAINT :

morrow steel Fabricators, Inc.

3620 COPELAND DRIVE
ZEPHYRHILLS, FL. 33542

	PRINTS FOR	DATE	MK	REVISIONS	DATE
			0	RELEASED FOR APPROVAL	Nov 18 2025
			1	RELEASED FOR RE-APPROVAL	Jul 13 2026
			2	RELEASED FOR RE-APPROVAL	Aug 26 2026

STRUCTURE:-PINELLAS SUNCOAST TRANSIT AUTHORITY
LOCATION:- CLEARWATER STATION,CLEARWATER,FL.
DETAILER:- VECTORSHADES LLC
CUSTOMER:- KOKOLAKIS
ARCH./ENG.:- CDM SMITH
DESCRIPTION:-WAVE CANOPY ANGLE DETAIL
DRAWN:- PBI DATE:-10-27-2025 CHK.D:-RAG DATE:- 10-27-2025

SHOP BILL	WORK ORDER NO.	DRWG. NO.
	2553	1564

SHIPPING LIST

MATERIAL BILL

ITEM NO	TOTAL QTY	DESCRIPTION	MAJOR MARK	PAINT CODE	TOTAL WEIGHT	ABM NO	UNIT QTY	LENGTH FT.	LENGTH IN.	MINOR MARK	REMARKS	UNIT WEIGHT	GRADE
	2	MISC	1565A	G	268						Galv	134	
	2	L6x6x$^3/_4$			268		1	4	8	1565A		134	A572-50
		FIELD BOLTS											
	8	1 Dia A325N						0	$2^3/_4$		+1HD WASH		

Total weight : 268

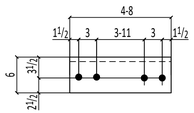

2 MISCS 1565A-G

REFERENCE :----

PAGE TOTALS

REVISION NO.

SPECIAL NOTES:-

MATERIAL:-

ASTM: A36 U.N.O.
S. S.: -----
ALUM.: -----
PIPE: A53 GR.B
TUBES: A500 GR.B
HOLES: $^{13}/_{16}$ U.N.O
WELDING: E70XX

MATERIAL PREP.:-

CLEAN: SSPC-SP2
SHOP PAINT: TWO COAT OF STD SHOP PRIMER
GALV: GALVANIZED & PAINTED

GEN. NOTES:-

BUY AMERICAN:
DOMESTIC:
CERT/CONFORMANCE:
CERT/COMPLIANCE:

ALL WIDE FLANGE SHAPES TO BE PER A992-G50

FIELD CONNECTIONS :
HOLES : $^{13}/_{16}$" U.N.O
PAINT :

morrow steel Fabricators, Inc.

3620 COPELAND DRIVE
ZEPHYRHILLS, FL. 33542

	PRINTS FOR	DATE	MK	REVISIONS	DATE
			0	RELEASED FOR APPROVAL	Nov 18 2025
			1	RELEASED FOR RE-APPROVAL	Jul 13 2026
			2	RELEASED FOR RE-APPROVAL	Aug 26 2026

STRUCTURE:-PINELLAS SUNCOAST TRANSIT AUTHORITY
LOCATION:- CLEARWATER STATION,CLEARWATER,FL.
DETAILER:- VECTORSHADES LLC
CUSTOMER:- KOKOLAKIS
ARCH./ENG.:- CDM SMITH
DESCRIPTION:- WAVE CANOPY ANGLE DETAIL
DRAWN:- PBI DATE:-10-27-2025 CHK.D:-RAG DATE:- 10-27-2025

SHOP BILL	WORK ORDER NO.	DRWG. NO.
	2553	1565

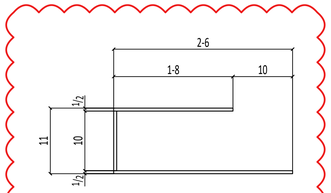

74 BENT PLATES 1651M-G

SHIPPING LIST

MATERIAL BILL

ITEM NO	TOTAL QTY	DESCRIPTION	MAJOR MARK	PAINT CODE	TOTAL WEIGHT	ABM NO	UNIT QTY	LENGTH FT.	LENGTH IN.	MINOR MARK	REMARKS	UNIT WEIGHT	GRADE
	74	BENT PLATE	1651M	G	7554						Galv	102	
	74	BPL1/2x12			7554		1	5	0	1651M	BENT	102	A572-50

Total weight : 7554

REFERENCE :----

PAGE TOTALS

REVISION NO.

SPECIAL NOTES:-

MATERIAL:-

ASTM: A36 U.N.O.
S. S.: -----
ALUM.: -----
PIPE: A53 GR.B
TUBES: A500 GR.B
HOLES: 13/16 U.N.O
WELDING: E70XX

MATERIAL PREP.:-

CLEAN: SSPC-SP2
SHOP PAINT:
GALV: GALVANIZED

GEN. NOTES:-

BUY AMERICAN:
DOMESTIC:
CERT/CONFORMANCE:
CERT/COMPLIANCE:

ALL WIDE FLANGE SHAPES TO BE PER A992-G50

FIELD CONNECTIONS :
HOLES : 13/16" U.N.O
PAINT :

morrow steel Fabricators, Inc.

3620 COPELAND DRIVE
ZEPHYRHILLS, FL. 33542

	PRINTS FOR	DATE	MK	REVISIONS	DATE
			0	RELEASED FOR APPROVAL	Nov 18 2025
			1	RELEASED FOR RE-APPROVAL	Jul 13 2026
			2	RELEASED FOR RE-APPROVAL	Aug 26 2026

STRUCTURE:- PINELLAS SUNCOAST TRANSIT AUTHORITY
LOCATION:- CLEARWATER STATION,CLEARWATER,FL.
DETAILER:- VECTORSHADES LLC.
CUSTOMER:- KOKOLAKIS
ARCH./ENG.:- CDM SMITH
DESCRIPTION:- WAVE CANOPY MISC DETAIL
DRAWN:- PBI DATE:-10-27-2025 CHK.D:-RAG DATE:- 10-27-2025

SHOP BILL	WORK ORDER NO.	DRWG. NO.
	2553	1651

SHIPPING LIST

MATERIAL BILL

ITEM NO	TOTAL QTY	DESCRIPTION	MAJOR MARK	PAINT CODE	TOTAL WEIGHT	ABM NO	UNIT QTY	LENGTH FT.	LENGTH IN.	MINOR MARK	REMARKS	UNIT WEIGHT	GRADE
	4	COLUMN	1701C	G	1565						Galv	391	
	4	HSS8x8x$^{1}/_{4}$			1503		1	14	$6^{11}/_{16}$	1701C		376	A500C
	8	L3x3x$^{1}/_{4}$			26		2	0	8	a163		3	A572-50
	4	PL$^{1}/_{2}$x8			36		1	0	8	p1		9	A572-50

SHIPPING LIST

MATERIAL BILL

ITEM NO	TOTAL QTY	DESCRIPTION	MAJOR MARK	PAINT CODE	TOTAL WEIGHT	ABM NO	UNIT QTY	LENGTH FT.	LENGTH IN.	MINOR MARK	REMARKS	UNIT WEIGHT	GRADE
	2	COLUMN	1702C	G	783						Galv	391	
	2	HSS8x8x1/4			752		1	14	6 11/16	1702C		376	A500C
	4	L3x3x1/4			13		2	0	8	a163		3	A572-50
	2	PL1/2x8			18		1	0	8	p1		9	A572-50
											Total weight :	783	

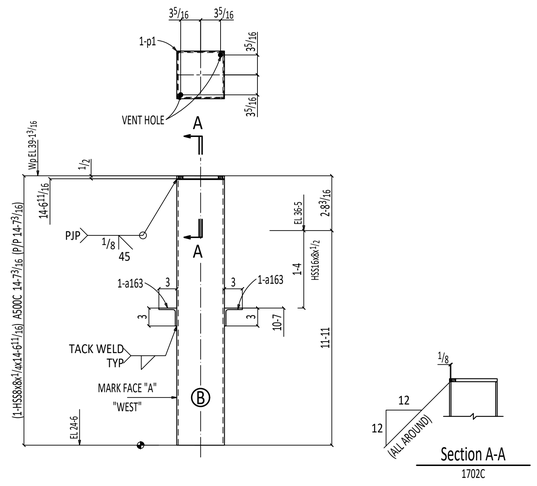

2 COLUMNS 1702C -G

AT GRID:
1.1 & B
1.1 & C

SHOP NOTE:
TACK WELD THE ANGLE AFTER GALVANIZE

REFERENCE :----

PAGE TOTALS

REVISION NO.

SPECIAL NOTES:-

1. SEAL ALL WELDS FOR GALVANIZE.
2. ALL VENT HOLES TO BE PLUGGED AFTER GALVANIZING.

MATERIAL:-

ASTM: A36 U.N.O.
S. S.: -----
ALUM.: -----
PIPE: A53 GR.B
TUBES: A500 GR.B
HOLES: 13/16 U.N.O
WELDING: E70XX

MATERIAL PREP.:-

CLEAN: SSPC-SP2
SHOP PAINT: ------

GEN. NOTES:-

BUY AMERICAN:
DOMESTIC:
CERT/CONFORMANCE:
CERT/COMPLIANCE:

ALL WIDE FLANGE SHAPES TO BE PER A992-G50

FIELD CONNECTIONS :
HOLES : 13/16" U.N.O
PAINT :

morrow steel Fabricators, Inc.

3620 COPELAND DRIVE
ZEPHYRHILLS, FL. 33542

	PRINTS FOR	DATE	MK	REVISIONS	DATE
			0	RELEASED FOR APPROVAL	Nov 18 2025
			1	RELEASED FOR RE-APPROVAL	Jul 13 2026
			2	RELEASED FOR RE-APPROVAL	Aug 26 2026

STRUCTURE:-PINELLAS SUNCOAST TRANSIT AUTHORITY
LOCATION:- CLEARWATER STATION,CLEARWATER,FL.
DETAILER:- VECTORSHADES LLC
CUSTOMER:- KOKOLAKIS
ARCH./ENG.:- CDM SMITH
DESCRIPTION:- PAVILION BUILDING COLUMN DETAIL
DRAWN:- PBI DATE:- 10-27-2025 CHK.D:- RAG DATE:- 10-27-2025

SHOP BILL	WORK ORDER NO.	DRWG. NO.
	2553	1702

SHIPPING LIST

MATERIAL BILL

ITEM NO	TOTAL QTY	DESCRIPTION	MAJOR MARK	PAINT CODE	TOTAL WEIGHT	ABM NO	UNIT QTY	LENGTH FT.	LENGTH IN.	MINOR MARK	REMARKS	UNIT WEIGHT	GRADE
	ONE	BEAM	1704B	G	163						Galv	163	
	1	HSS16x8x1/2			150		1	1	11 11/16	1704B		150	A500C
	1	PL3/8x2			2		1	0	8	p31		2	A572-50
	1	PL1/4x8			9		1	1	4	p8		9	A572-50
	2	WS7/8			2		2	0	6	ss4		1	A108
					Total weight : 163								

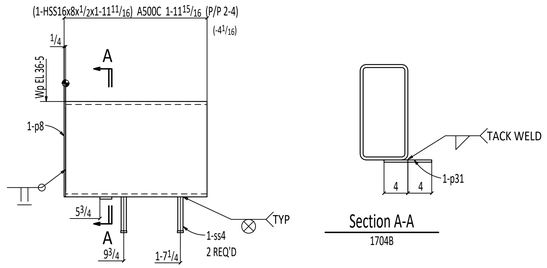

Section A-A
1704B

ONE BEAM 1704B-G

SHOP NOTE:
TACK WELD THE PLATE AFTER GALVANIZE

WE HAVE FOLLOWED GALVANIZED FOR ALL STEELS IN PAVILION BUILDING.
PLEASE CONFIRM/ADVISE IF ANY ADDITIONAL PAINT IS REQUIRED.

AISC CERTIFIED FABRICATOR AND ERECTOR

REFERENCE :----

PAGE TOTALS

REVISION NO.

SPECIAL NOTES:-

1. SEAL ALL WELDS FOR GALVANIZE.

MATERIAL:-

ASTM: A36 U.N.O.
S. S.: -----
ALUM.: -----
PIPE: A53 GR.B
TUBES: A500 GR.B
HOLES: 13/16 U.N.O
WELDING: E70XX

MATERIAL PREP.:-

CLEAN: SSPC-SP2
SHOP PAINT: -------
GALV: GALVANIZED

GEN. NOTES:-

BUY AMERICAN:
DOMESTIC:
CERT/CONFORMANCE:
CERT/COMPLIANCE:

ALL WIDE FLANGE SHAPES TO BE PER A992-G50

FIELD CONNECTIONS :
HOLES : 13/16" U.N.O
PAINT :

morrow steel Fabricators, Inc.

3620 COPELAND DRIVE
ZEPHYRHILLS, FL. 33542

	PRINTS FOR	DATE	MK	REVISIONS	DATE
			0	RELEASED FOR APPROVAL	Nov 18 2025
			1	RELEASED FOR RE-APPROVAL	Jul 13 2026
			2	RELEASED FOR RE-APPROVAL	Aug 26 2026

STRUCTURE:- PINELLAS SUNCOAST TRANSIT AUTHORITY
LOCATION:- CLEARWATER STATION,CLEARWATER,FL.
DETAILER:- VECTORSHADES LLC
CUSTOMER:- KOKOLAKIS
ARCH./ENG.:- CDM SMITH
DESCRIPTION:- PAVILION BUILDING BEAM DETAIL
DRAWN:- PBI DATE:- 10-27-2025 CHK.D:- RAG DATE:- 10-27-2025

SHOP BILL	WORK ORDER NO.	DRWG. NO.
	2553	1704

SHIPPING LIST

MATERIAL BILL

ITEM NO	TOTAL QTY	DESCRIPTION	MAJOR MARK	PAINT CODE	TOTAL WEIGHT	ABM NO	UNIT QTY	LENGTH FT.	LENGTH IN.	MINOR MARK	REMARKS	UNIT WEIGHT	GRADE
	ONE	BEAM	1705B	G	1220						Galv	1220	
	1	HSS16x8x$^{1}/_{2}$			1217		1	15	11$^{15}/_{16}$	1705B		1217	A500C
	2	PL$^{3}/_{8}$x2			3		2	0	8	p31		2	A572-50

Total weight : 1220

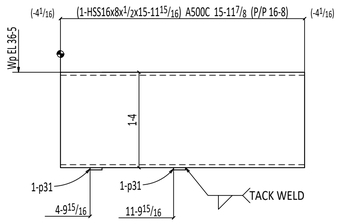

ONE BEAM 1705B-G

SHOP NOTE:
TACK WELD THE PLATE AFTER GALVANIZE

REFERENCE :----

PAGE TOTALS

REVISION NO.

SPECIAL NOTES:-

MATERIAL:-
ASTM: A36 U.N.O.
S. S.: -----
ALUM.: -----
PIPE: A53 GR.B
TUBES: A500 GR.B
HOLES: $^{13}/_{16}$ U.N.O
WELDING: E70XX

MATERIAL PREP.:-
CLEAN: SSPC-SP2
SHOP PAINT: ------
GALV: GALVANIZED

GEN. NOTES:-
BUY AMERICAN:
DOMESTIC:
CERT/CONFORMANCE:
CERT/COMPLIANCE:

ALL WIDE FLANGE SHAPES TO BE PER A992-G50

FIELD CONNECTIONS :
HOLES : $^{13}/_{16}$" U.N.O
PAINT :

morrow steel Fabricators, Inc.

3620 COPELAND DRIVE
ZEPHYRHILLS, FL. 33542

	PRINTS FOR	DATE	MK	REVISIONS	DATE
			0	RELEASED FOR APPROVAL	Nov 18 2025
			1	RELEASED FOR RE-APPROVAL	Jul 13 2026
			2	RELEASED FOR RE-APPROVAL	Aug 26 2026

STRUCTURE:- PINELLAS SUNCOAST TRANSIT AUTHORITY
LOCATION:- CLEARWATER STATION,CLEARWATER,FL.
DETAILER:- VECTORSHADES LLC
CUSTOMER:- KOKOLAKIS
ARCH./ENG.:- CDM SMITH
DESCRIPTION:- PAVILION BUILDING BEAM DETAIL
DRAWN:- PBI DATE:- 10-27-2025 CHK.D:- RAG DATE:- 10-27-2025

SHOP BILL	WORK ORDER NO.	DRWG. NO.
	2553	1705 ⚠1

SHIPPING LIST

MATERIAL BILL

ITEM NO	TOTAL QTY	DESCRIPTION	MAJOR MARK	PAINT CODE	TOTAL WEIGHT	ABM NO	UNIT QTY	LENGTH FT.	LENGTH IN.	MINOR MARK	REMARKS	UNIT WEIGHT	GRADE
	ONE	BEAM	1706B	G	863						Galv	863	
	1	HSS16x8x$^{1}/_{2}$			862		1	11	$3^{15}/_{16}$	1706B		862	A500C
	1	PL$^{3}/_{8}$x2			1		1	0	6	p49		1	A572-50

SHIPPING LIST

MATERIAL BILL

ITEM NO	TOTAL QTY	DESCRIPTION	MAJOR MARK	PAINT CODE	TOTAL WEIGHT	ABM NO	UNIT QTY	LENGTH FT.	LENGTH IN.	MINOR MARK	REMARKS	UNIT WEIGHT	GRADE
	ONE	BEAM	1707B	G	964						Galv	964	
	1	HSS16x8x$^{1}/_{2}$			963		1	12	$^{7}15/_{16}$	1707B		963	A500C
	1	PL$^{3}/_{8}$x2			1		1	0	6	p49		1	A572-50

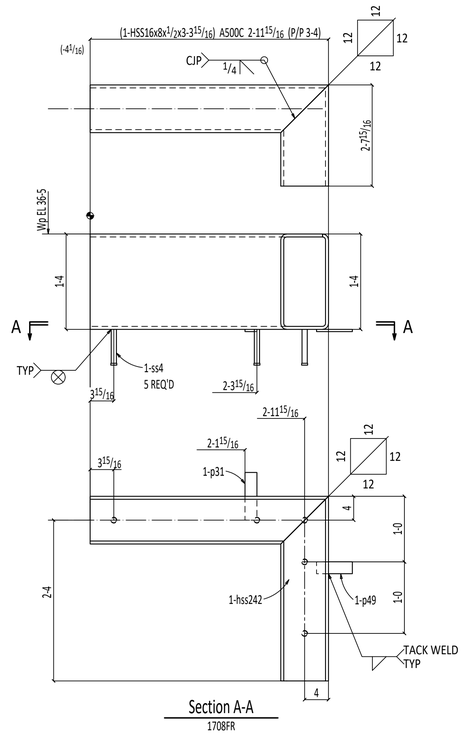

Section A-A
1708FR

ONE BEAM 1708FR-G

SHOP NOTE:
TACK WELD THE PLATE AFTER GALVANIZE

SHIPPING LIST

MATERIAL BILL

ITEM NO	TOTAL QTY	DESCRIPTION	MAJOR MARK	PAINT CODE	TOTAL WEIGHT	ABM NO	UNIT QTY	LENGTH FT.	LENGTH IN.	MINOR MARK	REMARKS	UNIT WEIGHT	GRADE
	ONE	BEAM	1708FR	G	464						Galv	464	
	1	HSS16x8x1/2			253		1	3	3 15/16	1708FR		253	A500C
	1	HSS16x8x1/2			203		1	2	8	hss242		203	A500C
	1	PL3/8x2			1		1	0	6	p49		1	A572-50
	1	PL3/8x2			2		1	0	8	p31		2	A572-50
	5	WS7/8			5		5	0	6	ss4		1	A108

Total weight : 464

REFERENCE :----

PAGE TOTALS

REVISION NO.

SPECIAL NOTES:-

1. SEAL ALL WELDS FOR GALVANIZE.

MATERIAL:-

ASTM: A36 U.N.O.
S. S.: -----
ALUM.: -----
PIPE: A53 GR.B
TUBES: A500 GR.B
HOLES: 13/16 U.N.O
WELDING: E70XX

MATERIAL PREP.:-

CLEAN: SSPC-SP2
SHOP PAINT: ------
GALV: GALVANIZED

GEN. NOTES:-

BUY AMERICAN:
DOMESTIC:
CERT/CONFORMANCE:
CERT/COMPLIANCE:

ALL WIDE FLANGE SHAPES TO BE PER A992-G50

FIELD CONNECTIONS :
HOLES : 13/16" U.N.O
PAINT :

morrow steel Fabricators, Inc.

3620 COPELAND DRIVE
ZEPHYRHILLS, FL. 33542

	PRINTS FOR	DATE	MK	REVISIONS	DATE
			0	RELEASED FOR APPROVAL	Nov 18 2025
			1	RELEASED FOR RE-APPROVAL	Jul 13 2026
			2	RELEASED FOR RE-APPROVAL	Aug 26 2026

STRUCTURE:- PINELLAS SUNCOAST TRANSIT AUTHORITY
LOCATION:- CLEARWATER STATION,CLEARWATER,FL.
DETAILER:- VECTORSHADES LLC
CUSTOMER:- KOKOLAKIS
ARCH./ENG.:- CDM SMITH
DESCRIPTION:- PAVILION BUILDING FRAME DETAIL
DRAWN:- PBI DATE:- 10-27-2025 CHK.D:- RAG DATE:- 10-27-2025

SHOP BILL	WORK ORDER NO.	DRWG. NO.
	2553	1708

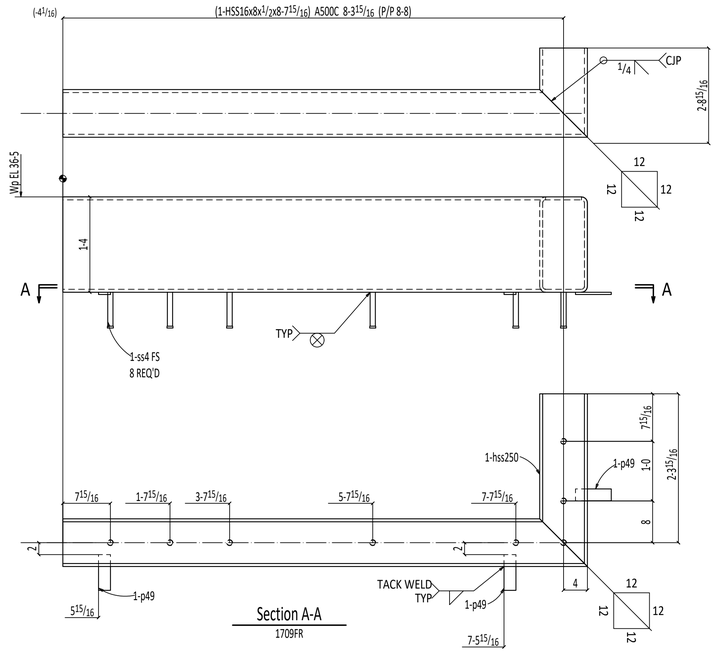

Section A-A

1709FR

ONE BEAM 1709FR-G

SHOP NOTE:
TACK WELD THE PLATE AFTER GALVANIZE

SHIPPING LIST

MATERIAL BILL

ITEM NO	TOTAL QTY	DESCRIPTION	MAJOR MARK	PAINT CODE	TOTAL WEIGHT	ABM NO	UNIT QTY	LENGTH FT.	LENGTH IN.	MINOR MARK	REMARKS	UNIT WEIGHT	GRADE
	ONE	BEAM	1709FR	G	874						Galv	874	
	1	HSS16x8x1/2			659		1	8	7 15/16	1709FR		659	A500C
	1	HSS16x8x1/2			203		1	2	8	hss250		203	A500C
	3	PL3/8x2			4		3	0	6	p49		1	A572-50
	8	WS7/8			8		8	0	6	ss4		1	A108

Total weight : 874

REFERENCE :----

PAGE TOTALS

REVISION NO.

SPECIAL NOTES:-

1. SEAL ALL WELDS FOR GALVANIZE.

MATERIAL:-

ASTM: A36 U.N.O.
S. S.: -----
ALUM.: -----
PIPE: A53 GR.B
TUBES: A500 GR.B
HOLES: 13/16 U.N.O
WELDING: E70XX

MATERIAL PREP.:-

CLEAN: SSPC-SP2
SHOP PAINT: ------

GALV: GALVANIZED

GEN. NOTES:-

BUY AMERICAN:
DOMESTIC:
CERT/CONFORMANCE:
CERT/COMPLIANCE:

ALL WIDE FLANGE SHAPES TO BE PER A992-G50

FIELD CONNECTIONS :
HOLES : 13/16" U.N.O
PAINT :

morrow steel Fabricators, Inc.

3620 COPELAND DRIVE
ZEPHYRHILLS, FL. 33542

	PRINTS FOR	DATE	MK	REVISIONS	DATE
			0	RELEASED FOR APPROVAL	Nov 18 2025
			1	RELEASED FOR RE-APPROVAL	Jul 13 2026
			2	RELEASED FOR RE-APPROVAL	Aug 26 2026

STRUCTURE:-PINELLAS SUNCOAST TRANSIT AUTHORITY
LOCATION:- CLEARWATER STATION,CLEARWATER,FL.
DETAILER:- VECTORSHADES LLC
CUSTOMER:- KOKOLAKIS
ARCH./ENG.:- CDM SMITH
DESCRIPTION:-PAVILION BUILDING FRAME DETAIL
DRAWN:- PBI DATE:-10-27-2025 CHK.D:-RAG DATE:- 10-27-2025

SHOP BILL	WORK ORDER NO.	DRWG. NO.
	2553	1709

SHIPPING LIST

MATERIAL BILL

ITEM NO	TOTAL QTY	DESCRIPTION	MAJOR MARK	PAINT CODE	TOTAL WEIGHT	ABM NO	UNIT QTY	LENGTH FT.	LENGTH IN.	MINOR MARK	REMARKS	UNIT WEIGHT	GRADE
	ONE	BEAM	1710FR	G	799						Galv	799	
	1	HSS8x2x1/4			107		1	6	10	1710FR		107	A500C
	5	HSS8x2x1/4			534		5	6	10	hss210		107	A500C
	4	HSS8x2x1/4			120		4	1	11	hss231		30	A500C
	8	L4x4x3/8			33		8	0	5	a162		4	A572-50
	1	PL3/8x2			1		1	0	6	p49		1	A572-50
	4	PL1/4x2			4		4	0	8	p23		1	A572-50
	4	PL1/4x1			0		4	0	1 7/16	p43		0	A572-50

Total weight : 799

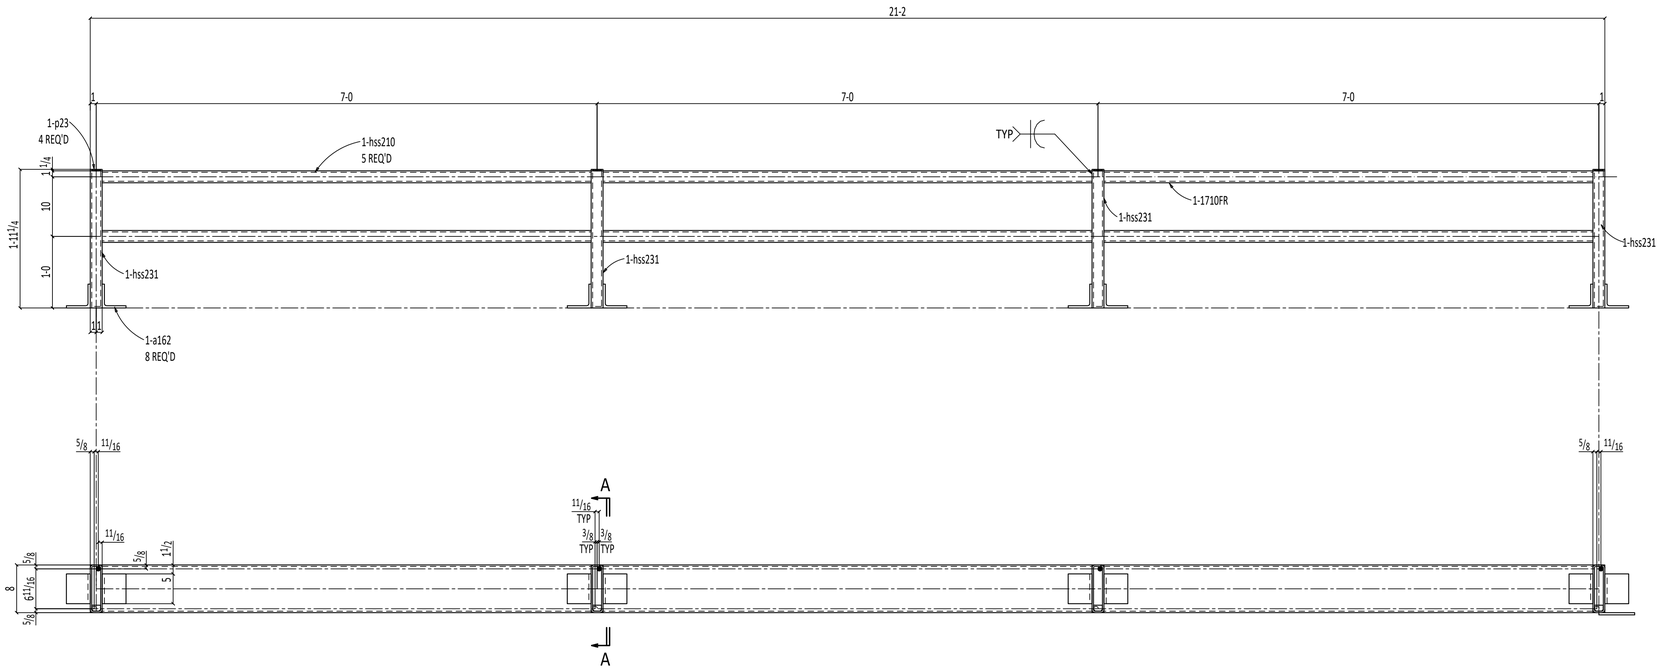

ONE BEAM 1710FR-G

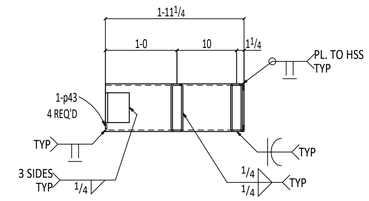

Section A-A
1710FR

SHOP NOTE:
TACK WELD THE PLATE AFTER GALVANIZE

REFERENCE :----

PAGE TOTALS

REVISION NO.

SPECIAL NOTES:-

1. SEAL ALL WELDS FOR GALVANIZE.

MATERIAL:-

ASTM:	A36 U.N.O.
S. S.:	-----
ALUM.:	-----
PIPE:	A53 GR.B
TUBES:	A500 GR.B
HOLES:	13/16 U.N.O
WELDING:	E70XX

MATERIAL PREP.:-

CLEAN:	SSPC-SP2
SHOP PAINT:	------
GALV:	GALVANIZED

GEN. NOTES:-

BUY AMERICAN:	
DOMESTIC:	
CERT/CONFORMANCE:	
CERT/COMPLIANCE:	

ALL WIDE FLANGE SHAPES TO BE PER A992-G50

FIELD CONNECTIONS :
HOLES : 13/16" U.N.O
PAINT :

morrow steel Fabricators, Inc.

3620 COPELAND DRIVE
ZEPHYRHILLS, FL. 33542

	PRINTS FOR	DATE	MK	REVISIONS	DATE
			0	RELEASED FOR APPROVAL	Nov 18 2025
			1	RELEASED FOR RE-APPROVAL	Jul 13 2026
			2	RELEASED FOR RE-APPROVAL	Aug 26 2026

STRUCTURE:- PINELLAS SUNCOAST TRANSIT AUTHORITY
LOCATION:- CLEARWATER STATION,CLEARWATER,FL.
DETAILER:- VECTORSHADES LLC
CUSTOMER:- KOKOLAKIS
ARCH./ENG.:- CDM SMITH
DESCRIPTION:- PAVILION BUILDING FRAME DETAIL
DRAWN:- PBI DATE:- 10-27-2025 CHK.D:- RAG DATE:- 10-27-2025

SHOP BILL	WORK ORDER NO.	DRWG. NO.
	2553	1710

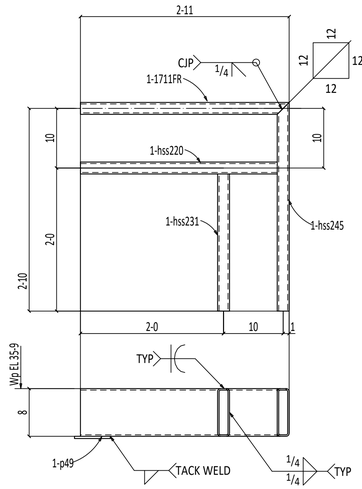

ONE BEAM 1711FR-G

SHOP NOTE:
TACK WELD THE PLATE AFTER GALVANIZE

SHIPPING LIST

MATERIAL BILL

ITEM NO	TOTAL QTY	DESCRIPTION	MAJOR MARK	PAINT CODE	TOTAL WEIGHT	ABM NO	UNIT QTY	LENGTH FT.	LENGTH IN.	MINOR MARK	REMARKS	UNIT WEIGHT	GRADE
	ONE	BEAM	1711FR	G	165						Galv	165	
	1	HSS8x2x1/4			46		1	2	11	1711FR		46	A500C
	1	HSS8x2x1/4			46		1	2	11	hss245		46	A500C
	1	HSS8x2x1/4			43		1	2	9	hss220		43	A500C
	1	HSS8x2x1/4			30		1	1	11	hss231		30	A500C
	1	PL3/8x2			1		1	0	6	p49		1	A572-50

Total weight : 165

REFERENCE :----

PAGE TOTALS | REVISION NO.

SPECIAL NOTES:-

1. SEAL ALL WELDS FOR GALVANIZE.

MATERIAL:-

ASTM: A36 U.N.O.
S. S.: -----
ALUM.: -----
PIPE: A53 GR.B
TUBES: A500 GR.B
HOLES: 13/16 U.N.O
WELDING: E70XX

MATERIAL PREP.:-

CLEAN: SSPC-SP2
SHOP PAINT: ------
GALV: GALVANIZED

GEN. NOTES:-

BUY AMERICAN:
DOMESTIC:
CERT/CONFORMANCE:
CERT/COMPLIANCE:

ALL WIDE FLANGE SHAPES TO BE PER A992-G50

FIELD CONNECTIONS :
HOLES : 13/16" U.N.O
PAINT :

morrow steel Fabricators, Inc.

3620 COPELAND DRIVE
ZEPHYRHILLS, FL. 33542

	PRINTS FOR	DATE	MK	REVISIONS	DATE
			0	RELEASED FOR APPROVAL	Jul 13 2026
			1	RELEASED FOR RE-APPROVAL	Aug 26 2026

STRUCTURE:- PINELLAS SUNCOAST TRANSIT AUTHORITY
LOCATION:- CLEARWATER STATION,CLEARWATER,FL.
DETAILER:- VECTORSHADES LLC
CUSTOMER:- KOKOLAKIS
ARCH./ENG.:- CDM SMITH
DESCRIPTION:- PAVILION BUILDING FRAME DETAIL
DRAWN:- PBI DATE:-07-13-2026 CHK.D:-RAG DATE:- 07-13-2026

SHOP BILL	WORK ORDER NO.	DRWG. NO.
	2553	1711

SHIPPING LIST

MATERIAL BILL

ITEM NO	TOTAL QTY	DESCRIPTION	MAJOR MARK	PAINT CODE	TOTAL WEIGHT	ABM NO	UNIT QTY	LENGTH FT.	LENGTH IN.	MINOR MARK	REMARKS	UNIT WEIGHT	GRADE
	ONE	BEAM	1712FR	G	605						Galv	605	
	1	HSS8x2x1/4			121		1	7	9	1712FR		121	A500C
	3	HSS8x2x1/4			363		3	7	9	hss208		121	A500C
	3	HSS8x2x1/4			90		3	1	11	hss231		30	A500C
	6	L4x4x3/8			25		6	0	5	a162		4	A572-50
	2	PL3/8x2			3		2	0	6	p49		1	A572-50
	3	PL1/4x2			3		3	0	8	p23		1	A572-50
	3	PL1/4x1			0		3	0	1 7/16	p43		0	A572-50

Total weight : 605

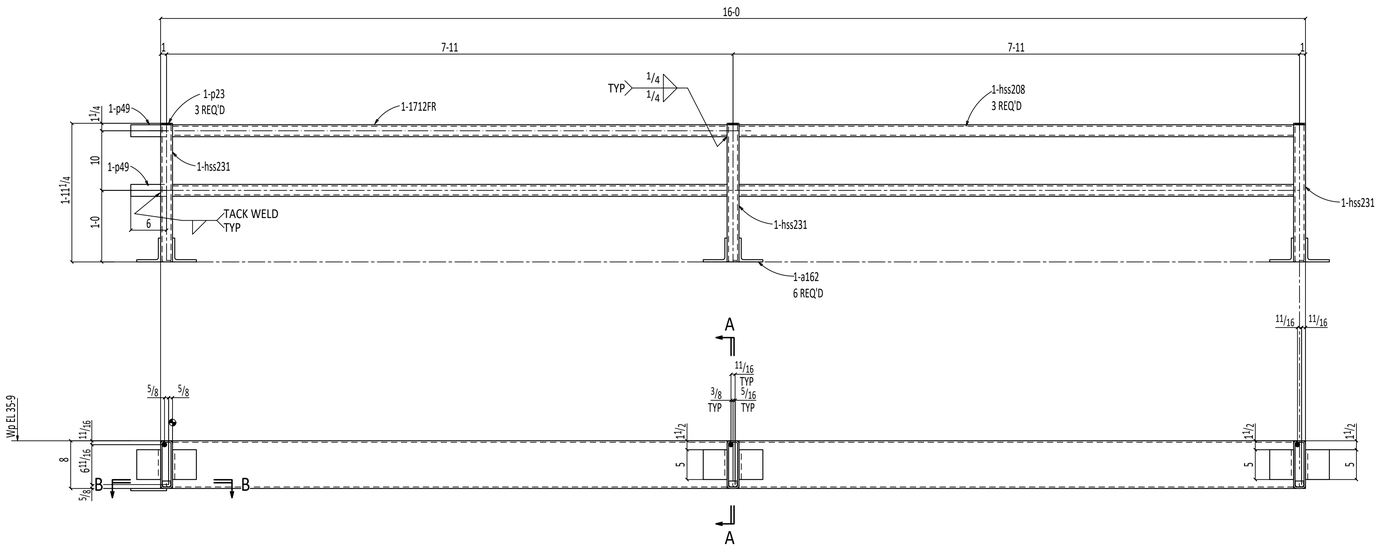

ONE BEAM 1712FR-G

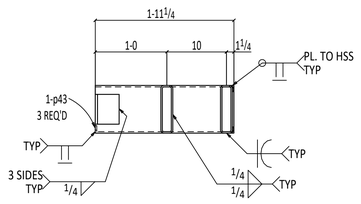

Section A-A
1712FR

REFERENCE :----

PAGE TOTALS

REVISION NO.

SPECIAL NOTES:-

1. SEAL ALL WELDS FOR GALVANIZE.

MATERIAL:-

ASTM: A36 U.N.O.
S. S.: -----
ALUM.: -----
PIPE: A53 GR.B
TUBES: A500 GR.B
HOLES: 13/16 U.N.O
WELDING: E70XX

MATERIAL PREP.:-

CLEAN: SSPC-SP2
SHOP PAINT: ------
GALV: GALVANIZED

GEN. NOTES:-

BUY AMERICAN:
DOMESTIC:
CERT/CONFORMANCE:
CERT/COMPLIANCE:

ALL WIDE FLANGE SHAPES TO BE PER A992-G50

FIELD CONNECTIONS :
HOLES : 13/16" U.N.O
PAINT :

morrow steel Fabricators, Inc.

3620 COPELAND DRIVE
ZEPHYRHILLS, FL. 33542

	PRINTS FOR	DATE	MK	REVISIONS	DATE
			0	RELEASED FOR APPROVAL	Jul 13 2026
			1	RELEASED FOR RE-APPROVAL	Aug 26 2026

STRUCTURE:-PINELLAS SUNCOAST TRANSIT AUTHORITY
LOCATION:- CLEARWATER STATION,CLEARWATER,FL.
DETAILER:- VECTORSHADES LLC
CUSTOMER:- KOKOLAKIS
ARCH./ENG.:- CDM SMITH
DESCRIPTION:-PAVILION BUILDING FRAME DETAIL
DRAWN:-PBI DATE:-07-13-2026 CHK.D:-RAG DATE:- 07-13-2026

SHOP BILL	WORK ORDER NO.	DRWG. NO.
	2553	1712

SHIPPING LIST

MATERIAL BILL

ITEM NO	TOTAL QTY	DESCRIPTION	MAJOR MARK	PAINT CODE	TOTAL WEIGHT	ABM NO	UNIT QTY	LENGTH FT.	LENGTH IN.	MINOR MARK	REMARKS	UNIT WEIGHT	GRADE
	ONE	BEAM	1713FR	G	164						Galv	164	
	1	HSS8x2x1/4			46		1	2	11	1713FR		46	A500C
	1	HSS8x2x1/4			46		1	2	11	hss228		46	A500C
	1	HSS8x2x1/4			43		1	2	9	hss220		43	A500C
	1	HSS8x2x1/4			30		1	1	11	hss231		30	A500C

Total weight : 164

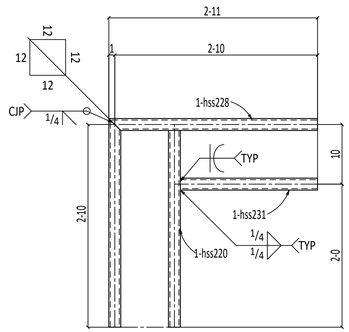

ONE BEAM 1713FR -G

REFERENCE :----

PAGE TOTALS

REVISION NO.

SPECIAL NOTES:-

1. SEAL ALL WELDS FOR GALVANIZE.

MATERIAL:-

ASTM: A36 U.N.O.
S. S.: -----
ALUM.: -----
PIPE: A53 GR.B
TUBES: A500 GR.B
HOLES: 13/16 U.N.O
WELDING: E70XX

MATERIAL PREP.:-

CLEAN: SSPC-SP2
SHOP PAINT: ------
GALV: GALVANIZED

GEN. NOTES:-

BUY AMERICAN:
DOMESTIC:
CERT/CONFORMANCE:
CERT/COMPLIANCE:

ALL WIDE FLANGE SHAPES TO BE PER A992-G50

FIELD CONNECTIONS :
HOLES : 13/16" U.N.O
PAINT :

morrow steel Fabricators, Inc.

3620 COPELAND DRIVE
ZEPHYRHILLS, FL. 33542

	PRINTS FOR	DATE	MK	REVISIONS	DATE
			0	RELEASED FOR APPROVAL	Jul 13 2026
			1	RELEASED FOR RE-APPROVAL	Aug 26 2026

STRUCTURE:- PINELLAS SUNCOAST TRANSIT AUTHORITY
LOCATION:- CLEARWATER STATION,CLEARWATER,FL.
DETAILER:- VECTORSHADES LLC
CUSTOMER:- KOKOLAKIS
ARCH./ENG.:- CDM SMITH
DESCRIPTION:- PAVILION BUILDING FRAME DETAIL
DRAWN:- PBI DATE:-07-13-2026 CHK.D:-RAG DATE:- 07-13-2026

SHOP BILL	WORK ORDER NO.	DRWG. NO.
	2553	1713

SHIPPING LIST

MATERIAL BILL

ITEM NO	TOTAL QTY	DESCRIPTION	MAJOR MARK	PAINT CODE	TOTAL WEIGHT	ABM NO	UNIT QTY	LENGTH FT.	LENGTH IN.	MINOR MARK	REMARKS	UNIT WEIGHT	GRADE
	ONE	BEAM	1714FR	G	860						Galv	860	
	1	HSS8x2x1/4			128		1	8	2	1714FR		128	A500C
	1	HSS8x2x1/4			128		1	8	2	hss212		128	A500C
	2	HSS8x2x1/4			234		2	7	6	hss216		117	A500C
	2	HSS8x2x1/4			213		2	6	10	hss210		107	A500C
	4	HSS8x2x1/4			120		4	1	11	hss231		30	A500C
	8	L4x4x3/8			33		8	0	5	a162		4	A572-50
	4	PL1/4x2			4		4	0	8	p23		1	A572-50
	4	PL1/4x1			0		4	0	17/16	p43		0	A572-50

Total weight : 860

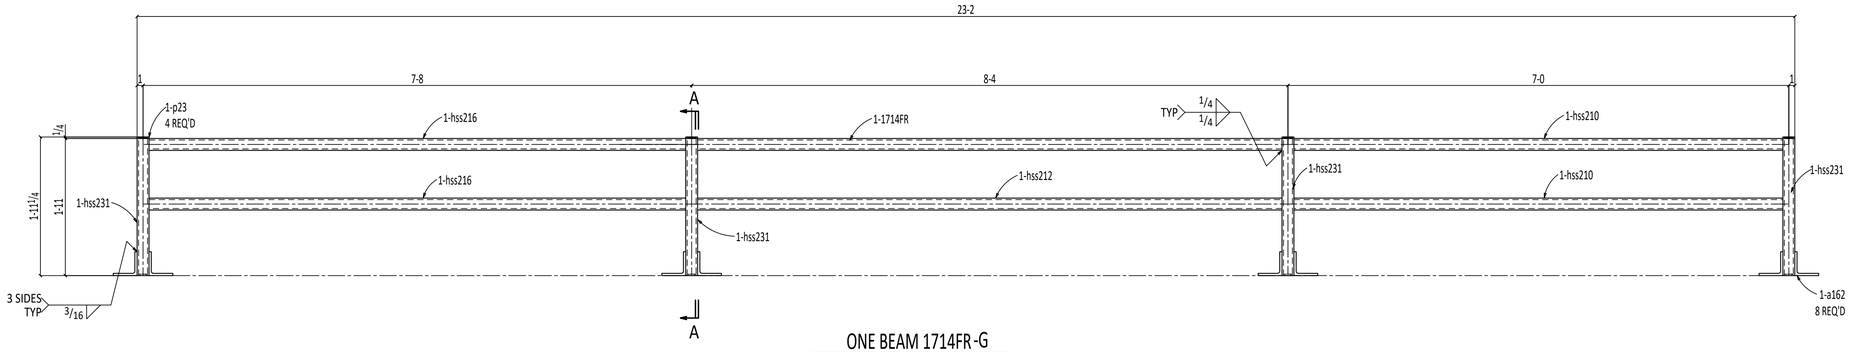

ONE BEAM 1714FR-G

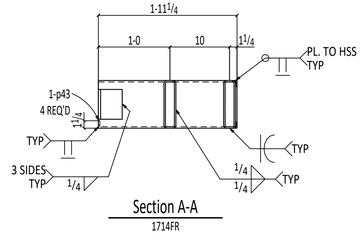

Section A-A
1714FR

REFERENCE :----

PAGE TOTALS

REVISION NO.

SPECIAL NOTES:-

1. SEAL ALL WELDS FOR GALVANIZE.

MATERIAL:-

ASTM: A36 U.N.O.
S. S.: -----
ALUM.: -----
PIPE: A53 GR.B
TUBES: A500 GR.B
HOLES: 13/16 U.N.O
WELDING: E70XX

MATERIAL PREP.:-

CLEAN: SSPC-SP2
SHOP PAINT: -------

GEN. NOTES:-

BUY AMERICAN:
DOMESTIC:
CERT/CONFORMANCE:
CERT/COMPLIANCE:
GALV: GALVANIZED

ALL WIDE FLANGE SHAPES TO BE PER A992-G50

FIELD CONNECTIONS :
HOLES : 13/16" U.N.O
PAINT :

morrow steel Fabricators, Inc.

3620 COPELAND DRIVE
ZEPHYRHILLS, FL. 33542

	PRINTS FOR	DATE	MK	REVISIONS	DATE
			0	RELEASED FOR APPROVAL	Jul 13 2026
			1	RELEASED FOR RE-APPROVAL	Aug 26 2026

STRUCTURE:- PINELLAS SUNCOAST TRANSIT AUTHORITY
LOCATION:- CLEARWATER STATION,CLEARWATER,FL.
DETAILER:- VECTORSHADES LLC
CUSTOMER:- KOKOLAKIS
ARCH./ENG.:- CDM SMITH
DESCRIPTION:- PAVILION BUILDING FRAME DETAIL
DRAWN:- PBI DATE:-07-13-2026 CHK.D:-RAG DATE:- 07-13-2026

SHOP BILL	WORK ORDER NO.	DRWG. NO.
	2553	1714 ⚠1

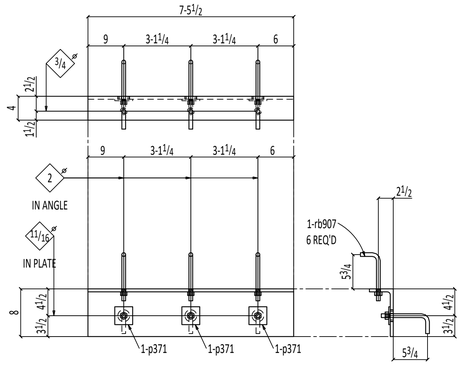

ONE MISC 1715M-G

SHIPPING LIST

MATERIAL BILL

ITEM NO	TOTAL QTY	DESCRIPTION	MAJOR MARK	PAINT CODE	TOTAL WEIGHT	ABM NO	UNIT QTY	LENGTH FT.	LENGTH IN.	MINOR MARK	REMARKS	UNIT WEIGHT	GRADE
	ONE	MISC	1715M	G	153						Galv	153	
	1	L8x4x1/2			146		1	7	5 1/2	1715M		146	A572-50
	6	RB5/8			5		6	0	9 13/16	rb907		1	A572-50
	3	PL1/4x3			2		3	0	3	p371		1	A572-50
	6	5/8 NUT					6			blt2	HHNT		A563

Total weight : 153

REFERENCE :----

PAGE TOTALS

REVISION NO.

SPECIAL NOTES:-

1. SEAL ALL WELDS FOR GALVANIZE.

MATERIAL:-

ASTM: A36 U.N.O.
S. S.: -----
ALUM.: -----
PIPE: A53 GR.B
TUBES: A500 GR.B
HOLES: 13/16 U.N.O
WELDING: E70XX

MATERIAL PREP.:-

CLEAN: SSPC-SP2
SHOP PAINT: ------
GALV: GALVANIZED

GEN. NOTES:-

BUY AMERICAN:
DOMESTIC:
CERT/CONFORMANCE:
CERT/COMPLIANCE:

ALL WIDE FLANGE SHAPES TO BE PER A992-G50

FIELD CONNECTIONS :
HOLES : 13/16" U.N.O
PAINT :

morrow steel Fabricators, Inc.

3620 COPELAND DRIVE
ZEPHYRHILLS, FL. 33542

	PRINTS FOR	DATE	MK	REVISIONS	DATE
			0	RELEASED FOR APPROVAL	Jul 13 2026
			1	RELEASED FOR RE-APPROVAL	Aug 26 2026

STRUCTURE:- PINELLAS SUNCOAST TRANSIT AUTHORITY
LOCATION:- CLEARWATER STATION,CLEARWATER,FL.
DETAILER:- VECTORSHADES LLC
CUSTOMER:- KOKOLAKIS
ARCH./ENG.:- CDM SMITH
DESCRIPTION:- PAVILION BUILDING FRAME DETAIL
DRAWN:- PBI DATE:-07-13-2026 CHK.D:-RAG DATE:- 07-13-2026

SHOP BILL	WORK ORDER NO.	DRWG. NO.
	2553	1715

SHIPPING LIST

MATERIAL BILL

ITEM NO	TOTAL QTY	DESCRIPTION	MAJOR MARK	PAINT CODE	TOTAL WEIGHT	ABM NO	UNIT QTY	LENGTH FT.	LENGTH IN.	MINOR MARK	REMARKS	UNIT WEIGHT	GRADE
	ONE	MISC	1716M	G	174						Galv	174	
	1	L8x4x1/2			167		1	8	6 1/2	1716M		167	A572-50
	6	RB5/8			5		6	0	9 13/16	rb907		1	A572-50
	3	PL1/4x3			2		3	0	3	p371		1	A572-50
	6	5/8 NUT					6			blt2	HHNT		A563

Total weight : 174

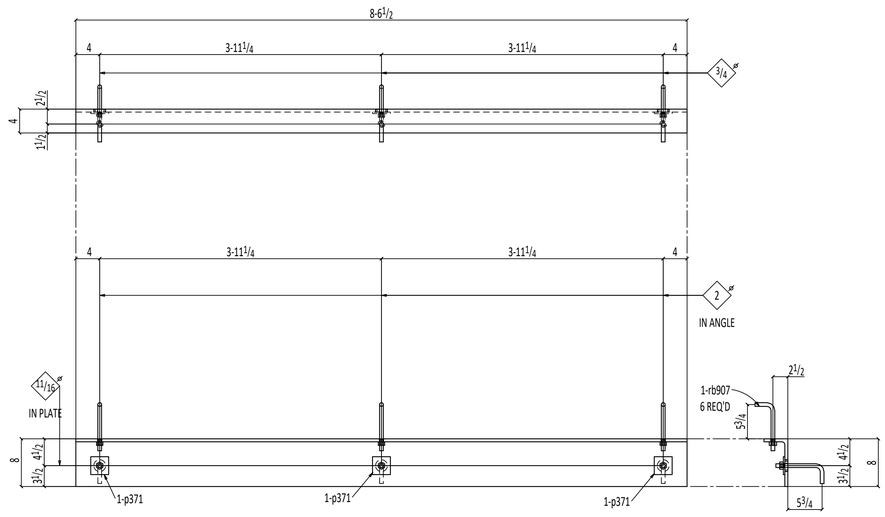

ONE MISC 1716M-G

REFERENCE :----

PAGE TOTALS

REVISION NO.

SPECIAL NOTES:-

1. SEAL ALL WELDS FOR GALVANIZE.

MATERIAL:-

ASTM: A36 U.N.O.
S. S.: -----
ALUM.: -----
PIPE: A53 GR.B
TUBES: A500 GR.B
HOLES: 13/16 U.N.O
WELDING: E70XX

MATERIAL PREP.:-

CLEAN: SSPC-SP2
SHOP PAINT: ------
GALV: GALVANIZED

GEN. NOTES:-

BUY AMERICAN:
DOMESTIC:
CERT/CONFORMANCE:
CERT/COMPLIANCE:

ALL WIDE FLANGE SHAPES TO BE PER A992-G50

FIELD CONNECTIONS :
HOLES : 13/16" U.N.O
PAINT :

morrow steel Fabricators, Inc.

3620 COPELAND DRIVE
ZEPHYRHILLS, FL. 33542

	PRINTS FOR	DATE	MK	REVISIONS	DATE
			0	RELEASED FOR APPROVAL	Jul 13 2026
			1	RELEASED FOR RE-APPROVAL	Aug 26 2026

STRUCTURE:-PINELLAS SUNCOAST TRANSIT AUTHORITY
LOCATION:- CLEARWATER STATION,CLEARWATER,FL.
DETAILER:- VECTORSHADES LLC
CUSTOMER:- KOKOLAKIS
ARCH./ENG.:- CDM SMITH
DESCRIPTION:- PAVILION BUILDING FRAME DETAIL
DRAWN:- PBI DATE:-07-13-2026 CHK.D:-RAG DATE:- 07-13-2026

SHOP BILL	WORK ORDER NO.	DRWG. NO.
	2553	1716

SHIPPING LIST

MATERIAL BILL

ITEM NO	TOTAL QTY	DESCRIPTION	MAJOR MARK	PAINT CODE	TOTAL WEIGHT	ABM NO	UNIT QTY	LENGTH FT.	LENGTH IN.	MINOR MARK	REMARKS	UNIT WEIGHT	GRADE
	2	MISC	1717M	G	486						Galv	243	
	2	L8x4x1/2			467		1	11	11	1717M		234	A572-50
	16	RB5/8			14		8	0	9 13/16	rb907		1	A572-50
	8	PL1/4x3			5		4	0	3	p371		1	A572-50
	16	5/8 NUT					8			blt2	HHNT		A563

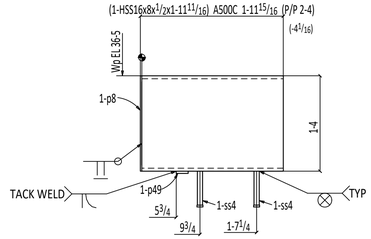

ONE BEAM 1718B-G

SHIPPING LIST / MATERIAL BILL

ITEM NO	TOTAL QTY	DESCRIPTION	MAJOR MARK	PAINT CODE	TOTAL WEIGHT	ABM NO	UNIT QTY	LENGTH FT.	LENGTH IN.	MINOR MARK	REMARKS	UNIT WEIGHT	GRADE
	ONE	BEAM	1718B	G	163						Galv	163	
	1	HSS16x8x1/2			150		1	1	11 11/16	1718B		150	A500C
	1	PL3/gx2			1		1	0	6	p49		1	A572-50
	1	PL1/4x8			9		1	1	4	p8		9	A572-50
	2	WS7/8			2		2	0	6	ss4		1	A108

Total weight : 163

REFERENCE :----

PAGE TOTALS

REVISION NO.

SPECIAL NOTES:-

1. SEAL ALL WELDS FOR GALVANIZE.

MATERIAL:-

ASTM: A36 U.N.O.
S. S.: -----
ALUM.: -----
PIPE: A53 GR.B
TUBES: A500 GR.B
HOLES: 13/16 U.N.O
WELDING: E70XX

MATERIAL PREP.:-

CLEAN: SSPC-SP2
SHOP PAINT: ------
GALV: GALVANIZED

GEN. NOTES:-

BUY AMERICAN:
DOMESTIC:
CERT/CONFORMANCE:
CERT/COMPLIANCE:

ALL WIDE FLANGE SHAPES TO BE PER A992-G50

FIELD CONNECTIONS :
HOLES : 13/16" U.N.O
PAINT :

morrow steel Fabricators, Inc.

3620 COPELAND DRIVE
ZEPHYRHILLS, FL. 33542

	PRINTS FOR	DATE	MK	REVISIONS	DATE
			0	RELEASED FOR APPROVAL	Jul 13 2026
			1	RELEASED FOR RE-APPROVAL	Aug 26 2026

STRUCTURE:- PINELLAS SUNCOAST TRANSIT AUTHORITY
LOCATION:- CLEARWATER STATION,CLEARWATER,FL.
DETAILER:- VECTORSHADES LLC
CUSTOMER:- KOKOLAKIS
ARCH./ENG.:- CDM SMITH
DESCRIPTION:- PAVILION BUILDING FRAME DETAIL
DRAWN:- PBI DATE:-07-13-2026 CHK.D:-RAG DATE:- 07-13-2026

SHOP BILL	WORK ORDER NO.	DRWG. NO.
	2553	1718

SHIPPING LIST

MATERIAL BILL

ITEM NO	TOTAL QTY	DESCRIPTION	MAJOR MARK	PAINT CODE	TOTAL WEIGHT	ABM NO	UNIT QTY	LENGTH FT.	LENGTH IN.	MINOR MARK	REMARKS	UNIT WEIGHT	GRADE
	6	MISC	1719M	G	52						Galv	9	
	6	L4x4x1/2			45		1	0	7	1719M		7	A572-50
	6	RB3/4			7		1	0	9	rb893		1	A572-50
	6	3/4 NUT					1			blt1	HHNT		A563

Total weight : 52

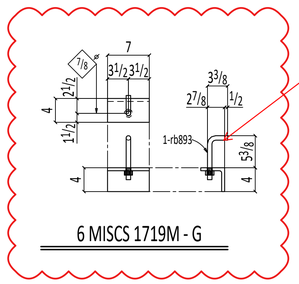

6 MISCS 1719M - G

Contractor to verify question in erection with hollow core mfr. If post-installed anchor is required, submit RFI with details (TYP)

REFERENCE :----

PAGE TOTALS

REVISION NO.

SPECIAL NOTES:-

MATERIAL:-

ASTM: A36 U.N.O.
S. S.: -----
ALUM.: -----
PIPE: A53 GR.B
TUBES: A500 GR.B
HOLES: 13/16 U.N.O
WELDING: E70XX

MATERIAL PREP.:-

CLEAN: SSPC-SP2
SHOP PAINT: ------
GALV: GALVANIZED

GEN. NOTES:-

BUY AMERICAN:
DOMESTIC:
CERT/CONFORMANCE:
CERT/COMPLIANCE:

ALL WIDE FLANGE SHAPES TO BE PER A992-G50

FIELD CONNECTIONS :
HOLES : 13/16" U.N.O
PAINT :

morrow steel Fabricators, Inc.

3620 COPELAND DRIVE
ZEPHYRHILLS, FL. 33542

	PRINTS FOR	DATE	MK	REVISIONS	DATE
			0	RELEASED FOR APPROVAL	Jul 13 2026
			1	RELEASED FOR RE-APPROVAL	Aug 26 2026

STRUCTURE:- PINELLAS SUNCOAST TRANSIT AUTHORITY
LOCATION:- CLEARWATER STATION,CLEARWATER,FL.
DETAILER:- VECTORSHADES LLC
CUSTOMER:- KOKOLAKIS
ARCH./ENG.:- CDM SMITH
DESCRIPTION:- PAVILION BUILDING FRAME DETAIL
DRAWN:- PBI DATE:-07-13-2026 CHK.D:-RAG DATE:- 07-13-2026

SHOP BILL	WORK ORDER NO.	DRWG. NO.
	2553	1719

SHIPPING LIST

ITEM NO	TOTAL QTY	DESCRIPTION	MAJOR MARK	PAINT CODE	TOTAL WEIGHT
	2	BEAM	1720B	G	353
	2	W8x24			324
	8	L4x4x$^{1}/_{4}$			24
	8	$^{3}/_{4}$ Dia A325N			5
		FIELD BOLTS			
	16	$^{5}/_{8}$ DIA HILTI HIT HY-270			
		ADHESIVE ANCHORS			

Total weight : 353

MATERIAL BILL

ABM NO	UNIT QTY	LENGTH FT.	LENGTH IN.	MINOR MARK	REMARKS	UNIT WEIGHT	GRADE
	1	6	9	1720B		162	A992
	4	0	$5^{1}/_{2}$	a65		3	A572-50
	4	0	2		+1HD WASH	1	
	8	0	$7^{1}/_{2}$		(6" EMBEDMENT)		

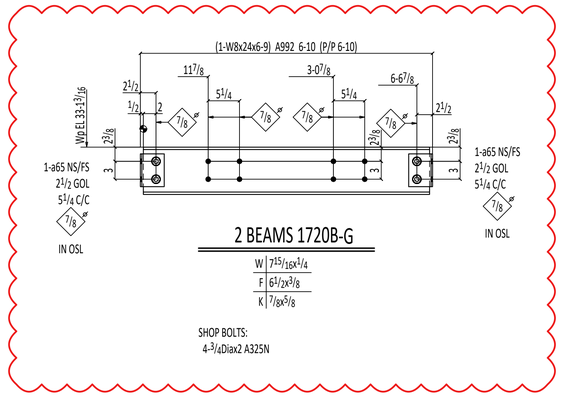

REFERENCE :----

PAGE TOTALS | REVISION NO.

SPECIAL NOTES:-

MATERIAL:-

ASTM: A36 U.N.O.
S. S.: -----
ALUM.: -----
PIPE: A53 GR.B
TUBES: A500 GR.B
HOLES: $^{13}/_{16}$ U.N.O
WELDING: E70XX

MATERIAL PREP.:-

CLEAN: SSPC-SP2
SHOP PAINT: ------
GALV: GALVANIZED

GEN. NOTES:-

BUY AMERICAN:
DOMESTIC:
CERT/CONFORMANCE:
CERT/COMPLIANCE:

ALL WIDE FLANGE SHAPES TO BE PER A992-G50

FIELD CONNECTIONS :
HOLES : $^{13}/_{16}$" U.N.O
PAINT :

morrow steel Fabricators, Inc.

3620 COPELAND DRIVE
ZEPHYRHILLS, FL. 33542

	PRINTS FOR	DATE	MK	REVISIONS	DATE
			0	RELEASED FOR APPROVAL	Aug 26 2026

STRUCTURE:-PINELLAS SUNCOAST TRANSIT AUTHORITY
LOCATION:- CLEARWATER STATION,CLEARWATER,FL.

DETAILER:- VECTORSHADES LLC
CUSTOMER:- KOKOLAKIS
ARCH./ENG.:- CDM SMITH
DESCRIPTION:-BEAM DETAIL
DRAWN:- PBI DATE:-08-26-2026 CHK.D:-RAG DATE:- 08-26-2026

SHOP BILL	WORK ORDER NO.	DRWG. NO.
	2553	1720

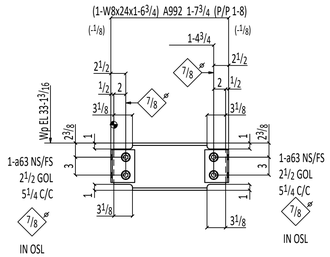

2 BEAMS 1721B-G

W	$7^{15}/_{16}x^{1}/_{4}$
F	$6^{1}/_{2}x^{3}/_{8}$
K	$^{7}/_{8}x^{5}/_{8}$

SHOP BOLTS:
4-$^{3}/_{4}$Diax2 A325N

SHIPPING LIST

ITEM NO	TOTAL QTY	DESCRIPTION	MAJOR MARK	PAINT CODE	TOTAL WEIGHT	ABM NO
	2	BEAM	1721B	G	104	
	2	W8x24			75	
	8	L4x4x$^{3}/_{4}$			24	
	8	$^{3}/_{4}$ Dia A325N			5	
		FIELD BOLTS				
	16	$^{3}/_{4}$ Dia A325N				

Total weight : 104

MATERIAL BILL

ITEM NO	UNIT QTY	LENGTH FT.	LENGTH IN.	MINOR MARK	REMARKS	UNIT WEIGHT	GRADE
						52	
	1	1	$6^{3}/_{4}$	1721B		38	A992
	4	0	$5^{1}/_{2}$	a63		3	A572-50
	4	0	2		+1HD WASH	1	
		0	$1^{3}/_{4}$		+1HD WASH		

REFERENCE :----

PAGE TOTALS

REVISION NO.

SPECIAL NOTES:-

MATERIAL:-
ASTM: A36 U.N.O.
S. S.: -----
ALUM.: -----
PIPE: A53 GR.B
TUBES: A500 GR.B
HOLES: $^{13}/_{16}$ U.N.O
WELDING: E70XX

MATERIAL PREP.:-
CLEAN: SSPC-SP2
SHOP PAINT: ------
GALV: GALVANIZED

GEN. NOTES:-
BUY AMERICAN:
DOMESTIC:
CERT/CONFORMANCE:
CERT/COMPLIANCE:

ALL WIDE FLANGE SHAPES TO BE PER A992-G50

FIELD CONNECTIONS :
HOLES : $^{13}/_{16}$" U.N.O
PAINT :

morrow steel Fabricators, Inc.

3620 COPELAND DRIVE
ZEPHYRHILLS, FL. 33542

	PRINTS FOR	DATE	MK	REVISIONS	DATE
			0	RELEASED FOR APPROVAL	Aug 26 2026

STRUCTURE:- PINELLAS SUNCOAST TRANSIT AUTHORITY
LOCATION:- CLEARWATER STATION,CLEARWATER,FL.
DETAILER:- VECTORSHADES LLC
CUSTOMER:- KOKOLAKIS
ARCH./ENG.:- CDM SMITH
DESCRIPTION:- BEAM DETAIL
DRAWN:- PBI DATE:- 08-26-2026 CHK.D:- RAG DATE:- 08-26-2026

SHOP BILL	WORK ORDER NO.	DRWG. NO.
	2553	1721

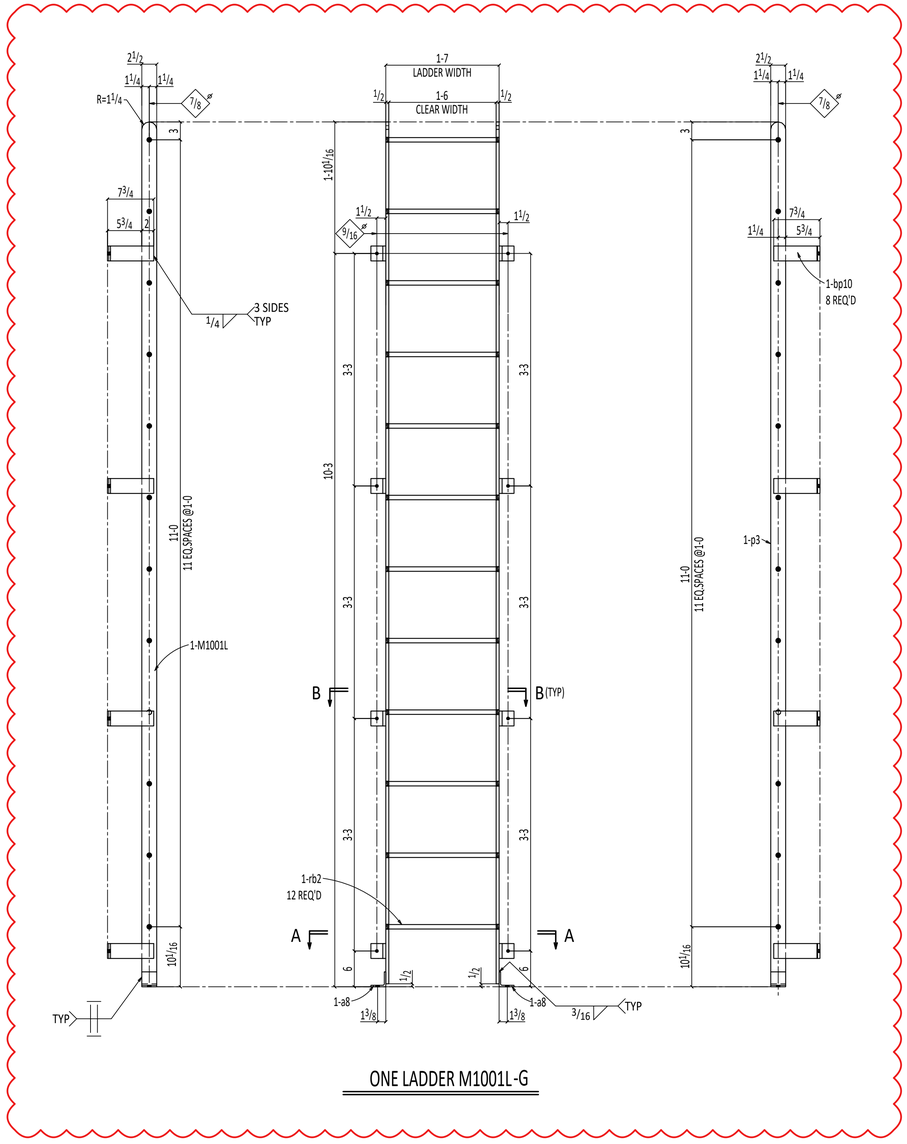

ONE LADDER M1001L-G

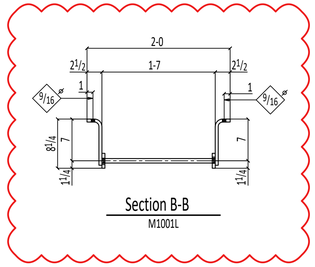

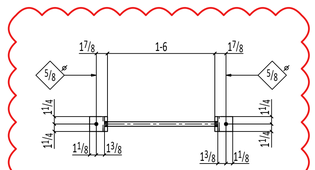

SHIPPING LIST

MATERIAL BILL

ITEM NO	TOTAL QTY	DESCRIPTION	MAJOR MARK	PAINT CODE	TOTAL WEIGHT	ABM NO	UNIT QTY	LENGTH FT.	LENGTH IN.	MINOR MARK	REMARKS	UNIT WEIGHT	GRADE
	ONE	LADDER	M1001L	G	156						Galv	156	
	1	PL 1/2x2 1/2			50		1	12	0 9/16	M1001L		50	A572-50
	2	L2 1/2x2 1/2x1/4			2		2	0	2 1/2	a8		1	A572-50
	12	RB 3/4			28		12	1	6 1/2	rb2		2	A572-50
	1	PL 1/2x2 1/2			50		1	12	0 9/16	p3		50	A572-50
	8	BPL 1/2x9 5/16			26		8	0	2 1/2	bp10	BENT	3	A572-50
		FIELD BOLTS											
	2	1/2 Dia HILTI KWIK BOLT TZ2						0	7		GALV		
		SS304 WEDGE ANCHOR											
	8	5/16 Dia LINDAPTER HOLLO BOLT						0	2		GALV		

Total weight 156

REFERENCE :----

PAGE TOTALS

REVISION NO.

SPECIAL NOTES:-

1. SEAL ALL WELDS FOR GALVANIZE.

MATERIAL:-

ASTM:	A36 U.N.O.
S. S.:	-----
ALUM.:	-----
PIPE:	A53 GR.B
TUBES:	A500 GR.B
HOLES:	13/16 U.N.O
WELDING:	E70XX

MATERIAL PREP.:-

CLEAN:	SSPC-SP2
SHOP PAINT:	

GALV: GALVANIZED

GEN. NOTES:-

BUY AMERICAN:

DOMESTIC:

CERT/CONFORMANCE:

CERT/COMPLIANCE:

ALL WIDE FLANGE SHAPES TO BE PER A992-G50

FIELD CONNECTIONS :

HOLES : 13/16" U.N.O

PAINT :

morrow steel Fabricators, Inc.

3620 COPELAND DRIVE
ZEPHYRHILLS, FL. 33542

	PRINTS FOR	DATE	MK	REVISIONS	DATE
			0	RELEASED FOR APPROVAL	Nov 18 2025
			1	RELEASED FOR RE-APPROVAL	Jul 13 2026
			2	RELEASED FOR RE-APPROVAL	Aug 26 2026

STRUCTURE:-PINELLAS SUNCOAST TRANSIT AUTHORITY
LOCATION:- CLEARWATER STATION,CLEARWATER,FL.
DETAILER:- VECTORSHADES LLC
CUSTOMER:- KOKOLAKIS
ARCH./ENG.:- CDM SMITH
DESCRIPTION:-WAITING PAVILION LADDER DETAIL
DRAWN:- PBI DATE:- 10-27-2025 CHK.D:-RAG DATE:- 10-27-2025

SHOP BILL	WORK ORDER NO.	DRWG. NO.
	2553	M1001 2

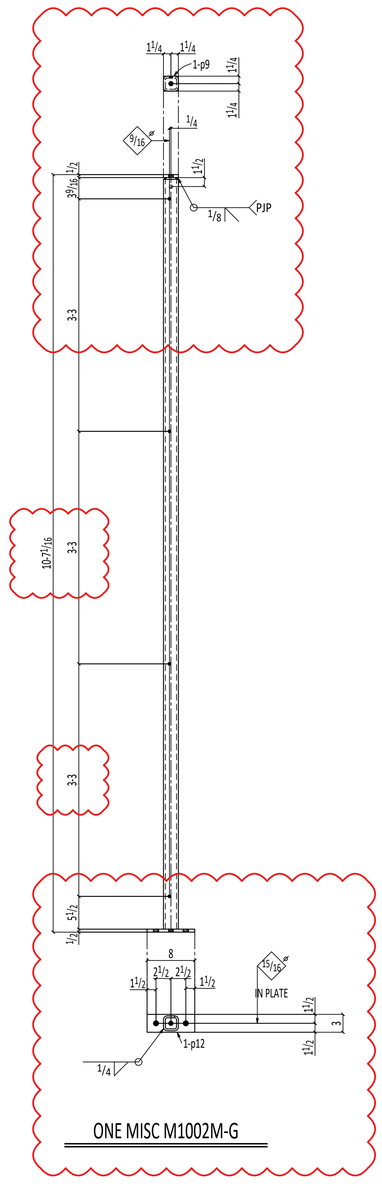

ONE MISC M1002M-G

SHIPPING LIST

MATERIAL BILL

ITEM NO	TOTAL QTY	DESCRIPTION	MAJOR MARK	PAINT CODE	TOTAL WEIGHT	ABM NO	UNIT QTY	LENGTH FT.	LENGTH IN.	MINOR MARK	REMARKS	UNIT WEIGHT	GRADE
	ONE	MISC	M1002M	G	93						Galv	93	
	1	HSS2 1/2X2 1/2X5/16			89		1	10	6 1/16	M1002M		89	A500C
	1	PL 1/2X8			3		1	0	3	p12		3	A572-50
	1	PL 1/2X2 1/2			1		1	0	2 1/2	p9		1	A572-50
		FIELD BOLTS											
	2	3/4 Dia ADHESIVE						0	8		6" EMBEDMENT		

Total weight 93

REFERENCE :----

PAGE TOTALS

REVISION NO.

SPECIAL NOTES:-

MATERIAL:-

ASTM: A36 U.N.O.
S. S.: -----
ALUM.: -----
PIPE: A53 GR.B
TUBES: A500 GR.B
HOLES: 13/16 U.N.O
WELDING: E70XX

MATERIAL PREP.:-

CLEAN: SSPC-SP2
SHOP PAINT:
GALV: GALVANIZED

GEN. NOTES:-

BUY AMERICAN:
DOMESTIC:
CERT/CONFORMANCE:
CERT/COMPLIANCE:

ALL WIDE FLANGE SHAPES TO BE PER A992-G50

FIELD CONNECTIONS :
HOLES : 13/16" U.N.O
PAINT :

morrow steel Fabricators, Inc.

3620 COPELAND DRIVE
ZEPHYRHILLS, FL. 33542

	PRINTS FOR	DATE	MK	REVISIONS	DATE
			0	RELEASED FOR APPROVAL	Nov 18 2025
			1	RELEASED FOR RE-APPROVAL	Jul 13 2026
			2	RELEASED FOR RE-APPROVAL	Aug 26 2026

STRUCTURE:- PINELLAS SUNCOAST TRANSIT AUTHORITY
LOCATION:- CLEARWATER STATION,CLEARWATER,FL.
DETAILER:- VECTORSHADES LLC
CUSTOMER:- KOKOLAKIS
ARCH./ENG.:- CDM SMITH
DESCRIPTION:- WAITING PAVILION MISC DETAIL
DRAWN:- PBI DATE:-10-27-2025 CHK.D:-RAG DATE:- 10-27-2025

SHOP BILL	WORK ORDER NO.	DRWG. NO.
	2553	M1002

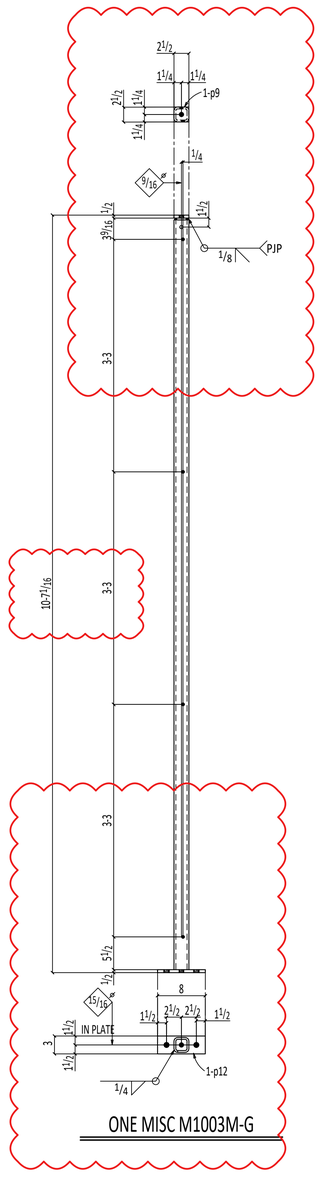

ONE MISC M1003M-G

SHIPPING LIST

MATERIAL BILL

ITEM NO	TOTAL QTY	DESCRIPTION	MAJOR MARK	PAINT CODE	TOTAL WEIGHT	ABM NO	UNIT QTY	LENGTH FT.	LENGTH IN.	MINOR MARK	REMARKS	UNIT WEIGHT	GRADE
	ONE	MISC	M1003M	G	93						Galv	93	
	1	HSS2 1/2 x2 1/2 x5/16			89		1	10	6 1/16	M1003M		89	A500C
	1	PL 1/2 x8			3		1	0	3	p12		3	A572-50
	1	PL 1/2 x2 1/2			1		1	0	2 1/2	p9		1	A572-50
		FIELD BOLTS											
	2	3/4 Dia ADHESIVE						0	8		6" EMBEDMENT		

Total weight 93

REFERENCE :----

PAGE TOTALS

REVISION NO.

SPECIAL NOTES:-

1. SEAL ALL WELDS FOR GALVANIZE.
2. ALL VENT HOLES TO BE PLUGGED AFTER GALVANIZING.

MATERIAL:-

ASTM:	A36 U.N.O.
S. S.:	-----
ALUM.:	-----
PIPE:	A53 GR.B
TUBES:	A500 GR.B
HOLES:	13/16 U.N.O
WELDING:	E70XX

MATERIAL PREP.:-

CLEAN:	SSPC-SP2
SHOP PAINT:	

GALV:	GALVANIZED

GEN. NOTES:-

BUY AMERICAN:	
DOMESTIC:	
CERT/CONFORMANCE:	
CERT/COMPLIANCE:	

ALL WIDE FLANGE SHAPES TO BE PER A992-G50

FIELD CONNECTIONS :

HOLES : 13/16" U.N.O

PAINT :

morrow steel Fabricators, Inc.

3620 COPELAND DRIVE
ZEPHYRHILLS, FL. 33542

	PRINTS FOR	DATE	MK	REVISIONS	DATE
			0	RELEASED FOR APPROVAL	Nov 18 2025
			1	RELEASED FOR RE-APPROVAL	Jul 13 2026
			2	RELEASED FOR RE-APPROVAL	Aug 26 2026

STRUCTURE:- PINELLAS SUNCOAST TRANSIT AUTHORITY
LOCATION:- CLEARWATER STATION,CLEARWATER,FL.
DETAILER:- VECTORSHADES LLC
CUSTOMER:- KOKOLAKIS
ARCH./ENG.:- CDM SMITH
DESCRIPTION:- WAITING PAVILION MISC DETAIL
DRAWN:- PBI DATE:- 10-27-2025 CHK.D:- RAG DATE:- 10-27-2025

SHOP BILL	WORK ORDER NO.	DRWG. NO.
	2553	M1003 ⚠

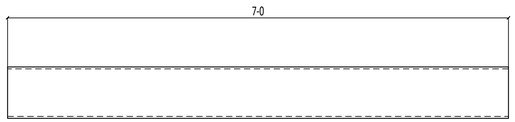

26 BOLLARDS M1011M-G

SHIPPING LIST

MATERIAL BILL

ITEM NO	TOTAL QTY	DESCRIPTION	MAJOR MARK	PAINT CODE	TOTAL WEIGHT	ABM NO	UNIT QTY	LENGTH FT.	LENGTH IN.	MINOR MARK	REMARKS	UNIT WEIGHT	GRADE
	26	BOLLARD	M1011M	G	5205						Galv	200	
	26	PI 8 SCH40			5205		1	7	0	M1011M		200	A53

Total weight : 5205

REFERENCE :----

PAGE TOTALS

REVISION NO.

SPECIAL NOTES:-

MATERIAL:-

ASTM: A36 U.N.O.
S. S.: -----
ALUM.: -----
PIPE: A53 GR.B
TUBES: A500 GR.B
HOLES: 13/16 U.N.O
WELDING: E70XX

MATERIAL PREP.:-

CLEAN: SSPC-SP2
SHOP PAINT:
GALV: GALVANIZED

GEN. NOTES:-

BUY AMERICAN:
DOMESTIC:
CERT/CONFORMANCE:
CERT/COMPLIANCE:

ALL WIDE FLANGE SHAPES TO BE PER A992-G50

FIELD CONNECTIONS :
HOLES : 13/16" U.N.O
PAINT :

morrow steel Fabricators, Inc.

3620 COPELAND DRIVE
ZEPHYRHILLS, FL. 33542

	PRINTS FOR	DATE	MK	REVISIONS	DATE
			0	RELEASED FOR APPROVAL	Nov 18 2025
			1	RELEASED FOR RE-APPROVAL	Jul 13 2026
			2	RELEASED FOR RE-APPROVAL	Aug 26 2026

STRUCTURE:- PINELLAS SUNCOAST TRANSIT AUTHORITY
LOCATION:- CLEARWATER STATION,CLEARWATER,FL.
DETAILER:- VECTORSHADES LLC
CUSTOMER:- KOKOLAKIS
ARCH./ENG.:- CDM SMITH
DESCRIPTION:- WAITING PAVILION MISC DETAIL
DRAWN:- PBI DATE:-10-27-2025 CHK.D:-RAG DATE:- 10-27-2025

SHOP BILL	WORK ORDER NO.	DRWG. NO.
	2553	M1011

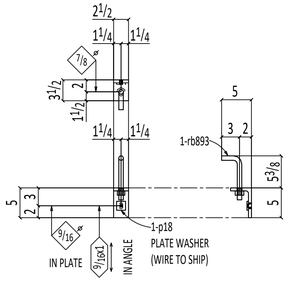

2 MISCS M1012M - G

SHIPPING LIST

MATERIAL BILL

ITEM NO	TOTAL QTY	DESCRIPTION	MAJOR MARK	PAINT CODE	TOTAL WEIGHT	ABM NO	UNIT QTY	LENGTH FT.	LENGTH IN.	MINOR MARK	REMARKS	UNIT WEIGHT	GRADE
	2	MISC	M1012M	G	8						Galv	4	
	2	L5x3 1/2x1/2			6		1	0	2 1/2	M1012M		3	A572-50
	2	RB 3/4			2		1	0	9	rb893		1	A572-50
	2	PL 1/4x1 1/2			0		1	0	1 1/2	p18		0	A572-50
	2	3/4 NUT					1			blt1	HHNT		A563
		FIELD BOLTS											
	2	1/2 Dia HOLLO BOL						0	2 3/4		+1HD WASH		

Total weight : 8

REFERENCE :----

PAGE TOTALS

REVISION NO.

SPECIAL NOTES:-

MATERIAL:-

ASTM: A36 U.N.O.
S. S.: -----
ALUM.: -----
PIPE: A53 GR.B
TUBES: A500 GR.B
HOLES: 13/16 U.N.O
WELDING: E70XX

MATERIAL PREP.:-

CLEAN: SSPC-SP2
SHOP PAINT:
GALV: GALVANIZED

GEN. NOTES:-

BUY AMERICAN:
DOMESTIC:
CERT/CONFORMANCE:
CERT/COMPLIANCE:

ALL WIDE FLANGE SHAPES TO BE PER A992-G50

FIELD CONNECTIONS :
HOLES : 13/16" U.N.O
PAINT :

morrow steel Fabricators, Inc.

3620 COPELAND DRIVE
ZEPHYRHILLS, FL. 33542

	PRINTS FOR	DATE	MK	REVISIONS	DATE
			0	RELEASED FOR APPROVAL	Jul 13 2026
			1	RELEASED FOR RE-APPROVAL	Aug 26 2026

STRUCTURE:- PINELLAS SUNCOAST TRANSIT AUTHORITY
LOCATION:- CLEARWATER STATION,CLEARWATER,FL.
DETAILER:- VECTORSHADES LLC
CUSTOMER:- KOKOLAKIS
ARCH./ENG.:- CDM SMITH
DESCRIPTION:- WAITING PAVILION MISC DETAIL
DRAWN:- PBI DATE:-10-27-2025 CHK.D:-RAG DATE:- 10-27-2025

SHOP BILL	WORK ORDER NO.	DRWG. NO.
	2553	M1012 ⚠

Lanning Chemical
Fast Dry Universal
Primer Series
The Steel Fabricators #1 Choice

Product Data Sheet

Lanning's universal primers series are fast dry corrosion inhibitive, alkyd metal primers. These products may be top coated universally, including epoxies, polyurethanes, water based acrylic enamels as well as conventional coatings. Will meet or exceed the specifications set forth in SSPC Specs #15 and 25 and MPI 79. Can be applied as a dryfall primer as well as dry fall finish.

Product Highlights

- Very Fast Drying
- Rust Inhibitive
- Good Adhesion & Hardness
- HAPS FREE
- Low Odor
- VOC 2.8 lbs./gal
- May be top-coated with high performance coatings
- Approved primer for intumescent fireproofing
- This product meets or exceeds MPI #79
- Meets or exceeds SSPC Paint Spec 15 and 25
- Dry Fall Coating
- Heat resistant up to 400° F

End Use Markets

- Industrial Equipment
- Metal Fabrication
- Structural Steel
- Dry Fall

Product Codes

- LB-87 (Red)
- LB-90 (Gray)
- LB-99 (White)
- LB-92 (Black)
- LB-261 (Dark Gray)
- LB-359 (Gray)
- LB-361 (White)
- LB-289 (RAL 7035)
- Custom colors, sheens and dry times can be formulated

Properties	Value
Vehicle	Modified Alkyd
Volume Solids	56% ± 2%
Solids by Weight	78% ± 2%
Density	12.5 ± .2lbs./gal
Coverage per Gallon	350-450 Sq. Ft.
Dry Time	To Touch- 7-10 Minutes @ 3 mils 70° F To Recoat- 30 Minutes To Topcoat- 2 hours minimum
Viscosity	65-70 KU
Gloss/Sheen	Eggshell
Recommended Dry Film Thickness	1.5-2.0 mils
Flash Point	45° F
Reduction Solvent	Naptha or Xylene
Color	Red, Gray, Black, White, Dark Gray, Custom Colors Available
Application	Conventional, HVLP, Airless,
VOC	2.8 lbs./gal 335 g/l

Substrates & Surface Preparation

General | Surfaces must be clean and dry. Surfaces must be free of dirt, dust, oil and all other contaminants that could interfere with adhesion of the coating

Steel | SSPC-SP6 with a 1.0-2.0 mil surface profile for maximum protection. SSPC-SP2 or SP3 as minimum requirement.

Mixing & Thinning

Mixing | Power Mix until uniform consistency.

Thinning | Naptha or Xylene

To Reduce overspray use Lanning SR-160

APPLICATION EQUIPMENT GUIDELINES

Listed below are general equipment guidelines for the application of this product. Job site conditions may require modifications to these guidelines to achieve the desired results.

Conventional Spray	Pressure pot equipped with dual regulators, 3/8” minimum material hose, .052” fluid tip and appropriate air cap.
Airless Spray	Pump Ratio: 30:1 (minimum) GPM Output: 3.0 (minimum) Material Hose: 3/8” I.D. (minimum) Tip Size: 0.013” - 0.017” Output PSI: 2000-2300
Electrostatic	Use Lanning LR-72
Brush & Roller	Use a natural bristle brush and a short-nap synthetic roller cover

APPLICATION CONDITIONS

Condition	Material	Surface	Ambient	Humidity
Minimum	35°F	35°F	35°F	0%
Maximum	120°F	120°F	120°F	90%

CLEANUP & SAFETY

Cleanup	Use Xylene or Naptha.
Safety	Read and follow all caution statements on this product data sheet and on the SDS for this product. Employ normal safety precautions. Wear protective clothing, and gloves. A protective cream is recommended for all exposed skin areas.
Ventilation	When used in enclosed areas, thorough air circulation must be used during and after application until the coating is cured. The ventilation system should be capable of preventing the solvent vapor concentration from reaching the lower explosion limit for the solvents used. User should test and monitor exposure levels to insure all personnel are below guidelines. If not sure or if not able to monitor levels, use MSHA/NIOSH approved respirator.
Caution	This product contains flammable solvents. Keep away from sparks and open flames. All electrical equipment and installations should be made and grounded in accordance with the National Electric Code. In areas where explosion hazards exist, workers should be required to use non-ferrous tools and wear conductive and non-sparking shoes.

Shelf Life five years unopened

ZRC Worldwide
INNOVATIVE ZINC TECHNOLOGIES

Outline Specifications for
ZRC GALVILITE GALVANIZING COMPOUND

By ZRC Worldwide
145 Enterprise Drive, Marshfield, MA 02050
Tel: 781-319-0400; Fax: 781-319-0404; E-mail: info@zrcworldwide.com
Web: www.zrcworldwide.com

For use with **SECTIONS 05 00 00 METALS or 09 00 00 FINISHES**

A. PROJECT INCLUDES

1. Cold galvanizing of structural steel members, assemblies and metal fabrications as an equivalent to hot-dip galvanizing and repair of hot-dip galvanizing.

B. PRODUCTS

1. Cold Galvanizing Compound: Premixed liquid organic zinc compound, ZRC Galvilite Galvanizing Compound by ZRC Worldwide Complying with the following:

   a. Metallic zinc content, 95 percent by weight in dry film.
   b. Solids content, 52 percent by volume.
   c. Application rate, 1.5 mils dry film thickness per coat.
   d. Number of coats required, 2.
   e. Shiny grey finish, ZRC Galvilite Galvanizing Compound.

END OF SECTION

Outline specifications are presented in the CSI Format for outline specifications and are compatible with the Master Outline Specifications published by the American Institute of Architects. They are intended for use by architects and engineers preparing specifications for construction projects.

For outline specifications, use the text provided and edit to your project requirements. For full specifications using CSI Format, insert the products specified in your office master spec under Part 2 – Products, in the appropriate section, and add/edit as necessary for your project requirements. Call the telephone number listed for additional information, as needed.

All contents © 2005, ZRC Worldwide. All rights Reserved.

Outline Specifications for
ZRC COLD GALVANIZING COMPOUND and
ZRC GALVILITE
By ZRC Worldwide
145 Enterprise Drive, Marshfield, MA 02050
Tel: 781-319-0400; Fax: 781-319-0404; E-mail: info@zrcworldwide.com
Web: www.zrcworldwide.com

For use with SECTION 05500 – METAL FABRICATIONS or SECTION 09800 – SPECIAL COATINGS

A. PROJECT INCLUDES

1. Cold galvanizing of structural steel members, assemblies and metal fabrications as an equivalent to hot-dip galvanizing and repair of hot-dip galvanizing.

B. PRODUCTS

1. Cold Galvanizing Compound: Premixed liquid organic zinc compound, ZRC Galvanizing Compound and ZRC Galvilite by ZRC Worldwide Complying with the following:

   a. Metallic zinc content, 95 percent by weight in dry film.
   b. Solids content, 52 percent by volume.
   c. Application rate, 1.5 mils dry film thickness per coat.
   d. Number of coats required, 2.
   e. Flat grey finish, ZRC Cold Galvanizing Compound.
   f. Shiny grey finish, ZRC Galvilite.

END OF SECTION

Outline specifications are presented in the CSI Format for outline specifications and are compatible with the Master Outline Specifications published by the American Institute of Architects. They are intended for use by architects and engineers preparing specifications for construction projects.

For outline specifications, use the text provided and edit to your project requirements. For full specifications using CSI Format, insert the products specified in your office master spec under Part 2 – Products, in the appropriate section, and add/edit as necessary for your project requirements. Call the telephone number listed for additional information, as needed.

WPS

Morrow Steel Erectors, Inc. Approved By: TREGAN

WPS# MSE3000 Date: 5/29/2024
WPS Rev# Rev Date:

Welding Process SMAW Type: MANUAL
(Manual, Semi Auto, etc)

Joints

Joint Type: B-P1b
Backing: N
Groove Angle:
Root Opening Radius: 1/8" +/-1/16"
Root Face: 1/4"
Backgouging? N
Backgouging Method:

Joint Detail

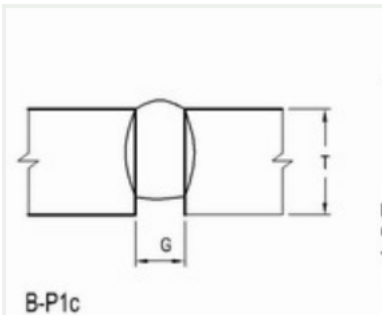

Base Metals

M-No. 1 GRP # II
Spec Type & Grade ASTM A36

Thickness Range of Base Metal: Groove 1/4"MAX Fillet
Pipe Dia Range: Groove: Fillet
Other Notes:

Filler Metals

Filler Metal F-No. F4
AWS Classification E7018
Filler Metal Size 1/8"
AWS Spec A5.1

Shielding

Flux SELF
Gas Composition:
Electrode Flux Class Flow Rate:
Gas Cup Size:

Firgure F.2

WPS

Pre Heat/Post Heat

Pre Heat Temp:	32 MIN	Table#	3.30		
Interpass Temp:	32 MIN				
Post Heat Applicable?	N	Post Heat Temps		Time	

Positions

Position of Groove	F	Weld Progression	L-R
Position of Fillet			

Electrical Characteristics

Current Type/Polarity	DCEP	Tungsten Electrode Size/Type	
Pulse	N	Pulsing Parameters	
Current	90-150	Transfer Mode	GLOBLAR
Voltage	24-28	Other Notes	
WFS			

Other Variables

Cup or Nozzle size			
Cleaning Method	CHIP/BRUSH/GRIND		
Number of Electrodes			
Technique	STRINGER	(Stringer or Weave)	
Single Pass	Y		
Multipass		Interpass Cleaning	
Contact Tip to Work Distance			
Other Notes			

Welding Parameters

		Filler Metal		Electrical			
Layers	Process	Class	Diameter	Type and Polarity	Current Range	Voltage Range	Travel Speed
	SMAW	4	1/8"	DCEP	90-150	24-28	

Firgure F.2

B	ASTM A36		SMAW with low-hydrogen electrodes, SAW, GMAW, FCAW	1/8 to 3/4 incl.	3 to 20 incl.	32[a]	0[a]
	ASTM A53	Grade B		Over 3/4 thru 1-1/2 incl.	Over 20 thru 38 incl.	50	10
	ASTM A106	Grade B		Over 1-1/2 thru 2-1/2 incl.	Over 38 thru 65 incl.	150	65
	ASTM A131	Grades A, B, CS, D, DS, E AH 32 & 36 DH 32 & 36 EH 32 & 36		Over 2-1/2	Over 65	225	110
	ASTM A139	Grade B					
	ASTM A381	Grade Y35					
	ASTM A441						
	ASTM A500	Grade A Grade B Grade C					
	ASTM A501	Grades A and B					
	ASTM A516	Grades 55 & 60 65 & 70					
	ASTM A524	Grades I & II					
	ASTM A529	Grades 50 & 55					

Firgure F.2

Firgure F.2

Firgure F.2

Firgure F.2

WPS

Morrow Steel Fabricators, Inc. Approved By: Tom R

WPS# MSF1000 Date: 5/1/2023
WPS Rev# Rev Date:

Welding Process FCAW Type: SEMI
(Manual, Semi Auto, etc)

Joints

Joint Type: 1G
Backing: Y
Groove Angle: 30-45 DEG
Root Opening Radius: 0
Root Face: 3/16" TO 1/4"
Backgouging? N
Backgouging Method:

Joint Detail

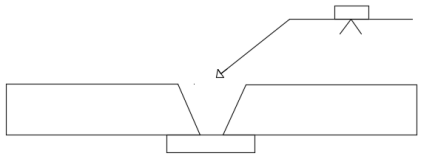

Base Metals

M-No. GRP # II
Spec Type & Grade A36

Thickness Range of Base Metal: Groove 1/8" - 3/4" Fillet
Pipe Dia Range: Groove: Fillet
Other Notes:

Filler Metals

Filler Metal F-No.
AWS Classification E71-T-1
Filler Metal Size .045"
AWS Spec A5.20

Shielding

Flux
Gas CO2 Composition: 100
Electrode Flux Class Flow Rate: 30-40CFH
Gas Cup Size: 0.625"

Firgure F.2

WPS

Pre Heat/Post Heat

Pre Heat Temp:	32 DEGREES MIN	Table#	3.3		
Interpass Temp:	32 DEGREES MIN				
Post Heat Applicable?	N	Post Heat Temps		Time	

Positions

Position of Groove	1G	Weld Progression	L-R/R-L
Position of Fillet			

Electrical Characteristics

Current Type/Polarity	DCEP	Tungsten Electrode Size/Type	
Pulse	N	Pulsing Parameters	
Current	190-230	Transfer Mode	GLOBLAR
Voltage	24-28	Other Notes	
WFS	250-350		

Other Variables

Cup or Nozzle size			
Cleaning Method	CHIP/BRUSH/GRIND		
Number of Electrodes			
Technique	STRINGER	(Stringer or Weave)	
Single Pass	N		
Multipass	Y	Interpass Cleaning	Chip/Brush/Grind
Contact Tip to Work Distance			
Other Notes			

Welding Parameters

		Filler Metal		Electrical			
Layers	Process	Class	Diameter	Type and Polarity	Current Range	Voltage Range	Travel Speed
Root	FCAW		.045"	DCEP	190-230	24-28	3.5-6IPM
Filler	FCAW		.045"	DCEP	190-231	24-29	3.5-6IPM
Cap Pass	FCAW		.045"	DCEP	190-232	24-30	3.5-6IPM

Firgure F.2

WPS

Morrow Steel Fabricators, Inc. Approved By: Tom R

WPS# MSF1300 Date: 5/1/2023
WPS Rev# 3 Rev Date: 5/28/2024

Welding Process FCAW Type: SEMI
(Manual, Semi Auto, etc)

Joints

Joint Type: T
Backing: N
Groove Angle: N/A
Root Opening Radius: N/A
Root Face: N/A
Backgouging? N
Backgouging Method:

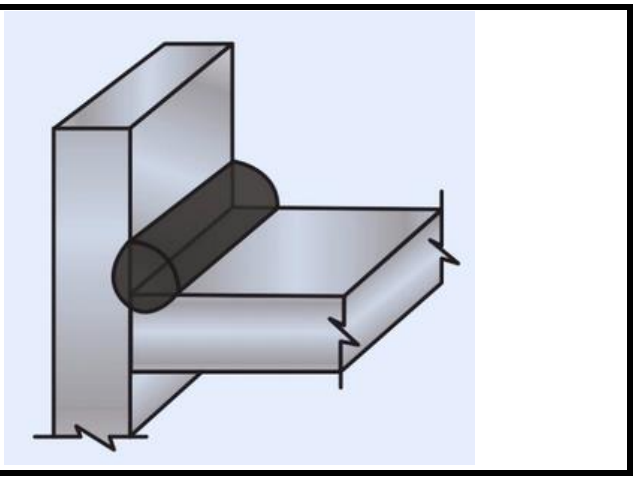

Base Metals

M-No. GRP # II
Spec Type & Grade A36

Thickness Range of Base Metal: Groove Fillet 1/8"-3/4"
Pipe Dia Range: Groove: Fillet
Other Notes:

Filler Metals

Filler Metal F-No. 6
AWS Classification E71T-1C-H8
Filler Metal Size .045"
AWS Spec A5.5A5.20

Shielding

Flux DUAL
Gas CO2 Composition: 100
Electrode Flux Class Flow Rate: 6.5CFM
Gas Cup Size: .625"

Firgure F.2

WPS

Pre Heat/Post Heat

Pre Heat Temp:	MIN 32 F	Table#	3.3B		
Interpass Temp:	MIN 32 F				
Post Heat Applicable?	NO	Post Heat Temps		Time	

Positions

Position of Groove		Weld Progression	L-R, R-L
Position of Fillet	2F		

Electrical Characteristics

Current Type/Polarity	DCEP	Tungsten Electrode Size/Type	
Pulse	N	Pulsing Parameters	
Current	190-230	Transfer Mode	GLOBLAR
Voltage	24-28	Other Notes	
WFS	250-350		

Other Variables

Cup or Nozzle size			
Cleaning Method	CHIP/BRUSH/GRIND		
Number of Electrodes	1		
Technique	STRINGER	(Stringer or Weave)	
Single Pass			
Multipass	x	Interpass Cleaning	Y
Contact Tip to Work Distance	1/16"-1/4"		
Other Notes			

Welding Parameters

		Filler Metal		Electrical			
Layers	Process	Class	Diameter	Type and Polarity	Current Range	Voltage Range	Travel Speed
Root Pass	FCAW	AWS	.045"	DCEP	190-230	24-28	3.5-6IPM
Cap Pass	FCAW	AWS	.045"	DCEP	190-230	24-28	3.5-6IPM

Firgure F.2

AWS TABLE 3.3

B	ASTM A36		SMAW with low-hydrogen electrodes, SAW, GMAW, FCAW	1/8 to 3/4 incl.	3 to 20 incl.	32[a]	0[a]
	ASTM A53	Grade B		Over 3/4 thru 1-1/2 incl.	Over 20 thru 38 incl.	50	10
	ASTM A106	Grade B		Over 1-1/2 thru 2-1/2 incl.	Over 38 thru 65 incl.	150	65
	ASTM A131	Grades A, B, CS, D, DS, E AH 32 & 36 DH 32 & 36 EH 32 & 36		Over 2-1/2	Over 65	225	110
	ASTM A139	Grade B					
	ASTM A381	Grade Y35					
	ASTM A441						
	ASTM A500	Grade A Grade B Grade C					
	ASTM A501	Grades A and B					
	ASTM A516	Grades 55 & 60 65 & 70					
	ASTM A524	Grades I & II					
	ASTM A529	Grades 50 & 55					

Firgure F.2

WPS

Morrow Steel Fabricators, Inc. Approved By: TOM R

WPS# MSF2000 Date: 2/21/2023
WPS Rev# 2 Rev Date: 5/30/2024

Welding Process FCAW Type: SEMI AUTO
(Manual, Semi Auto, etc)

Joints

Joint Type: TC-U4a-GF
Backing: Y
Groove Angle: 30
Root Opening Radius: N/A
Root Face: 3/8" (+1/4" -1/16")
Backgouging? N
Backgouging Method:

Joint Detail

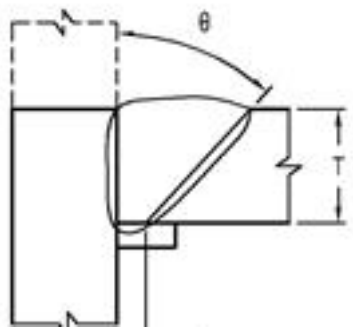

Base Metals

M-No. GRP # II
Spec Type & Grade ASTM A36

Thickness Range of Base Metal: Groove 1/8"-3/4" Fillet
Pipe Dia Range: Groove: Fillet
Other Notes:

Filler Metals

Filler Metal F-No. F6
AWS Classification E71-T-1
Filler Metal Size .045"
AWS Spec A5.20

Shielding

Flux
Gas CO2 Composition: 100
Electrode Flux Class Flow Rate: 30-40CFH
Gas Cup Size: .0625"

Firgure F.2

WPS

Pre Heat/Post Heat

Pre Heat Temp:	MIN 32F	Table#	3.30		
Interpass Temp:	MIN32F				
Post Heat Applicable?	N	Post Heat Temps		Time	

Positions

Position of Groove	FLAT	Weld Progression	L-R, R-L
Position of Fillet			

Electrical Characteristics

Current Type/Polarity	DCEP	Tungsten Electrode Size/Type	
Pulse	N	Pulsing Parameters	
Current	190-230	Transfer Mode	GLOBLAR
Voltage	24-28	Other Notes	
WFS	250-350		

Other Variables

Cup or Nozzle size			
Cleaning Method	CHIP/BRUSH/GRIND		
Number of Electrodes			
Technique	STRINGER	(Stringer or Weave)	
Single Pass			
Multipass	Y	Interpass Cleaning	YES
Contact Tip to Work Distance			
Other Notes			

Welding Parameters

		Filler Metal		Electrical			
Layers	Process	Class	Diameter	Type and Polarity	Current Range	Voltage Range	Travel Speed
ROOT	FCAW		.045"	DCEP	190-230	24-28	3.5-6ipm
FILLER	FCAW		.045"	DCEP	190-230	24-28	3.5-6ipm
CAP	FCAW		.045"	DCEP	190-230	24-28	3.5-6ipm

Firgure F.2

AWS TABLE 3.3

B	ASTM A36		SMAW with low-hydrogen electrodes, SAW, GMAW, FCAW	1/8 to 3/4 incl.	3 to 20 incl.	32[a]	0[a]
	ASTM A53	Grade B					
	ASTM A106	Grade B					
	ASTM A131	Grades A, B, CS, D, DS, E AH 32 & 36 DH 32 & 36 EH 32 & 36		Over 3/4 thru 1-1/2 incl.	Over 20 thru 38 incl.	50	10
	ASTM A139	Grade B					
	ASTM A381	Grade Y35					
	ASTM A441			Over 1-1/2 thru 2-1/2 incl.	Over 38 thru 65 incl.	150	65
	ASTM A500	Grade A Grade B Grade C					
	ASTM A501	Grades A and B		Over 2-1/2	Over 65	225	110
	ASTM A516	Grades 55 & 60 65 & 70					
	ASTM A524	Grades I & II					
	ASTM A529	Grades 50 & 55					

Firgure F.2

Sample Welder Qualification Form (Single-Process)
WELDER, WELDING OPERATOR, OR TACK WELDER
PERFORMANCE QUALIFICATION TEST RECORD

Name	Brett Selvaggio	OPTIONAL PHOTO ID	Test Date	2/8/2024	Rev.
ID Number	BS7256		Record No.	1	0
Stamp No.	N/A		Std. Test No.	N/A	N/A
Company	Morrow Steel		WPS No.	MS-WPS-001	
Division	FL		Qualified To	MS-WPS-001/AWS D1.1	

BASE METALS	Specification	Type or Grade	AWS Group No.	Size (NPS)	Schedule	Thickness	Diameter
Base Material	ASTM A36-19/A529-19	CS	1	N/A	N/A	1"	N/A
Welded To	ASTM A36-19/A529-19	CS	1	N/A	N/A	1"	N/A

VARIABLES	Actual Values		RANGE QUALIFIED
Type of Weld Joint	Plate-Groove B-UTA w/ Backing		Groove, Fillet CJP/PJP
Base Metal	Group 1 to Group 1		Any Qualified Base Metal Per AWS D1.1

	Groove	Fillet		Groove	Fillet
Plate Thickness	1"	N/A		.125 - Unlimited	Unlimited
Pipe/Tube Thickness	N/A	N/A		.125 - Unlimited	Unlimited
Pipe Diameter	N/A	N/A		24" and Larger	Unlimited

Welding Process	FCAW		FCAW
Type *(Manual, Semiautomatic, Mechanized, Automatic)*	Semiautomatic		Semiautomatic
Backing	With		With or (Backgouging, Backwelding)
Filler Metal (AWS Spec.)	A5.20		A5.20
AWS Classification	E71T-1C-H8		All
F-Number	N/A		N/A
Position	3G		F, V, H
Groove – Plate & Pipe ≥ 24 in	N/A		All w Backing
Groove – Pipe < 24 in	N/A		N/A
Fillet – Plate & Pipe ≥ 24 in	N/A		All
Fillet – Pipe < 24 in	N/A		All
Progression	Vertical Up		Vertical Up
GMAW Transfer Mode	N/A		N/A
Single or Multiple Electrodes	Single		Single
Gas/Flux Type	75%AR / 75%Co2		75%AR / 75%Co2

TEST RESULTS

Type of Test	Acceptance Criteria	Results	Remarks
Visual	4.9	Acc	
Radiography	4.9	Acc	
N/A	N/A	N/A	N/A

CERTIFICATION

Test Conducted by	
Laboratory	NDT XL
Test Number	2.7.24NDTXL
File Number	2.7.24NDTXL

Adam J Logan
CWI 13072931
QC1 EXP. 7/1/2025

We, the undersigned, certify that the statements in this record are correct and that the test welds were prepared, welded, and tested in accordance with the requirements of Clause 4 of AWS D1.1/D1.1M (2015) *Structural Welding Code—Steel.*
(year)

Manufacturer or Contractor _____ Authorized by _____

Date _____

Sample Welder Qualification Form (Single-Process)
WELDER, WELDING OPERATOR, OR TACK WELDER
PERFORMANCE QUALIFICATION TEST RECORD

Name	Gerald Masar	OPTIONAL PHOTO ID	Test Date	2/8/2024	Rev.
ID Number	GM2143		Record No.	1	0
Stamp No.	N/A		Std. Test No.	N/A	N/A
Company	Morrow Steel		WPS No.	MS-WPS-001	
Division	FL		Qualified To	MS-WPS-001/AWS D1.1	

BASE METALS	Specification	Type or Grade	AWS Group No.	Size (NPS)	Schedule	Thickness	Diameter
Base Material	ASTM A36-19/A529-19	CS	1	N/A	N/A	1"	N/A
Welded To	ASTM A36-19/A529-19	CS	1	N/A	N/A	1"	N/A

VARIABLES	Actual Values		RANGE QUALIFIED
Type of Weld Joint	Plate-Groove B-UTA w/ Backing		Groove, Fillet CJP/PJP
Base Metal	Group 1 to Group 1		Any Qualified Base Metal Per AWS D1.1

	Groove	Fillet		Groove	Fillet
Plate Thickness	1"	N/A		.125 - Unlimited	Unlimited
Pipe/Tube Thickness	N/A	N/A		.125 - Unlimited	Unlimited
Pipe Diameter	N/A	N/A		24" and Larger	Unlimited

Welding Process	FCAW		FCAW
Type *(Manual, Semiautomatic, Mechanized, Automatic)*	Semiautomatic		Semiautomatic
Backing	With		With or (Backgouging, Backwelding)
Filler Metal (AWS Spec.)	A5.20		A5.20
AWS Classification	E71T-1C-H8		All
F-Number	N/A		N/A
Position	3G		F, V, H
Groove – Plate & Pipe ≥ 24 in	N/A		All w Backing
Groove – Pipe < 24 in	N/A		N/A
Fillet – Plate & Pipe ≥ 24 in	N/A		All
Fillet – Pipe < 24 in	N/A		All
Progression	Vertical Up		Vertical Up
GMAW Transfer Mode	N/A		N/A
Single or Multiple Electrodes	Single		Single
Gas/Flux Type	75%AR / 75%Co2		75%AR / 75%Co2

TEST RESULTS

Type of Test	Acceptance Criteria	Results	Remarks
Visual	4.9	Acc	
Radiography	4.9	Acc	
N/A	N/A	N/A	N/A

CERTIFICATION

Test Conducted by	
Laboratory	NDT XL
Test Number	2.7.24NDTXL
File Number	2.7.24NDTXL

Adam J. Logan
CWI 13072931
QC1 EXP. 7/1/2025

We, the undersigned, certify that the statements in this record are correct and that the test welds were prepared, welded, and tested in *accordance with the requirements of Clause 4 of AWS D1.1/D1.1M (2015) Structural Welding Code—Steel.*
(year)

Manufacturer or Contractor _____ Authorized by _____

Date _____

Sample Welder Qualification Form (Single-Process)
WELDER, WELDING OPERATOR, OR TACK WELDER
PERFORMANCE QUALIFICATION TEST RECORD

Name	Neil Young	OPTIONAL PHOTO ID	Test Date	2/8/2024	Rev.
ID Number	NY8180		Record No.	1	0
Stamp No.	N/A		Std. Test No.	N/A	N/A
Company	Morrow Steel		WPS No.	MS-WPS-001	
Division	FL		Qualified To	MS-WPS-001/AWS D1.1	

BASE METALS	Specification	Type or Grade	AWS Group No.	Size (NPS)	Schedule	Thickness	Diameter
Base Material	ASTM A36-19/A529-19	CS	1	N/A	N/A	1"	N/A
Welded To	ASTM A36-19/A529-19	CS	1	N/A	N/A	1"	N/A

VARIABLES	Actual Values		RANGE QUALIFIED
Type of Weld Joint	Plate-Groove B-UTA w/ Backing		Groove, Fillet CJP/PJP
Base Metal	Group 1 to Group 1		Any Qualified Base Metal Per AWS D1.1

	Groove	Fillet		Groove	Fillet
Plate Thickness	1"	N/A		.125 - Unlimited	Unlimited
Pipe/Tube Thickness	N/A	N/A		.125 - Unlimited	Unlimited
Pipe Diameter	N/A	N/A		24" and Larger	Unlimited

Welding Process	FCAW		FCAW
Type *(Manual, Semiautomatic, Mechanized, Automatic)*	Semiautomatic		Semiautomatic
Backing	With		With or (Backgouging, Backwelding)
Filler Metal (AWS Spec.)	A5.20		A5.20
AWS Classification	E71T-1C-H8		All
F-Number	N/A		N/A
Position	3G		F, V, H
Groove – Plate & Pipe ≥ 24 in	N/A		All w Backing
Groove – Pipe < 24 in	N/A		N/A
Fillet – Plate & Pipe ≥ 24 in	N/A		All
Fillet – Pipe < 24 in	N/A		All
Progression	Vertical Up		Vertical Up
GMAW Transfer Mode	N/A		N/A
Single or Multiple Electrodes	Single		Single
Gas/Flux Type	75%AR / 75%Co2		75%AR / 75%Co2

TEST RESULTS

Type of Test	Acceptance Criteria	Results	Remarks
Visual	4.9	Acc	
Radiography	4.9	Acc	
N/A	N/A	N/A	N/A

CERTIFICATION

Test Conducted by	
Laboratory	NDT XL
Test Number	2.7.24NDTXL
File Number	2.7.24NDTXL

Adam J Logan
CWI 13072931
QC1 EXP. 7/1/2025

We, the undersigned, certify that the statements in this record are correct and that the test welds were prepared, welded, and tested in accordance with the requirements of Clause 4 of AWS D1.1/D1.1M (2015) *Structural Welding Code—Steel.*
(year)

Manufacturer or Contractor _____ Authorized by _____

Date _____

Sample Welder Qualification Blank Form (Single-Process)
WELDER, WELDING OPERATOR, OR TACK WELDER
PERFORMANCE QUALIFICATION TEST RECORD

Name	JAYLIN BRYAN	OPTIONAL PHOTO ID	Test Date	2/27/26	Rev.
ID Number	JB4120		Record No.	1	
Stamp No.			Std. Test No.		
Company	MORROW STEEL		WPS No.		
Division	FL		Qualified To		

BASE METALS	Specification	Type or Grade	AWS Group No.	Size (NPS)	Schedule	Thickness	Diameter
Base Material	ASTM A36-19/A529-19	CS	1	N/A	N/A	1"	N/A
Welded To	ASTM A36-19/A529-19	CS	1	N/A	N/A	1"	N/A

VARIABLES	Actual Values		RANGE QUALIFIED
Type of Weld Joint	PLATE GROOVE W/BACKING		GROOVE,FILLET,CJP.PJP
Base Metal	GROUP 1 TO GROUP 1		ANY QUALIFIED BASE MATERIAL

	Groove	Fillet		Groove	Fillet
Plate Thickness	1"	N/A		.125 TO UNLIMITED	UNLIMITED
Pipe/Tube Thickness	N/A	N.A		.125 TO UNLIMITED	UNLIMITED
Pipe Diameter	N/A	N/A		24" AND LARGER	UNLIMITED

Welding Process	FCAW		FCAW
Type *(Manual, Semiautomatic, Mechanized, Automatic)*	SEMI AUTOMATIC		SEMI AUTOMATIC
Backing	WITH BACKING		WITH BACKING OR BACKGOUGE AND BACK WELD
Filler Metal (AWS Spec.)	A5.20		A5.20
AWS Classification	E71T-1		ALL
F-Number	N/A		N/A
Position	1G		
Groove – Plate & Pipe ≥ 24 in			ALL WITH BACKING
Groove – Pipe < 24 in			N/A
Fillet – Plate & Pipe ≥ 24 in			ALL
Fillet – Pipe < 24 in			ALL
Progression	F		GROOVE-F, FILLET-F AND H
GMAW Transfer Mode	N/A		N/A
Single or Multiple Electrodes	SINGLE		SINGLE
Gas/Flux Type	100%CO2		100%CO2

TEST RESULTS

Type of Test	Acceptance Criteria	Results	Remarks
2 SIDE BENDS	4.9 AWS D1.1	PASS	NONE

CERTIFICATION

Test Conducted by	
Laboratory	
Test Number	
File Number	

We, the undersigned, certify that the statements in this record are correct and that the test welds were prepared, welded, and tested in accordance with the requirements of Clause 6 of AWS D1.1/D1.1M (2020) *Structural Welding Code—Steel.*
(year)

Manufacturer or Contractor MORROW STEEL

Authorized by T REGAN

Date 3/2/26

Form J-4

(See http://go.aws.org/D1forms)

Adam J. Logan
CWI 13072931
QC1 EXP. 7/1/2028

Sample Welder Qualification Blank Form (Single-Process)
WELDER, WELDING OPERATOR, OR TACK WELDER
PERFORMANCE QUALIFICATION TEST RECORD

Name	MIKE BAKER	OPTIONAL PHOTO ID	Test Date	2/27/26	Rev.
ID Number			Record No.	1	
Stamp No.			Std. Test No.		
Company	MORROW STEEL		WPS No.		
Division	FL		Qualified To		

BASE METALS	Specification	Type or Grade	AWS Group No.	Size (NPS)	Schedule	Thickness	Diameter
Base Material	ASTM A36-19/A529-19	CS	1	N/A	N/A	1"	N/A
Welded To	ASTM A36-19/A529-19	CS	1	N/A	N/A	1"	N/A

VARIABLES	Actual Values		RANGE QUALIFIED
Type of Weld Joint	PLATE GROOVE W/BACKING		GROOVE,FILLET,CJP.PJP
Base Metal	GROUP 1 TO GROUP 1		ANY QUALIFIED BASE MATERIAL

	Groove	Fillet		Groove	Fillet
Plate Thickness	1"	N/A		.125 TO UNLIMITED	UNLIMITED
Pipe/Tube Thickness	N/A	N.A		.125 TO UNLIMITED	UNLIMITED
Pipe Diameter	N/A	N/A		24" AND LARGER	UNLIMITED

Welding Process	FCAW		FCAW
Type *(Manual, Semiautomatic, Mechanized, Automatic)*	SEMI AUTOMATIC		SEMI AUTOMATIC
Backing	WITH BACKING		WITH BACKING OR BACKGOUGE AND BACK WELD
Filler Metal (AWS Spec.)	A5.20		A5.20
AWS Classification	E71T-1		ALL
F-Number	N/A		N/A
Position	1G		
Groove – Plate & Pipe ≥ 24 in			ALL WITH BACKING
Groove – Pipe < 24 in			N/A
Fillet – Plate & Pipe ≥ 24 in			ALL
Fillet – Pipe < 24 in			ALL
Progression	F		GROOVE-F, FILLET-F AND H
GMAW Transfer Mode	N/A		N/A
Single or Multiple Electrodes	SINGLE		SINGLE
Gas/Flux Type	100%CO2		100%CO2

TEST RESULTS

Type of Test	Acceptance Criteria	Results	Remarks
2 SIDE BENDS	4.9 AWS D1.1	PASS	NONE

CERTIFICATION

Test Conducted by	
Laboratory	
Test Number	
File Number	

We, the undersigned, certify that the statements in this record are correct and that the test welds were prepared, welded, and tested in accordance with the requirements of Clause 6 of AWS D1.1/D1.1M (2020) *Structural Welding Code—Steel.*
(year)

Manufacturer or Contractor MORROW STEEL

Authorized by T REGAN

Date 3/2/26

Adam J. Logan
CWI 13072931
QC1 EXP. 7/1/2028

Form J-4

(See http://go.aws.org/D1forms)

Sample Welder Qualification Form (Single-Process)
WELDER, WELDING OPERATOR, OR TACK WELDER
PERFORMANCE QUALIFICATION TEST RECORD

Name	John Martinelli	OPTIONAL PHOTO ID	Test Date	1/15/2025	Rev.
ID Number	JM5860		Record No.	1	0
Stamp No.	N/A		Std. Test No.	N/A	N/A
Company	Morrow Steel		WPS No.	MS-WPS-001	
Division	FL		Qualified To	MS-WPS-001/AWS D1.1	

BASE METALS	Specification	Type or Grade	AWS Group No.	Size (NPS)	Schedule	Thickness	Diameter
Base Material	ASTM A36-19/A529-19	CS	1	N/A	N/A	1"	N/A
Welded To	ASTM A36-19/A529-19	CS	1	N/A	N/A	1"	N/A

VARIABLES	Actual Values		RANGE QUALIFIED
Type of Weld Joint	Plate-Groove w/ Backing		Groove, Fillet CJP/PJP
Base Metal	Group 1 to Group 1		Any Qualified Base Metal Per AWS D1.1

	Groove	Fillet		Groove	Fillet
Plate Thickness	1"	N/A		.125 - Unlimited	Unlimited
Pipe/Tube Thickness	N/A	N/A		.125 - Unlimited	Unlimited
Pipe Diameter	N/A	N/A		24" and Larger	Unlimited

Welding Process	FCAW		FCAW
Type *(Manual, Semiautomatic, Mechanized, Automatic)*	Semi Automatic		Semiautomatic
Backing	With Backing		With Backing or (Backgouging, Backwelding)
Filler Metal (AWS Spec.)	A5.20		A5.20
AWS Classification	E71T-1		All
F-Number	N/A		N/A
Position	1G		1G 1F 2F
Groove – Plate & Pipe ≥ 24 in	N/A		All w Backing
Groove – Pipe < 24 in	N/A		N/A
Fillet – Plate & Pipe ≥ 24 in	N/A		All
Fillet – Pipe < 24 in	N/A		All
Progression	F		Groove- F. Fillet- F H
GMAW Transfer Mode	N/A		N/A
Single or Multiple Electrodes	Single		Single
Gas/Flux Type	75%AR / 75%Co2		75%AR / 75%Co2

TEST RESULTS

Type of Test	Acceptance Criteria	Results	Remarks
2 Side Bends	4.9 AWS D1.1	Acc	Acceptable
N/A	4.9 AWS D1.1	N/A	
N/A	N/A	N/A	N/A

Adam J. Logan
CWI 13072931
QC1 EXP. 7/1/2025

CERTIFICATION

Test Conducted by	
Laboratory	NDT XL
Test Number	1.15.25NDTXL(2)
File Number	11.20.24NDTXL(2)

We, the undersigned, certify that the statements in this record are correct and that the test welds were prepared, welded, and tested in accordance with the requirements of Clause 4 of AWS D1.1/D1.1M (2015) *Structural Welding Code—Steel.*
(year)

Manufacturer or Contractor _____ Authorized by _____

Date _____

Sample Welder Qualification Form (Single-Process)
WELDER, WELDING OPERATOR, OR TACK WELDER
PERFORMANCE QUALIFICATION TEST RECORD

Name	Raidel Rodriguez	OPTIONAL PHOTO ID	Test Date	2/8/2024	Rev.
ID Number	3197ROR		Record No.	1	0
Stamp No.	N/A		Std. Test No.	N/A	N/A
Company	Morrow Steel		WPS No.	MS-WPS-001	
Division	FL		Qualified To	MS-WPS-001/AWS D1.1	

BASE METALS	Specification	Type or Grade	AWS Group No.	Size (NPS)	Schedule	Thickness	Diameter
Base Material	ASTM A36-19/A529-19	CS	1	N/A	N/A	1"	N/A
Welded To	ASTM A36-19/A529-19	CS	1	N/A	N/A	1"	N/A

VARIABLES	Actual Values		RANGE QUALIFIED
Type of Weld Joint	Plate-Groove w/ Backing		Groove, Fillet CJP/PJP
Base Metal	Group 1 to Group 1		Any Qualified Base Metal Per AWS D1.1

	Groove	Fillet		Groove	Fillet
Plate Thickness	1"	N/A		.125 - Unlimited	Unlimited
Pipe/Tube Thickness	N/A	N/A		.125 - Unlimited	Unlimited
Pipe Diameter	N/A	N/A		24" and Larger	Unlimited

Welding Process	FCAW		FCAW
Type *(Manual, Semiautomatic, Mechanized, Automatic)*	Semi Automatic		Semiautomatic
Backing	With Backing		With Backing or (Backgouging, Backwelding)
Filler Metal (AWS Spec.)	A5.20		A5.20
AWS Classification	E71T-1		All
F-Number	N/A		N/A
Position	1G		1G 1F 2F
Groove – Plate & Pipe ≥ 24 in	N/A		All w Backing
Groove – Pipe < 24 in	N/A		N/A
Fillet – Plate & Pipe ≥ 24 in	N/A		All
Fillet – Pipe < 24 in	N/A		All
Progression	Flat		Groove- F. Fillet- F H
GMAW Transfer Mode	N/A		N/A
Single or Multiple Electrodes	Single		Single
Gas/Flux Type	75%AR / 75%Co2		75%AR / 75%Co2

TEST RESULTS

Type of Test	Acceptance Criteria	Results	Remarks
Visual	4.9 AWS D1.1	Acc	
Radiography	4.9 AWS D1.1	Acc	
N/A	N/A	N/A	N/A

CERTIFICATION

Test Conducted by	
Laboratory	NDT XL
Test Number	2.7.24NDTXL
File Number	2.7.24NDTXL

Adam J. Logan
CWI 13072931
QC1 EXP. 7/1/2025

We, the undersigned, certify that the statements in this record are correct and that the test welds were prepared, welded, and tested in accordance with the requirements of Clause 4 of AWS D1.1/D1.1M (2015) *Structural Welding Code—Steel.*
(year)

Manufacturer or Contractor _____ Authorized by _____

Date _____

Sample Welder Qualification Form (Single-Process)
WELDER, WELDING OPERATOR, OR TACK WELDER
PERFORMANCE QUALIFICATION TEST RECORD

Name	Carson Gilbert	OPTIONAL PHOTO ID	Test Date	2/8/2024	Rev.
ID Number	CG2462		Record No.	1	0
Stamp No.	N/A		Std. Test No.	N/A	N/A
Company	Morrow Steel		WPS No.	MS-WPS-001	
Division	FL		Qualified To	MS-WPS-001/AWS D1.1	

BASE METALS	Specification	Type or Grade	AWS Group No.	Size (NPS)	Schedule	Thickness	Diameter
Base Material	ASTM A36-19/A529-19	CS	1	N/A	N/A	1"	N/A
Welded To	ASTM A36-19/A529-19	CS	1	N/A	N/A	1"	N/A

VARIABLES	Actual Values		RANGE QUALIFIED
Type of Weld Joint	Plate-Groove w/ Backing		Groove, Fillet CJP/PJP
Base Metal	Group 1 to Group 1		Any Qualified Base Metal Per AWS D1.1

	Groove	Fillet		Groove	Fillet
Plate Thickness	1"	N/A		.125 - Unlimited	Unlimited
Pipe/Tube Thickness	N/A	N/A		.125 - Unlimited	Unlimited
Pipe Diameter	N/A	N/A		24" and Larger	Unlimited

Welding Process	FCAW		FCAW
Type *(Manual, Semiautomatic, Mechanized, Automatic)*	Semi Automatic		Semiautomatic
Backing	With Backing		With Backing or (Backgouging, Backwelding)
Filler Metal (AWS Spec.)	A5.20		A5.20
AWS Classification	E71T-1		All
F-Number	N/A		N/A
Position	1G		1G 1F 2F
Groove – Plate & Pipe ≥ 24 in	N/A		All w Backing
Groove – Pipe < 24 in	N/A		N/A
Fillet – Plate & Pipe ≥ 24 in	N/A		All
Fillet – Pipe < 24 in	N/A		All
Progression	F		Groove- F. Fillet- F H
GMAW Transfer Mode	N/A		N/A
Single or Multiple Electrodes	Single		Single
Gas/Flux Type	75%AR / 75%Co2		75%AR / 75%Co2

TEST RESULTS

Type of Test	Acceptance Criteria	Results	Remarks
Visual	4.9 AWS D1.1	Acc	
Radiography	4.9 AWS D1.1	Acc	
N/A	N/A	N/A	N/A

CERTIFICATION

Test Conducted by	
Laboratory	NDT XL
Test Number	2.7.24NDTXL
File Number	2.7.24NDTXL

Adam J. Logan
CWI 13072931
QC1 EXP. 7/1/2025

We, the undersigned, certify that the statements in this record are correct and that the test welds were prepared, welded, and tested in accordance with the requirements of Clause 4 of AWS D1.1/D1.1M (2015) *Structural Welding Code—Steel.*
(year)

Manufacturer or Contractor _____ Authorized by _____

Date _____

WELDER AND WELDING OPERATOR QUALIFICATION TEST RECORD

Welder Welding Operator's Name Jeffrey Brownfield
Identification No. 007 **Qualification Date** 6/8/2023
Welder's Social Security No. ***-**-8771
In Accordance with WPS No. MS-WPS-001 **Revision** 0
Welding Process(es) FCAW **Type** SEMI-Automatic
(Automatic, Manual, etc.
Mode of Transfer for GMAW
(Short Circuiting, Spray, Globular)

VARIABLE	ACTUAL VARIABLE USED IN QUAL.	QUALIFICATION RANGE
JOINT:		
Joint Type	B-U2a-GF	Butt
Backing Material Type	ASTM- A36	ASTM- A36
Groove Welded From:	V-Groove	V-Groove
BASE METAL		
Material Specification	A36	A36
Sheet Steel		
Supporting Steel		
Sheet Thickness		
Groove	1"	1/8" to Unlimited
Fillet		
Arc Spot		
Arc Seam		
COATING(S)		
Type		
Thickness		
POSITION		
Groove	3G	1G, 2G, 3G,
Fillet		1F, 2F, 3F
Arc Spot		
Arc Seam		
Progression	uphill	uphill
GAS	75%Ar/25%CO2	75%Ar/25%CO2
ELECTRODE	F1	F1
Size	0.45	0.45
Group Designation	A5.20	A5.20

VISUAL EXAMINATION RESULTS (4.9.1)

Specimen 1 **Pass Visual and X-ray test - 4.22.3.2** ***Specimen 2***
Appearance *Cracks* *Undercut*
Reinforcement *Diam. Of Arc Spot Nugget*

Samples Tested By Structural Inspection Serv. *Per* AWS D1.1
Laboratory Test *Date of Test* 6/8/2023

The undersigned certify that the statements in this record are correct and that the welds were prepared and tested in accordance with the requirements of AWS D1.1 - 2015

Company Structural Inspection Services LLC **Authorized By** Raul Mafla

Raul A Mafla
CWI 05120161
QC1 EXP. 12/1/2023

WELDER AND WELDING OPERATOR QUALIFICATION TEST RECORD

Welder Welding Operator's Name Vance Spencer
Identification No. 007 **Qualification Date** 6/8/2023
Welder's Social Security No. ***-**-5903
In Accordance with WPS No. MS-WPS-001 **Revision** 0
Welding Process(es) FCAW **Type** SEMI-Automatic
(Automatic, Manual, etc.
Mode of Transfer for GMAW
(Short Circuiting, Spray, Globular)

VARIABLE	ACTUAL VARIABLE USED IN QUAL.	QUALIFICATION RANGE
JOINT:		
Joint Type	B-U2a-GF	Butt
Backing Material Type	ASTM- A36	ASTM- A36
Groove Welded From:	V-Groove	V-Groove
BASE METAL		
Material Specification	A36	A36
Sheet Steel		
Supporting Steel		
Sheet Thickness		
Groove	1"	1/8" to Unlimited
Fillet		
Arc Spot		
Arc Seam		
COATING(S)		
Type		
Thickness		
POSITION		
Groove	3G	1G, 2G, 3G,
Fillet		1F, 2F, 3F
Arc Spot		
Arc Seam		
Progression	uphill	uphill
GAS	75%Ar/25%CO2	75%Ar/25%CO2
ELECTRODE	F1	F1
Size	0.45	0.45
Group Designation	A5.20	A5.20

VISUAL EXAMINATION RESULTS (4.9.1)

Specimen 1 **Pass Visual and X-ray test - 4.22.3.2** **Specimen 2**
Appearance *Cracks* *Undercut*
Reinforcement *Diam. Of Arc Spot Nugget*

Samples Tested By Structural Inspection Serv. *Per* AWS D1.1
Laboratory Test *Date of Test* 6/8/2023

The undersigned certify that the statements in this record are correct and that the welds were prepared and tested in accordance with the requirements of AWS D1.1 - 2015

Company Structural Inspection Services LLC **Authorized By** Raul Mafla

Raul A Mafla
CWI 05120161
QC1 EXP. 12/1/2023