Transmittal
Submittal Review Response

101 Southhall Lane, Suite 200
Maitland, Fl 32751
407.660.2552 Phone
407.875.1161 Fax

Date: 9/9/2026

To: **Contractor**
Kokolakis Contracting
202 East Center Street
Tarpon Springs, FL 34689
Attention: Cameron Champaigne

Re: **Project No.:** 253117-261237
Project Name: PSTA Clearwater Multimodal Transit Center
Client: Pinellas Suncoast Transit Authority

Transmitted herewith is (are)...

☐ *Hard Copy(ies)*	**Sent via:**	☐ *Mail*	☐ *Overnight*	☐ *Courier*
☒ *Digital*		☐ Email	☐ FTP	☐ Cloud Delivery

Submittal No.: **S-051200-002-F**
Title or Description: **Structural Steel Framing Canopy & Pavilion**
Type of Submittal: **Shop Drawing** **If other**
Status
Review Code: Code 4: Approved As Noted; Resubmit
Other:
Review Comments:

1. Contractor shall provide a written response to each of the Engineer's review comments listed below.
2. Engineer notes that this is a resubmittal of S-051200-002-D (not E).
3. For additional comments see pdf entitled "S-051200-002-F - Structural Steel Framing Canopy & Pavilion_CDM Smith Comments.pdf". Effort has been made by Engineer to provide responses to all clouds. If a response has not been provided, please ensure Engineer is aware to respond to. Contractor shall refer to markups for all detailer queries that require Contractor confirmation/response. Markups and questions are also provided on individual member sheets. Many are repeat comments.
4. Contractor to confirm steel elevation on p. 6 of 231 with approved storefront (not yet submitted). Engineer confirms intent is met. This is a repeat comment and Contractor has indicated coordination to still be completed.
5. There is a mismatch between the dimensions and wave truss bend radii shown on the overall truss longitudinal drawings, E110 and E111, and those shown on the contract drawings and typical truss shop drawings, Drawing Nos. 1176 through 1200. Coordinate between the drawings and ensure that

Ben Harber

Signed

all dimensions and bend radii are consistent with and accurately reflect the requirements shown on the contract drawings.

6. As shown in Detail E, provide two stiffeners on each side of each HSS5x5-to-HSS10x6 connection not just at the column location, as indicated in Detail E/S-CP-8, at gridlines 1.1, 2.9, 4.1, 5.1, 6.5, and 7.5. An isometric view has been provided for clarity on E118. This is a repeat comment (previously only a pdf markup).
7. Some comments on the individual member sheets from the previous submittal remain unaddressed. Provide responses or revise the shop drawings as required for all individual members with comments. These have been repeated in the pdf markup.
8. Engineer notes that the typical truss erection drawing submitted is representative of all longitudinal trusses. Contractor shall ensure that all comments provided for the typical truss are incorporated into every longitudinal truss and verified prior to fabrication and construction. This is a repeat comment as engineer notes revisions to submittal (as noted above) are still required.
9. Erection drawings and erection calculations may be submitted for engineer review and final approval prior to erection. However, the contractor shall ensure that the original member sizes and connections remain adequate and are not affected by the proposed erection sequence. If any changes are required, the shop drawings shall be revised and resubmitted for review and approval. Members and connections shown on the contract drawings are designed for final in-place loading conditions. Contractor shall submit the erection sequence, lifting and temporary support details, and shoring plan for review and approval per AISC 303. Contractor shall be responsible for verifying, through signed and sealed calculations, that stresses on members and connections do not exceed their capacities during erection, including the use of proposed erection aids and temporary connections. A smooth surface finish shall be maintained after removal of erection aids at all locations, per Section 051213-3.3. This is a repeat comment as this is required for engineer's final approval and any steel being released for fabrication without this erection plan submitted for review is at Contractor's risk.
10. Contractor shall coordinate base plate thickness, bolt hole diameters, and bolt hole locations with submittal "S-051200-001-C - Anchor Bolts & Embeds Shop Drawings" (not yet fully approved). This is a repeat comment.
11. At Waiting Pavilion building, Contractor to coordinate with the selected transformer manufacturer to confirm the location of the transformer support beams, and transformer connection requirements. This is a repeat comment as Contractor has indicated to be coordinated. Contractor to confirm intent if planned to be coordinated in field, will require coordination with grouted/reinforced CMU.
12. Submit all required information as specified in Section 1.7. This is a repeat comment as only certain items have been submitted. This may be submitted under separate cover. Contractor to confirm intent and timeline on if submitted separately.
13. Submit product data for all the items listed in section 1.6.A of specification 05 12 13. This is a repeat comment. This may be submitted under separate cover. Contractor to confirm intent and timeline on if submitted separately.

Ben Harber

Signed

14. Submit the samples as requested in section 1.6.C of specification 05 12 13. This is a repeat comment. This may be submitted under separate cover. Contractor to confirm intent and timeline on if submitted separately.
15. Include all the items listed in section 1.6.B of specifications 05 12 13. This is a repeat comment. This may be submitted under separate cover. Contractor to confirm intent and timeline on if submitted separately.
16. Submit all required information as specified in Section 1.7 of specification 05 12 13. This is a repeat comment. This may be submitted under separate cover. Contractor to confirm intent and timeline on if submitted separately.
17. Submit test results and certificates of conformance for all heavy sections (flange thickness greater than 2 inches), demonstrating compliance with Section A3.1.1c of AISC 360-16, as indicated in the steel general notes on Sheet S-1. The column flanges at the side (east and west) canopies have thicknesses greater than 2 inches. Therefore, provide the requested certificates with this resubmittal or include them in the side canopy shop drawings and resubmit. Contractor to confirm. This is a repeat comment from the “A”, “C” and “D” submittals. Contractor to confirm intent and timeline on if submitted separately.
18. Cane rails shall be provided in accordance with Section 05 52 00. Contractor shall submit under a separate package if not included in the Morrow Steel scope. This is a repeat comment as detailer has also requested confirmation. Contractor to confirm intent and timeline on if submitted separately.
19. Contractor shall submit the roof framing connected stanchion at the wave canopy or confirm if will be submitted under separate cover. This is a repeat comment as coordination has not been provided and may affect submitted framing. Contractor to confirm intent and timeline on if submitted separately.
20. Contractor shall coordinate the location, size, and elevation of plates and associated connections to structural steel for the signage connection shown on Section 7/S-CP-9 with the approved signage submittal and connection requirements (not yet submitted), and with the column cover shown on architectural drawings (not yet submitted), prior to fabrication and construction. This is a repeat comment as detailer has also requested coordination. Contractor to confirm intent if planned to be coordinated in field.
21. Contractor shall coordinate the location, size, and elevation of plates and associated connections to structural steel for the lighting connection shown on Detail B/S-CP-9 with the selected lighting manufacturer for connection requirements, and with the column cover shown on architectural drawings (not yet submitted), prior to fabrication and construction. This is a repeat comment as detailer has also requested coordination. Contractor to confirm intent if planned to be coordinated in field.
22. Contractor shall coordinate all access hatch opening sizes and associated connection requirements with the approved hatch submittal (not yet submitted). This is a repeat comment as detailer is also requesting confirmation.
23. Contractor shall coordinate ladder connection locations with submittal “S-034113-001-A – (Delegated Design) Precast Concrete Hollow Core Planks” to avoid conflicts between ladder

Ben Harber

Signed

connections to hollow core planks and precast panel embed connections at openings at the retail/operations and waiting pavilion buildings. This is a repeat comment as coordination has not been provided and conflicts may exist.

24. Contractor shall submit product data for the ladder safety post (or confirm will be submitted under separate cover) for the Engineer's review and approval. This is a repeat comment as Contractor has indicated this is shown on shop drawings however it says "by others." Contractor to confirm intent and timeline on if submitted separately.
25. Submit product data for headed studs (page 44 of 52) separately. Specification 055000 indicates basis of design. This is a repeat comment as Contractor indicated they will submit separately under 055000 if required, it is required. Contractor to confirm intent and timeline on if submitted separately.
26. Contractor is responsible for confirming that project level Buy America Act requirements are met.
27. Submitted LEED information was not reviewed. Comments to be resolved by client's LEED consultant. N CDM Smith response.
28. Receipt acknowledge od drawing E121 Wave Canopy roof hatch. However, hatch location is not shown on E106 partial roof framing of wave canopy. Contractor to locate and properly adjust roof hatch on E106.
29. Comment 35 from the previous submittal remains unresolved and pertains to the roof hatch location at the Waiting Pavilion Building. As shown on Page 32 of 266, the roof hatch opening is currently located 7'-1" from the east exterior wall. At this location, the required ladder access and clear travel area overla the adjacent interior metal stud wall. Revise the roof hatch opening location by increasing the 7'-1" offset dimension as necessary to provide the required clearances and eliminate the conflict with the interior wall construction. Resubmit for review.
30. Previous submittal response to comments 31 through 33 indicate further coordination and follow up. Contractor to confirm intent and timeline on if submitted separately.

Location of the Review Comments: Attached to Submittal

Remarks:

Reviewed by: Pooja Kalaria, Esther Goldberg, Shannon Ketchum, Daniela Montoya

Ben Harber

Signed

Submittal #051200-7.1 051200 - Structural Steel Framing

Kokolakis Contracting
202 East Center Street
Tarpon Springs, Florida 34689
Phone: +17279422211

Project: 25-0264-01 - PSTA Clearwater Station
751 Franklin St.
Clearwater, Florida 33756

S-051200-002-F - Structural Steel Framing Canopy & Pavilion

SPEC SECTION:	051200 - Structural Steel Framing	**SUBMITTAL MANAGER:**	Cameron Champaigne **(Kokolakis Contracting)**
STATUS:	Open	**DATE CREATED:**	08/31/2026
ISSUE DATE:	08/31/2026	**REVISION:**	1
RESPONSIBLE CONTRACTOR:	Acclaim Service Group, Inc.	**RECEIVED FROM:**	
RECEIVED DATE:		**SUBMIT BY:**	
FINAL DUE DATE:	09/15/2026	**LOCATION:**	
SUB JOB:		**COST CODE:**	
LEAD TIME:		**TYPE:**	
APPROVERS:	Xavier Arroyo **(CDM Smith)**, David DaSilva **(CDM Smith)**, Benjamin Harber **(CDM Smith)**, Mindy Heath **(CDM Smith)**, Robin Sarvis **(CDM Smith)**		

BALL IN COURT:
Xavier Arroyo **(CDM Smith)**, David DaSilva **(CDM Smith)**, Benjamin Harber **(CDM Smith)**, Mindy Heath **(CDM Smith)**, Robin Sarvis **(CDM Smith)**

DISTRIBUTION:
Ashley Quaid **(HDR, Inc.)** , Benjamin Harber **(CDM Smith)** , Cameron Champaigne **(Kokolakis Contracting)** , Christine Herrold **(MORROW STEEL FABRICATORS, INC)** , Colton Forkush **(Kokolakis Contracting)** , David DaSilva **(CDM Smith)** , Dylan Hernandez **(HDR, Inc.)** , Elizabeth Fazio **(PSTA)** , Eric Lawson **(MORROW STEEL FABRICATORS, INC)** , John Olivio **(HDR, Inc.)** , John Steele **(HDR, Inc.)** , Joseph Barron **(HDR, Inc.)** , Josh Van Vossen **(Kokolakis Contracting)** , Leticia Sheppard **(HDR, Inc.)** , Marcus Glynn **(HDR, Inc.)** , Mike Ferry **(MORROW STEEL FABRICATORS, INC)** , Mindy Heath **(CDM Smith)** , Robin Sarvis **(CDM Smith)** , Tracie Rose **(HDR, Inc.)** , Xavier Arroyo **(CDM Smith)**

DESCRIPTION:


ATTACHMENTS:

SUBMITTAL WORKFLOW

NAME	SUBMITTER/ APPROVER	SENT DATE	DUE DATE	RETURNED DATE	RESPONSE	ATTACHMENTS	COMMENTS
Cameron Champaigne	Submitter	9/1/2026	8/31/2026	9/1/2026	Submitted	S-051200-002-F - Structural Steel Framing Canopy & Pavilion.pdf	
Xavier Arroyo	Approver	9/1/2026	9/15/2026		Pending		
David DaSilva	Approver	9/1/2026	9/15/2026		Pending		
Benjamin Harber	Approver	9/1/2026	9/15/2026		Pending		
Mindy Heath	Approver	9/1/2026	9/15/2026		Pending		
Robin Sarvis	Approver	9/1/2026	9/15/2026		Pending		

Kokolakis Contracting hereby certifies that all items submitted herewith have been checked by the Contractor, are correct, and are in accordance with the requirements of the Contract Documents, except as noted in the remarks section of the submittal.

Tampa General Hospital VS_CLR#01
05-20-2025
PAGE No: 01 of 02

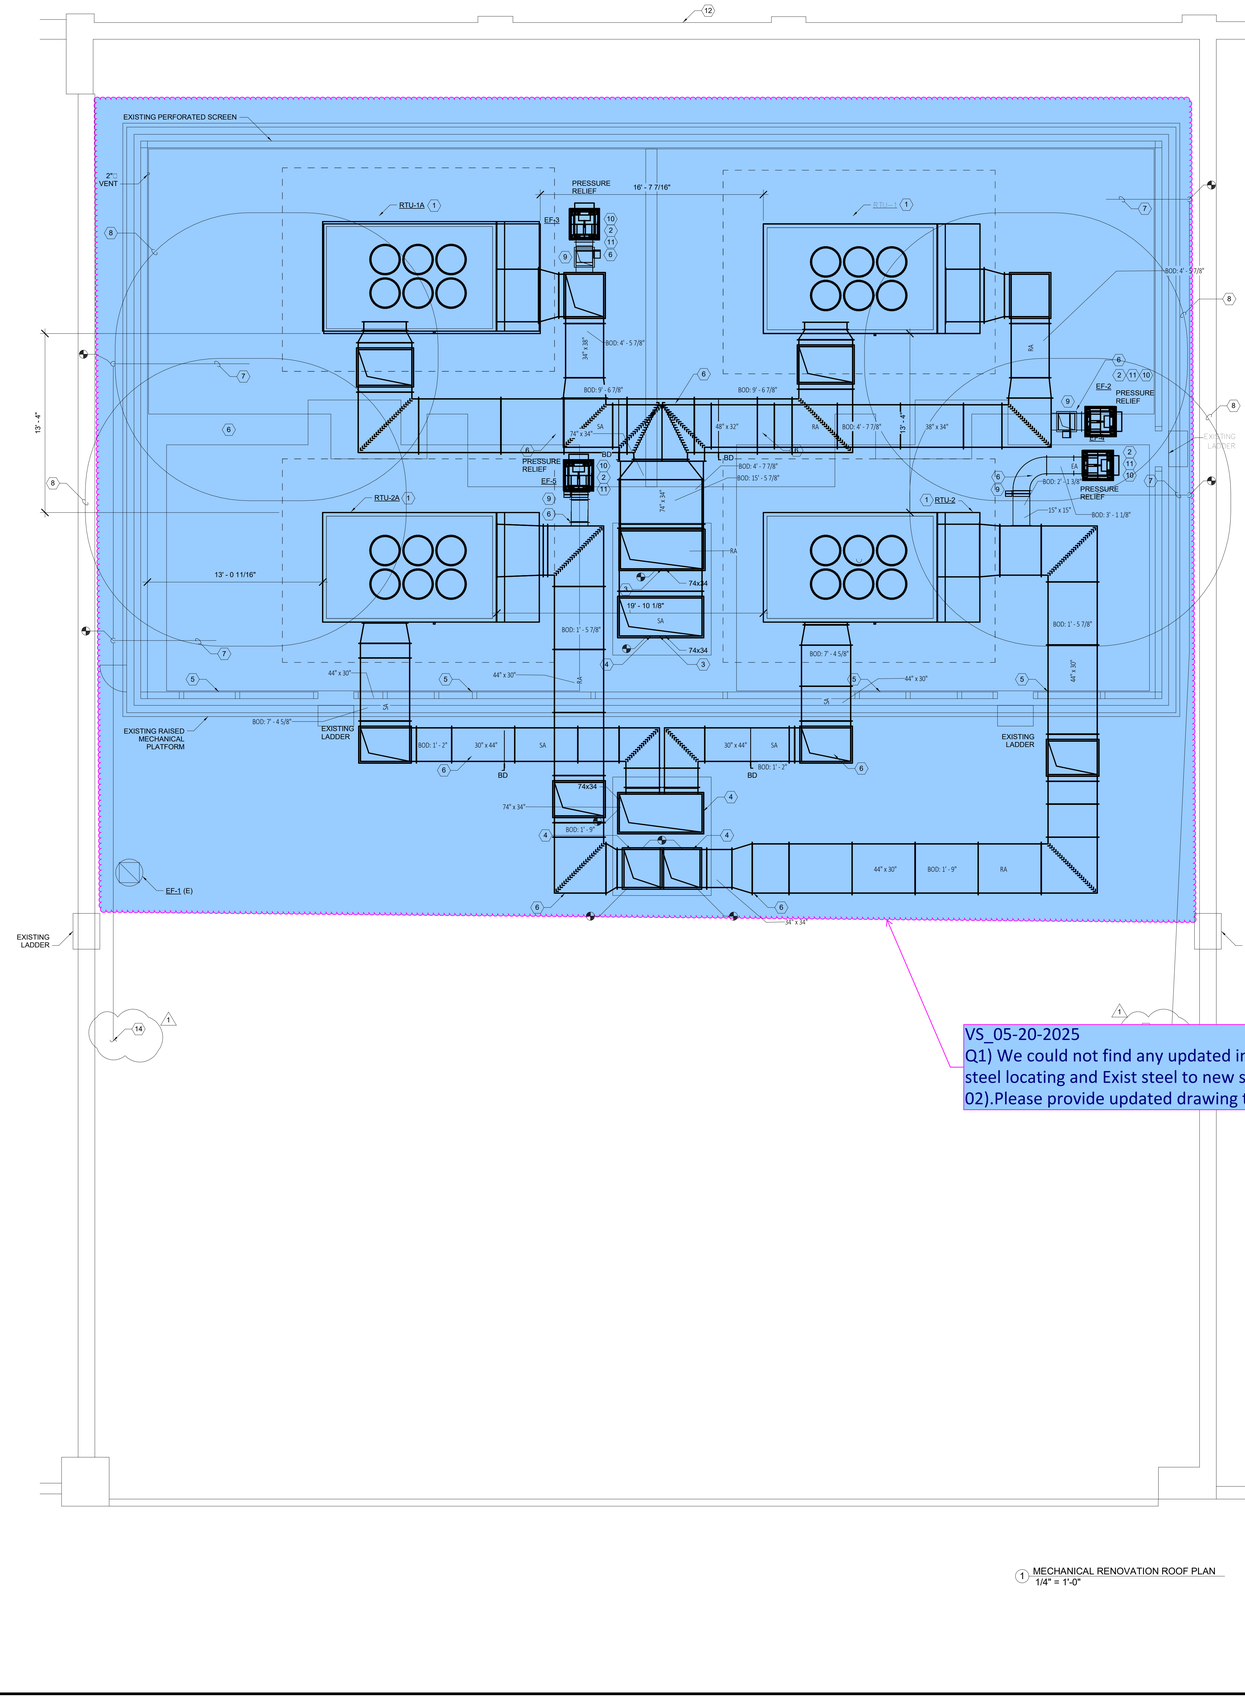

GENERAL NOTES

1. PRIOR TO BID, THE CONTRACTOR SHALL VISIT THE SITE AND FAMILIARIZE HIMHERSELF WITH THE EXISTING CONDITIONS AND CONFIRM THE DESIGN INTENT IS ACHIEVABLE. ISSUE A REQUEST FOR ADDITIONAL INFORMATION AS NECESSARY.
2. EXISTING INFORMATION TAKEN FROM EXISTING "TAMPA GENERAL HOSPITAL INFORMATION & FINANCE RELOCATION" AS-BUILT DRAWINGS DATED 05/05/2011, ISSUED BY VOLTAIR CONSULTING ENGINEERS, AND FIELD OBSERVATION PERFORMED BY CARASTRO & ASSOCIATES, INC.
3. ROOFTOP EQUIPMENT MUST BE WITHIN PERFORATED SCREEN OR A MINIMUM OF 10 FEET FROM THE ROOF EDGE TO PREVENT THE NEED FOR A GUARD RAIL.
4. THE INSTALLATION AND EXACT LOCATION OF THE ROOFTOP EQUIPMENT SHALL BE COORDINATED WITH AND APPROVED BY THE STRUCTURAL ENGINEER PRIOR TO ANY CONSTRUCTION WORK. ANY MODIFICATIONS TO THE EXISTING ROOF STRUCTURE SHALL BE COORDINATED BY THE GENERAL CONTRACTOR WITH THE STRUCTURAL ENGINEER.
5. CONTRACTOR SHALL ENSURE THAT NO CLASS 2 OR HIGHER EXHAUST AIR OR PLUMBING VENTS ARE INSTALLED WITHIN THE OUTSIDE AIR INTAKE CLEARANCES.
6. THE GENERAL CONTRACTOR SHALL RETAIN THE SERVICES OF THE ROOFING CONTRACTOR WHO HOLDS THE WARRANTY ON THE ROOF FOR ALL PATCHING, CAPPING, AND REPAIRING OF THE ROOF RESULTING FROM THE MECHANICAL WORK AS PART OF THIS CONTRACT. SEE STRUCTURAL DRAWINGS FOR ADDITIONAL DETAILS.
7. ROUTE TYPE 'L' COPPER CONDENSATE DRAINS FROM ROOFTOP UNITS TO THE EXISTING CONDENSATE DRAIN PIPES. CONDENSATE DRAIN PIPING SHALL MATCH THE UNIT'S CONNECTION SIZE. SUPPORT PIPING A MINIMUM OF EVERY SIX FEET AND SECURELY FASTEN TO THE ROOF PER THE DETAIL ON SHEET M6.0 TO WITHSTAND 2023 FLORIDA BUILDING CODE, 8TH EDITION'S WIND LOAD REQUIREMENTS.
8. CONTRACTOR SHALL COORDINATE PHASING OF PACKAGED ROOFTOP AIR CONDITIONING UNIT (RTU) REMOVAL AND REPLACEMENT WITH TGH PRIOR TO ANY CONSTRUCTION WORK.
9. INCIDENTAL PIPE, WIRING, AND CONDUIT THAT PENETRATES ROOF CONSTRUCT SHALL BE DONE SO IN A PREFABRICATED ROOF PENETRATION HOUSING EQUAL TO RPH MODEL "THE VAULT." REFER TO SHEET M6.0 FOR DETAIL. CONTRACTOR SHALL COORDINATE WITH THE MANUFACTURER FOR THE SIZE OF THE PENETRATION AND HOUSING, THE NUMBER OF PENETRATIONS, THE HEIGHT OF THE HOUSING, AND THE GASKET MATERIAL PRIOR TO SHOP DRAWING PRODUCTION.

DRAWING NOTES

1. CONTRACTOR SHALL PROVIDE A NEW PACKAGED ROOFTOP AIR CONDITIONING UNIT. COORDINATE EXACT INSTALLATION LOCATION WITH THE EXISTING I-BEAM SYSTEM AND STRUCTURAL DRAWINGS. ALL MANUFACTURER REQUIRED CLEARANCES MUST BE MAINTAINED. THE MANUFACTURER SHALL REVIEW THE FLOOR PLAN AND CONFIRM, IN WRITING, THAT ANY AND ALL CLEARANCE REDUCTIONS TO FIT THE UNIT DO NOT DERATE THE PERFORMANCE OF THE UNIT OR PROHIBIT ACCESS TO THE UNIT.
2. CONTRACTOR SHALL PROVIDE A NEW PRESSURE RELIEF EXHAUST FAN. SEE STRUCTURAL DRAWINGS FOR DETAIL. PROVIDE DUCT FITTINGS AND TRANSITIONS AS NECESSARY AT FAN INLET CONNECTION. EF-4 AND EF-5 ARE ON A 4% (0.5:12) ROOF PITCH AND REQUIRE DELEGATED ENGINEERING TO INSTALL FAN TO ROOF CURB AND ROOF CURB TO STRUCTURE FOR HIGH WIND RATING. CONTRACTOR SHALL CONFIRM THE ROOF PITCH PRIOR TO SHOP DRAWING PRODUCTION AND EQUIPMENT PURCHASE.
3. CONTRACTOR SHALL INSULATE THE DUCTWORK UNDERNEATH THE RAISED MECHANICAL PLATFORM. THE EXTERIOR INSULATION SPECIFICATION SHALL APPLY TO THIS DUCTWORK. SEAL TO EXISTING FIBERGLASS INSULATION AT PENETRATION THROUGH THE THERMAL ENVELOPE AND TO DOUBLE-WALLED DUCT AT THE PENETRATION THROUGH THE RAISED MECHANICAL PLATFORM. SEE ELEVATIONS ON M4.5 FOR FURTHER DETAIL.
4. CONTRACTOR SHALL REINSULATE AND JACKET THE EXISTING TO REMAIN EXTERIOR INSTALLED DUCTWORK PER THE DETAIL ON SHEET M6.0.
5. MECHANICAL CONTRACTOR SHALL COORDINATE WITH THE GENERAL CONTRACTOR THE PORTIONS OF THE EXISTING PERFORATED SCREEN WALL TO BE OPENED DUE TO THE ADDITION OF DUCTWORK. REMOVE AND PROVIDE NEW FRAMING MEMBERS AS REQUIRED FOR ADDITION OF DUCTWORK.
6. EXPOSED DUCTWORK INSTALLED ON THE ROOF AND/OR RAISED MECHANICAL PLATFORM SHALL BE CONSTRUCTED IN ACCORDANCE WITH THE DETAIL ON SHEET M6.0 AND WHT TABLE 1510.10 OF THE 2023 FLORIDA BUILDING CODE, 8TH EDITION. DELEGATED ENGINEERING IS REQUIRED FOR INSTALLATION AND SUPPORT OF THE ROOFTOP DUCTWORK.
7. ROUTE FULL CONNECTION SIZE CONDENSATE PIPE TO AND CONNECT TO EXISTING CONDENSATE DRAIN PIPE. PROVIDE INDIRECT CONNECTION AND DIELECTRIC UNIONS TO EXISTING PIPE AS APPLICABLE.
8. DASHED LINE INDICATES EXHAUST/VENT EXCLUSION ZONE. NO CLASS 2 OR HIGHER EXHAUST AIR OR PLUMBING VENTS MAY BE INSTALLED WITHIN THE EXCLUSION ZONE. CONTRACTOR SHALL CONFIRM IF SUCH BUILDING ELEMENTS EXISTING AND SHALL INCLUDE RELOCATING THEM IN HIS/HER COST.
9. CONTRACTOR SHALL PROVIDE A 2-POSITION MOTORIZED DAMPER. REFER TO SHEET M1.0 FOR SPECIFICATIONS. PROVIDE A MECHANICAL STOP TO ALLOW FOR THE DAMPER TO ONLY PARTIALLY OPEN. SET THE POSITION OF THE MECHANICAL STOP AS DIRECTED BY THE TEST AND BALANCE CONTRACTOR.
10. CONTRACTOR SHALL EXTEND EXHAUST AIR DUCTWORK FROM FAN OUTLET AND CUT THE OPENING AT A 45 DEGREE ANGLE. COVER THE OPENING WITH A WIRE MESH.
11. LOCAL DISCONNECT PROVIDED BY FAN MANUFACTURER. VFD IS LOCATED IN 2ND FLOOR IT ROOM W225. REFER TO SHEET M4.2 FOR LOCATION AND ADDITIONAL INFORMATION.
12. CONTROLS CONTRACTOR SHALL INSPECT EXISTING CONDITIONS FOR A GLOBAL OUTSIDE AIR TEMPERATURE AND RELATIVE HUMIDITY SENSOR AND REPAIR OR REPLACE AS NEEDED TO PROPERLY OPERATE WITH NEW EQUIPMENT. IF NO SUCH SENSOR EXISTS, THEN THE CONTROLS CONTRACTOR SHALL PROVIDE ONE ON THE NORTH FACING EXTERIOR WALL, SHIELDED FROM DIRECT SUN EXPOSURE. REFER TO SHEET M5.0.
13. CONTRACTOR SHALL PROVIDE A BACKDRAFT DAMPER EQUAL TO A TAMCO 7600 CWA.
14. REFER TO SHEET M4.3 FOR CONDENSATE DRAIN PIPE CONTINUATION.

VS_05-20-2025
Q1) We could not find any updated information about new steel to steel locating and Exist steel to new steel locations(Refer Page 02).Please provide updated drawing to proceed further.

1 MECHANICAL RENOVATION ROOF PLAN
1/4" = 1'-0"

IF BAR SCALE ABOVE DOES NOT READ ACCURATELY SCALE OF DRAWING HAS BEEN ALTERED

M-4.4

ISSUED FOR

Date: _____ Detailer: _____
Date: _____ Foreman: _____
Date: _____ Manager: _____

BCH MECHANICAL, INC.

LEGAL DISCLAIMER
THIS DOCUMENT, INCLUDING ALL IDEAS AND DESIGNS, IS AN INSTRUMENT OF A PROFESSIONAL SERVICE, AND SHALL NOT BE USED IN WHOLE OR IN PART FOR ANY PURPOSE WITHOUT EXPRESSED WRITTEN CONSENT OF COMFORT SYSTEMS USA. ANY UNAUTHORIZED USE, REUSE, REPRODUCTION, OR ALTERATION OF THIS DOCUMENT OR UNAUTHORIZED CONVERSION OF THIS DOCUMENT SHALL BE AT THE USERS SOLE RISK WITHOUT LIABILITY OR LEGAL EXPOSURE TO COMFORT SYSTEMS USA

Owner
TGH CORPORATE CENTER
Enter address here

MECHANICAL ENLARGED RENOVATION ROOF PLAN

Rev	Date	Description	By


PROJECT NUMBER: Project Number
PROJECT ISSUE DATE: Issue Date
DRAWN: JB
CHECKED: CM
CONTRACT REF: REF
M-4.4

Autodesk Docs://24-10-0025 TGH Corp Center/TGH Corp Center_R24.rvt

5/9/2025 9:31:08 AM

KEY PLAN

TRUE NORTH

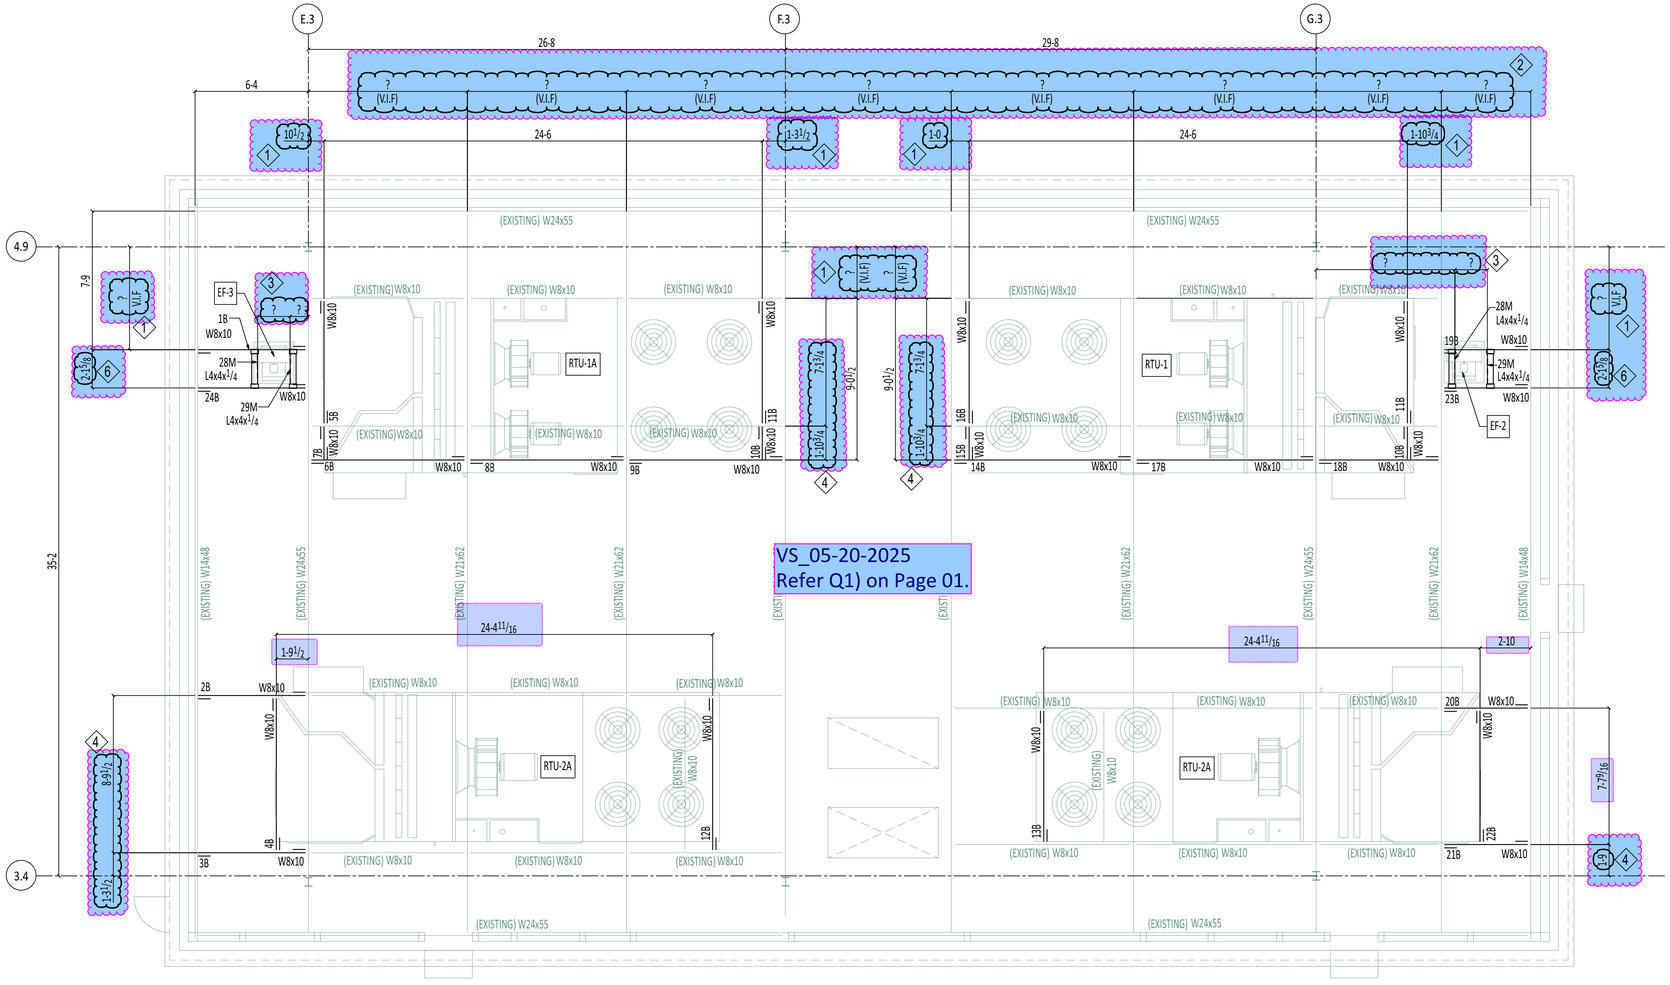

PARTIAL ROOF PLAN - STRUCTURAL PLATFORM RENOVATION

(REF: S1.0)

TRUE NORTH

NOTE:
- TOP OF EXISTING/NEW BEAM EL: ??? ◇5
- FOR SECTIONS REFER SHEET E2
- V.I.F INDICATES VERIFY IN FIELD
- ALL STEELS ARE PRIME PAINTED.

PLEASE REVIEW AND CONFIRM THE FOLLOWING ITEMS:

◇1 - PLEASE FURNISH THE NEW BEAM/EXISTING BEAM LOCATION FROM GRID LINE.

◇2 - PLEASE FURNISH THE FIELD VERIFIED CLOUDED DIMENSION TO FIX THE NEW BEAM LENGTH.

◇3 - PLEASE FURNISH THE NEW ANGLE LOCATIONS.

◇4 - PLEASE CONFIRM OR FURNISH THE BEAM LOCATION TO FIX THE NEW BEAM LENGTH.

◇5 - PLEASE FURNISH THE EXISTING TOP OF STEEL ELEVATION AND NEW STEEL ELEVATION.

◇6 - PLEASE VERIFY AND CONFIRM THE CLOUDED DIMENSION, SINCE STRUCTURAL DRAWING SHOWS THIS DIMENSION AS [+/-].

APPROVER NOTE:
ALL CLOUDED INFORMATION NOT VERIFIED/CONFIRMED ON RETURNED APPROVAL SUBMITTAL WILL BE CONSIDERED APPROVED AS DETAILED.

REFERENCE :S1.0

FIELD CONNECTIONS :
HOLES : 13/16" U.N.O
PAINT :

morrow steel Fabricators, Inc.

3620 COPELAND DRIVE
ZEPHYRHILLS, FL. 33542

	PRINTS FOR	DATE	MK	REVISIONS	DATE
			0	RELEASED FOR APPROVAL	Apr 16 2025

STRUCTURE:- TAMPA GENERAL HOSPITAL ISF BUILDING RTU REPLACEMENT
LOCATION:- TAMPA, FL 33606-1415
DETAILER:- VECTORSHADES ENGINEERING SERVICES LLC
CUSTOMER:- ---
ARCH./ENG.:- MASTER CONSULTING ENGINEERS, INC
DESCRIPTION:- ROOF FRAMING PLAN-STRUCTURAL PLATFORM RENOVATION
DRAWN:- SSN DATE:- 04-11-2025 CHK.D:- PRG DATE:- 04-13-2025

SHOP BILL	WORK ORDER NO.	DRWG. NO.
	2520	E1 △1